

South Central Regional Council of Governments

Traffic Signal Inventory Project

Town of Wallingford, CT

Prepared by:



ENGINEERING SUCCESS **TOGETHER**

1010 Wethersfield Avenue
Suite 305
Hartford, CT 06114

June 2012

TRAFFIC SIGNAL INVENTORY: WALLINGFORD, CT

PROJECT REPORT

FINAL REPORT

Prepared by: BETA Group, Inc.

Prepared for: South Central Regional Council of Governments

June 2012

EXECUTIVE SUMMARY

BETA Group, Inc. was retained by the South Central Regional Council of Governments (SCRCOG), on behalf of the Town of Wallingford, CT, to conduct an inventory of traffic signal equipment and intersection geometry at 31 town-owned locations. The purpose of this project was to gather data relating to the type and condition of the existing traffic signal equipment and geometry at the project locations. These data were then used by a team of senior traffic signal engineers to develop a qualitative assessment of existing operations, and potential improvement strategies which may require further study.

Qualitative Assessment

The following Qualitative Assessment categories were used to classify each project location:

1. **Compliant Intersections** are those that have no major violations of the requirements of the Manual on Uniform Traffic Control Devices (MUTCD). Equipment at these intersections is typically operating properly and providing good traffic operations.
2. **Maintenance Needed Intersections** are those intersections that require routine maintenance. Minor equipment issues and operational changes fall into this category.
3. **Capital Improvement Intersections** are those intersections which require replacement or upgrading of hardware that shows significant deterioration or operational issues. These intersections typically have deteriorated structural supports or vehicle damage.
4. **Replacement Intersections** are those intersections where the signal equipment is at the end of its useful life based on age or ability to be maintained. In most cases intersections which have not been upgraded in approximately 20 to 25 years will fall into this category. Intersections that have major compliance issues with the MUTCD requirements will also fall into this category.
5. **Red Flag Intersections** are those intersections that were found to have issues that present serious safety issues. In such cases, the situation would be immediately reported to the Town with recommendations for actions to provide interim solutions. It should be noted that none of the project intersections were assigned to this category.

The results of the Qualitative Assessment are summarized as follows:

Qualitative Assessment	Number of Intersections
1 - Compliant Intersections	2
2 - Maintenance Needed Intersections	8
3 - Capital Improvement Intersections	12
4 - Replacement Intersections	9
5 - Red Flag Intersections	0
TOTAL	31

Recommended Intersection Improvements

This report has identified improvements which can be realized in the traffic signals which are owned by the City of Wallingford. The recommended improvement program is divided into two major categories:

1. System Level Improvements – These are projects which apply to the overall performance of the system. These include actions to improve traffic signal operations as a whole. Projects which address multiple locations, operational plans and similar actions.
2. Intersection Level Improvements – These items are recommended to bring a specific location to its original design, repair malfunctioning equipment or upgrade an intersection to current standards.

The following table summarizes the estimated costs associated with the System Level Improvements:

Project	Estimated Cost
Vehicle Detector Repair	\$30,000
System Coordination Repair	\$35,000
System Timing Update	\$50,000
TOTAL	\$115,000

The following tables summarize the estimated costs associated with the Intersection Level Improvements:

Intersection Cost Estimate Summary

Qualitative Assessment	Total
2 Maintenance Needed Intersections	\$402,000
3 Capital Improvement Intersections	\$1,718,000
4 Replacement Intersections	\$1,648,000
TOTAL	\$3,768,000

Intersection Cost Estimate Summary - Maintenance Needed Intersections

Intersection	Estimated Cost				Priority
	Equipment	Software	Geometric	Total	
59T Quinnipiac Street at Washington Street	\$47,000	\$0	\$30,000	\$77,000	1
60T Quinnipiac Street at North and South Cherry Street	\$46,000	\$0	\$16,000	\$69,000	2
4T South Colony Road (US Route 5) at Walgreens Shopping Center Driveway	\$32,000	\$5,000	\$0	\$37,000	3
30T Hall Avenue (Route 150) at Washington Street	\$51,000	\$0	\$0	\$51,000	4
54T South Turnpike Road at Cook Hill Road	\$27,000	\$5,000	\$1,000	\$33,000	5
55T South Turnpike Road at Cheshire Road	\$30,000	\$0	\$0	\$30,000	6
56T South Turnpike Road/Quinnipiac Street at Masonic Avenue/Route 15 Southbound Ramps	\$87,000	\$0	\$0	\$87,000	7
69T Research Parkway at Bristol-Myers Squibb Main Driveway	\$13,000	\$5,000	\$0	\$18,000	8
				TOTAL	\$402,000

Intersection Cost Estimate Summary - Capital Improvement Intersections

Intersection	Estimated Cost				Priority	
	Equipment	Software	Geometric	Total		
28T	Center Street (Route 150) at North and South Orchard Streets	\$151,000	\$0	\$0	\$151,000	1
5T	South Colony Road (US Route 5) at Ward Street	\$184,000	\$5,000	\$14,000	\$203,000	2
6T	North and South Colony Road (US Route 5) at Hall Avenue, Center Street, Quinnipiac Street	\$197,000	\$0	\$19,000	\$216,000	3
29T	Hall Avenue (Route 150) at North Cherry Street	\$163,000	\$0	\$0	\$163,000	4
57T	Quinnipiac Street at River Road/Route 15 Northbound Off-Ramp	\$142,000	\$0	\$0	\$142,000	5
58T	Quinnipiac Street at Ward Street	\$207,000	\$0	\$4,000	\$211,000	6
65T	North Main Street Extension at Barnes Industrial Road/Wal-Mart Driveway	\$176,000	\$0	\$0	\$176,000	7
66T	North Main Street Extension at Ives Road	\$148,000	\$0	\$0	\$148,000	8
68T	Barnes Industrial Road North at Barnes Road	\$103,000	\$0	\$0	\$103,000	9
73T	John Street at South Cherry Street	\$115,000	\$0	\$0	\$115,000	10
74T	Hope Hill Road at Yalesville Fire Department	\$77,000	\$0	\$0	\$77,000	11
75T	North Colony Street (US Route 5) at Holy Trinity Church	\$2,000	\$0	\$11,000	\$13,000	12
				TOTAL	\$1,718,000	

Intersection Cost Estimate Summary - Replacement Intersections

Intersection	Estimated Cost				Priority
	Equipment	Software	Geometric	Total	
27T Center Street (Route 150) at North and South Main Streets	\$192,000	\$0	\$46,000	\$238,000	1
26T Center Street (Route 150) at North and South Elm Streets	\$161,000	\$0	\$43,000	\$204,000	2
25T Center Street (Route 150) at Silver Pond Apartments Driveway	\$132,000	\$0	\$18,000	\$150,000	3
67T North Main Street Extension at Stop & Shop Shopping Center Driveway	\$163,000	\$0	\$16,000	\$179,000	4
61T Ward Street at South Cherry Street	\$166,000	\$0	\$38,000	\$204,000	5
64T North Main Street Extension at Beaumont Road	\$163,000	\$0	\$13,000	\$176,000	6
63T North Plains Industrial Road at Pent Highway	\$135,000	\$0	\$16,000	\$151,000	7
62T Ward Street at South Orchard Street	\$166,000	\$0	\$16,000	\$182,000	8
32T Hall Avenue (Route 150) at Masonic Avenue/Fire Dept. Headquarters	\$149,000	\$0	\$15,000	\$164,000	9
			TOTAL	\$1,648,000	

Prioritization of Improvements

This report also prioritized the system and intersection improvements recommended. The following list of priorities is based primarily on the condition of the existing equipment as determined by the field inventory and a review of traffic signal maintenance logs.

Priority Area 1: Repair vehicle detection, traffic signal coordination, and traffic signal timing system wide. Simple timing changes and coordination of operations at adjacent intersections could significantly improve traffic operations within the Town. Repair of broken vehicle detectors will also reduce the amount of unused time given to non-coordinated signal phases. These are relatively low cost improvements that could be implemented in a short period of time and could have a significant effect on traffic signal operations town wide.

Priority Area 2: Implement recommended improvements along Center Street which include the following intersections:

- 25T - Center Street (Route 150) at Silver Pond Apartments Driveway
- 26T - Center Street (Route 150) at North and South Elm Streets
- 27T - Center Street (Route 150) at North and South Main Streets
- 28T - Center Street (Route 150) at North and South Orchard Streets

These intersections are among the oldest in the Town system. Most of the equipment is outdated and reaching the end of its useful life. A review of maintenance records shows that these intersections require the most on-going maintenance.

Priority Area 3: Implement recommended improvements at project intersections along Hall Avenue, Quinnipiac Street, and South Colony Road which include the following intersections:

- 5T - South Colony Road (US Route 5) at Ward Street
- 6T - North and South Colony Road (US Route 5) at Hall Avenue, Center Street, Quinnipiac Street
- 29T - Hall Avenue (Route 150) at North Cherry Street
- 57T - Quinnipiac Street at River Road/Route 15 Northbound Off-Ramp
- 58T - Quinnipiac Street at Ward Street
- 59T - Quinnipiac Street at Washington Street
- 60T - Quinnipiac Street at North and South Cherry Street
- 61T - Ward Street at South Cherry Street

Priority Area 4: Implement recommended improvements at all intersections categorized as "Maintenance needed" which include the following intersections:

- 4T - South Colony Road (US Route 5) at Walgreens Shopping Center Driveway
- 30T - Hall Avenue (Route 150) at Washington Street
- 54T - South Turnpike Road at Cook Hill Road
- 55T - South Turnpike Road at Cheshire Road

Traffic Signal Inventory

Wallingford, CT

- 56T - South Turnpike Road/Quinnipiac Street at Masonic Avenue/Route 15 Southbound Ramps
- 59T - Quinnipiac Street at Washington Street
- 60T - Quinnipiac Street at North and South Cherry Street
- 69T - Research Parkway at Bristol-Myers Squibb Main Driveway

Most intersections in this category require improvements that are in the low to middle price range. These intersections could most likely be repaired using existing town maintenance contracts in a short time frame. These improvements were given a lower priority because they are typically not critical to the safe operation of the traffic signal.

Priority Area 5: Implement recommended improvements along North Main Street Extension which includes the following intersections:

- 64T - North Main Street Extension at Beaumont Road
- 65T - North Main Street Extension at Barnes Industrial Road/Wal-Mart Driveway
- 66T - North Main Street Extension at Ives Road
- 67T - North Main Street Extension at Stop & Shop Shopping Center Driveway

These closely spaced intersections located in a heavy Industrial and commercial area could benefit from improved timing and traffic signal coordination. The traffic signal located at the driveway from the Stop & Shop Plaza appears to be the oldest in the Town system.

Priority Area 6: Implement recommended improvements at the remaining project intersections which include:

- 32T - Hall Avenue (Route 150) at Masonic Avenue/Fire Dept. Headquarters
- 62T - Ward Street at South Orchard Street
- 63T - North Plains Industrial Road at Pent Highway
- 68T - Barnes Industrial Road North at Barnes Road
- 73T - John Street at South Cherry Street
- 74T - Hope Hill Road at Yalesville Fire Department
- 75T - North Colony Street (US Route 5) at Holy Trinity Church

TABLE OF CONTENTS

Executive Summary	i
1.0 Introduction	1
1.1 Project Purpose	1
1.2 Study Methodology	1
2.0 Traffic Signal Inventory and Qualitative Assessment	3
2.1 Intersection Inventory, Deficiencies, and Qualitative Assessments	4
3.0 Qualitative Assessment Results	78
4.0 Recommendations	82
4.1 System Level Improvements	82
4.2 System Level Improvements Cost Estimate Summary	84
4.3 Intersection Level Improvements.....	84
4.4 Intersection Level Cost Estimate Summary	93
4.5 Recommended Prioritization.....	97
Appendix A - Intersection Plans	
Appendix B - Field Inspection Sheets	
Appendix C - Intersection Photo Logs	
Appendix D - Project Cost Estimates	

LIST OF FIGURES

Figure 1 - Study Intersections.....	2
Figure 2 - Intersection Status	80
Figure 3 - Coordination Zones	83

LIST OF TABLES

Table 1 - Qualitative Assessment Summary by Intersection.....	78
Table 2 - Qualitative Assessment Summary by Category.....	81
Table 3 - System Level Improvements Cost Estimate Summary	84

Traffic Signal Inventory
Wallingford, CT

Table 4 - Intersection Cost Estimate Summary	93
Table 5 - Intersection Cost Estimate Summary - Maintenance Needed Intersections.....	94
Table 6 - Intersection Cost Estimate Summary - Capital Improvement Intersections.....	95
Table 7 - Intersection Cost Estimate Summary - Replacement Intersections.....	96

1.0 INTRODUCTION

BETA Group, Inc. was retained by the South Central Regional Council of Governments (SCRCOG), on behalf of the Town of Wallingford, CT, to conduct an inventory of traffic signal equipment and intersection geometry at 31 town owned locations. This project was funded through the Federal Highway Administration (FHWA), the Connecticut Department of Transportation (CDOT) and SCRCOG per a SCRCOG-CDOT Fiscal Year 2012-2012 planning agreement as described in SCRCOG's *Fiscal Year 2012 Unified Planning Work Program* ("UPWP").

1.1 Project Purpose

The purpose of this project was to gather data relating to the type and condition of the existing traffic signal equipment and geometry at the 31 project locations. These data were then used to develop a qualitative assessment of existing operations, and potential improvement strategies which may require further study. The study intersections are presented in Figure 1.


1.2 Study Methodology

This study was performed in three parts. Part one involved the collection of record signal plans and a field visit to each of the 31 project locations to perform an inventory of existing traffic signal equipment and intersection geometry. Upon completion of the field inventory, the project intersections were reviewed by senior traffic signal engineers to assess the needed modifications and improvements. In the last part, the qualitative assessments were drafted into improvement recommendations for each of the study intersection.

A Microsoft Access Database was created and populated with existing traffic signal data. This database will serve as the basis for the Town to monitor the condition of signal equipment as traffic patterns change due to: future development, background growth, and the influence of future transportation improvements.

Figure 1 - Study Intersections

Study Intersections

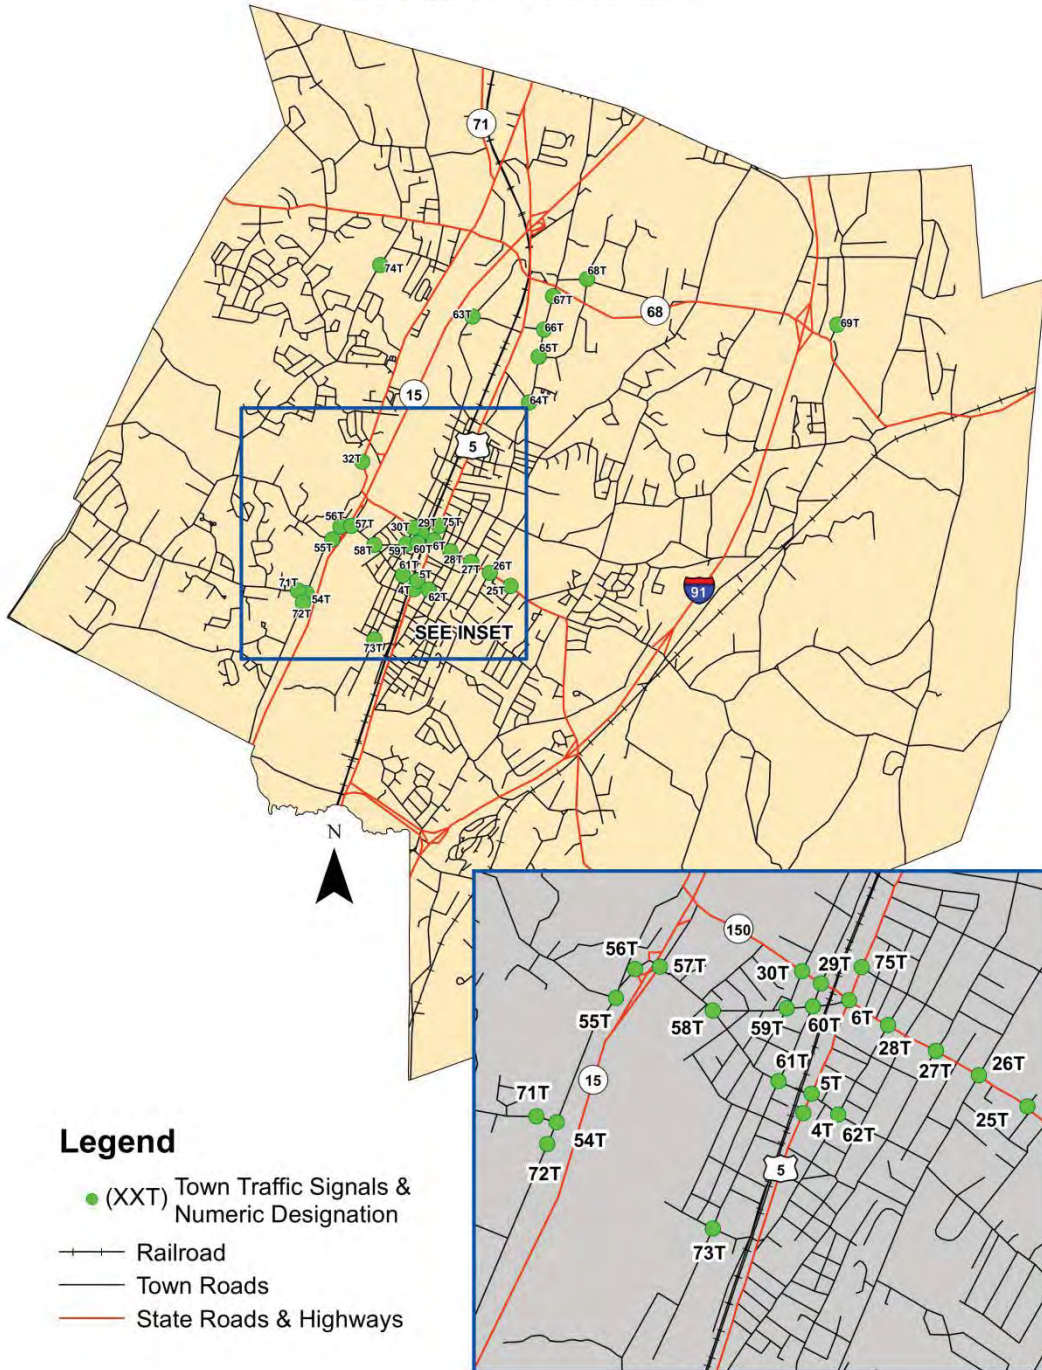

2.0 TRAFFIC SIGNAL INVENTORY AND QUALITATIVE ASSESSMENT

The following section provides the results of the traffic signal and intersection geometry inventories. During the field visit the following items were inventoried:

- Traffic signal controller, cabinet, and ancillary equipment;
- Traffic signal phasing and timing settings;
- Size, type, location, and condition of vehicular and pedestrian signal heads;
- Location of pedestals, mast arms and span wires;
- Pedestrian push-buttons;
- Accessible Pedestrian Signals (APS);
- Regulatory signing;
- Vehicle detector type, location and function;
- Emergency vehicle pre-emption equipment;
- Traffic signal interconnection

The record plans were also reviewed during the field visit for changes which might have occurred since the plan was developed. A photo log of the intersection was also obtained.

Each of the 31 project intersections were evaluated by a team of senior traffic engineers following the field inventory. Each intersection was classified into one of the following categories during the qualitative assessment:

1. **Compliant Intersections** are those that have no major violations of the requirements of the Manual on Uniform Traffic Control Devices (MUTCD). Equipment at these intersections is typically operating properly and providing good traffic operations.
2. **Maintenance Needed Intersections** are those intersections that require routine maintenance. Minor equipment issues and operational changes fall into this category.
3. **Capital Improvement Intersections** are those intersections which require replacement or upgrading of hardware that shows significant deterioration or operational issues. These intersections typically have deteriorated structural supports or vehicle damage.
4. **Replacement Intersections** are those intersections where the signal equipment is at the end of its useful life based on age or ability to be maintained. In most cases intersections which have not been upgraded in approximately 20 to 25 years will fall into this category. Intersections that have major compliance issues with the MUTCD requirements will also fall into this category.
5. **Red Flag Intersections** are those intersections that were found to have issues that present serious safety issues. In such cases, the situation would be

immediately reported to the Town with recommendations for actions to provide interim solutions. It should be noted that none of the project intersections were assigned to this category.

2.1 Intersection Inventory, Deficiencies, and Qualitative Assessments

The following section presents the results of the field inventory, deficiencies identified, and the Qualitative Assessment Category assigned to each project intersection.

2.1.1 Intersection 4T - South Colony Road (US Route 5) at Walgreens Shopping Center Driveway

This three-legged, T-type intersection is controlled by a three phase, semi-actuated traffic signal. A leading, protected left-turn signal phase is provided on the South Colony Road southbound approach and left-turns are permitted during the following through phase. Pedestrians are permitted to cross South Colony Road concurrently with the Walgreens Driveway traffic. The driveway approaches the intersection from the east and the traffic signal phase is actuated by wire loop detectors. A pre-emption detector is provided and a pre-emption routine is programmed for the South Colony Road southbound approach. Vehicle signal heads are supported by a single span wire assembly. Wire loop detectors and shelf mounted amplifiers are used for vehicle detection.



The provided plan is marked as revision number 2 and is dated 2008. The South Colony Road southbound approach is a multi-lane approach. A concrete sidewalk and sidewalk ramps are provided on the east side of South Colony Rd. The following deficiencies were identified during the inventory:

Wire nuts are used for splices in one or more hand holes.



The doghouse signal head is damaged.



- Controller timing parameters do not match the values on the record plan. All values are within the Min/Max ranges shown on the plan.
- The southbound left-turn phase is programmed with Max recall.
- Traffic signal coordination and time-of-day settings have not been programmed. The signal operates in the Free Mode at all times.
- Eight-inch, three-section vehicular signal indications are currently used to indicate the concurrent pedestrian phase.
- Eight-inch signal indications are provided on the Walgreens Driveway approach. All other indications are 12-inch diameter.
- One of the two signal heads provided on the northbound and southbound approaches is located too close to the stop line and does not conform to the requirements of the MUTCD.
- Loop Detector D1 is not programmed in the traffic signal controller to extend Phase 1 as shown on the plan.
- The emergency vehicle pre-emption function does not appear to be functioning on the South Colony Road southbound approach.
- Emergency vehicle pre-emption is not provided on the South Colony Road northbound approach.
- Backplates are not provided on span wire mounted signal heads.
- The cabinet light bulb is burned out.
- Dust and dirt should be vacuumed from the cabinet and the air filter should be replaced.
- The color of the signal heads and visors is chipped and faded.

Qualitative Assessment

Overall, traffic signal equipment and intersection geometry are in good condition. Updates were last performed at this intersection in 2008. The issues that are present are minor in nature and could be resolved by maintenance activities. The Qualitative Assessment category assigned to this intersection is:

2 - Maintenance Needed

2.1.2 Intersection 5T - South Colony Road (US Route 5) at Ward Street

This four-legged intersection is controlled by a four-phase, semi-actuated traffic signal. Ward Street eastbound and westbound traffic are served by a single phase and eastbound traffic, which crosses the rail road tracks, is provided with a lagging clear-out phase. South Colony Street traffic is served by a single phase, and pedestrians cross during an exclusive pedestrian phase. Vehicle signal heads are supported by a single span wire assembly. Wire loop detectors and shelf mounted amplifiers are used for vehicle detection.



This intersection is located 130 feet east of the Amtrak regional railroad line. Traffic signal operations are pre-empted during train crossings. Internally illuminated “No Left Turn” and “No Right Turn” signs are provided on the South Colony Road northbound and southbound approaches, respectively. These signs are activated during train pre-emption and prohibit turns onto Ward Street westbound.

The provided plan is dated 1995. This intersection is located in a commercial zone. The South Colony Road northbound approach consists of an exclusive left-turn lane and a shared through/right-turn lane. All other approaches consist of a single travel lane. Concrete sidewalks and sidewalk ramps are provided on all four corners of the intersection. The following deficiencies were identified during the inventory:

Traffic Signal Inventory
Wallingford, CT

<p>Wire nuts are used for splice connections in one or more hand holes.</p> <p>Hand hole covers are not bonded.</p>	 A photograph showing electrical wiring in a hand hole. Two blue wire nuts are used to splice the wires. The hand hole cover is not bonded to the wall.
<p>Pavement markings and some sidewalk ramps are in poor condition.</p>	 A photograph of a crosswalk on a street. The pavement markings are faded and the crosswalk is cracked, indicating poor condition.
<p>Large vehicles have difficulty turning at one or more corners.</p>	 A photograph of a large white semi-trailer truck parked on a street. The truck has "CARLISLE" and "CANISEE CO." written on the side. The truck is parked in a narrow space, illustrating difficulty turning at corners.

Pedestrian push-buttons, signs and pedestrian signal heads are different types.



- The on-street master traffic signal controller is located at this intersection; however, it is disconnected from the communication system and is not powered.
- This intersection operates in the Free Mode at all times.
- No coordination settings are programmed.
- Train pre-emption is working properly, but it does not appear that emergency vehicle pre-emption is functioning.

- One of the two signal heads provided on the northbound, southbound and eastbound approaches is located too close to the stop line and does not conform to the requirements of the MUTCD.
- Most existing signal indications are eight-inch diameter indications.
- Existing pedestrian signal heads present word legends for Walk and Don't Walk.
- Pedestrian clearance interval timing should be verified for conformance with the latest revision of the MUTCD.
- An audible pedestrian tone is not provided during the exclusive pedestrian phase.
- Backplates are not provided on span wire mounted signal heads.
- Dust and dirt should be vacuumed from the cabinet and the air filter should be replaced.
- The color of the signal heads and visors is chipped and faded.

Qualitative Assessment

Overall, intersection geometry is in good condition, but the traffic signal equipment is in poor condition. This intersection was constructed in 1995 and the equipment is now 17 years old. The issues that are present will require more than routine maintenance to resolve. The Qualitative Assessment category assigned to this intersection is:

3 - Capital Improvement Intersection

2.1.3 Intersection 6T - North and South Colony Road (US Route 5) at Hall Avenue, Center Street, Quinnipiac Street

This five-legged intersection is controlled by a six-phase, semi-actuated traffic signal. A leading protected left-turn signal phase is provided on the South Colony Road northbound approach and the Quinnipiac Street eastbound approach. A lagging protected left-turn signal phase is provided on the North Colony Road southbound approach. Left-turns are permitted from all roadways during the through traffic phases. Pedestrian are permitted to cross during an exclusive pedestrian phase. All traffic signal phases are actuated with wire loop detectors and rack mounted amplifiers. Vehicle signal heads are supported by two span wire assembly utilizing three span poles. An audible tone is provided during the exclusive



pedestrian phase.

This intersection is located 300 feet east of the Amtrak regional railroad line. Traffic signal operations are pre-empted during train crossings. A “No Left Turn” sign and a “No Right Turn” sign are provided on South Colony Road northbound and southbound approaches, respectively. These signs are illuminated during a train pre-emption to prohibit turns onto Quinnipiac Street and Hall Avenue. Three emergency vehicle pre-emption routines are programmed.

The provided plan is marked as revision number two and is dated July 1997. Decorative lighting, trash receptacles, landscaping, brick paver treatments and a bus stop are provided at this location. Concrete sidewalks and sidewalk ramps are present on each corner. An exclusive left-turn lane and a shared through/right-turn lane are provided on North and South Colony Road and on Quinnipiac Street. A shared through/left-turn lane and a shared through/right-turn lane are provided on the Center Street (Route 150) approach. Hall Avenue consists of two westbound departure lanes. The following deficiencies were identified during the inventory:

<p>Railroad crossing pavement markings are in poor condition.</p>	
<p>A concrete hand hole is damaged at the intersection of Hall Avenue and Quinnipiac Street.</p>	

Existing sidewalk ramps lack detectable warning strips and do not meet current ADA requirements.

A section of brick pavers behind the sidewalk ramp has settled causing a hazard to pedestrians.



Wire nuts are used for splice connections in several hand holes.

Some hand hole covers are not grounded, lack duct seal and/or are not set flush to grade.



- Grout at the base of the span pole located on the northeast Corner of Hall Avenue and North Colony Road is deteriorated.
- Traffic signal coordination settings are programmed, but the controller is operating in Free Mode at all times. According to the controller's program change log, the signal is operating in the Free Mode at all times on a command from the master system controller.
- Emergency vehicle pre-emption for the Quinnipiac Street approach appears to be the only functioning pre-emption phase. The pre-emption phase selector rack card for the remaining two pre-emption routines is not connected to the card rack and is inactive.
- One of the two signal heads provided on the northbound approach is located too close to the stop line and does not conform to the requirements of the MUTCD.
- There is evidence in the controller cabinet of mice infestation. It appears that the debris is old and the mice have been removed from the cabinet, and all entrances were sealed.
- Backplates are not provided on span wire mounted signal heads.

- Dust and debris should be vacuumed from the cabinet and the air filter should be replaced.
- The color of the signal heads and visors is chipped and faded.

Qualitative Assessment

Overall, intersection geometry is in good condition, but the traffic signal equipment is in poor condition. This intersection was constructed in 1997 and the equipment is now 15 years old. The issues that are present will require more than routine maintenance to resolve. The Qualitative Assessment category assigned to this intersection is:

3 - Capital Improvement Intersection

2.1.4 Intersection 25T - Center Street (Route 150) at Silver Pond Apartments Driveway

This three-legged, T-type intersection is controlled by a three-phase, semi-actuated traffic signal. Center Street northbound and southbound movements are served in phase one; an exclusive pedestrian phase is provided in phase two; and the driveway from the Silver Pond Apartments is served in phase three. Vehicle signal heads are supported by a Y-type span wire assembly, utilizing three span poles. An audible tone is provided during the exclusive pedestrian phase. Wire loop detectors and rack mounted amplifiers are used for vehicle detection.

The provided plan is dated April-1997. All approach roadways consist of single lanes. Concrete sidewalks are provided along each side of Center Street (Route 150). The following deficiencies were identified during the inventory:



Traffic Signal Inventory
Wallingford, CT

<p>A concrete hand hole is damaged on the north side of Center Street (Route 150).</p>	
<p>Pavement markings are in poor condition. Pedestrian ramps are not provided at crosswalks.</p>	
<p>Pavement on the Silver Pond Apartments Driveway is in poor condition. Vehicle detection loops are currently functioning properly, but the pavement condition makes these loops susceptible to failure.</p>	

The color of the signal heads and visors is chipped and faded.



- The design plans indicate that this intersection is intended to operate as part of the Downtown closed-loop traffic signal system, however, the controller operates in the Free Mode at all times.
- Communication with the closed-loop system should be tested.
- Programmed time settings do not match the record plans. Some of the programmed times do not fall within the Min/Max ranges presented on the record plans.
- One of the two signal heads provided on the westbound and southbound approaches is located too close to the stop line and does not conform to the requirements of the MUTCD.
- The intersection does not include emergency pre-emption equipment.
- Tinting on the face of the pedestrian signal indications is peeling.
- Backplates are not provided on span wire mounted signal heads.
- Dust and dirt should be vacuumed from the cabinet and the air filter should be replaced.
- The color of the signal heads and visors is chipped and faded.

Qualitative Assessment

Overall, traffic signal equipment and intersection geometry are in poor condition. This intersection was constructed in 1997 and the equipment is now 15 years old. The issues that are present will require more than routine maintenance to resolve. The Qualitative Assessment category assigned to this intersection is:

4 - Replacement Intersection

2.1.5 Intersection 26T - Center Street (Route 150) at North and South Elm Streets

This four-legged intersection is controlled by a semi-actuated traffic signal. A leading left-turn phase is provided for Center Street southbound vehicles in Phase 1 and northbound and southbound vehicles are permitted during Phase 2. An exclusive pedestrian phase is provided in Phase 5. North and South Elm Street signal phases are arranged in the standard NEMA dual ring configuration and feature leading left turn phases (Phase 3 and 7) which are followed by through phases (Phase 4 and 8). Left turns are permitted during the through phases. The signal currently operates in the Free Mode at all times. Vehicle signal heads are supported by a Y-type span wire assembly. An audible pedestrian tone is provided during the exclusive pedestrian phase. Wire loop detectors and shelf mounted amplifiers are used for vehicle detection.



The plan provided is dated April 1990. Concrete sidewalks are provided along each side on all roadways and sidewalk ramps and crosswalks are provided on all four corners. The following deficiencies were identified during the inventory:



Traffic Signal Inventory
Wallingford, CT


The pedestrian traffic signal push-buttons and signs are a mix of older and newer types.



The crosswalk pavement markings are in poor condition.



A ground rod is exposed and a riser conduit is open on the utility pole located on the northwest corner.

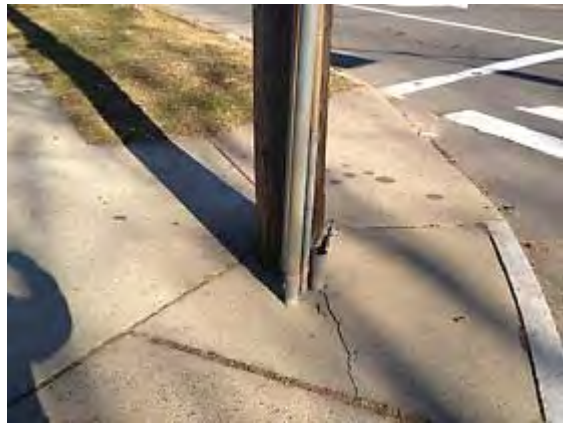

A drip loop has uncoiled and is hanging in front of a signal head.



- The lock on this cabinet should be changed to match the key used at most other Town maintained intersections.
- Programmed time settings do not match record plan times; however, all values are within the Min/Max ranges presented on the record plan.
- The record plans indicate that this intersection is intended to operate as part of the Downtown closed-loop traffic signal system, however it operates in the Free Mode at all times. Communication with the closed-loop system should be tested.
- Most existing signal indications are eight-inch diameter indications.
- One of the two signal heads provided on the eastbound approach is located too close to the stop line and does not conform to the requirements of the MUTCD.
- The intersection does not include emergency pre-emption equipment.
- A flash transfer relay is wired on the shelf, instead of in the back panel.
- Backplates are not provided on span wire mounted signal heads.
- The cabinet light bulb is burned out.
- Dust and dirt should be vacuumed from the cabinet and the air filter should be replaced.
- The color of the signal heads and visors is faded.

Qualitative Assessment

Overall, traffic signal equipment and intersection geometry are in poor condition. This intersection was constructed in 1990 and the equipment is now 22 years old. The issues that are present will require more than routine maintenance to resolve. The Qualitative Assessment category assigned to this intersection is:

4 - Replacement Intersection

2.1.6 Intersection 27T - Center Street (Route 150) at North and South Main Streets

This four-legged intersection is controlled by a seven-phase, semi-actuated traffic signal. The Center Street eastbound and westbound approaches are served by leading protected left-turn phases (Phases 1 and 5). Left-turns are also permitted to move with the adjacent through movements in the following phase (Phases 2 and 6). The North/South Main Street approaches are provided with a single protected left-turn phase and a single through phase during which left-turns are also permitted to move. Pedestrians cross during an exclusive pedestrian phase. Right turn on red is prohibited on all approaches. Vehicle signal heads are supported by a single span wire assembly. An audible pedestrian tone is provided during the exclusive pedestrian phase. Wire loop detectors and shelf mounted amplifiers are used for vehicle detection.



The on-street master traffic signal controller is located at this intersection. The master is currently operating, but most connected intersections do not seem to be receiving plan changes from the master and therefore operate in the Free Mode at all times.

The provided plan is dated May 29, 1991, and is labeled a revision number four. An exclusive left-turn lane and a shared through/right-turn lane are provided on all approaches. A one way entrance to a parking lot for businesses along Main Street is located in the northwest quadrant of the intersection. Concrete sidewalks, sidewalk ramps and crosswalks are provided on all corners (including the parking lot entrance). Brick pavers, ornamental lighting and other streetscape amenities are also provided. The following deficiencies were identified during the inventory:

Traffic Signal Inventory
Wallingford, CT

Conduits are not sealed in the controller cabinet.



The pedestrian push-buttons and signs are a mix of older and newer types.



Wire nuts are used for splice connections in one or more hand holes.

Several hand holes could not be opened due to rusted bolts.



Span poles and pedestrian poles have been painted, but the colors do not match and are faded.

Some span poles are missing bolt covers.



- The lock on the cabinet door was difficult to turn and the door was difficult to open.
- Programmed time settings do not match record plan times; however, all values are within the Min/Max ranges presented on the record plan.
- Communications between the on-street master and the local controllers should be tested and repaired where necessary.

- The record plans indicate that this intersection is intended to operate as part of the Downtown closed-loop traffic signal system, however it operates in the Free Mode at all times.
- One of the two signal heads provided on the northbound and southbound approaches is located too close to the stop line and does not conform to the requirements of the MUTCD.
- Most existing signal indications are eight-inch diameter indications.
- The intersection does not include emergency pre-emption equipment.
- Backplates are not provided on span wire mounted signal heads.
- The cabinet light bulb is burned out.
- Dust and dirt should be vacuumed from the cabinet and the air filter should be replaced.
- The color of the signal heads and visors is chipped and faded.

Qualitative Assessment

Overall, traffic signal equipment and intersection geometry are in poor condition. This intersection was constructed in 1991 and the equipment is now 21 years old. The issues that are present will require more than routine maintenance to resolve. The Qualitative Assessment category assigned to this intersection is:

4 - Replacement Intersection

2.1.7 Intersection 28T - Center Street (Route 150) at North and South Orchard Streets

This four-legged intersection is controlled by a four-phase, semi-actuated traffic signal. The North Orchard Street approach intersects Center Street approximately 30 feet to the east of the South Orchard Street intersection with Center Street. The Center Street eastbound and westbound approaches are served during the first signal phase. Center Street eastbound left-turns are permitted to move with the adjacent through movements. The North/South Orchard Street approaches are provided with split phases, where each street is given its own signal phase. Pedestrians cross during an exclusive pedestrian phase. Right turn on red is prohibited on all approaches. Vehicle signal heads are supported by a single span wire assembly. An audible pedestrian tone is provided during the exclusive pedestrian phase. Wire loop detectors and shelf mounted amplifiers are used for vehicle detection.



Traffic Signal Inventory
Wallingford, CT

The provided plan is dated May-2004, and is marked as revision number five. Concrete sidewalks, sidewalk ramps and crosswalks are provided on all corners. Brick pavers, ornamental lighting and other streetscape amenities are also provided at this location. The following deficiencies were identified during the inventory:

<p>Conduits are not sealed in the controller cabinet.</p>	
<p>The pedestrian push-buttons are a mix of older and newer types.</p>	

Wire nuts are used for splice connections in one or more hand holes.

Some hand hole covers are not bonded.

Conduits are not sealed.



One or more span poles have been painted and do not match colors and are faded.

One or more span poles are missing bolt covers and/or exhibit slight corrosion at the base.



- An older Peek 3000 controller is currently in operation. It appears that this controller is a replacement for the Transyt 1880EL controller which sits non-operational in the cabinet.
- Coordination parameters have not been programmed. The signal operates in the Free Mode at all times.
- Controller timings do not match the record plan, but all parameters are within the acceptable Min/Max ranges shown on the plan.
- All existing signal indications are eight-inch diameter indications.

- One of the two signal heads provided on the northbound, eastbound and westbound approaches is located too close to the stop line and does not conform to the requirements of the MUTCD.
- The intersection does not include emergency pre-emption equipment.
- The cabinet light bulb is burned out.
- Backplates are not provided on span wire mounted signal heads.
- Dust and dirt should be vacuumed from the cabinet and the air filter should be replaced.
- The color of the signal heads and visors is chipped and faded.

Qualitative Assessment

Overall, intersection geometry is in good condition, but the traffic signal equipment is in poor condition. This intersection was last updated in 2004 but most equipment is much older. The issues that are present will require more than routine maintenance to resolve. The Qualitative Assessment category assigned to this intersection is:

3 - Capital Improvement Intersection

2.1.8 Intersection 29T - Hall Avenue (Route 150) at North Cherry Street

This four-legged intersection is controlled by a four-phase, fully-actuated traffic signal. Hall Avenue eastbound and westbound traffic are served by separate consecutive signal phases. North Cherry Street traffic is served by a single phase, and pedestrians are provided with an exclusive phase. Vehicle signal heads are supported by a single span wire assembly. An audible pedestrian tone is provided during the exclusive pedestrian phase. Wire loop detectors and rack mounted amplifiers are used for vehicle detection.

This traffic signal operates as part of the Downtown coordinated traffic signal system between 6:30 AM and 6:30 PM. The signal operates in the Free Mode during the overnight hours. Coordination and Time of Day functions are operating as programmed

This intersection is located 250 feet west of the Amtrak regional railroad line. Traffic signal operations are pre-empted during train crossings.



Traffic Signal Inventory
Wallingford, CT

The provided plan is dated July-1997. This intersection is located within a mixed-use commercial/residential area. Concrete sidewalks are provided along all roadways and driveways are located in close proximity to the intersection. New ramps and sidewalks are present on the northwest and southwest corners. The following deficiencies were identified during the inventory:

<p>A NO RIGHT TURN sign is leaning over the curb line.</p>	
<p>One or more hand hole covers are not grounded. Wire nuts are used for splice connections. Hand hole covers have rusted or missing bolts. Ducts are not sealed.</p>	
<p>Pavement markings are worn.</p>	

A hand hole is partially buried.



- The system detector located on the departure lane of North Cherry Street northbound (SD8) is malfunctioning.
- The emergency vehicle phase selector card is not connected to the card rack; therefore, none of the emergency vehicle pre-emption phases function.
- Programmed time settings do not match the record plans. Some of the programmed times do not fall within the Min/Max ranges presented on the record plans.
- One of the two signal heads provided on the eastbound and westbound approaches is located too close to the stop line and does not conform to the requirements of the MUTCD.
- Backplates are not provided on span wire mounted signal heads.
- The cabinet light bulb is burned out.
- Dust and dirt should be vacuumed from the cabinet and the air filter should be replaced.
- The color of the signal heads and visors is chipped and faded.

Qualitative Assessment

Overall, intersection geometry is in good condition, but the traffic signal equipment is in poor condition. This intersection was constructed in 1997 and the equipment is now 15 years old. The issues that are present will require more than routine maintenance to resolve. The Qualitative Assessment category assigned to this intersection is:

3 - Capital Improvement Intersection

2.1.9 Intersection 30T - Hall Avenue (Route 150) at Washington Street

This four-legged intersection is controlled by a four-phase, fully-actuated traffic signal. A leading protected left-turn signal phase is provided on the Hall Avenue eastbound approach. Washington Street traffic is served by a single signal phase, and pedestrians are provided with an exclusive signal phase. Vehicle signal heads are supported by a single span wire assembly. An audible pedestrian tone is provided during the exclusive pedestrian phase. Wire loop detectors and rack mounted amplifiers are used for vehicle detection.

Design plans show that this traffic signal is intended to operate as part of the Downtown coordinated traffic signal system between 7:00 AM and 9:00 PM, but the signal operates in the Free Mode at all times.



The provided plan is dated July-1997. Single approach and departure lanes are provided on each roadway. New concrete sidewalks and sidewalk ramps are present at this location. Crosswalks are present on all roadways. The following deficiencies were identified during the inventory:

<p>Several hand holes and the controller cabinet were found in locations other than those shown on the plan.</p> <p>Several hand holes had rusted or missing cover bolts.</p>	Two photographs showing the intersection. The top photograph shows a street view with a utility pole and a traffic signal cabinet. The bottom photograph shows a street view with a traffic signal head and a utility pole.
---	---

The crosswalks and stop bars have not been painted on some approaches.



- System Detectors SD7 and SD8 on the departure lanes of Washington Street are malfunctioning.
- The stop bar detector (D4B) on the Washington Street southbound approach is malfunctioning.
- One of the two signal heads provided on the eastbound approach is located too close to the stop line and does not conform to the requirements of the MUTCD.
- The record plans indicate that the signal is intended to operate with two emergency vehicle pre-emption routines on Hall Avenue, however, no pre-emption routines are programmed in the traffic signal controller. A rack mounted pre-emption phase selector card is present and powered in the cabinet, and two detectors are mounted on the overhead span wire.
- Programmed time settings do not match the record plans. Some of the programmed times fall outside of the Min/Max ranges presented on the record plans.
- The record plans indicate that this intersection is intended to operate as a part of the Downtown closed-loop traffic signal system, but coordination settings are not programmed in the traffic signal controller, and the signal operates in the Free Mode at all times.
- The cable drip loop for the Hall Avenue eastbound pre-emption detector has fallen out and the cable hangs in front of one of the Washington Street northbound signal faces.
- Backplates are not provided on span wire mounted signal heads.
- Dust and dirt should be vacuumed from the cabinet and the air filter should be replaced.
- The color of the signal heads and visors is chipped and faded.

Qualitative Assessment

Overall, traffic signal equipment and intersection geometry are in good condition. Updates were last performed at this intersection in 2008. The issues that are present are minor in nature and could be resolved by maintenance activities. The Qualitative Assessment category assigned to this intersection is:

2 - Maintenance Needed

2.1.10 Intersection 32T - Hall Avenue (Route 150) at Masonic Avenue/Fire Department Headquarters

This location consists of two separate T-type intersections which operate on the same traffic signal controller. The northern intersection is the intersection of Masonic Avenue and the driveway for the Fire Department Headquarters building, and the southern intersection is the intersection of Masonic Avenue and Masonic Drive. Both Masonic Drive and the Fire Department driveway approach Masonic Avenue from the west.

The Masonic Drive intersection consists of two-phase, vehicle-actuated, signal operation. The fire department driveway intersection is under flashing operation except during an emergency vehicle pre-emption, when a signal phase is called that stops northbound and southbound traffic in front of the fire department and permits northbound traffic to proceed at the Masonic Drive intersection. Vehicle signal heads are supported by a two span wire assemblies, with one assembly located at each intersection. Wire loop detectors and shelf mounted amplifiers are used for vehicle detection.



The provided plan is dated February-1998. The plan provided did not provide a plan view layout of the intersection and related signal equipment. A single travel lane is provided on each approach. No sidewalks, sidewalk ramps or crosswalks are present at this location. The following deficiencies were identified during the inventory:

<p>Signal head and visor color are faded and peeling.</p>	
<p>The stop bar pavement markings are worn on all approaches.</p>	

- Traffic signal controller is out-dated, but appears to be operating safely and reliably.
- Programmed time settings do not match the record plans. Some of the programmed times do not fall within the Min/Max ranges presented on the record plans.
- The signal heads provided on the eastbound approach may be located too close to the stop line and may not conform to the requirements of the MUTCD.
- Pedestrian signals are not provided at this intersection.
- Backplates are not provided on span wire mounted signal heads.
- The cabinet does not have an internal light bulb to illuminate the cabinet when the cabinet door is opened.
- Dust and dirt should be vacuumed from the cabinet and the air filter should be replaced.
- The color of the signal heads and visors is chipped and faded.

Qualitative Assessment

Overall, traffic signal equipment and intersection geometry are in poor condition. This intersection was updated in 1998, but the equipment is much older than that. The issues that are present will require more than routine maintenance to resolve. The Qualitative Assessment category assigned to this intersection is:

4 - Replacement Intersection

**2.1.11 Intersection 54T - South Turnpike Road
at Cook Hill Road**

This three-legged, T-type intersection is controlled by a three-phase, fully-actuated traffic signal. The South Turnpike Road northbound approach is provided with a leading, actuated, left-turn phase and the South Turnpike Road northbound and southbound through movements follow in the next signal phase. Cook Hill Road is served in phase three. Vehicle signal heads are supported by a single span wire assembly. Pedestrians are permitted to cross concurrently with parallel vehicle traffic. Wire loop detectors and shelf mounted amplifiers are used to provide vehicle detection.



The provided plan is dated February-1996. No sidewalks, sidewalk ramps, or crosswalks are provided at this location. The following deficiencies were identified during the inventory:

- One or more hand holes were not found.
- Hand hole covers are not bonded.
- Hand hole covers are missing bolts or could not be opened because of rust.



<p>Access to pedestrian bush buttons is not ADA compliant.</p> <p>The pedestal top is loose.</p>	
<p>A lane use sign is missing on the Cook Hill southbound approach. One sign is provided; two signs are indicated on the plan.</p>	

- The pedestrian crosswalk is not striped and 8-inch vehicle indications are used to indicate the concurrent pedestrian phase across South Turnpike Road.
- Programmed time settings generally match the record plans, however, some of the programmed times fall outside of the Min/Max ranges presented on the plans.
- Backplates are not provided on span wire mounted signal heads.
- Dust and dirt should be vacuumed from the cabinet and the air filter should be replaced.
- The color of the signal heads and visors is chipped and faded.

Qualitative Assessment

Overall, traffic signal equipment and intersection geometry are in good condition. The issues that are present are minor in nature and could be resolved by maintenance activities. The Qualitative Assessment category assigned to this intersection is:


2 - Maintenance Needed

2.1.12 Intersection 55T - South Turnpike Road at Cheshire Road

This three-legged, T-type intersection is controlled by a four-phase, semi-actuated traffic signal. The South Turnpike Road northbound approach is provided with a leading, actuated, left-turn phase and the South Turnpike Road northbound and southbound through movements follow in the next two signal phases. The second through signal phase is used to activate an illuminate traffic sign in advance of the northbound stop line to warn drivers that the signal is red. Cheshire Road is served in phase three. Vehicle signal heads are supported by a single span wire assembly. Pedestrians are permitted to cross Cheshire Road concurrently with parallel vehicle traffic on South Turnpike Road. Wire loop detectors and shelf mounted amplifiers are used to provide vehicle detection.



The provided plan is dated May 29, 1996. The plan notes a revision in which traffic signal interconnection and emergency pre-emption were added and South Turnpike Road was widened to add a left-turn lane. A retaining wall is present along the east side of South Turnpike Road and two approach lanes are provided in each direction. The northbound approach on South Turnpike Road appears to have limited sight distance due to a crest vertical curve. A “When Flashing Stop Ahead” warning flasher is provided on this approach. No sidewalks, sidewalk ramps, or crosswalks are present at this location. The following deficiencies were identified during the inventory:

<p>One or more hand holes were not found, were buried, or could not be opened.</p>	
--	--

One or more hand holes were not found, were buried, or could not be opened.



- Cheshire Road vehicle detection is malfunctioning. The signal phase operates on Max recall.
- One of the two signal heads provided on the eastbound approach is located too close to the stop line and does not conform to the requirements of the MUTCD.
- The existing signal indications on Cheshire Road are eight-inch diameter indications.
- Backplates are not provided on span wire mounted signal heads.
- The cabinet light bulb is burned out.
- Dust and dirt should be vacuumed from the cabinet and the air filter should be replaced.
- The color of the signal heads and visors is chipped and faded.

Qualitative Assessment

Overall, traffic signal equipment and intersection geometry are in good condition. Routine maintenance appears to be performed at this location. The issues that are present are minor in nature and could be resolved by maintenance activities. The Qualitative Assessment category assigned to this intersection is:

2 - Maintenance Needed

2.1.13 Intersection 56T - South Turnpike Road/Quinnipiac Street at Masonic Avenue/Route 15 Southbound Ramps

This five-legged intersection is controlled by a four-phase, fully-actuated traffic signal. The signal phases for the South Turnpike Road northbound and southbound approaches are arranged in the standard NEMA dual ring configuration, which provides leading, protected left-turns and lagging through phases. The Route 15 off-ramp is served by signal phase three, and Masonic Avenue is served by signal phase seven. The right turn movement from the Route 15 off-ramp to Quinnipiac Street northbound operates under Yield control. Most vehicle signal heads are supported by a single span wire assembly. One signal head is mounted on a pedestal. Wire loop detectors and shelf mounted amplifiers are used to provide vehicle detection. The shelf mounted vehicle loop detector amplifiers are marked with tags that clearly describe the loop the amplifier is connected to.



The provided plan is dated May 30, 1996, and was revised on December 3, 1997 and June 29, 1998. No sidewalks, sidewalk ramps or crosswalks are provided at this location. The following deficiencies were identified during the inventory:

For one or more hand holes:

- Covers are not grounded,
- Standing water was observed in the bottom,
- Cover bolts are rusted or missing

Some hand holes could not be found.



Traffic Signal Inventory
Wallingford, CT

<p>The color of the signal heads and visors is chipped and faded.</p>	
<p>A lane use sign has been damaged and is on the ground. Other signs at this intersection show damage.</p>	
<p>Two hand holes are within the vehicle tracking path and show damage.</p>	

A pedestal mounted signal is out of plumb.



- Programmed time settings do not match the record plans, however, all of the programmed times fall within the Min/Max ranges presented on the plans.
- One of the three signal heads provided on the northbound approach is located too close to the stop line and does not conform to the requirements of the MUTCD.
- Backplates are not provided on span wire mounted signal heads.
- The cabinet light bulb is burned out.
- Dust and dirt should be vacuumed from the cabinet and the air filter should be replaced.

Qualitative Assessment

Overall, traffic signal equipment and intersection geometry are in good condition. Routine maintenance appears to be performed at this location. The issues that are present are minor in nature and could be resolved by maintenance activities. The Qualitative Assessment category assigned to this intersection is:

2 - Maintenance Needed

2.1.14 Intersection 57T - Quinnipiac Street at River Road/Route 15 Northbound Off-Ramp

Traffic Signal Inventory

Wallingford, CT

This four-legged intersection is controlled by a four-phase, fully-actuated traffic signal. The Quinnipiac Street eastbound approach is provided with a leading, vehicle-actuated, left-turn phase and the Quinnipiac Street eastbound and westbound through movements follow in the next signal phase. The Route 15 Off-Ramp approach and the River Road approach are served by individual signal phases with are run sequentially. Most vehicle signal heads are supported by a single span wire assembly. The signal heads for the Quinnipiac eastbound approach are mounted horizontally to improve visibility for traffic passing below the Route 15 bridges. Pedestrians are permitted to cross Quinnipiac Street concurrently with parallel vehicle traffic on the Route 15 Off-Ramp and River Street. Wire loop detectors and shelf mounted amplifiers are used to provide vehicle detection.



The provided plan is dated June 4, 1996. An advance warning sign is provided on Quinnipiac Street due to a horizontal curve sight line restriction. Sidewalks are provided along Quinnipiac Street under the Route 15 bridge and along the east side of River Road. The following deficiencies were identified during the inventory:

For one or more hand holes:

- The cover is not grounded,
- Cover bolts are rusted or missing.

Wire nuts are used for splice connections.

Many hand holes could not be found or may have been filled over with debris.



	
<p>The paint on the signal heads and visors is chipped and faded.</p>	
<p>Sidewalk ramps are not ADA compliant.</p>	

- A fault was present on detector D2B (Quinnipiac Street westbound through phase).
- The record plans indicate that this intersection is intended to operate as part of the South Turnpike Road Closed-Loop traffic signal system, however the signal operates in the Free Mode at all times.
- Programmed time settings do not match the record plans, but all of the programmed times fall within the Min/Max ranges presented on the plans.

- One of the two signal heads provided on the northbound and eastbound approaches is located too close to the stop line and does not conform to the requirements of the MUTCD.
- Backplates are not provided on span wire mounted signal heads.
- Dust and dirt should be vacuumed from the cabinet and the air filter should be replaced.
- Pavement markings are worn.

Qualitative Assessment

Overall, intersection geometry is in good condition, but the traffic signal equipment is in poor condition. This intersection was constructed in 1996 and the equipment is now 16 years old. The issues that are present will require more than routine maintenance to resolve. The Qualitative Assessment category assigned to this intersection is:

3 - Capital Improvement Intersection

2.1.15 Intersection 58T - Quinnipiac Street at Ward Street/Lufbery Avenue/Bull Avenue

This signal controls multiple intersections in close proximity to each other in a commercial/residential zone. The signal operates with four actuated vehicle phases and an actuated pedestrian phase. Each roadway receives an individual signal phase. These phases are run in consecutive order. Phase one serves Quinnipiac Street eastbound and westbound traffic, phase two is the exclusive pedestrian phase, phase three serves Bull Avenue, phase four serves Lufbery Avenue and phase five serves Ward Street. Vehicle turning moves are prohibited between the section of Quinnipiac Street east of the intersection and Ward Street. Vehicle signal heads are supported by three span wire assemblies, with one assembly located at each intersection. Wire loop detectors and rack mounted amplifiers are used to provide vehicle detection.



The provided plan is dated July-1997. Sidewalks, sidewalk ramps and crosswalks are provided along all roadways at this location. Several business and/or residential driveways are located within the intersection. The following deficiencies were identified during the inventory:

Traffic Signal Inventory
Wallingford, CT

<p>One or more hand hole covers are not grounded, and have rusted or missing cover bolts.</p> <p>Wire nuts are used for splice connections in some hand holes.</p> <p>Some hand holes could not be found.</p>	
<p>The 8' pedestal and foundation opposite Bull Avenue is damaged.</p>	
<p>A wire loop is loose on the span pole located on the south side of Ward Street.</p>	

A pedestrian ramp located on the north side of Quinnipiac St is filled with sediment/debris.



A signal face is obscured by curb line trees.



- A fault was present on detector D6 (Ward Street westbound approach)
- Programmed time settings do not match the record plans, and some of the programmed times do not fall within the Min/Max ranges presented on the plans.
- An emergency pre-emption phase selector card and an optical detector are present, but it does not appear that the emergency pre-emption system is functioning.
- The cabinet door was difficult to open.
- One of the two signal heads provided on the eastbound approach of Quinnipiac Street to Bull Avenue and Lufbery Avenue, the Lufbery Avenue northbound approach, and the Quinnipiac Street westbound approach to Lufbery Avenue is located too close to the stop line and does not conform to the requirements of the MUTCD.
- Both of the signal heads provided on the Bull Avenue southbound approach are located too close to the stop line and does not conform to the requirements of the MUTCD.
- Some of the existing signal indications are eight-inch diameter indications.

- Backplates are not provided on span wire mounted signal heads.
- An audible pedestrian tone is not provided during the exclusive pedestrian phase.
- Dust and dirt should be vacuumed from the cabinet and the air filter should be replaced.
- The color of the signal heads and visors is chipped and faded.

Qualitative Assessment

Overall, intersection geometry is in good condition, but the traffic signal equipment is in poor condition. This intersection was constructed in 1997 and the equipment is now 15 years old. The issues that are present will require more than routine maintenance to resolve. The Qualitative Assessment category assigned to this intersection is:

3 - Capital Improvement Intersection




2.1.16 Intersection 59T - Quinnipiac Street at Washington Street

This four-legged intersection is controlled by a three-phase, fully-actuated traffic signal. The Quinnipiac Street eastbound and westbound approaches are served in phase one, an exclusive pedestrian phase is provided in phase two, and Washington Street northbound and southbound traffic is served in phase three. An audible pedestrian tone is provided during the exclusive pedestrian phase. Vehicle signal heads are supported by a single span wire assembly. Wire loop detectors and rack mounted amplifiers are used to provide vehicle detection.

The plan provided is dated July-1997. Concrete sidewalks and sidewalk ramps are present at each corner. The following deficiencies were identified during the inventory:



Traffic Signal Inventory
Wallingford, CT

<p>The "SLOW" pavement markings are faded.</p>	
<p>Wire nuts are used for splice connections in at least one location.</p>	
<p>Sidewalk ramps do not meet current ADA requirements lacking detectable warning strips and at least one location is in poor condition.</p>	

Pavement/Loop Condition is poor in at least one location.



- Faults are present on detectors D4 (Washington Street northbound) and D4C (Washington Street southbound).
- This signal is intended to operate as part of the Downtown closed-loop traffic signal system; however, it does not appear that the coordination plans are being used by the controller.
- An emergency pre-emption phase selector card is in the detector rack, but is not connected. Emergency vehicle pre-emption is not functioning.
- One of the two signal heads provided on the northbound and southbound approaches is located too close to the stop line and does not conform to the requirements of the MUTCD.
- A second Peek 3000 traffic signal controller is located in this cabinet. It is unclear if this second controller is operational.
- Backplates are not provided on span wire mounted signal heads.
- Dust and dirt should be vacuumed from the cabinet and the air filter should be replaced.
- The color of the signal heads and visors is chipped and faded.

Qualitative Assessment

Overall, traffic signal equipment and intersection geometry are in good condition. The issues that are present are minor in nature and could be resolved by maintenance activities. The Qualitative Assessment category assigned to this intersection is:

2 - Maintenance Needed

2.1.17 Intersection 60T - Quinnipiac Street at North and South Cherry Street

This four-legged intersection is controlled by a four-phase, fully-actuated traffic signal. The Quinnipiac Street eastbound and westbound approaches are served in Phase 1, an exclusive pedestrian phase is provided in Phase 2, the North Cherry Street southbound approach is given a leading green phase in Phase 3 and North and South Cherry Streets are served in Phase 4. Vehicle signal heads are supported by a single span wire assembly. An audible pedestrian tone is provided during the exclusive pedestrian phase. Wire loop detectors and rack mounted amplifiers are used to provide vehicle detection.



The plan provided is dated July-1997. Concrete sidewalks and sidewalk ramps are present at each corner. The following deficiencies were identified during the inventory:

<p>Pavement markings are in poor condition.</p>	A photograph of a street intersection. The pavement markings, including a crosswalk and lane lines, are significantly faded and worn, making them difficult to see. The street is paved with asphalt, and there are buildings and utility poles in the background.
<p>Existing sidewalk ramps do not meet current ADA requirements. They lack detectable warning strips and in some cases exceed slope requirements.</p>	A close-up photograph of a crosswalk. The white stripes of the crosswalk are faded and uneven. There are no detectable warning strips (DWS) at the edge of the crosswalk, which is a deficiency according to ADA requirements.

A wood utility pole on the southeast corner of the intersection appears to be moderately out of plumb.



Pedestal mounted signals on Quinnipiac Street westbound appear to be obscured by a tree.



- Programmed time settings do not match the record plans, however, all of the programmed times fall within the Min/Max ranges presented on the plans.
- This intersection is intended to operate as part of the Downtown Closed-Loop traffic signal system. This intersection operates in the Free Mode at all times and does not seem to be communicating with the master.
- An emergency pre-emption phase selector card is in the detector rack, but is not connected. Emergency vehicle pre-emption is not functioning.
- One of the two signal heads provided on the northbound approach is located too close to the stop line and does not conform to the requirements of the MUTCD.
- The Railroad Crossing graphic sign on Quinnipiac Street eastbound is missing.
- Backplates are not provided on span wire mounted signal heads.
- Dust and dirt should be vacuumed from the cabinet and the air filter should be replaced.
- The color of the signal heads and visors is chipped and faded.

Qualitative Assessment

Overall, traffic signal equipment and intersection geometry are in good condition. The issues that are present are minor in nature and could be resolved by maintenance activities. The Qualitative Assessment category assigned to this intersection is:

2 - Maintenance Needed

2.1.18 Intersection 61T - Ward Street at South Cherry Street

This four-legged intersection is controlled by an isolated, three-phase, semi-actuated traffic signal. The Ward Street eastbound and westbound approaches are served in Phase 1, an exclusive pedestrian phase is provided in Phase 2 and traffic on the South Cherry Street northbound and southbound approaches is served in Phase 3. Vehicle signal heads are supported by a single span wire assembly. Vehicle actuation is provided on the South Cherry Street Approach. The cycle length varies between 55 and 65 seconds. Wire loop detectors and shelf mounted amplifiers are used to provide vehicle detection.



The provided plan was dated 1973 with a notation that timings recorded in June-2002. Sidewalks, sidewalk ramps and crosswalks are provided on all four approaches. The pedestals and pedestrian signals appear to have been recently replaced or updated. Otherwise, the existing traffic signal hardware was generally found to be in fair to poor condition with the following deficiencies or exceptions:

The crosswalk markings are faded, do not align with the sidewalk ramps, and appear to be too narrow.

The pedestrian signal faces are difficult to see as they do not face opposing ramps.

One or more ramps appear to be too steep (non-ADA compliant).



Traffic Signal Inventory
Wallingford, CT

<p>The signs for the pedestrian push-buttons are not consistent with pedestrian signal faces which are man/hand.</p> <p>Pedestrian push-buttons are not all 2" diameter.</p>	
<p>The vehicle detector loops are in poor condition.</p>	
<p>The conduits in the controller cabinet are not sealed.</p>	

Signal heads appear to be old and have been repaired or are missing components.



A manhole within the cross walk has been paved over and is creating a tripping hazard.



- Programmed time settings do not match the record plans, however, all of the programmed times appear to fall within the Min/Max ranges presented on the plans.
- One of the two signal heads provided on the southbound, eastbound and westbound approaches is located too close to the stop line and does not conform to the requirements of the MUTCD.
- The two signal heads provided on the northbound approach are located too close to the stop line and do not conform to the requirements of the MUTCD.
- All existing vehicle signal indications are eight-inch diameter.
- Backplates are not provided on span wire mounted signal heads.
- The cabinet does not have an internal light bulb to illuminate the cabinet when the cabinet door is opened.
- An audible pedestrian tone is not provided during the exclusive pedestrian phase.
- Dust and dirt should be vacuumed from the cabinet and the air filter should be replaced,
- The color of the signal heads and visors is chipped and faded.

Qualitative Assessment

Overall, traffic signal equipment and intersection geometry are in poor condition. This intersection was constructed in 1973 but the equipment seems to be approximately 15 to 20 years old. The issues that are present will require more than routine maintenance to resolve. The Qualitative Assessment category assigned to this intersection is:

4 - Replacement Intersection

2.1.19 Intersection 62T - Ward Street at South Orchard Street

This four-legged intersection is controlled by an isolated, three-phase, semi-actuated traffic signal. The Ward Street eastbound and westbound approaches are served in Phase 1, an exclusive pedestrian phase is provided in Phase Two, and the South Orchard Street northbound and southbound approaches are served in Phase 3. Vehicle signal heads are supported by a single span-wire assembly. Vehicle actuation is provided on the South Cherry Street Approach. Microwave detection is provided on South Orchard Street and wire loop detectors are provided on Ward Street. Rack mounted amplifiers are used to provide vehicle detection.

The provided plan is dated April-1997. This intersection consists of single lane approaches in all directions. The location is primarily within a business/residential zone. A school is located in the vicinity of this intersection. Concrete sidewalks, sidewalk ramps and crosswalks are provided on all four corners. The following deficiencies were identified during the inventory:



Conduits are not sealed in the controller cabinet.



Pedestrian push-button signs are a mix of older and newer types.



<p>One or more sidewalk ramps appear to be non ADA compliant.</p>	
<p>A span pole is missing the hand hole cover, one or more bolt covers, and exhibits slight corrosion at the base.</p>	
<p>Double yellow centerlines are missing on South Orchard Street.</p>	

- Programmed time settings do not match the record plans, however, all of the programmed times fall within the Min/Max ranges presented on the plans.
- One of the two signal heads provided on the northbound, eastbound and westbound approaches is located too close to the stop line and does not conform to the requirements of the MUTCD.
- Both of the signal heads provided on the southbound approach are located too close to the stop line and do not conform to the requirements of the MUTCD.

- The plans indicate that this intersection is intended to operate in coordination with intersection 5T (South Colony Road at Ward Street). Coordination settings are not programmed in the controller, and the intersection operates in the Free Mode at all times.
- The plans indicate that an emergency pre-emption phase is provided on South Orchard Street southbound. The intersection does not include emergency pre-emption equipment, and no pre-emption routines have been programmed.
- The audible pedestrian tone was not functioning at this intersection.
- Most existing vehicle signal indications are eight-inch diameter.
- Backplates are not provided on span wire mounted signal heads.
- The cabinet light bulb is burned out.
- Dust and dirt should be vacuumed from the cabinet and the air filter should be replaced.
- The color of the signal heads and visors is chipped and faded.

Qualitative Assessment

Overall, traffic signal equipment and intersection geometry are in poor condition. This intersection was constructed in 1997 and the equipment is now 15 years old. The issues that are present will require more than routine maintenance to resolve. The Qualitative Assessment category assigned to this intersection is:

4 - Replacement Intersection

2.1.20 Intersection 63T - North Plains Industrial Road at Pent Highway

This intersection is a three-way, vehicle actuated, isolated, T-type intersection. An uncontrolled driveway approaches the intersection from the west. A leading southbound left-turn phase is provided on North Plains Industrial Road, and the Pent Highway westbound right-turn is allowed to move as an overlapping movement during this leading signal phase. Vehicle signal heads are supported by a single span wire assembly. Pedestrian push-buttons are provided, but a crosswalk is not marked. Pedestrians move concurrently with westbound Pent Highway traffic. Wire loop detectors and rack mounted amplifiers are used to provide vehicle detection.

The provided plan is dated March-2001. This location is primarily commercial with



Traffic Signal Inventory
Wallingford, CT

business access in close proximity to the intersection. There are no sidewalks at this location. A pedestrian crossing exists on North Plains Ind. The following deficiencies were identified during the inventory:

<p>One or more hand hole covers were not found and may be filled over.</p> <p>One or more hand holes had rusted or missing bolts in the cover.</p>	
<p>The detector loops and pavement are in poor condition at several locations.</p>	
<p>An additional signal face is mounted on the northeast span pole that is not noted on the signal plan.</p>	

Signal Face #3 is mounted horizontally in the field but not identified on the signal plan as such (may be due to visibility/height reasons).



A hand hole on the northeast corner of the intersection is being hit by turning vehicles.



- The adjacent property owner's chain link fence has been damaged and is leaning toward the controller cabinet, making it impossible to fully open the controller cabinet door.
- Eight-inch diameter red, yellow, and green vehicle signal heads are provided as pedestrian indications. These indications are timed with the vehicle phase, and do not show pedestrian walk or clearance intervals.
- Programmed time settings do not match the record plans; however, all values fall with the Min/Max range presented on the plan.
- Loop detectors in the North Plains Industrial Road southbound left-turn lane and Pent Highway westbound right turn lane are malfunctioning.
- The system detector on the Pent Highway departure lane (SD3) is malfunctioning.
- Backplates are not provided on span wire mounted signal heads.
- The pavement markings are in poor condition.
- Dust and dirt should be vacuumed from the cabinet and the air filter should be replaced.
- The color of the signal heads and visors is chipped and faded.

Qualitative Assessment

Overall, traffic signal equipment and intersection geometry are in poor condition. This intersection was updated in 2001 but the equipment seems to be much older. The issues that are present will require more than routine maintenance to resolve. The Qualitative Assessment category assigned to this intersection is:

4 - Replacement Intersection

2.1.21 Intersection 64T - North Main Street Extension at Beaumont Road

This four-legged intersection is controlled by a four-phase, vehicle-actuated, traffic signal which operates as part of the North Main Street Extension coordinated traffic signal system. North Main Street Extension northbound and southbound traffic moves together with permitted left-turns. Beaumont Road eastbound traffic and the Community Pool driveway traffic are each served by split signal phases. An exclusive pedestrian phase is also provided which includes an audible tone. Vehicle signal heads are supported by a single span wire assembly. Wire loop detectors and rack mounted amplifiers are used to provide vehicle detection.



The provided plan was dated December-1998. The entrance to the Town's community pool is located on the east leg of the intersection. Sidewalks are present along the east side of North Main Street Extension and also along the west side of North Main Street Extension to the north of Beaumont Road. Concrete sidewalk ramps and crosswalks are present on all four corners. The following deficiencies were identified during the inventory:

Traffic Signal Inventory
Wallingford, CT

<p>One or more hand hole covers are not grounded, and are rusted or missing cover bolts.</p>	
<p>The span pole located in the northwest corner has been hit by large vehicles turning onto Beaumont Road. The bolt covers are also damaged.</p>	
<p>Tree pruning is required at Utility pole #5497 to clear vegetation away from the signal power supply.</p>	

<p>A span wire mounted sign is out of plumb.</p>	
<p>One or more of the pedestrian signals are corroding and/or have been damaged.</p>	

- The North Main Street Extension signal heads in the center of the intersection are held together using rope.
- The pre-emption detection card is not installed in the detector rack, but is stored in a cardboard box on the shelf.
- The pedestrian push-button on the southeast corner of the intersection appears to have been hit and the signal housing is broken. The push-button and signal head function properly.
- One of the two signal heads provided on the northbound and eastbound approaches is located too close to the stop line and does not conform to the requirements of the MUTCD.
- Both of the signal heads provided on the westbound approach are located too close to the stop line and do not conform to the requirements of the MUTCD.
- Backplates are not provided on span wire mounted signal heads.
- The cabinet light bulb is missing.
- Dust and dirt should be vacuumed from the cabinet and the air filter should be replaced.
- The color of the signal heads and visors is chipped and faded.

Qualitative Assessment

Overall, traffic signal equipment and intersection geometry are in poor condition. This intersection was constructed in 1998 and the equipment is now 14 years old. The issues that are present will require more than routine maintenance to resolve. The Qualitative Assessment category assigned to this intersection is:

4 - Replacement Intersection

2.1.22 Intersection 65T - North Main Street Extension at Barnes Industrial Road/Wal-Mart Driveway

This four-legged intersection is controlled by a five-phase, vehicle-actuated, traffic signal which operates as part of the North Main Street Extension coordinated signal system. The master signal controller for this coordinated signal system is located in at this intersection. The signal phases for the North Main Street Extension northbound and southbound vehicle movements are arranged in a standard NEMA dual-ring configuration. Barnes Industrial Road and the Wal-Mart driveway are controlled by the same signal phase. Vehicle signal heads are supported by a single span wire assembly. Pedestrian push-buttons are provided, and pedestrians are permitted to cross North Main Street Extension concurrently with adjacent vehicle traffic, however, pedestrian indications and marked crosswalks are not provided. Wire loop detectors and shelf mounted amplifiers are used to provide vehicle detection.



Two emergency vehicle pre-emption routines are programmed in the controller, detector cards are installed and powered, and pre-emption detectors are present. The pre-emption routines were not tested to ensure proper function.

The provided plan is dated October 1995. This intersection is located within a commercial area, and concrete sidewalks are only provided along the west side of North Main Street Extension. Two concrete sidewalk ramps are present on the northwest and southwest corners. The following deficiencies were identified during the inventory:

<p>Some hand hole covers are not grounded, and have rusted or missing bolts.</p> <p>Some hand holes could not be found and appear to have been filled over.</p> <p>Wire nuts are used for splice connections in one or more hand holes.</p> <p>Conduits are not sealed.</p>	
<p>Heavy vehicles are riding over the curb while making right turns on to Barnes Industrial Road.</p>	
<p>The length of the concrete ramp leading to the push-button on the northeast corner appears to exceed allowable ADA limits.</p>	

- One of the two signal heads provided on the eastbound approach is located too close to the stop line and does not conform to the requirements of the MUTCD.
- The existing vehicle signal indications for the Wal-Mart Driveway and Barnes Industrial Road approaches are eight-inch diameter.
- Backplates are not provided on span wire mounted signal heads.
- Dust and dirt should be vacuumed from the cabinet and the air filter should be replaced.

- The wire drip loop at the top of the northeast span pole is uncoiled.
- The color of the signal heads and visors is chipped and faded.

Qualitative Assessment

Overall, intersection geometry is in good condition, but the traffic signal equipment is in poor condition. This intersection was constructed in 1995 and the equipment is now 17 years old. The issues that are present will require more than routine maintenance to resolve. The Qualitative Assessment category assigned to this intersection is:

3 - Capital Improvement Intersection

2.1.23 Intersection 66T - North Main Street Extension at Ives Road

This four-legged intersection is controlled by a five-phase, vehicle-actuated, traffic signal which operates as part of the North Main Street Extension coordinated signal system. The signal phases for the North Main Street Extension northbound and southbound vehicle movements are arranged in a standard NEMA dual-ring configuration. Ives Road and the Westview Office Park driveway are controlled by the same signal phase. Vehicle signal heads are supported by a single span wire assembly. Pedestrian push-buttons are provided, and pedestrians are permitted to cross North Main Street Extension concurrently with adjacent vehicle traffic. Wire loop detectors and shelf mounted amplifiers are used to provide vehicle detection.



The provided plan is dated July-1997. A sidewalk and one sidewalk ramp is provided on the northwest corner of the intersection. There are no marked crosswalks at this location. The following deficiencies were identified during the inventory:

Traffic Signal Inventory
Wallingford, CT

<p>One or more hand hole covers are not grounded.</p> <p>Some covers have rusted or missing bolts.</p> <p>Wire nuts are used for splice connections.</p> <p>Some hand holes could not be found.</p>	
<p>A span mounted lane use sign (Left Turn Only) is out of plumb.</p>	
<p>Trimming of vegetation is required at one utility pole.</p>	

Heavy vehicles are riding over the curb while making right turns onto Ives Road.



- Programmed time settings match the record plans for all intervals except MAX 1 for phase 1 (North Main Street Extension northbound left turn phase). The programmed values fall within the Min/Max ranges presented on the plan.
- Pedestrian push-buttons are provided, but pedestrian indications and marked crosswalks are not provided.
- Both of the signal heads provided on the westbound approach are located too close to the stop line and do not conform to the requirements of the MUTCD.
- The existing vehicle signal indications for the Ives Road and Westview Office Park Driveway approaches are eight-inch diameter.
- The foundation for the traffic signal controller has settled approximately 18 inches. The bottom of the cabinet door is partially blocked by soil.
- Backplates are not provided on span wire mounted signal heads.
- Dust and dirt should be vacuumed from the cabinet and the air filter should be replaced.
- The color of the signal heads and visors is chipped and faded.

Qualitative Assessment

Overall, intersection geometry is in good condition, but the traffic signal equipment is in poor condition. This intersection was constructed in 1997 and the equipment is now 15 years old. The issues that are present will require more than routine maintenance to resolve. The Qualitative Assessment category assigned to this intersection is:

3 - Capital Improvement Intersection



2.1.24 Intersection 67T - North Main Street Extension at Stop & Shop Shopping Center Driveway

This four-legged intersection is controlled by a three-phase, vehicle-actuated, traffic signal. The North Main Street Extension northbound left-turn is the leading signal phase, which is followed by the northbound/southbound through phase. The Stop & Shop Shopping Center driveway and a driveway leading to an office building are served by the third signal phase. Vehicle signal heads are supported by a single span wire assembly. Pedestrian push-buttons are provided, but pedestrian indications and marked crosswalks are not provided. Wire loop detectors and shelf mounted amplifiers are used to provide vehicle detection.



The provided plan is dated August-1988. Concrete sidewalks are only provided along the west side of North Main Street from the Stop and Shop Plaza driveway to the south. One concrete sidewalk ramp is present on the southwest corner. The following deficiencies were identified during the inventory:

<p>Existing pavement markings and lane use do not agree with the signal plan.</p>	
---	--

<p>One or more hand hole covers were not grounded.</p> <p>Some hand holes could not be found.</p> <p>Wire nuts are used for splice connections.</p> <p>Some covers have rusted or missing bolts.</p> <p>Conduits are not sealed.</p>	
<p>Pedestrian push-buttons are the older style and not easily accessible by pedestrians.</p>	

- Programmed time settings do not match the record plans, however, all of the programmed times fall within the Min/Max ranges presented on the plan.
- The traffic signal is intended to operate as part of the North Main Street Extension coordinated signal system, however, the signal operates in the Free Mode at all times.
- Emergency vehicle pre-emption is not provided at this intersection.
- The pedestrian push-buttons are not ADA compliant because there are not handicapped accessible routes leading to the buttons.
- One of the two signal heads provided on the eastbound and westbound approaches is located too close to the stop line and does not conform to the requirements of the MUTCD.
- Backplates are not provided on span wire mounted signal heads.
- The cabinet light bulb is burned out.
- Dust and dirt should be vacuumed from the cabinet and the air filter should be replaced,
- The color of the signal heads and visors is chipped and faded.

Qualitative Assessment

Overall, traffic signal equipment and intersection geometry are in poor condition. This intersection was constructed in 1988 and the equipment is now **24 years old**. The issues that are present will require more than routine maintenance to resolve. The Qualitative Assessment category assigned to this intersection is:

4 - Replacement Intersection

2.1.25 Intersection 68T - Barnes Industrial Road North at Barnes Road

This four-legged intersection is controlled by a two-phase, vehicle-actuated traffic signal. East-west traffic along Barnes Road is served by Phase 1 and north-south traffic along Barnes Industrial Road North is served by Phase 2. All vehicle signal heads are LED type, 12 inch diameter, and supported by a single span wire assembly. Pedestrian crosswalks, pedestrian signal heads, and emergency vehicle pre-emption are not provided at this intersection. All equipment in this cabinet is manufactured by Naztec. Wire loop detectors and shelf mounted amplifiers are used to provide vehicle detection.



The provided plan is dated August-1996. This intersection is located in an industrial area. No sidewalks, sidewalk ramps or crosswalks are provided. The following deficiencies were identified during the inventory:

- One or more hand hole covers were not grounded.
- Some hand holes could not be found.
- Wire nuts are used for splice connections.
- Some covers have rusted or missing bolts.
- Conduits are not sealed.



<p>The pavement in the vicinity of the vehicle loop detectors is in poor condition.</p>	
<p>Vehicles are impacting the northwest and northeast curb lines.</p>	

- A detector fault was present on loop D1 (Barnes Road westbound approach).
- Programmed time settings do not match the record plans, and, some of the programmed times do not fall within the Min/Max ranges presented on the plan.
- Emergency vehicle pre-emption is not provided at this intersection.
- One of the two signal heads provided on the northbound and southbound approaches is located too close to the stop line and does not conform to the requirements of the MUTCD.
- Visors are missing on the following two signal heads:
 - Barnes Road: eastbound green indication
 - Barnes Industrial Road North: southbound green indication
- The existing vehicle signal indications for the Barnes Industrial Road approaches are eight-inch diameter.
- The lock on this cabinet should be changed to use the same key as all other Town owned intersections.
- Vegetation around the cabinet should be trimmed.
- Backplates are not provided on span wire mounted signal heads.

- The cabinet light bulb is missing.
- Dust and dirt should be vacuumed from the cabinet and the air filter should be replaced,
- The color of the signal heads and visors is chipped and faded.

Qualitative Assessment

Overall, intersection geometry is in good condition, but the traffic signal equipment is in poor condition. This intersection was constructed in 1996 and the equipment is now 16 years old. The issues that are present will require more than routine maintenance to resolve. The Qualitative Assessment category assigned to this intersection is:




3 - Capital Improvement Intersection

2.1.26 Intersection 69T - Research Parkway at Bristol-Myers Squibb Main Driveway

This three-legged, T-type intersection operates as an isolated, fully-actuated, three-phase traffic signal. The Research Parkway southbound left-turn is the leading signal phase, which is followed by the northbound/southbound through phase. The Bristol-Myers Squibb driveway is served by the third signal phase. Vehicle signal heads are supported by a single span wire assembly. Pedestrian push-buttons are provided, and pedestrians are permitted to cross Research Parkway concurrently with the driveway traffic, however, marked crosswalks are not provided. Wire loop detectors and rack mounted amplifiers are used to provide vehicle detection.

The provided plan is dated June-2001.No sidewalks, sidewalk ramps, or crosswalks are provided at this location. The following deficiencies were identified during the inventory:



<p>One or more hand hole covers were not grounded.</p> <p>Some hand holes could not be found.</p> <p>Wire nuts are used for splice connections.</p> <p>Some covers have rusted or missing bolts.</p>	
<p>Sidewalk access is not provided to the Pedestrian push-buttons.</p>	
<p>Lane restriction signs are missing on the northbound approach.</p>	

- Eight-inch diameter red, yellow, and green vehicle signal heads are provided as pedestrian indications. These indications are timed with the vehicle phase, and do not show pedestrian walk or clearance intervals.
- Programmed time settings do not match the record plans, however, all of the programmed times do fall within the Min/Max ranges presented on the plan.
- One of the two signal heads provided on the westbound approach is located too close to the stop line and does not conform to the requirements of the MUTCD.

- Emergency vehicle pre-emption is not provided at this location.
- Backplates are not provided on span wire mounted signal heads.
- The cabinet does not have an internal light bulb to illuminate the cabinet when the cabinet door is opened.
- Dust and dirt should be vacuumed from the cabinet and the air filter should be replaced.
- The color of the signal heads and visors is chipped and faded.

Qualitative Assessment

Overall, traffic signal equipment and intersection geometry are in good condition. The issues that are present are minor in nature and could be resolved by maintenance activities. The Qualitative Assessment category assigned to this intersection is:

2 - Maintenance Needed

***2.1.27 Intersection 71T - Cook Hill Road at
Oakdale Theater North Driveway***

This is a T-type intersection with a flashing beacon signal. Flashing yellow indications are provided for Cook Hill Road traffic and a flashing red indication is provided for Oakdale Theater north driveway traffic. These indications are supported by a single span wire assembly. Traffic on the Oakdale Theater north driveway is controlled by a STOP sign.

A cluster of four flood lights are mounted below the flashing indications to illuminate the roadway below. The flood lights are controlled by a toggle switch located in the pedestal mounted controller cabinet.

The following deficiencies were identified during the inventory:

- Dust and dirt should be vacuumed from the cabinet.



Qualitative Assessment

Overall, traffic signal equipment and intersection geometry are in good condition. No major issues were found. The Qualitative Assessment category assigned to this intersection is:

1 - Compliant Intersection

2.1.28 Intersection 72T - South Turnpike Road at Oakdale Theater East Driveway

This is a T-type intersection with a flashing beacon signal. A flashing yellow indication is displayed to traffic on South Turnpike Road and a flashing red indication is displayed to vehicles on the Oakdale Theater driveway. These indications are supported by a single span wire assembly. Traffic on the Oakdale Theater east driveway is controlled by a STOP sign.

A cluster of four flood lights are mounted below the flashing indications to illuminate the roadway below. The flood lights are controlled by a toggle switch located in the controller cabinet mounted on the southern span pole.

The following deficiencies were identified during the inventory:

- A bulb in one of the overhead flood lights is burned out and should be replaced.
- The light bulb provided in this cabinet is burned out.
- Pavement markings are faded.
- Dust and dirt should be vacuumed from the cabinet.



Qualitative Assessment

Overall, traffic signal equipment and intersection geometry are in good condition. No major issues were found. The Qualitative Assessment category assigned to this intersection is:

1 - Compliant Intersection

2.1.29 Intersection 73T - John Street at South Cherry Street

This four-legged intersection is controlled by a two-phase, fixed-time traffic signal. North-south traffic along South Cherry Street is served by phase one and east/west traffic along John Street is served by Phase 2. Vehicle signal heads are LED type, 12 inch diameter, and supported by a single span wire assembly. Pedestrian crosswalks, pedestrian signal heads, and emergency vehicle pre-emption are not provided at this intersection. Traffic signal equipment is contained in a small, pedestal mounted, traffic controller cabinet.

A plan of this intersection does not exist. The following deficiencies were identified during the inventory:



<p>A wire drip loop is uncoiled. Pavement markings are faded.</p>	A photograph of a street intersection. A white semi-truck is driving through the intersection. Traffic lights are visible above the road. The pavement shows some faded markings.
<p>Heavy vehicles are riding over the curb line in the southeast corner of the intersection.</p>	A close-up photograph of a curb area. A storm drain is visible in the foreground. A person's leg in blue pants is visible on the left side of the frame, standing near the curb.

- Traffic Signal warrants should be reviewed at this location to confirm that traffic signal operations are still warranted.
- Vehicle detection is not provided.
- The signal heads provided on the southbound approach are located too close to the stop line and do not conform to the requirements of the MUTCD.
- The existing signal timing does not match the timing specified in the STC permit.
- Backplates are not provided on span wire mounted signal heads.
- The cabinet does not have an internal light bulb to illuminate the cabinet when the cabinet door is opened.
- Dust and dirt should be vacuumed from the cabinet.
- The color of the signal heads and visors is faded.

Qualitative Assessment

Overall, intersection geometry is in fair condition, but the traffic signal equipment is in poor condition. This STC permit is dated 1958, but most of the equipment seems to be approximately 20 years old. The issues that are present will require more than routine maintenance to resolve. The Qualitative Assessment category assigned to this intersection is:

3 - Capital Improvement Intersection

2.1.30 Intersection 74T - Hope Hill Road at Yalesville Fire Department

This is a T-type intersection controlled by a flashing traffic signal. Flashing yellow indications are displayed to traffic on Hope Hill Road and flashing red indications are displayed to vehicles on the Yalesville Fire Department driveway. The traffic signal displays steady red indications on the Hope Hill Road approaches and steady green indications on the Fire Station driveway approach when fire trucks exit the fire station. A push-button is located in the fire station to actuate the signal phase for the Fire Station approach.

The following deficiencies were identified during the inventory:

The conduits in the controller cabinet are not sealed.



Multiple risers and loose wiring are present around the weather-heads.



- The cabinet lock and door assembly should be repaired. Entry into the cabinet was very difficult.
- Programmed time settings do not match the record plans, and some of the programmed times do not fall within the Min/Max ranges presented on the plan.
- Backplates are not provided on span wire mounted signal heads.
- Dust and dirt should be vacuumed from the cabinet.

Qualitative Assessment

Overall, intersection geometry is in good condition, but the traffic signal equipment is in poor condition. The issues that are present will require more than routine maintenance to resolve. The Qualitative Assessment category assigned to this intersection is:

3 - Capital Improvement Intersection

2.1.31 Intersection 75T - North Colony Street (US Route 5) at Holy Trinity Church

This location consists of an overhead spot light. The switch to activate the spot light is located approximately nine feet above the ground on a utility pole located in southeast corner of the intersection.

The following deficiencies were identified during the inventory:

3. A bulb in one of the overhead spot lights is burned out.



There are no pedestrian ramps for the marked crosswalks on North Colony Road.



Qualitative Assessment

Overall, the overhead spot lights are in good condition, but the lack of sidewalk ramps should be addressed. The issues that are present will require more than routine maintenance to resolve. The Qualitative Assessment category assigned to this intersection is:

3 - Capital Improvement Intersection

3.0 QUALITATIVE ASSESSMENT RESULTS

Based on the intersection inventory results, the Qualitative Assessments of the project intersections are summarized in Table 1 and in Figure 2.


Table 1 - Qualitative Assessment Summary by Intersection

Intersection	Qualitative Assessment
4T South Colony Road (US Route 5) at Walgreens Shopping Center Driveway	2 - Maintenance Needed
5T South Colony Road (US Route 5) at Ward Street	3 - Capital Improvement Intersection
6T North and South Colony Road (US Route 5) at Hall Avenue, Center Street, Quinnipiac Street	3 - Capital Improvement Intersection
25T Center Street (Route 150) at Silver Pond Apartments Driveway	4 - Replacement Intersection
26T Center Street (Route 150) at North and South Elm Streets	4 - Replacement Intersection
27T Center Street (Route 150) at North and South Main Streets	4 - Replacement Intersection
28T Center Street (Route 150) at North and South Orchard Streets	3 - Capital Improvement Intersection
29T Hall Avenue (Route 150) at North Cherry Street	3 - Capital Improvement Intersection
30T Hall Avenue (Route 150) at Washington Street	2 - Maintenance Needed
32T Hall Avenue (Route 150) at Masonic Avenue/Fire Dept. Headquarters	4 - Replacement Intersection
54T South Turnpike Road at Cook Hill Road	2 - Maintenance Needed
55T South Turnpike Road at Cheshire Road	2 - Maintenance Needed
56T South Turnpike Road/Quinnipiac Street at Masonic Avenue/Route 15 Southbound Ramps	2 - Maintenance Needed
57T Quinnipiac Street at River Road/Route 15 Northbound Off-Ramp	3 - Capital Improvement Intersection
58T Quinnipiac Street at Ward Street	3 - Capital Improvement Intersection
59T Quinnipiac Street at Washington Street	2 - Maintenance Needed
60T Quinnipiac Street at North and South Cherry Street	2 - Maintenance Needed

Traffic Signal Inventory
Wallingford, CT

Intersection		Qualitative Assessment
61T	Ward Street at South Cherry Street	4 - Replacement Intersection
62T	Ward Street at South Orchard Street	4 - Replacement Intersection
63T	North Plains Industrial Road at Pent Highway	4 - Replacement Intersection
64T	North Main Street Extension at Beaumont Road	4 - Replacement Intersection
65T	North Main Street Extension at Barnes Industrial Road/Wal-Mart Driveway	3 - Capital Improvement Intersection
66T	North Main Street Extension at Ives Road	3 - Capital Improvement Intersection
67T	North Main Street Extension at Stop & Shop Shopping Center Driveway	4 - Replacement Intersection
68T	Barnes Industrial Road North at Barnes Road	3 - Capital Improvement Intersection
69T	Research Parkway at Bristol-Myers Squibb Main Driveway	2 - Maintenance Needed
71T	Cook Hill Road at Oakdale Theater North Driveway	1 - Compliant Intersection
72T	South Turnpike Road at Oakdale Theater East Driveway	1 - Compliant Intersection
73T	John Street at South Cherry Street	3 - Capital Improvement Intersection
74T	Hope Hill Road at Yalesville Fire Department	3 - Capital Improvement Intersection
75T	North Colony Street (US Route 5) at Holy Trinity Church	3 - Capital Improvement Intersection

Figure 2 - Intersection Status

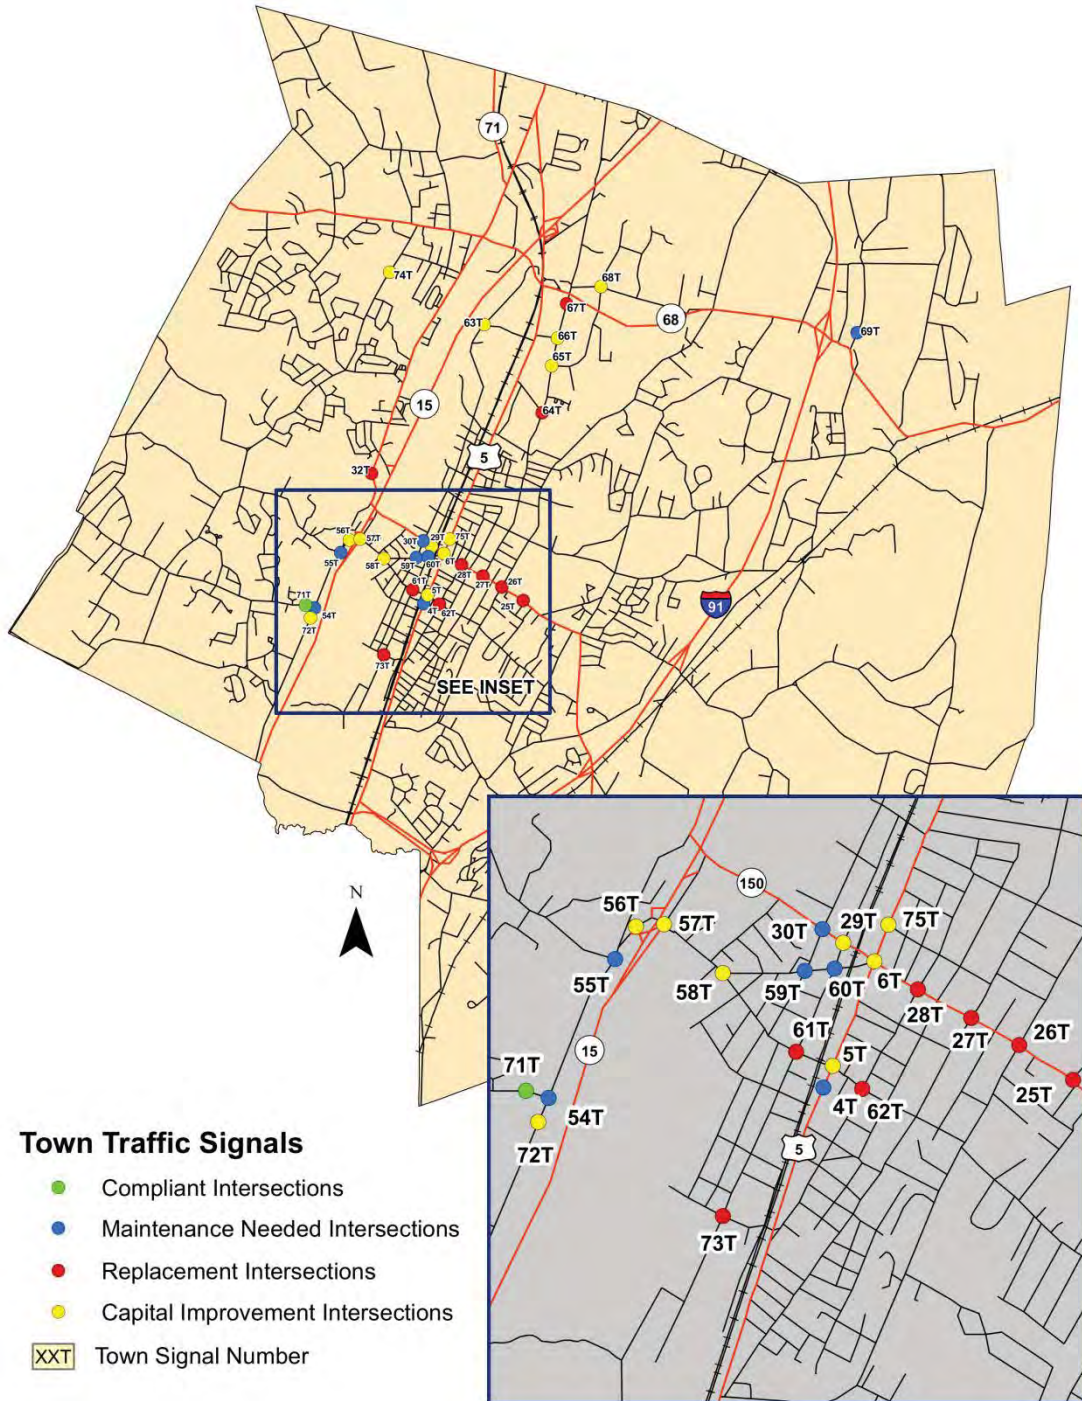

The Qualitative Assessment categories are summarized in Table 2.

Table 2 - Qualitative Assessment Summary by Category

Qualitative Assessment	Number of Intersections
1 - Compliant	2
2 - Maintenance Needed	8
3 - Capital Improvement	12
4 - Replacement	9
5 - Red Flag	0
TOTAL	31

4.0 RECOMMENDATIONS

This report has identified improvements which can be realized in the traffic signals which are owned by the City of Wallingford. The improvement program is divided into two major categories:

4. System Level Improvements – These are projects which apply to the overall performance of the system. These include actions to improve traffic signal operations as a whole. Projects which address multiple locations, operational plans and similar actions.
5. Intersection Level Improvements – These items are recommended to bring a specific location to its original design, repair malfunctioning equipment or upgrade an intersection to current standards.

The following sections will present the recommendations to improvement of the overall traffic signal system and to improve individual intersections.

4.1 System Level Improvements

Vehicle Detector Repair

A number of detectors were found to be malfunctioning. This is normally due to pavement deterioration and requires replacement of loop detectors. The number of these detectors is sufficient to justify the development of a system wide detector repair project. We recommend the City program this improvement as a separate effort from other intersection repairs. This project is recommended at a funding level of \$30,000.


System Coordination Repair

Our inspection and inventory noted that many intersections were originally designed to function in a coordinated fashion. This is a very efficient means to reduce stops and vehicle delay between closely spaced intersections. In Wallingford, there are four such “Systems”. These systems are presented in Figure X. None of the four systems are functioning. In two cases, the coordination units were missing or not connected. In the others, the coordination hardware did not appear to be communicating with its neighboring intersections.

Efficiency of the overall traffic signal system could be improved by restoring the existing traffic signal interconnect communication system, and implementing traffic signal coordination settings. Most project intersections are programmed with the coordination settings shown on the plans, but these settings not being implemented. A few project intersections do not have the coordination setting programmed. This traffic signal inventory found that 21 project intersections should be operating with coordination plans. The Inventory revealed that only six project intersections are actually implementing the intended coordination plans.

We recommend a System Coordination Project which will examine each “System” and determine the reasons for failure. This project would test coordination cable for deterioration, re-establish operation plans, and verify that local intersections are responding to system commands from the master location.

Figure 3 - Coordination Zones

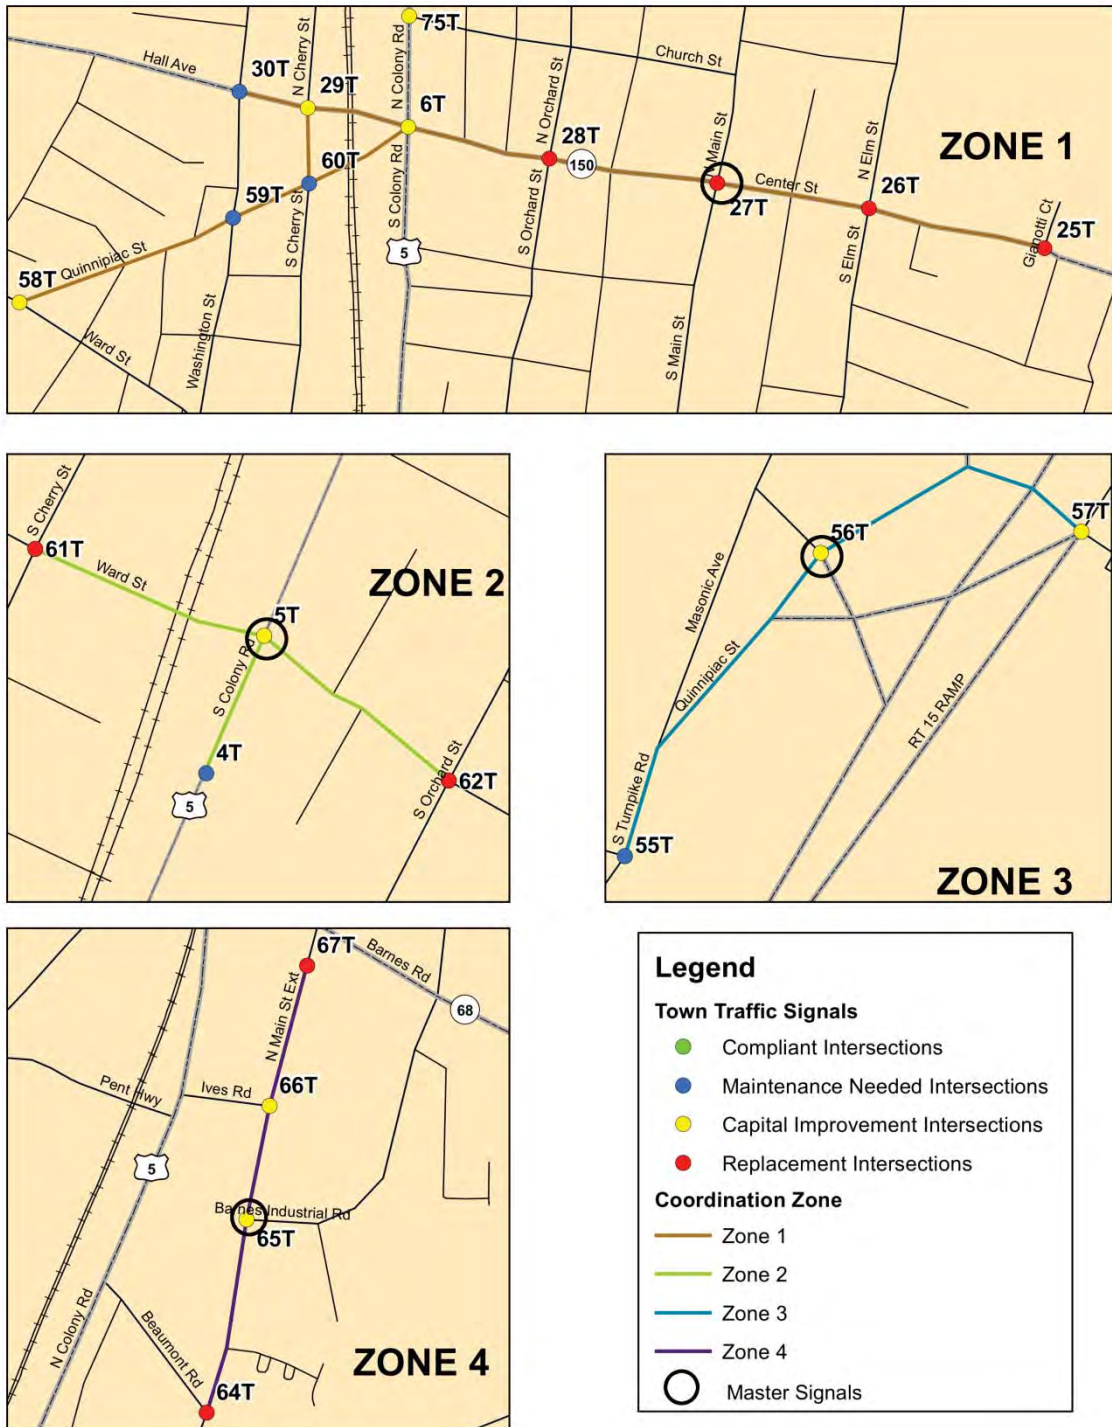

A number of coordination technologies are now available for locations where the existing traffic signal hard-wire interconnect communication system is not functioning and the repair would be too costly to implement. Wireless communication technology has advanced to a point where it can be considered a reliable and cost effective solution. Time-based traffic signal coordination can also be implemented by using the highly accurate time data transmitted by Global Positioning System (GPS) satellites. These data are used to synchronize the internal clocks of the local traffic signal controllers. This project is recommended to be funded at \$35,000.

System Retiming Update

Major improvement in traffic operations could be obtained by retiming Wallingford’s traffic signals.

The coordination plans for most project intersections are over 15 years old. Traffic patterns may have changed during that period of time. A traffic study is recommended to assess the existing coordination plans and recommend new settings where needed.

This project would include collecting counts at each intersection supplemented by Automatic Traffic Data assembled from existing CDOT data and other information the Town has. This data would be used to reset the timing at each intersection and develop updated system timing plans. We note that for this effort to be fully effective it would have to be preceded by the local repair efforts. The project could be first performed for non-coordinated intersections and then the effort bundled with each system repair. System work should include modeling of system operations using a software package similar to Synchro. We recommend a budget of \$50,000.00 for this effort.

4.2 System Level Improvements Cost Estimate Summary

The estimated system project costs are summarized in Table 3.

Table 3 - System Level Improvements Cost Estimate Summary

Project	Estimated Cost
Vehicle Detector Repair	\$30,000
System Coordination Repair	\$35,000
System Timing Update	\$50,000
TOTAL	\$115,000

4.3 Intersection Level Improvements

The following sections present the improvements recommended for each project intersection and the estimated cost associated with those improvements. Recommended improvements are based on the Qualitative Assessment category

assigned to each intersection. The recommended improvements were determined as follows:

1. **Compliant Intersection:** There are generally no recommended improvements for these intersections.
2. **Maintenance Needed:** Recommended improvements include items required to address identified deficiencies to bring the intersections in to a good state of repair. Reapplication of pavement markings is also included at all intersections in this category.
3. **Capital Improvement Intersection:** Recommended improvements generally consist of replacement of damaged/obsolete aboveground traffic signal equipment (e.g. controller, cabinet, span poles, pedestals, signal heads, emergency pre-emption equipment, loop detectors, wiring, regulatory signs and foundations). The hand hole and conduit system is assumed to be reused where possible as replacement of these elements could disturb existing roadways and sidewalks.
4. **Replacement Intersection:** Recommended improvements generally consist of replacement of all aboveground traffic signal equipment (e.g. controller, cabinet, span poles, pedestals, signal heads, emergency pre-emption equipment, loop detectors, wiring, regulatory signs and foundations). The hand hole and conduit system is assumed to be reused where possible. Damaged conduit and hand holes are assumed to be replaced. Replacement of these items may require areas of roadway and sidewalk construction. Reapplication of pavement markings is included where roadway work may be necessary.

4.3.1 Intersection 4T - South Colony Road (US Route 5) at Walgreens Shopping Center Driveway

This intersection is assessed as a “Maintenance needed” intersection. Recommended improvements include:

- Modify traffic signal controller settings to match record plans and implement traffic signal coordination.
- Repair/replace emergency vehicle pre-emption functions.
- Replace all existing traffic signal heads.
- Eliminate the use of wire nuts for cable splices in hand holes.
- Ensure vehicle loop detectors are functioning properly.

The estimated cost to implement these recommended improvements is \$37,000.

4.3.2 Intersection 5T - South Colony Road (US Route 5) at Ward Street

This intersection is assessed as a “Capital Improvement” intersection. Recommended Improvements include:

- Replace most of the existing traffic signal equipment, with reuse of the existing cabinet, and reuse of the existing hand hole and conduit system where possible. The existing traffic signals and mast arms controlling traffic at the railroad crossing would be retained.

The estimated cost to implement these recommended improvements is \$203,000.

4.3.3 Intersection 6T - North and South Colony Road (US Route 5) at Hall Avenue, Center Street, Quinnipiac Street

This intersection is assessed as a “Capital Improvement” intersection. Recommended Improvements include:

- Replace most existing traffic signal equipment, with reuse of the existing cabinet and reuse of the existing hand hole and conduit system where possible. The existing traffic signals and mast arms controlling traffic at the railroad crossing would be retained.

The estimated cost to implement these recommended improvements is \$216,000.

4.3.4 Intersection 25T - Center Street (Route 150) at Silver Pond Apartments Driveway

This intersection is assessed as a “Replacement” intersection. Recommended Improvements include:

- Replace all existing traffic signal equipment.
- Reconstruct sidewalk ramps.
- Mill and resurface sections of the approach roadways where needed for vehicle detector placement.

The estimated cost to implement these recommended improvements is \$150,000.

4.3.5 Intersection 26T - Center Street (Route 150) at North and South Elm Streets

This intersection is assessed as a “Replacement” intersection. Recommended Improvements include:

- Replace all existing traffic signal equipment.
- Reconstruct sidewalk ramps.
- Mill and resurface sections of the approach roadways where needed for vehicle detector placement.

The estimated cost to implement these recommended improvements is \$204,000.

4.3.6 Intersection 27T - Center Street (Route 150) at North and South Main Streets

This intersection is assessed as a “Replacement” intersection. Recommended Improvements include:

- Replace all existing traffic signal equipment. The existing traffic signal configuration consists of two span poles and a single span wire. The recommended configuration would include four span poles to support the span wire in a box configuration. This configuration ensures that all signal heads can be located in conformance with the requirements of the MUTCD.
- Reconstruct sidewalk ramps.
- Mill and resurface sections of the approach roadways where needed for vehicle detector placement.

The estimated cost to implement these recommended improvements is \$238,000.

4.3.7 Intersection 28T - Center Street (Route 150) at North and South Orchard Streets

This intersection is assessed as a “Capital Improvement” intersection. Recommended Improvements include:

- Replace most existing traffic signal equipment, with reuse of the existing hand hole and conduit system where possible. The existing traffic signal configuration consists of two span poles and a single span wire. The recommended configuration would include four span poles to support the span wire in a box configuration. This configuration ensures that all signal heads can be located in conformance with the requirements of the MUTCD.

The estimated cost to implement these recommended improvements is \$151,000.

4.3.8 Intersection 29T - Hall Avenue (Route 150) at North Cherry Street

This intersection is assessed as a “Capital Improvement” intersection. Recommended Improvements include:

- Replace most existing traffic signal equipment, with reuse of the existing hand hole and conduit system where possible. The existing traffic signal configuration consists of two span poles and a single span wire. The recommended configuration would include four span poles to support the span wire in a box configuration. This configuration ensures that all signal heads can be located in conformance with the requirements of the MUTCD.

The estimated cost to implement these recommended improvements is \$163,000.

4.3.9 Intersection 30T - Hall Avenue (Route 150) at Washington Street

This intersection is assessed as a “Maintenance needed” intersection. Recommended improvements include:

- Modify traffic signal controller settings to match record plans and implement traffic signal coordination.
- Repair/replace emergency vehicle pre-emption functions
- Eliminate the use of wire nuts for cable splices in hand holes.

The estimated cost to implement these recommended improvements is \$51,000.

4.3.10 Intersection 32T - Hall Avenue (Route 150) at Masonic Avenue/Fire Department Headquarters

This intersection is assessed as a “Replacement” intersection. Recommended Improvements include:

- Replace all existing traffic signal equipment.
- Mill and resurface the approach of Masonic Avenue within 100 feet of the intersection. Hall Avenue was recently resurfaced.

The estimated cost to implement these recommended improvements is \$164,000.

4.3.11 Intersection 54T - South Turnpike Road at Cook Hill Road

This intersection is assessed as a “Maintenance needed” intersection. Recommended improvements include:

- Modify traffic signal controller settings to match record plans and implement traffic signal coordination.
- Repair/replace emergency vehicle pre-emption functions
- Install new pedestrian signals and crosswalk markings on South Turnpike Road.
- Eliminate the use of wire nuts for cable splices in hand holes.

The estimated cost to implement these recommended improvements is \$33,000.

4.3.12 Intersection 55T - South Turnpike Road at Cheshire Road

This intersection is assessed as a “Maintenance needed” intersection. Recommended improvements include:

- Replace the existing traffic signal controller, program settings to match record plans and implement traffic signal coordination.
- Eliminate the use of wire nuts for cable splices in hand holes.

The estimated cost to implement these recommended improvements is \$30,000.

4.3.13 Intersection 56T - South Turnpike Road/Quinnipiac Street at Masonic Avenue/Route 15 Southbound Ramps

This intersection is assessed as a “Maintenance needed” intersection. Recommended improvements include:

- Replace the existing traffic signal controller, program settings to match record plans and implement traffic signal coordination.
- Replace the on-street master traffic signal controller.
- Replace all traffic signal heads.
- Eliminate the use of wire nuts for cable splices in hand holes.

- Relocate the two hand holes located in the roadway.
- Repair/replace damaged regulatory signs.

The estimated cost to implement these recommended improvements is \$87,000.

4.3.14 Intersection 57T - Quinnipiac Street at River Road/Route 15 Northbound Off-Ramp

This intersection is assessed as a “Capital Improvement” intersection. Recommended Improvements include:

- Replace most existing traffic signal equipment, with reuse of the existing hand hole and conduit system where possible. The advance warning sign with flashing beacons located on Quinnipiac Street is included in the equipment replacement.

The estimated cost to implement these recommended improvements is \$142,000.

4.3.15 Intersection 58T - Quinnipiac Street at Ward Street

This intersection is assessed as a “Capital Improvement” intersection. Recommended Improvements include:

- Replace most existing traffic signal equipment, with reuse of the existing hand hole and conduit system where possible.

The estimated cost to implement these recommended improvements is \$211,000.

4.3.16 Intersection 59T - Quinnipiac Street at Washington Street

This intersection is assessed as a “Maintenance needed” intersection. Recommended improvements include:

- Replace the existing traffic signal controller, program settings to match record plans and implement traffic signal coordination.
- Repair/replace emergency vehicle pre-emption functions.
- Eliminate the use of wire nuts for cable splices in hand holes.
- Mill and resurface sections of approach roadways where the existing roadway has deteriorated near existing vehicle loop detector locations.
- Replace vehicle loop detectors in areas of milling and resurfacing.
- Reconstruct sidewalk ramps.
- Replace all loop detector amplifier cards.
- Reapply pavement markings.

The estimated cost to implement these recommended improvements is \$77,000.

4.3.17 Intersection 60T - Quinnipiac Street at North and South Cherry Street

This intersection is assessed as a “Maintenance needed” intersection. Recommended improvements include:

- Replace existing traffic signal controller with a new controller, program settings to match record plans and implement traffic signal coordination.
- Replace the existing bowed wooden span pole with a new steel span pole
- Eliminate the use of wire nuts for cable splices in hand holes.
- Reconstruct sidewalk ramps.
- Repair/replace damaged regulatory signs.

The estimated cost to implement these recommended improvements is \$69,000.

4.3.18 Intersection 61T - Ward Street at South Cherry Street

This intersection is assessed as a “Replacement” intersection. Recommended Improvements include:

- Replace all existing traffic signal equipment. The existing traffic signal configuration consists of two span poles and a single span wire. The recommended configuration would include four span poles to support the span wire in in a box configuration. This configuration ensures that all signal heads can be located in conformance with the requirements of the MUTCD.
- Reconstruct sidewalk ramps.
- Mill and resurface sections of the approach roadways where needed for vehicle detector placement.

The estimated cost to implement these recommended improvements is \$204,000.

4.3.19 Intersection 62T - Ward Street at South Orchard Street

This intersection is assessed as a “Replacement” intersection. Recommended Improvements include:

- Replace all existing traffic signal equipment. The existing traffic signal configuration consists of two span poles and a single span wire. The recommended configuration would include four span poles to support the span wire in in a box configuration. This configuration ensures that all signal heads can be located in conformance with the requirements of the MUTCD.
- Reconstruct sidewalk ramps.
- Mill and resurface sections of the approach roadways where needed for vehicle detector placement.

The estimated cost to implement these recommended improvements is \$182,000.

4.3.20 Intersection 63T - North Plains Industrial Road at Pent Highway

This intersection is assessed as a “Replacement” intersection. Recommended Improvements include:

- Replace all existing traffic signal equipment.
- Reconstruct sidewalk ramps.

- Mill and resurface sections of the approach roadways where needed for vehicle detector placement.

The estimated cost to implement these recommended improvements is \$151,000.

4.3.21 Intersection 64T - North Main Street Extension at Beaumont Road

This intersection is assessed as a “Replacement” intersection. Recommended Improvements include:

- Replace all existing traffic signal equipment. The existing traffic signal configuration consists of two span poles and a single span wire. The recommended configuration would include four span poles to support the span wire in a box configuration. This configuration ensures that all signal heads can be located in conformance with the requirements of the MUTCD.
- Reconstruct sidewalk ramps.
- Mill and resurface sections of the approach roadways where needed for vehicle detector placement.

The estimated cost to implement these recommended improvements is \$176,000.

4.3.22 Intersection 65T - North Main Street Extension at Barnes Industrial Road/Wal-Mart Driveway

This intersection is assessed as a “Capital Improvement” intersection. Recommended Improvements include:

- Replace most existing traffic signal equipment, with reuse of the existing cabinet and reuse of the existing hand hole and conduit system where possible. The closed-loop mater controller is located at this intersection and is included in the equipment replacement.

The estimated cost to implement these recommended improvements is \$176,000.

4.3.23 Intersection 66T - North Main Street Extension at Ives Road

This intersection is assessed as a “Capital Improvement” intersection. Recommended Improvements include:

- Replace most existing traffic signal equipment, with reuse of the existing hand hole and conduit system where possible.

The estimated cost to implement these recommended improvements is \$148,000.

4.3.24 Intersection 67T - North Main Street Extension at Stop & Shop Shopping Center Driveway

This intersection is assessed as a “Replacement” intersection. Recommended Improvements include:

- Replace all existing traffic signal equipment.
- Reconstruct sidewalk ramps.
- Mill and resurface sections of the approach roadways where needed for vehicle detector placement.

The estimated cost to implement these recommended improvements is \$179,000.

4.3.25 Intersection 68T - Barnes Industrial Road North at Barnes Road

This intersection is assessed as a “Capital Improvement” intersection. Recommended Improvements include:

- Replace most existing traffic signal equipment, with reuse of the existing cabinet and reuse of the existing hand hole and conduit system where possible.

The estimated cost to implement these recommended improvements is \$103,000.

4.3.26 Intersection 69T - Research Parkway at Bristol-Myers Squibb Main Driveway

This intersection is assessed as a “Maintenance needed” intersection. Recommended improvements include:

- Replace the 3-section signal head that is currently fastened together with rope.
- Eliminate the use of wire nuts for cable splices in hand holes.
- Repair/replace damaged regulatory signs.
- Reapply pavement markings.

The estimated cost to implement these recommended improvements is \$18,000.

4.3.27 Intersection 71T - Cook Hill Road at Oakdale Theater North Driveway

This intersection is assessed as a “Compliant” intersection. No improvements are recommended for this intersection.

4.3.28 Intersection 72T - South Turnpike Road at Oakdale Theater East Driveway

This intersection is assessed as a “Compliant” intersection. No physical improvements are recommended for this intersection. An analysis of traffic signal warrants is recommended at this location to assess the need to upgrade the existing flashing beacon to for a fully functional traffic signal.

4.3.29 Intersection 73T - John Street at South Cherry Street

This intersection is assessed as a “Capital Improvement” intersection. Recommended Improvements include:

- Replace all existing traffic signal equipment, with reuse of the existing hand hole and conduit system where possible. An analysis of traffic signal warrants is recommended at this location to assess the need to retain this existing traffic signal.

The estimated cost to implement these recommended improvements is \$115,000.

4.3.30 Intersection 74T - Hope Hill Road at Yalesville Fire Department

This intersection is assessed as a “Capital Improvement” intersection. Recommended Improvements include:

- Replace most existing traffic signal equipment, with reuse of the existing cabinet and reuse of the existing hand hole and conduit system where possible.

The estimated cost to implement these recommended improvements is \$77,000.

4.3.31 Intersection 75T - North Colony Street (US Route 5) at Holy Trinity Church

This intersection is assessed as a “Capital Improvement” intersection. This location is currently unsignalized. An analysis of traffic signal warrants is recommended to assess the need for a pedestrian traffic signal or a flashing pedestrian hybrid signal.

Physical improvement recommendations include construction of sidewalk ramps and reconstruction of sidewalk areas as needed.

The estimated cost to implement these recommended improvements is \$13,000.

4.4 Intersection Level Cost Estimate Summary

The estimated intersection costs are summarized in Table 4 through Table 7. Estimates are based on 2011 ConnDOT Weighted Unit Prices.

Table 4 - Intersection Cost Estimate Summary

Qualitative Assessment		Total
2	Maintenance Needed Intersections	\$402,000
3	Capital Improvement Intersections	\$1,718,000
4	Replacement Intersections	\$1,648,000
TOTAL		\$3,768,000

Table 5 - Intersection Cost Estimate Summary - Maintenance Needed Intersections

Intersection	Estimated Cost				Priority
	Equipment	Software	Geometric	Total	
59T Quinnipiac Street at Washington Street	\$47,000	\$0	\$30,000	\$77,000	1
60T Quinnipiac Street at North and South Cherry Street	\$46,000	\$0	\$16,000	\$69,000	2
4T South Colony Road (US Route 5) at Walgreens Shopping Center Driveway	\$32,000	\$5,000	\$0	\$37,000	3
30T Hall Avenue (Route 150) at Washington Street	\$51,000	\$0	\$0	\$51,000	4
54T South Turnpike Road at Cook Hill Road	\$27,000	\$5,000	\$1,000	\$33,000	5
55T South Turnpike Road at Cheshire Road	\$30,000	\$0	\$0	\$30,000	6
56T South Turnpike Road/Quinnipiac Street at Masonic Avenue/Route 15 Southbound Ramps	\$87,000	\$0	\$0	\$87,000	7
69T Research Parkway at Bristol-Myers Squibb Main Driveway	\$13,000	\$5,000	\$0	\$18,000	8
				TOTAL	\$402,000

Table 6 - Intersection Cost Estimate Summary - Capital Improvement Intersections

Intersection	Estimated Cost				Priority	
	Equipment	Software	Geometric	Total		
28T	Center Street (Route 150) at North and South Orchard Streets	\$151,000	\$0	\$0	\$151,000	1
5T	South Colony Road (US Route 5) at Ward Street	\$184,000	\$5,000	\$14,000	\$203,000	2
6T	North and South Colony Road (US Route 5) at Hall Avenue, Center Street, Quinnipiac Street	\$197,000	\$0	\$19,000	\$216,000	3
29T	Hall Avenue (Route 150) at North Cherry Street	\$163,000	\$0	\$0	\$163,000	4
57T	Quinnipiac Street at River Road/Route 15 Northbound Off-Ramp	\$142,000	\$0	\$0	\$142,000	5
58T	Quinnipiac Street at Ward Street	\$207,000	\$0	\$4,000	\$211,000	6
65T	North Main Street Extension at Barnes Industrial Road/Wal-Mart Driveway	\$176,000	\$0	\$0	\$176,000	7
66T	North Main Street Extension at Ives Road	\$148,000	\$0	\$0	\$148,000	8
68T	Barnes Industrial Road North at Barnes Road	\$103,000	\$0	\$0	\$103,000	9
73T	John Street at South Cherry Street	\$115,000	\$0	\$0	\$115,000	10
74T	Hope Hill Road at Yalesville Fire Department	\$77,000	\$0	\$0	\$77,000	11
75T	North Colony Street (US Route 5) at Holy Trinity Church	\$2,000	\$0	\$11,000	\$13,000	12
				TOTAL	\$1,718,000	

Table 7 - Intersection Cost Estimate Summary - Replacement Intersections

Intersection	Estimated Cost				Priority
	Equipment	Software	Geometric	Total	
27T Center Street (Route 150) at North and South Main Streets	\$192,000	\$0	\$46,000	\$238,000	1
26T Center Street (Route 150) at North and South Elm Streets	\$161,000	\$0	\$43,000	\$204,000	2
25T Center Street (Route 150) at Silver Pond Apartments Driveway	\$132,000	\$0	\$18,000	\$150,000	3
67T North Main Street Extension at Stop & Shop Shopping Center Driveway	\$163,000	\$0	\$16,000	\$179,000	4
61T Ward Street at South Cherry Street	\$166,000	\$0	\$38,000	\$204,000	5
64T North Main Street Extension at Beaumont Road	\$163,000	\$0	\$13,000	\$176,000	6
63T North Plains Industrial Road at Pent Highway	\$135,000	\$0	\$16,000	\$151,000	7
62T Ward Street at South Orchard Street	\$166,000	\$0	\$16,000	\$182,000	8
32T Hall Avenue (Route 150) at Masonic Avenue/Fire Dept. Headquarters	\$149,000	\$0	\$15,000	\$164,000	9
			TOTAL	\$1,648,000	

4.5 Recommended Prioritization

The following list of priorities is based primarily on the condition of the existing equipment as determined by the field inventory and a review of traffic signal maintenance logs.

Priority Area 1: Repair vehicle detection, traffic signal coordination, and traffic signal timing system wide. Simple timing changes and coordination of operations at adjacent intersections could significantly improve traffic operations within the Town. Repair of broken vehicle detectors will also reduce the amount of unused time given to non-coordinated signal phases. These are relatively low cost improvements that could be implemented in a short period of time and could have a significant effect on traffic signal operations town wide.

Priority Area 2: Implement recommended improvements along Center Street which include the following intersections:

- 25T - Center Street (Route 150) at Silver Pond Apartments Driveway
- 26T - Center Street (Route 150) at North and South Elm Streets
- 27T - Center Street (Route 150) at North and South Main Streets
- 28T - Center Street (Route 150) at North and South Orchard Streets

These intersections are among the oldest in the Town system. Most of the equipment is outdated and reaching the end of its useful life. A review of maintenance records shows that these intersections require the most on-going maintenance.

Priority Area 3: Implement recommended improvements at project intersections along Hall Avenue, Quinnipiac Street, and South Colony Road which include the following intersections:

- 5T - South Colony Road (US Route 5) at Ward Street
- 6T - North and South Colony Road (US Route 5) at Hall Avenue, Center Street, Quinnipiac Street
- 29T - Hall Avenue (Route 150) at North Cherry Street
- 57T - Quinnipiac Street at River Road/Route 15 Northbound Off-Ramp
- 58T - Quinnipiac Street at Ward Street
- 59T - Quinnipiac Street at Washington Street
- 60T - Quinnipiac Street at North and South Cherry Street
- 61T - Ward Street at South Cherry Street

Priority Area 4: Implement recommended improvements at all intersections categorized as “Maintenance needed” which include the following intersections:

- 4T - South Colony Road (US Route 5) at Walgreens Shopping Center Driveway
- 30T - Hall Avenue (Route 150) at Washington Street
- 54T - South Turnpike Road at Cook Hill Road
- 55T - South Turnpike Road at Cheshire Road

Traffic Signal Inventory

Wallingford, CT

- 56T - South Turnpike Road/Quinnipiac Street at Masonic Avenue/Route 15 Southbound Ramps
- 59T - Quinnipiac Street at Washington Street
- 60T - Quinnipiac Street at North and South Cherry Street
- 69T - Research Parkway at Bristol-Myers Squibb Main Driveway

Most intersections in this category require improvements that are in the low to middle price range. These intersections could most likely be repaired using existing town maintenance contracts in a short time frame. These improvements were given a lower priority because they are typically not critical to the safe operation of the traffic signal.

Priority Area 5: Implement recommended improvements along North Main Street Extension which includes the following intersections:

- 64T - North Main Street Extension at Beaumont Road
- 65T - North Main Street Extension at Barnes Industrial Road/Wal-Mart Driveway
- 66T - North Main Street Extension at Ives Road
- 67T - North Main Street Extension at Stop & Shop Shopping Center Driveway

These closely spaced intersections located in a heavy Industrial and commercial area could benefit from improved timing and traffic signal coordination. The traffic signal located at the driveway from the Stop & Shop Plaza appears to be the oldest in the Town system.


Priority Area 6: Implement recommended improvements at the remaining project intersections which include:

- 32T - Hall Avenue (Route 150) at Masonic Avenue/Fire Dept. Headquarters
- 62T - Ward Street at South Orchard Street
- 63T - North Plains Industrial Road at Pent Highway
- 68T - Barnes Industrial Road North at Barnes Road
- 73T - John Street at South Cherry Street
- 74T - Hope Hill Road at Yalesville Fire Department
- 75T - North Colony Street (US Route 5) at Holy Trinity Church

APPENDIX A - INTERSECTION PLANS

F.H.W.A. PROJ. NO.	STATE	TOWN	FED. AID PROJ. NO.	PROJ. NO.	YEAR	ROUTE NO.	SHEET NO.	TOTAL SHEETS
1	CONN.	WALLINGFORD	CM-55 (133)	148-158	1995	5	13	38

INTERSECTION # 148-204
METERED SERVICE
 OFFICE RECORD REVISION #
 SERVICE POLE- SNET 932
 SIGNAL REVISED
 REPLACED CONTROLLER AND INSTALLED OPTICAL DETECTORS UNDER PROJECT 148-158

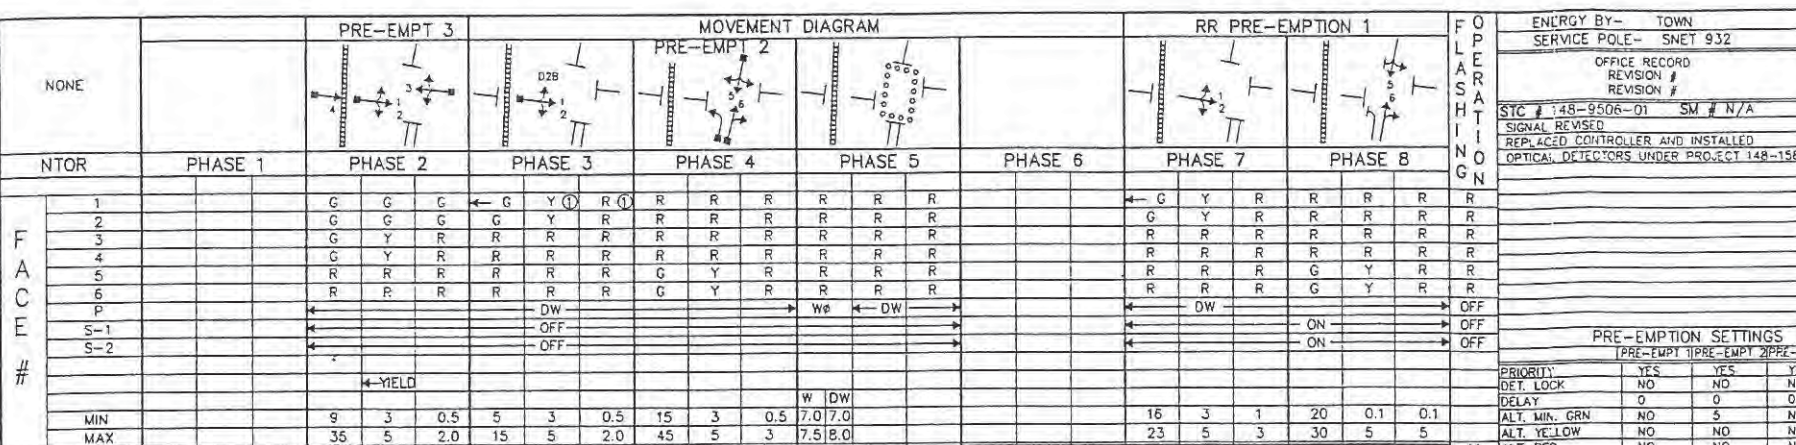

FACE #	NTOR	PHASE 1	PHASE 2	PHASE 3	PHASE 4	PHASE 5	PHASE 6	PHASE 7	PHASE 8
1		G	G	G	G	R	R	R	R
2		G	G	G	G	R	R	R	R
3		G	Y	R	R	R	R	R	R
4		G	Y	R	R	R	R	R	R
5		R	R	R	R	G	Y	R	R
6		R	R	R	R	R	R	R	R
7		R	R	R	R	R	R	G	Y
8		R	R	R	R	R	R	R	R

PRE-EMPTION SETTINGS

PRIORITY	YES	NO	YES	NO	YES	NO
DET. LOCK	NO	NO	NO	NO	NO	NO
DELAY	0	0	0	0	0	0
ALT. MIN. GRN	NO	NO	5	NO	NO	NO
ALT. YELLOW	NO	NO	NO	NO	NO	NO
ALT. RED	NO	NO	NO	NO	NO	NO
ALT. RED CLR	0	0	0	0	0	0
TRACK CLEAR GREEN	22	0	0	0	0	0
TRACK CLEAR YELLOW	4	0	0	0	0	0
TRACK CLEAR RED	2	0	0	0	0	0
HOLD GREEN	20	15	15	0	0	0
HOLD YELLOW	0.1	4	4	0	0	0
HOLD RED	0.1	2	2	0	0	0
HOLD PHASE	8	4	2	0	0	0
EXT PHASE	2	2	3	0	0	0
EXT CALL	NONE	NONE	NONE	0	0	0

SIGNAL FACES

TOWN SIGNAL

STATE OF CONNECTICUT DEPARTMENT OF TRANSPORTATION BUREAU OF ENGINEERING & HWY OPERATIONS DIVISION OF TRAFFIC ENGINEERING

TRAFFIC CONTROL SIGNAL

TOWN OF WALLINGFORD US ROUTE 5 (SOUTH COLONY STREET) AT WARD STREET

DETECTORS

IDENT	SIZE	TURNS	MODE	FUNCTION	TIME	DAYS
D2E	7'x6'	3	8" DELAY	FLASH	(2)	
D2A	10'x6'	3	PRESENCE	MAX. 1	ALL OTHER TIMES	DAILY
D2F	10'x6'	3	PRESENCE	MAX. 2	11:30-12:15	M-W, SAT
D2B	10'x6'	3	10" DELAY	MAX. 2	11:30-12:15	THUR, FRI
D2D	6'x6'	3	8" DELAY	PATTERNS	TO BE DETERMINED BY ICHN	
D2C	9'x6'	3	PRESENCE	FREE	2300-0500	DAILY
D4A	14'x6'	3	PRESENCE	FREE	2300-0500	DAILY
D4B	6'x6'	4	PRESENCE			

TECHNICAL NOTES

STANDARD OVERLAP SKIP FEATURES APPLY

1 TO REMAIN ← G IF RAILROAD PRE-EMPTION IS NEXT

2 D2B TO EXTEND PHASE 3 ONLY

3 D2A AND D2F TO OPERATE DURING PHASE 2.

4 SIGNAL SHALL IMMEDIATELY ADVANCE OUT OF ANY GREEN INCLUDING MIN. GREEN INTO CLEARANCE INTERVALS GOING TO PRE-EMPTION & THEN GO DIRECTLY TO PHASE 7

DETECTORS D2A, D2C, D2D, AND D2E TO BE NONACTUATING DURING COORDINATED OPERATION.

PHASE 2 ON TO OMIT PHASE 4 AND 5.

PHASE 4 AND 5 CHECK TO CALL BUT NOT EXTEND PHASE 3.

CONSTRUCTION NOTES

ALL TRAFFIC SIGNAL EQUIPMENT IS EXISTING EXCEPT AS NOTED

STAKE ALL R.O.W. PRIOR TO EXCAVATION

INSTALL EIGHT PHASE FULLY ACTUATED CONTROLLER IN A TYPE "C" CABINET ON EXISTING FOUNDATION. MODIFY FOUNDATION TO INSTALL 3-2" RMC SWEEPS

INSTALL LOOP DETECTORS D4A, D4B, D4C, HANDHOLE, 2" RMC AND 14/2 CABLING TO CONTROLLER

INSTALL LOUVERS ON FACES 1 AND 2.

REPLACE SIGNAL HEADS 4 WITH 3-SECTION 12" HEADS

INSTALL OPTICAL DETECTOR

1 INSTALL HANDHOLE AND 2" RMC BETWEEN HANDHOLE AND 2" RMC SWEEP INSTALLED IN FOUNDATION. INSTALL 2-16/12 INTERCONNECT IN 2" RMC.

INSTALL HANDHOLE AT BASE OF POLE SHET 2862 AND 2" RISER ON POLE. INSTALL 2" RMC BETWEEN RISER AND HANDHOLE AND INSTALL 16/12 INTERCONNECT

INSTALL 2" RISER AND STANDOFF ON POLE SNET 932. REMOVE 1" RISER

2 INSTALL CABLE CLOSURE (TYPE A).

NEW LOOPS ARE TO BE INSTALLED IN CENTER OF LAKE AND SHOULD BE FIELD LOCATED PRIOR TO CUTTING ROADWAY

INSTALL HANDHOLES APPROXIMATELY 1' BEHIND CURB OR EDGE OF ROAD UNLESS OTHERWISE SPECIFIED

REMOVE ALL ABANDONED TRAFFIC SIGNAL EQUIPMENT INCLUDING FOUNDATIONS, CONDUIT, RISERS AND CABLE, MESSENGER AND INTERCONNECT

UNLESS OTHERWISE NOTED ALL EXISTING TRAFFIC SIGNAL EQUIPMENT BEING REMOVED IS TO BE RETURNED TO THE STATE OF CONNECTICUT, SHOOK STREET, ROCKY HILL

CABINET DOOR TO OPEN FIELD SIDE

INSTALL SIDEWALK 3'x4' IN FRONT OF CONTROLLER FOUNDATION. DOOR SIDE.

THE CONTRACTOR SHALL TELEPHONE "CALL BEFORE YOU DIG" PRIOR TO ANY EXCAVATION

CONTRACTOR TO INSTALL PAVEMENT MARKINGS AS SHOWN

TWO WEEKS PRIOR TO INSTALLATION CONTACT WALLINGFORD ELECTRIC REPRESENTATIVE ARTHUR DUTRA AT (203) 265-5932 SNET REPRESENTATIVE ROBERT WENTWORTH AT (203) 725-4519, AND TC CABLEVISION REPRESENTATIVE JAMES HUBBARD AT (203) 483-3622

CONTRACTOR TO NOTIFY ATTHACK REPRESENTATIVE PETER FINCH AT (203) 773-6014 TWO WEEKS PRIOR TO DISCONNECTING THE RAILROAD PRE-EMPTION

ALL SIGNS REMOVED DURING CONSTRUCTION SHALL BE REPLACED IN-KIND UNLESS OTHERWISE NOTED.

INSTALL NEW EMERGENCY VEHICLE PRE-EMPTION EQUIPMENT

OPTICAL DETECTOR LOCATIONS ARE FOR ILLUSTRATION ONLY. EXACT LOCATIONS SHALL BE DETERMINED BY THE MANUFACTURER OR HIS DESIGNATED REPRESENTATIVE. DETECTOR CABLES ARE TO BE INSTALLED CONTINUOUS BETWEEN EACH OPTICAL DETECTOR AND THE AUXILIARY EQUIPMENT CABINET

CABINET TO BE EQUIPPED WITH AN OUTSIDE ELECTRIC METER CLOSURE TO BE MOUNTED ON THE SIDE OF THE CABINET AND APPROVED BY WALLINGFORD ELECTRIC (WE)

RAILROAD PRE-EMPTION (INTERNAL OPERATION)

TRAIN ENTERS TRACK CIRCUIT - RR PROVIDES IMMEDIATE PRE-EMPTION CIRCUIT TO THE TRAFFIC SIGNAL CONTROLLER CABINET

THE TRAFFIC SIGNAL CONTROLLER IMMEDIATELY ADVANCES THE SEQUENCE TO THE TRACK CLEARANCE PHASE AND THEN HOLD PHASE (PHASES 7 AND 8) VS THE PROPER YELLOW AND RED CLEARANCE INTERVALS

THE TURN RESTRICTION SIGNS WILL BE ILLUMINATED WITH THE TRAFFIC SIGNAL PRE-EMPTION PHASE 7.

THE R.R. FLASHING LIGHTS WILL COMMENCE OPERATION 9 TO 14 SECONDS INTO THE TRAFFIC SIGNAL TRACK CLEARANCE PHASE (PHASE 7) DEPENDING UPON WHICH INTERVAL THE TRAFFIC SIGNAL CONTROLLER IS IN WHEN THE PRE-EMPTION CALL IS RECEIVED. STANDARD R.R. FLASHING LIGHTS, GATES, AND BELLS WILL COMMENCE A MINIMUM OF 29 SECONDS PRIOR TO THE TRAIN ENTERING THE CROSSING

THE TRACK CLEARANCE INTERVAL WILL TERMINATE AND THE TRAFFIC SIGNAL PRE-EMPTION PHASE 7 WILL HOLD IN THE PRE-EMPTION PHASE (PHASE 7)

WHEN THE TRAIN HAS LEFT THE CROSSING AND THE TRACK CIRCUIT, THE RAILROAD DEVICES AND ILLUMINATED SIGNS WILL DEACTIVATE, AND THE TRAFFIC SIGNAL SIGNAL SHALL RETURN TO NORMAL OPERATION, PHASE 2.

RAILROAD PRE-EMPTION (EXTERNAL OPERATION)

TRAIN ENTERS TRACK CIRCUIT - RR PROVIDES IMMEDIATE PRE-EMPTION CIRCUIT TO THE TRAFFIC SIGNAL CABINET

THE FLASHING OPERATION IMMEDIATELY REVERTS TO A SOLID RED ON FACES 3 AND 4. FACES 1, 2, 5, AND 6 WILL REMAIN FLASHING AND THE SIGNAL WILL HOLD IN THIS INTERVAL

THE TURN RESTRICTION SIGNS SHALL BE ILLUMINATED IMMEDIATELY UPON RECEIPT OF THE RAILROAD PRE-EMPTION CALL

THE R.R. FLASHING LIGHTS, GATES AND BELLS WILL COMMENCE OPERATION 15 SECONDS AFTER TRAIN HAS ENTERED THE TRACK CIRCUIT. STANDARD R.R. FLASHING LIGHTS, GATES AND BELLS WILL COMMENCE A MINIMUM OF 29 SECONDS PRIOR TO THE TRAIN ENTERING THE CROSSING.

WHEN THE TRAIN HAS LEFT THE CROSSING AND THE TRACK CIRCUIT, THE RAILROAD DEVICES AND ILLUMINATED SIGNS WILL DEACTIVATE, AND THE TRAFFIC SIGNAL SIGNAL SHALL RETURN TO FLASHING OPERATION.

SIGN LEGEND

(A) EXISTING 31-0410 (DO NOT STOP ON TRACKS)

(B) INSTALL 31-0135 (SPAN MTD)

(C) INSTALL 41-2205(R) (CROSSROAD WITH RR PARALLEL)

(D) INSTALL 31-0349 (T)

NOTE:


STATE TO MAINTAIN ALL SIGNS, PAVEMENT MARKINGS, AND CROSSWALKS ON STATE ROADS AND ALL STOP BARS.

TOWN TO MAINTAIN ALL SIGNS, PAVEMENT MARKINGS, AND CROSSWALKS ON TOWN ROADS.

RAILROAD PRE-EMPTION TO BE MAINTAINED BY STATE

EMERGENCY VEHICLE PRE-EMPTION TO BE MAINTAINED BY TOWN OF WALLINGFORD.

BAR TYPE CROSSWALKS (16"x16"x2")

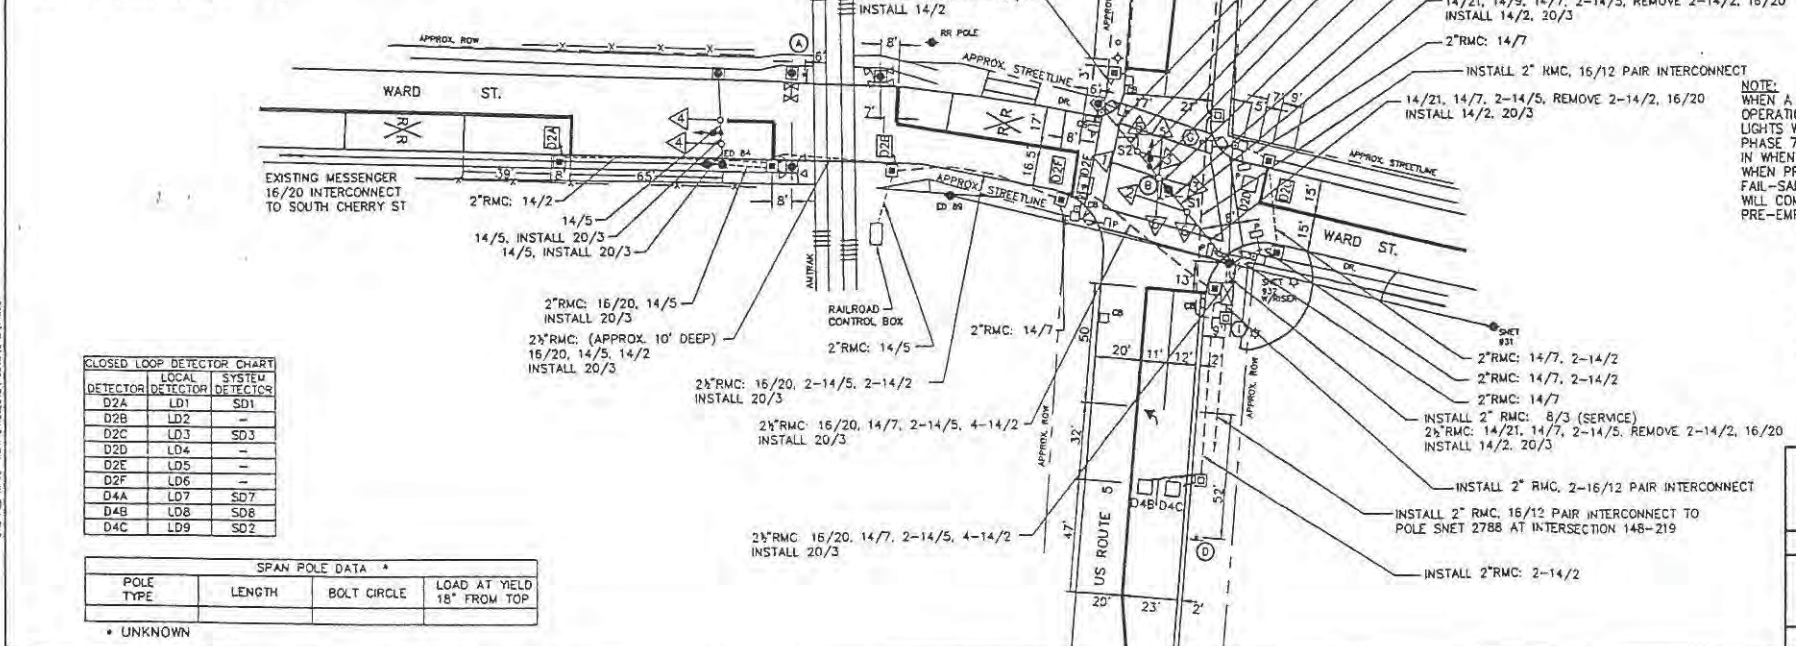

REV. # INTERSECTION #148-204

TIME	EVENT
0"	START OF TRAFFIC SIGNAL PRE-EMPTION
10"	START OF RAILROAD FLASHING LIGHTS AND BELLS
22"	RAILROAD GATES START TO DROP
32"	RAILROAD GATES HORIZONTAL
44"	TRAIN ENTERS THE CROSSING

RAILROAD PRE-EMPTION

TIME	EVENT
0"	START OF TRAFFIC SIGNAL PRE-EMPTION
10"	START OF RAILROAD FLASHING LIGHTS AND BELLS
22"	RAILROAD GATES START TO DROP
32"	RAILROAD GATES HORIZONTAL
44"	TRAIN ENTERS THE CROSSING

TOWN SIGNAL

STATE OF CONNECTICUT DEPARTMENT OF TRANSPORTATION BUREAU OF ENGINEERING & HWY OPERATIONS DIVISION OF TRAFFIC ENGINEERING

TRAFFIC CONTROL SIGNAL LAYOUT


TOWN OF WALLINGFORD US ROUTE 5 (SOUTH COLONY STREET) AT WARD STREET

SCALE 1"=40'

STATE OF CONNECTICUT DEPARTMENT OF TRANSPORTATION BUREAU OF ENGINEERING & HIGHWAY OPERATIONS DIVISION OF TRAFFIC ENGINEERING

TRAFFIC CONTROL SIGNAL

PHASING

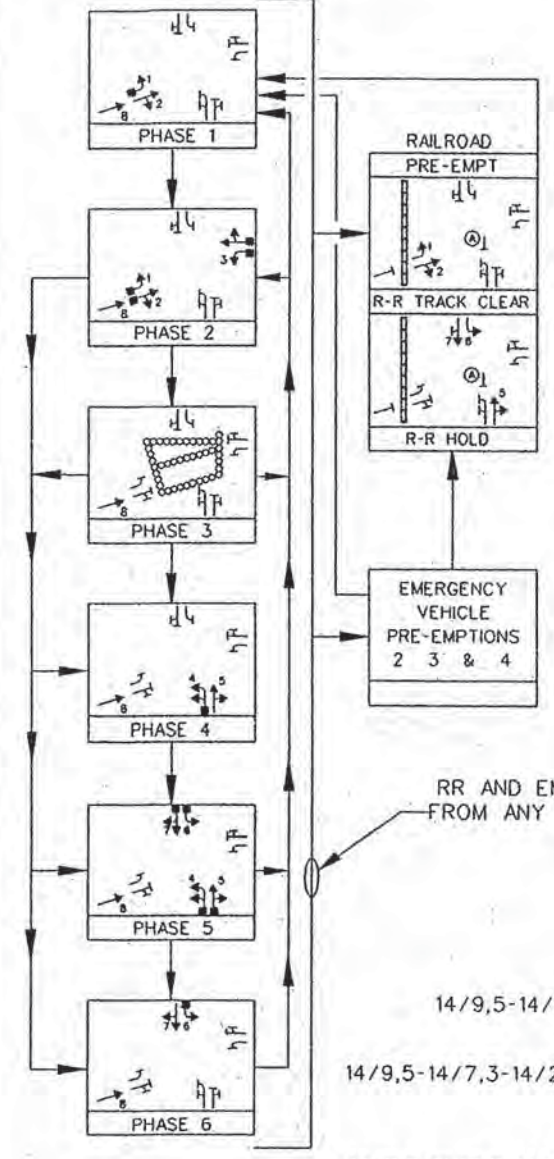

PRE-EMPT #1		RAILROAD PRE-EMPT		RAILROAD PRE-EMPTION FROM FAIL-SAFE AND EMERGENCY FLASH	
NTOR	R-R TRACK CLEAR	R-R HOLD	CL	CL	CL
1	GRN	CL	GRN	CL	CL
2	G	Y	R	R	FLR
3	R	R	R	R	FLR
4	R	R	R	R	R
5	R	R	R	G	Y
6	R	R	R	G	Y
7	R	R	R	G	Y
8	R	R	R	R	R
P	DW	DW	OFF	OFF	OFF
MIN	35	3	1	20	3
MAX	45	4	3	40	4

INTERVALS	MIN GRN	WALK	PRO CLR	VEH EXT	MAX 1	MAX 2	MIN GAP	MODE	ON-OMT	ON-OMT
1	37									
2										
3										
4										
5										
6										
7										
8										

SEE SIGNAL PLAN FOR CT. ROUTE 150 (HALL AVENUE) AND NORTH CHERRY STREET (INT #148-218)

- SIGN LEGEND**
- (A) INTERNALLY ILLUMINATED "NO LEFT TURN" SIGN
 - (B) 31-0823 (SPAN MTD) (NTOR)
 - (C) 31-0282 (NTOR)
 - (D) 31-0282(2) (NTOR)
 - (E) 31-0280 (NTOR)
 - (F) 31-0824 (NTOR)
 - (G) 31-0281 (NTOR)
 - (K) INSTALL 31-0841 (LEFT TURN SIGNAL)
 - (L) INSTALL 31-0823 (NTOR)
 - (M) 31-0349


NOTES:
SEE SEPARATE PAVEMENT MARKING AND SIGNING PLAN. PAVEMENT MARKINGS AND SIGNING TO BE INSTALLED BY THE CONTRACTOR (AS PER PLAN). STATE TO MAINTAIN ALL SIGNS, MARKINGS, AND CROSS WALKS ON STATE ROADS AND ALL STOP BARS TOWN TO MAINTAIN ALL SIGNS, MARKINGS, AND CROSS WALKS ON TOWN ROADS.

TIME	EVENT
0"	START RAILROAD PRE-EMPTION
23"	START RAILROAD LIGHTS
30"	START RAILROAD GATES
40"	GATES HORIZONTAL
52"	TRAIN ENTERS CROSSING


NOTE: WHEN A RAILROAD PRE-EMPTION CALL IS RECEIVED DURING NORMAL TRAFFIC SIGNAL OPERATION, OR MANUAL OPERATION, RAILROAD FLASHING LIGHTS WILL COMMENCE OPERATION 18 TO 22 SECONDS INTO THE TRACK CLEAR PHASE DEPENDING ON WHICH INTERVAL CONTROLLER IS IN WHEN PRE-EMPTION CALL IS RECEIVED.

WHEN RAILROAD PRE-EMPTION OCCURS DURING EMERGENCY FLASH OR FAIL-SAFE FLASHING OPERATION, RAILROAD FLASHING LIGHTS WILL COMMENCE OPERATION 23 SECONDS AFTER PRE-EMPTION CALL IS RECEIVED.

DETAIL OF OVERHEAD WIRING

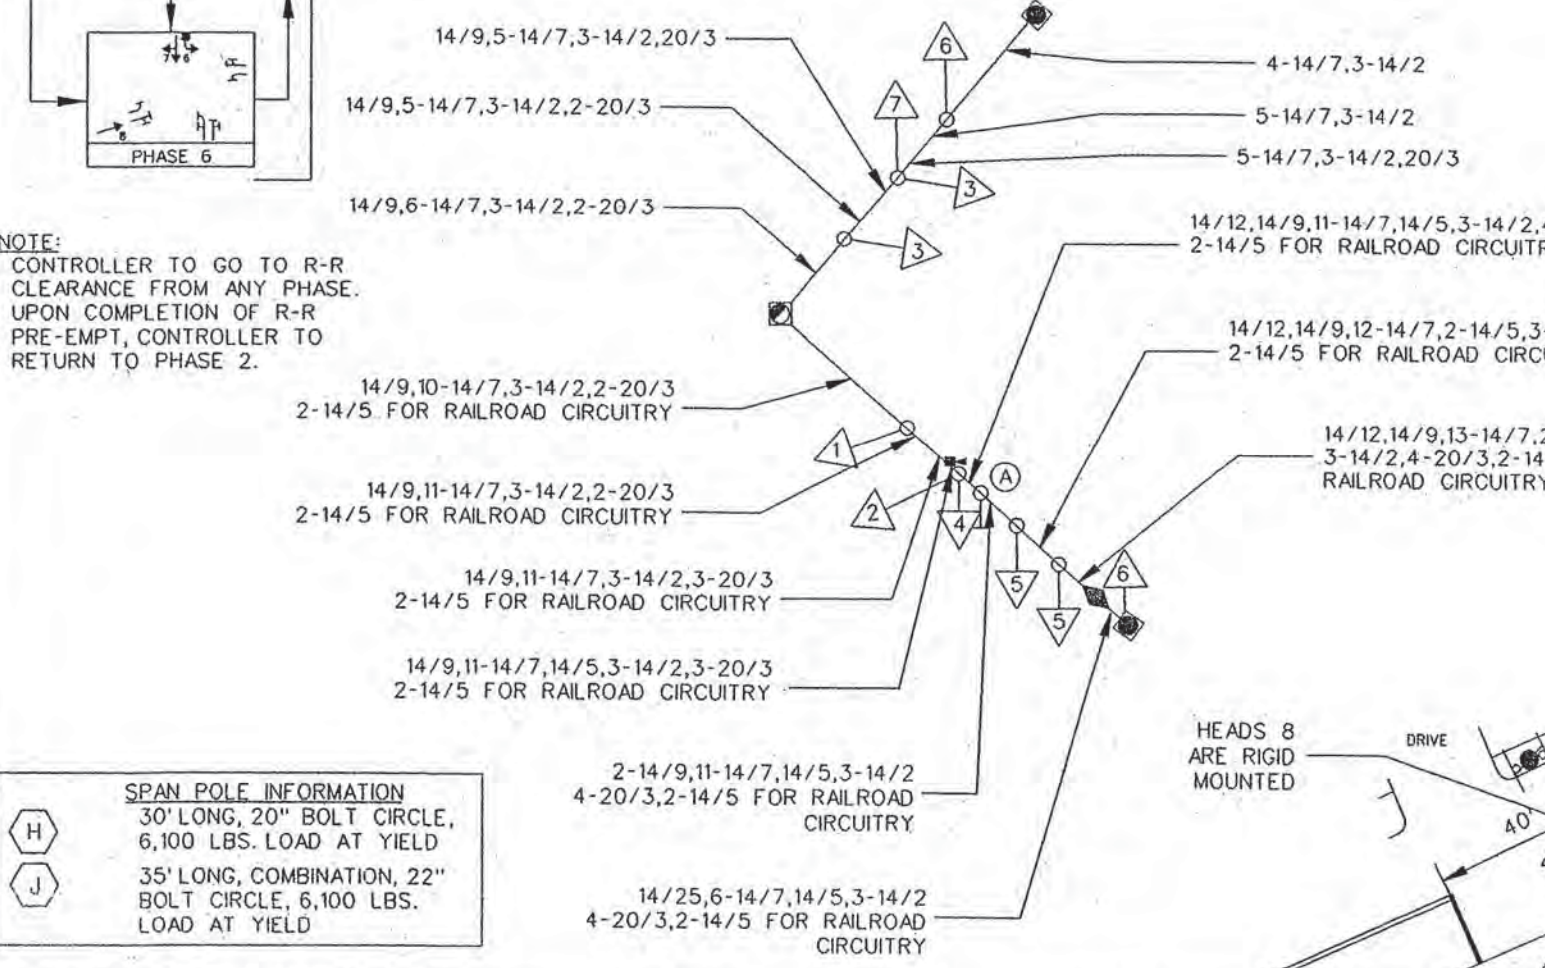

SPAN POLE INFORMATION
30' LONG, 20" BOLT CIRCLE, 6,100 LBS. LOAD AT YIELD
35' LONG, COMBINATION, 22" BOLT CIRCLE, 6,100 LBS. LOAD AT YIELD

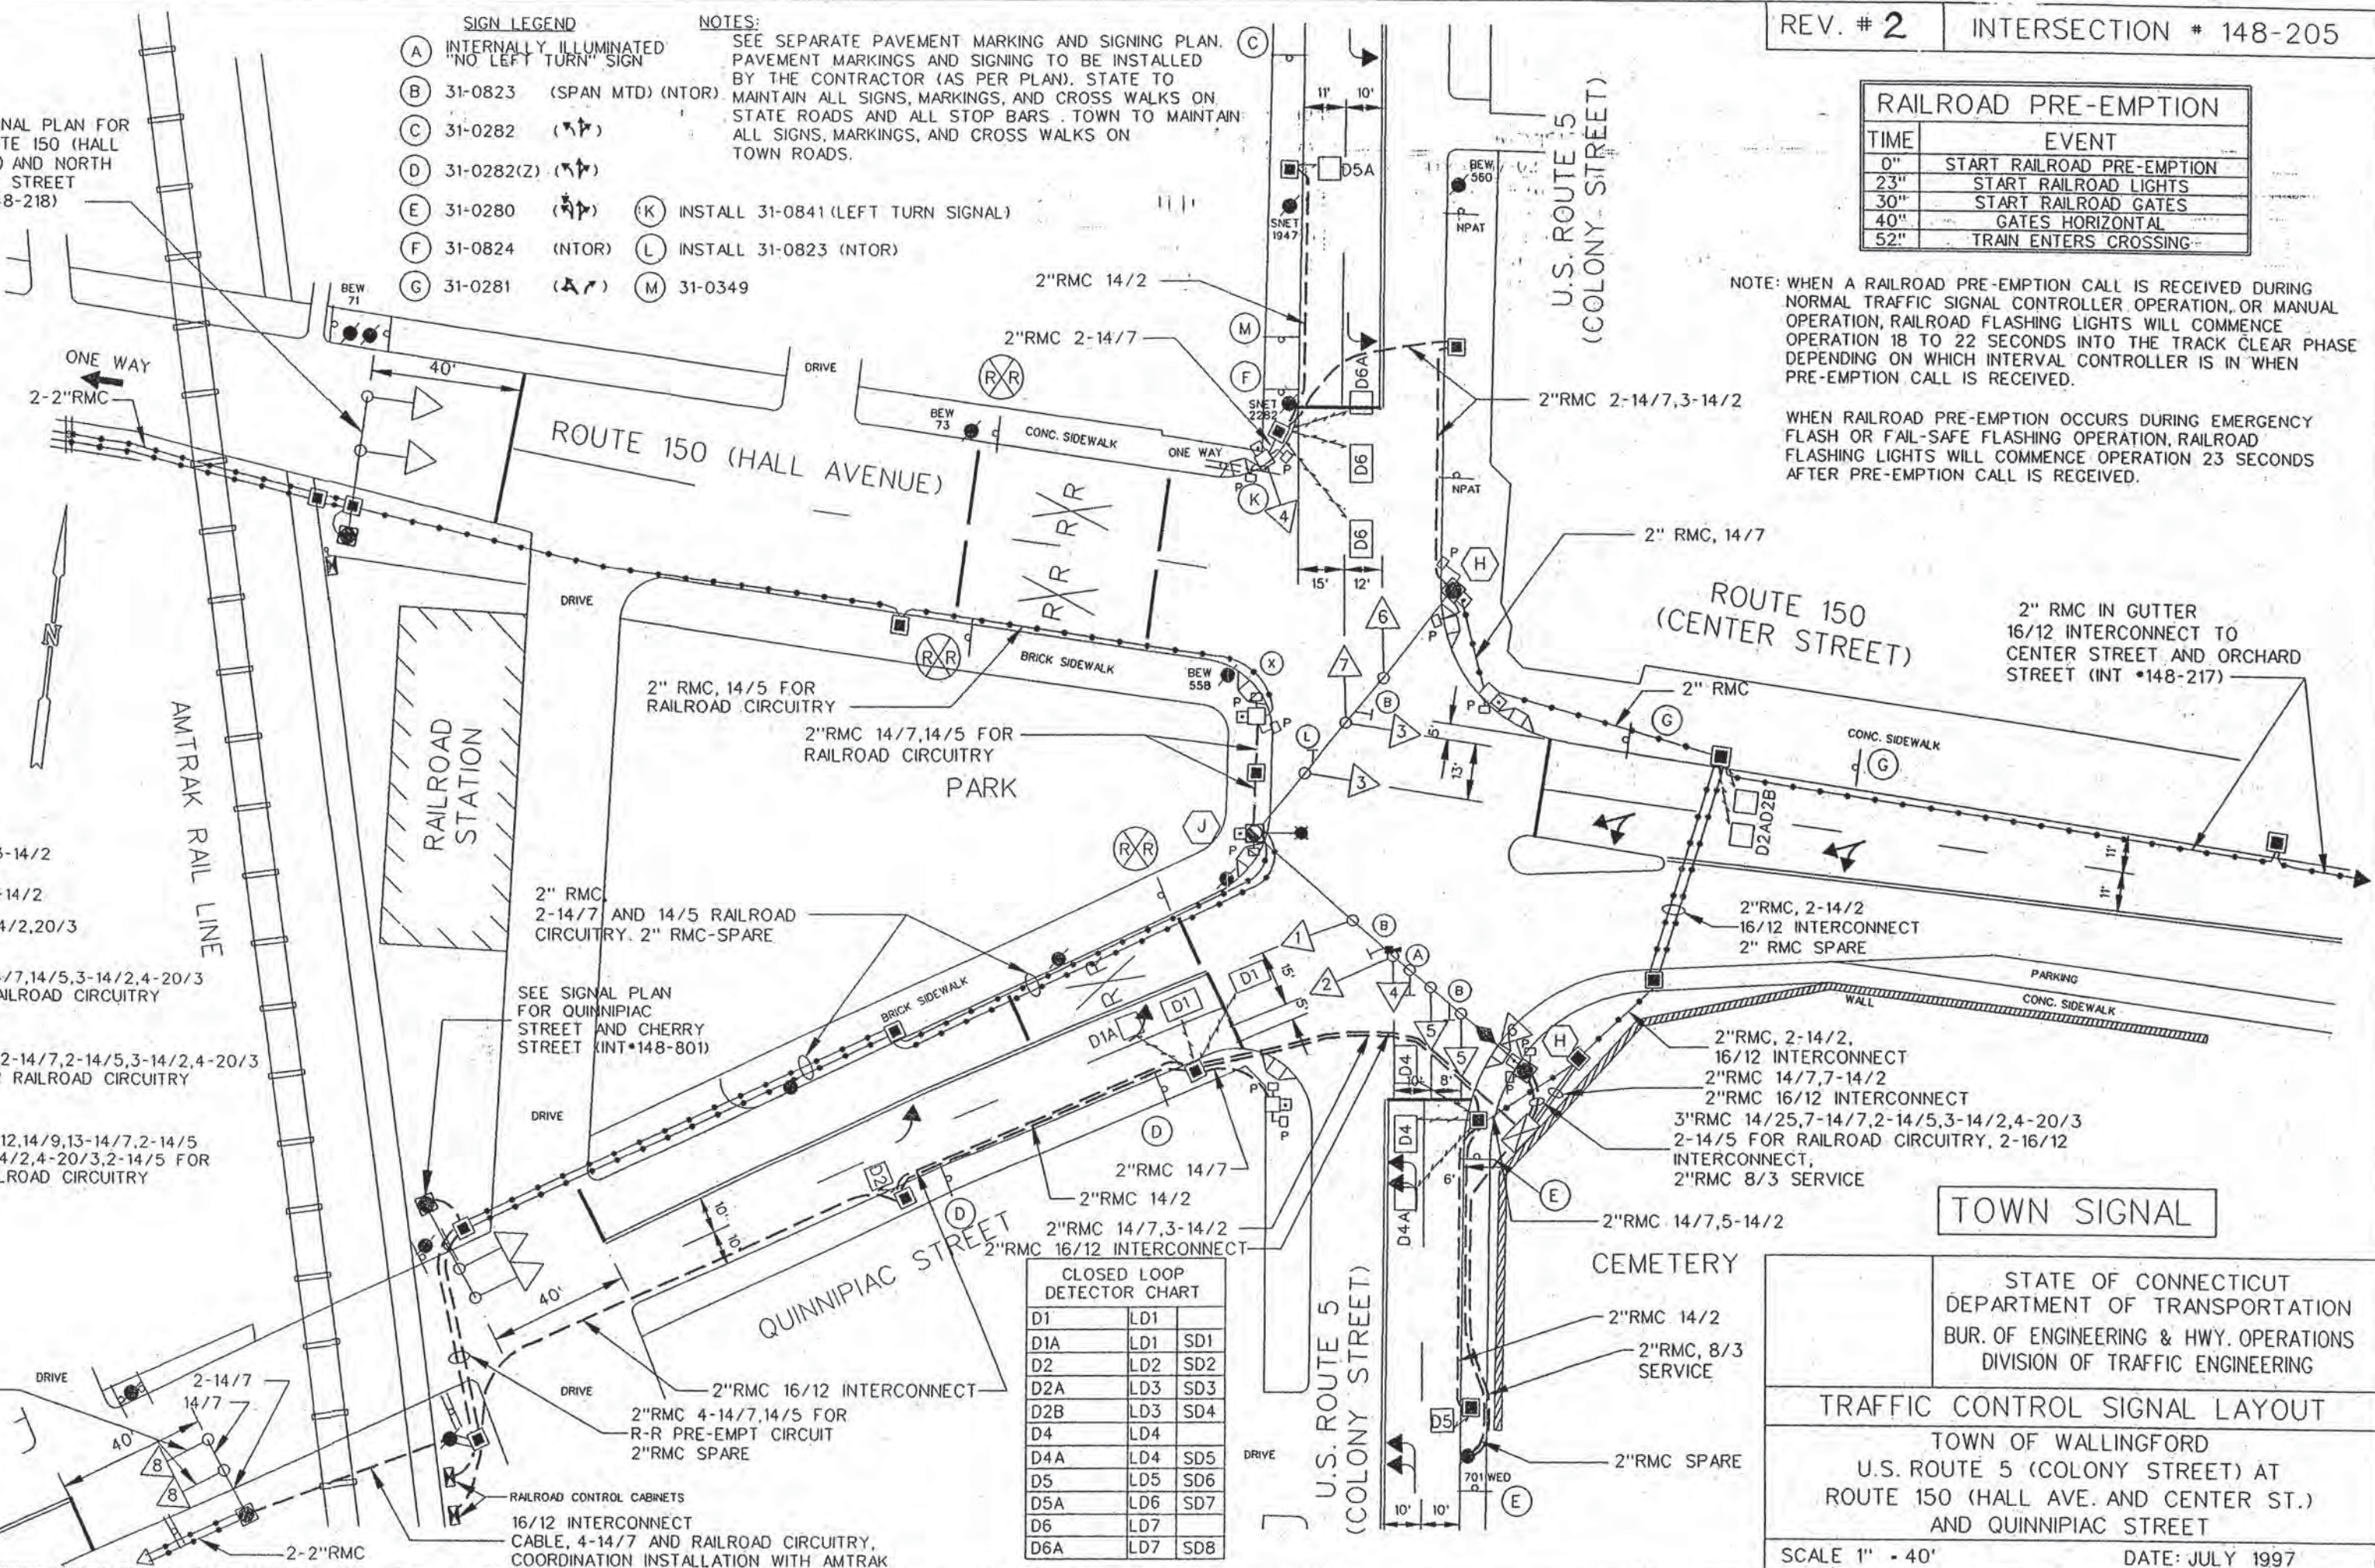

CLOSED LOOP DETECTOR CHART

D1	LD1	SD1
D2	LD2	SD2
D2A	LD3	SD3
D2B	LD3	SD4
D4	LD4	
D4A	LD4	SD5
D5	LD5	SD6
D5A	LD6	SD7
D6	LD7	
D6A	LD7	SD8

TOWN SIGNAL

STATE OF CONNECTICUT
DEPARTMENT OF TRANSPORTATION
BUR. OF ENGINEERING & HWY. OPERATIONS
DIVISION OF TRAFFIC ENGINEERING

TRAFFIC CONTROL SIGNAL LAYOUT

TOWN OF WALLINGFORD
U.S. ROUTE 5 (COLONY STREET) AT
ROUTE 150 (HALL AVE. AND CENTER ST.)
AND QUINNIPIAC STREET


SCALE 1" = 40' DATE: JULY 1997

MOVEMENT DIAGRAM														ENERGY BY- MAINT 24hr <input checked="" type="checkbox"/> Norm <input type="checkbox"/>		METER # - SERVICE POLE-		INTERSECTION # 148-239								
NTOR	PHASE 1			PHASE 2			PHASE 3			PHASE 4			PHASE 5			PHASE 6			PHASE 7			PHASE 8				
	FLASH	GRN	CL	CL	GRN	CL	CL	GRN	CL	CL	GRN	CL	CL	GRN	CL	CL	GRN	CL	CL	GRN	CL	CL	GRN	CL	CL	
1					G	Y	R	R	R	R	R	R	R													
2					G	Y	R	R	R	R	R	R	R													
3					R	R	R	R	R	R	R	R	R	G	Y	R										
P					O	DW	DW	DW	DW	DW	DW	DW	DW													
#	Min				20	3	1	7/7						10	3	1										
	Max				90	5	3	14/10						30	5	3										
INTERVALS	MIN GRN																									
	WALK				15									5												
	PED CLR				14																					
	VEH EXT				1									2												
	MAX 1				25									14												
	MAX 2				25									14												
	YELLOW					3									3											
	RED						1		0.1	0						1										
	ADD INIT																									
	MIN GAP																									
MODE					Min Recall			Non Lock					Non Lock													
INI START					This Phase																					

DETECTORS		PROGRAM		COORDINATION TYPE		PERMIS		SYSTEM		TECHNICAL NOTES		
IDENT	SIZE (WXL)	TURNS	MODE	FUNCTION	TIME	DAYS	CYCLE	PHASE SPLITS	SEC/ %	OFFSET	PERIOD	LOC
04	6x6	3	Presence	Flash	2200-0600	Daily		01 02 03 04 05 06 07 08			0 SEC	148-
04A	6x6	3	Presence	Flash	All Other Times	Daily					0 SEC	148-
				Max 1							0 SEC	148-
				Max 2		Future					0 SEC	148-239

LEGEND	PROPOSED	EXISTING
R	RED	PROPOSED CONTROLLER
Y	YELLOW	EXISTING CONTROLLER
G	GREEN	PROPOSED HANDHOLE
+	RED ARROW	EXISTING HANDHOLE
+	YELLOW ARROW	PROPOSED METAL CONDUIT
+	GREEN ARROW	EXISTING METAL CONDUIT
W	WALK/FL D.W.	PROPOSED CABLE CLOSURE
D.W.	DONT WALK	EXISTING CABLE CLOSURE
FL	FLASHING	DET. LEADS IN SAW CUT
O	PROPOSED WOOD SPAN POLE	AUXILIARY TERMINATION CABINET
W	EXISTING WOOD SPAN POLE	AUXILIARY EQUIPMENT CABINET
S	PROPOSED STEEL SPAN POLE	TRAFFIC SIGNAL CABINET
W	EXISTING STEEL SPAN POLE	TRAFFIC SIGNAL CABINET
U	PROPOSED UTILITY POLE	ALBIS PEDESTRIAN SIGNAL
U	EXISTING UTILITY POLE	
P	PEDESTAL MOUNTING	
P	PEDESTAL PUSH	
B	BUTTON & SIGN	
F	TRAFFIC SIGNAL FACE	
F	PEDESTRIAN SIGNAL FACE	
L	LOOP DETECTOR	
M	MAGNETIC DETECTOR	
SD	SYSTEM DETECTOR	
+	OPTICAL DETECTOR	

- ### CONSTRUCTION NOTES
- All traffic signal equipment is new except as noted.
 - Remove all abandoned traffic signal equipment including but not limited to conduit, cable, and span wire.
 - Unless otherwise directed, all traffic signal equipment being removed is to be returned to the Town of Wallingford.
 - Existing pedestal foundation to be reused.
 - Install four phase controller cabinet on new type II foundation.
 - Controller to include model 3021 Eight Phase Timer, and Model 12ELRA Conflict Monitor manufactured by Peek Traffic, Tallahassee, Florida. Cabinet to include all necessary equipment for closed loop operation.
 - Install loop detectors 2' off edge of drive and centerline of drive and 8' apart. Rear loop will serve as system and local detector and will be wired separately to its own amplifier.
 - Interconnect cable will be installed continuously to the controller at Rt. 150 and Elm Street. Prior to bidding, the contractor shall contact Officer Rick Doll, Wallingford Traffic, and the utility Co. for information and costs for overhead attachments.
 - A 60 Amp. Weatherproof Cutler Hammer Disconnect shall be installed 11' from ground level on Existing Wood Span Pole.
 - Audible Pedestrian signal shall be installed to most current Conn. DOT Spec.
 - All work shall be done in accordance with Conn. DOT Form 814A unless otherwise noted.
 - The contractor shall notify "Call Before You Dig" prior to any construction.

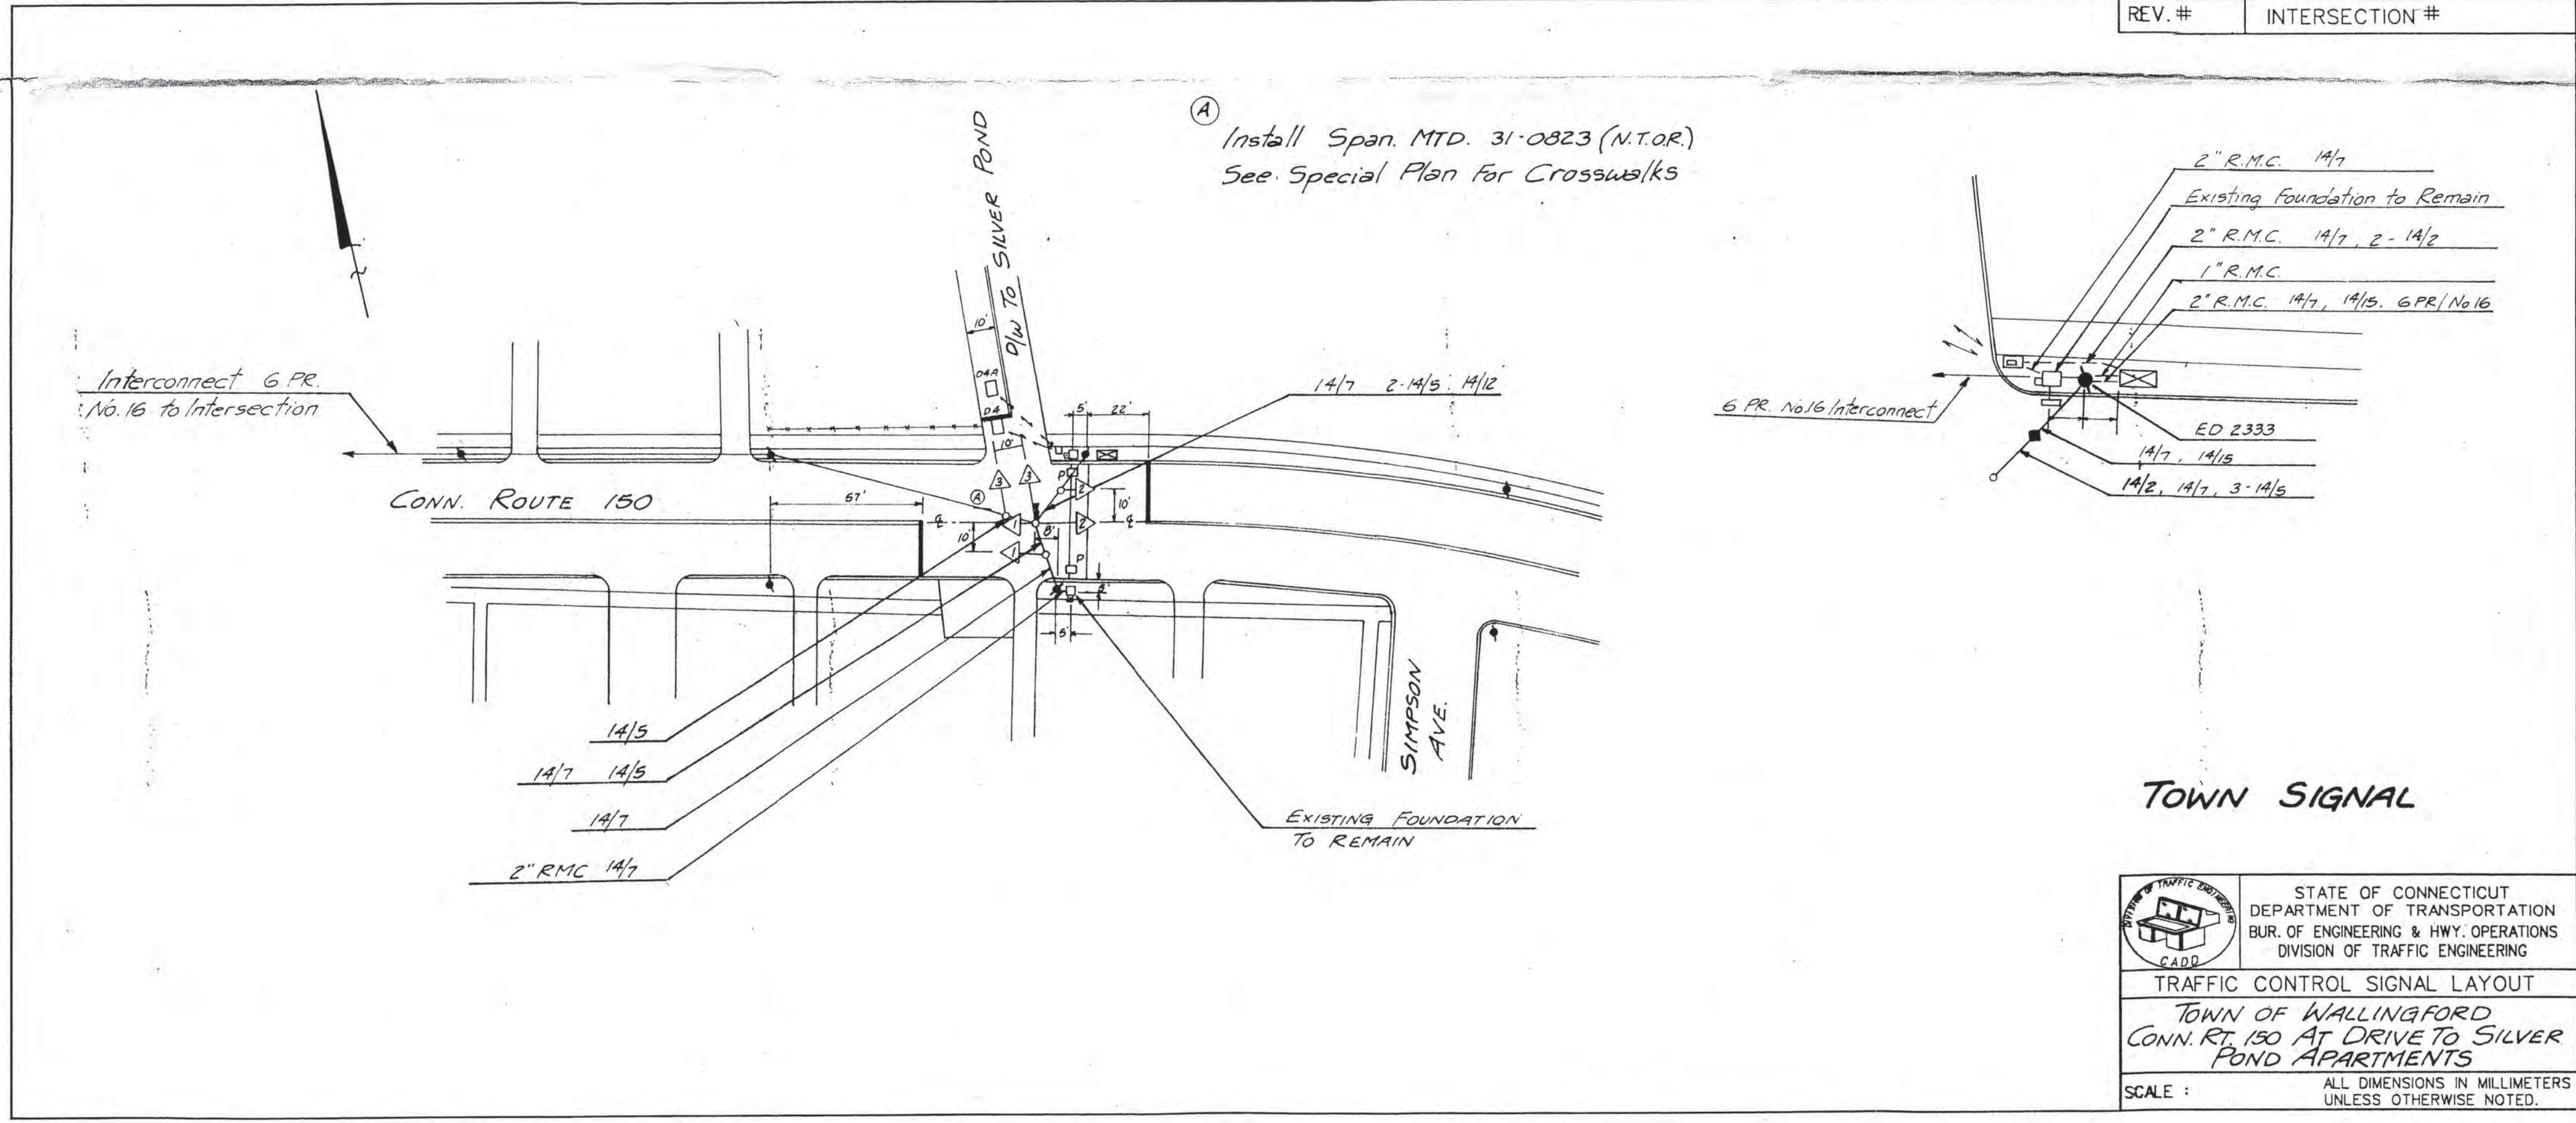

REV. #	INTERSECTION #						
STATE OF CONNECTICUT DEPARTMENT OF TRANSPORTATION BUREAU OF ENGINEERING & HIGHWAY OPERATIONS DIVISION OF TRAFFIC ENGINEERING							
R.D.							
TRAFFIC CONTROL SIGNAL							
F.H.W.A. REGION NO.	STATE	TOWN	FED. AID PROJ. NO.	PROJ. NO.	YEAR	ROUTE NO.	SHEET NO.
1	CONN.						

V-223

F.H.W.A. REGION NO.	STATE	TOWN	FED. AID PROJ. NO.	PROJ. NO.	YEAR	ROUTE NO.	SHEET NO.	TOTAL SHEETS
1	CONN.							


N TOR	MOVEMENT DIAGRAM								F O P L A S H R A T I O N
	PHASE 1	PHASE 2	PHASE 3	PHASE 4	PHASE 5	PHASE 6	PHASE 7	PHASE 8	
1	G/G	G/G	G/Y	R/R	R/R	R/R	R/R	R/R	
2	G/G	G/G	G/Y	R/R	R/R	R/R	R/R	R/R	
3	R/R	R/R	G/Y	R/R	R/R	R/R	R/R	R/R	
4	R/R	R/R	G/Y	R/R	R/R	R/R	R/R	R/R	
5	R/R	R/R	R/R	R/R	R/R	R/R	R/R	R/R	
6	R/R	R/R	R/R	R/R	R/R	R/R	R/R	R/R	
7	R/R	R/R	R/R	R/R	R/R	R/R	R/R	R/R	
8	R/R	R/R	R/R	R/R	R/R	R/R	R/R	R/R	
P									
MIN	4	3	1	20	5	1	4	3	1
MAX	15	5	5	70	5	5	15	5	5

INTERVALS	MIN GRN	WALK	RED CLR	VEH EXT	MAX 1	MAX 2	YELLOW	RED	ADD INI	MAX INI	TBR	TTR	MIN GAP
	3			2	8	10							
	40			40	8	50							
	3			3	3	10							
	8			4	8	30							
	7			12	20	20							
	3			2	20	10							
	8			4	25	30							
	3			2	20	30							

MODE	NON LOCK	MIN. RECALL	NON LOCK	LOCK	LOCK	OFF	NON LOCK	LOCK
MINI START								

DETECTORS		PROGRAM		COORDINATION		SYSTEM LOC		TECHNICAL NOTES	
IDEN	SIZE	FUNCTION	TIME	DAYS	CYCLE SAFETY CRT	OFFSET %/SEC	YIELD PT %	PERMIS PERIOD	FORCE OFF %
D-1	6 X 10	PRES	DIAL 1	ALL OTHER TIMES	80 SEC				
D-3	6 X 10	PRES	DIAL 2	NOT USED					
D-4	6 X 8	PRES	DIAL 3	15.15 TO 17.30 MON-SAT	100 SEC				
D-7	6 X 10	PRES							
D-8	6 X 8	PRES							
SD-1	6 X 7	PRES							

ENERGY BY - TOWN	NORMAL 1.13 kW 730 hr/mo = 825 kWh/mo
SERVICE POLE # ED 2119	FLASH KW hr/mo = kWh/mo
OFFICE RECORD	
REVISION # 2	
JOB # 148-8508-01 SM #	
ELIM PROGRAMMED FLASH OPERATION	
REVISED TIMING	
REVISION # 3	
REVISED SEQUENCE & TIMING	
ADDED NORTH AND SOUTH BOUND EXCLUSIVE TURN PHASES	
ADDED DETECTORS AND ACTUATED PEDESTRIAN PHASE	

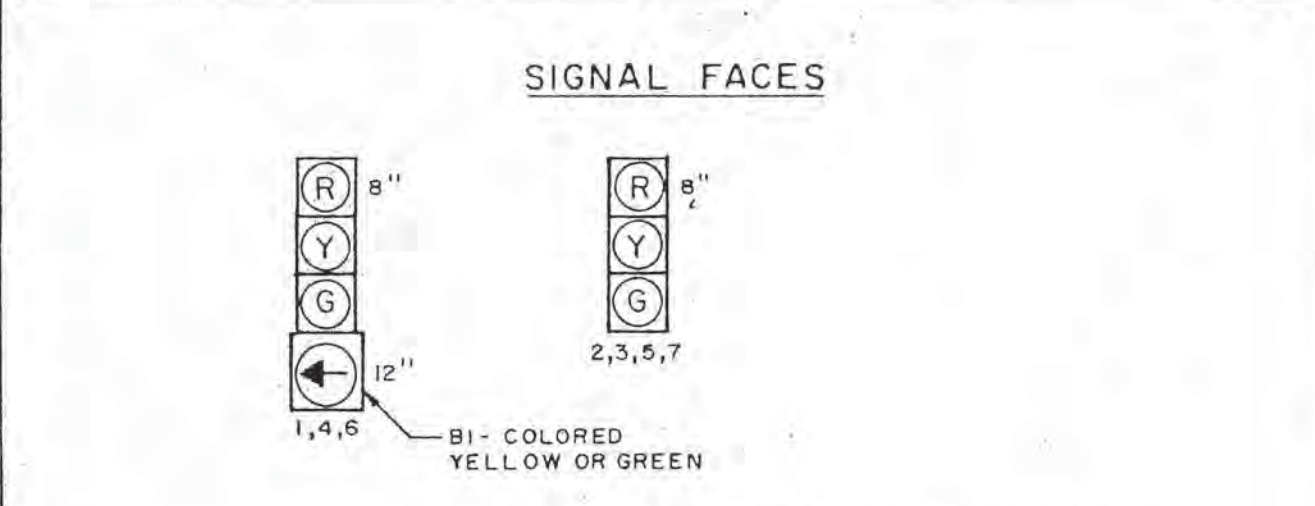

LEGEND	
RED	CONTROLLER
YELLOW	MANHOLE
GREEN	RIGID METAL (R.M.C.) CONDUIT
RED ARROW	STRAIN INSULATOR
YELLOW ARROW	MAGNETOMETER PROBES
GREEN ARROW	CABLE CLOSURE
WALK/PL/DW	GET LEADS IN SAW CUT
DW DONT WALK	AUXILIARY TERMINATION CABINET
PL FLASHING	RADIO ANTENNA
PROPOSED WOOD SPAN POLE	
EXISTING WOOD SPAN POLE	
PROPOSED STEEL SPAN POLE	
EXISTING STEEL SPAN POLE	
PROPOSED UTILITY POLE	
EXISTING UTILITY POLE	
PEDESTAL MOUNTING	
PEDESTRIAN PUSH BUTTON & SIGN	
TRAFFIC SIGNAL FACE	
PEDESTRIAN SIGNAL FACE	
LOOP DETECTOR	
MAGNETIC DETECTOR	
SD SYSTEM DETECTOR	


TOWN SIGNAL

STATE OF CONNECTICUT
DEPARTMENT OF TRANSPORTATION
BUREAU OF HIGHWAYS DIVISION OF TRAFFIC
TRAFFIC CONTROL SIGNAL

TOWN OF WALLINGFORD
RTE. 150 (CENTER ST.) AT
NORTH ELM ST. & SOUTH ELM ST.

REV.# 3	TRAFFIC	ELECTRICAL
FIELD SURVEY	DATE	DATE
ENGINEER	MARLIN CONTROLS INC	4/90
DRAFTER		
CHECKED BY		
SUBMITTED BY		
APPROVED BY		
DATE		

- ### CONSTRUCTION NOTES
- ALL EQUIPMENT IS NEW EXCEPT WHERE NOTED. PEDESTAL FOUNDATIONS ARE TO REMAIN.
 - ALL EXISTING SIGNAL EQUIPMENT, SURFACE CONDUIT, CABLE AND CONTROLLER INCLUDING PEDESTALS ARE TO BE REMOVED AND RETURNED TO THE TOWN OR DISPOSED OF AS DIRECTED.
 - UNLESS OTHERWISE DIRECTED BY THE TOWN, ALL CONSTRUCTION SHALL CONFORM TO THE STATE OF CONNECTICUT, STANDARD SPECIFICATIONS - FORM 814 AND ALL SUPPLEMENTALS THERE TO.
 - THE CONTROLLER DOOR SHALL OPEN TOWARD THE SIDEWALK.
 - LOOP DETECTORS SHALL BE INSTALLED 8' APART AND BE CENTERED IN THE LANE.
 - THE ELECTRIC COMPANY WILL INSTALL A NEW WOOD POLE AND GUYS ON THE SOUTHWEST CORNER FOR THE NEW SPAN ATTACHMENT.
ELECTRIC COMPANY CONTACT - CARLOS DURAN 265-1201
 - THE EXISTING INTERCONNECT CABLE SHALL BE REMOVED AND REPLACED BETWEEN THIS LOCATION AND RTE. 150 AT NORTH MAIN STREET WITH 6 PAIR, NO. 16 A.W.G. SHIELDED CABLE. THE CABLE SHALL BE FROM CONTROLLER TO CONTROLLER WITHOUT SPLICES. THE REMOVAL SHALL INCLUDE A SECTION OF CABLE WHICH RUNS FROM THE TELEPHONE MANHOLE AT 1350 CENTER STREET INTO THE BUILDING (OLD POLICE DEPT.) TO A JUNCTION BOX.
TELEPHONE CONTACT - JOE ST. ONGE 287-0595
 - PAVEMENT MARKINGS AND SIGNS - SEE SEPARATE PLAN. THE MARKINGS ARE EXISTING. THE CONTRACTOR SHALL INSTALL PAVEMENT MARKINGS TO A POINT 150' AWAY FROM THE INTERSECTION ON ALL APPROACHES.

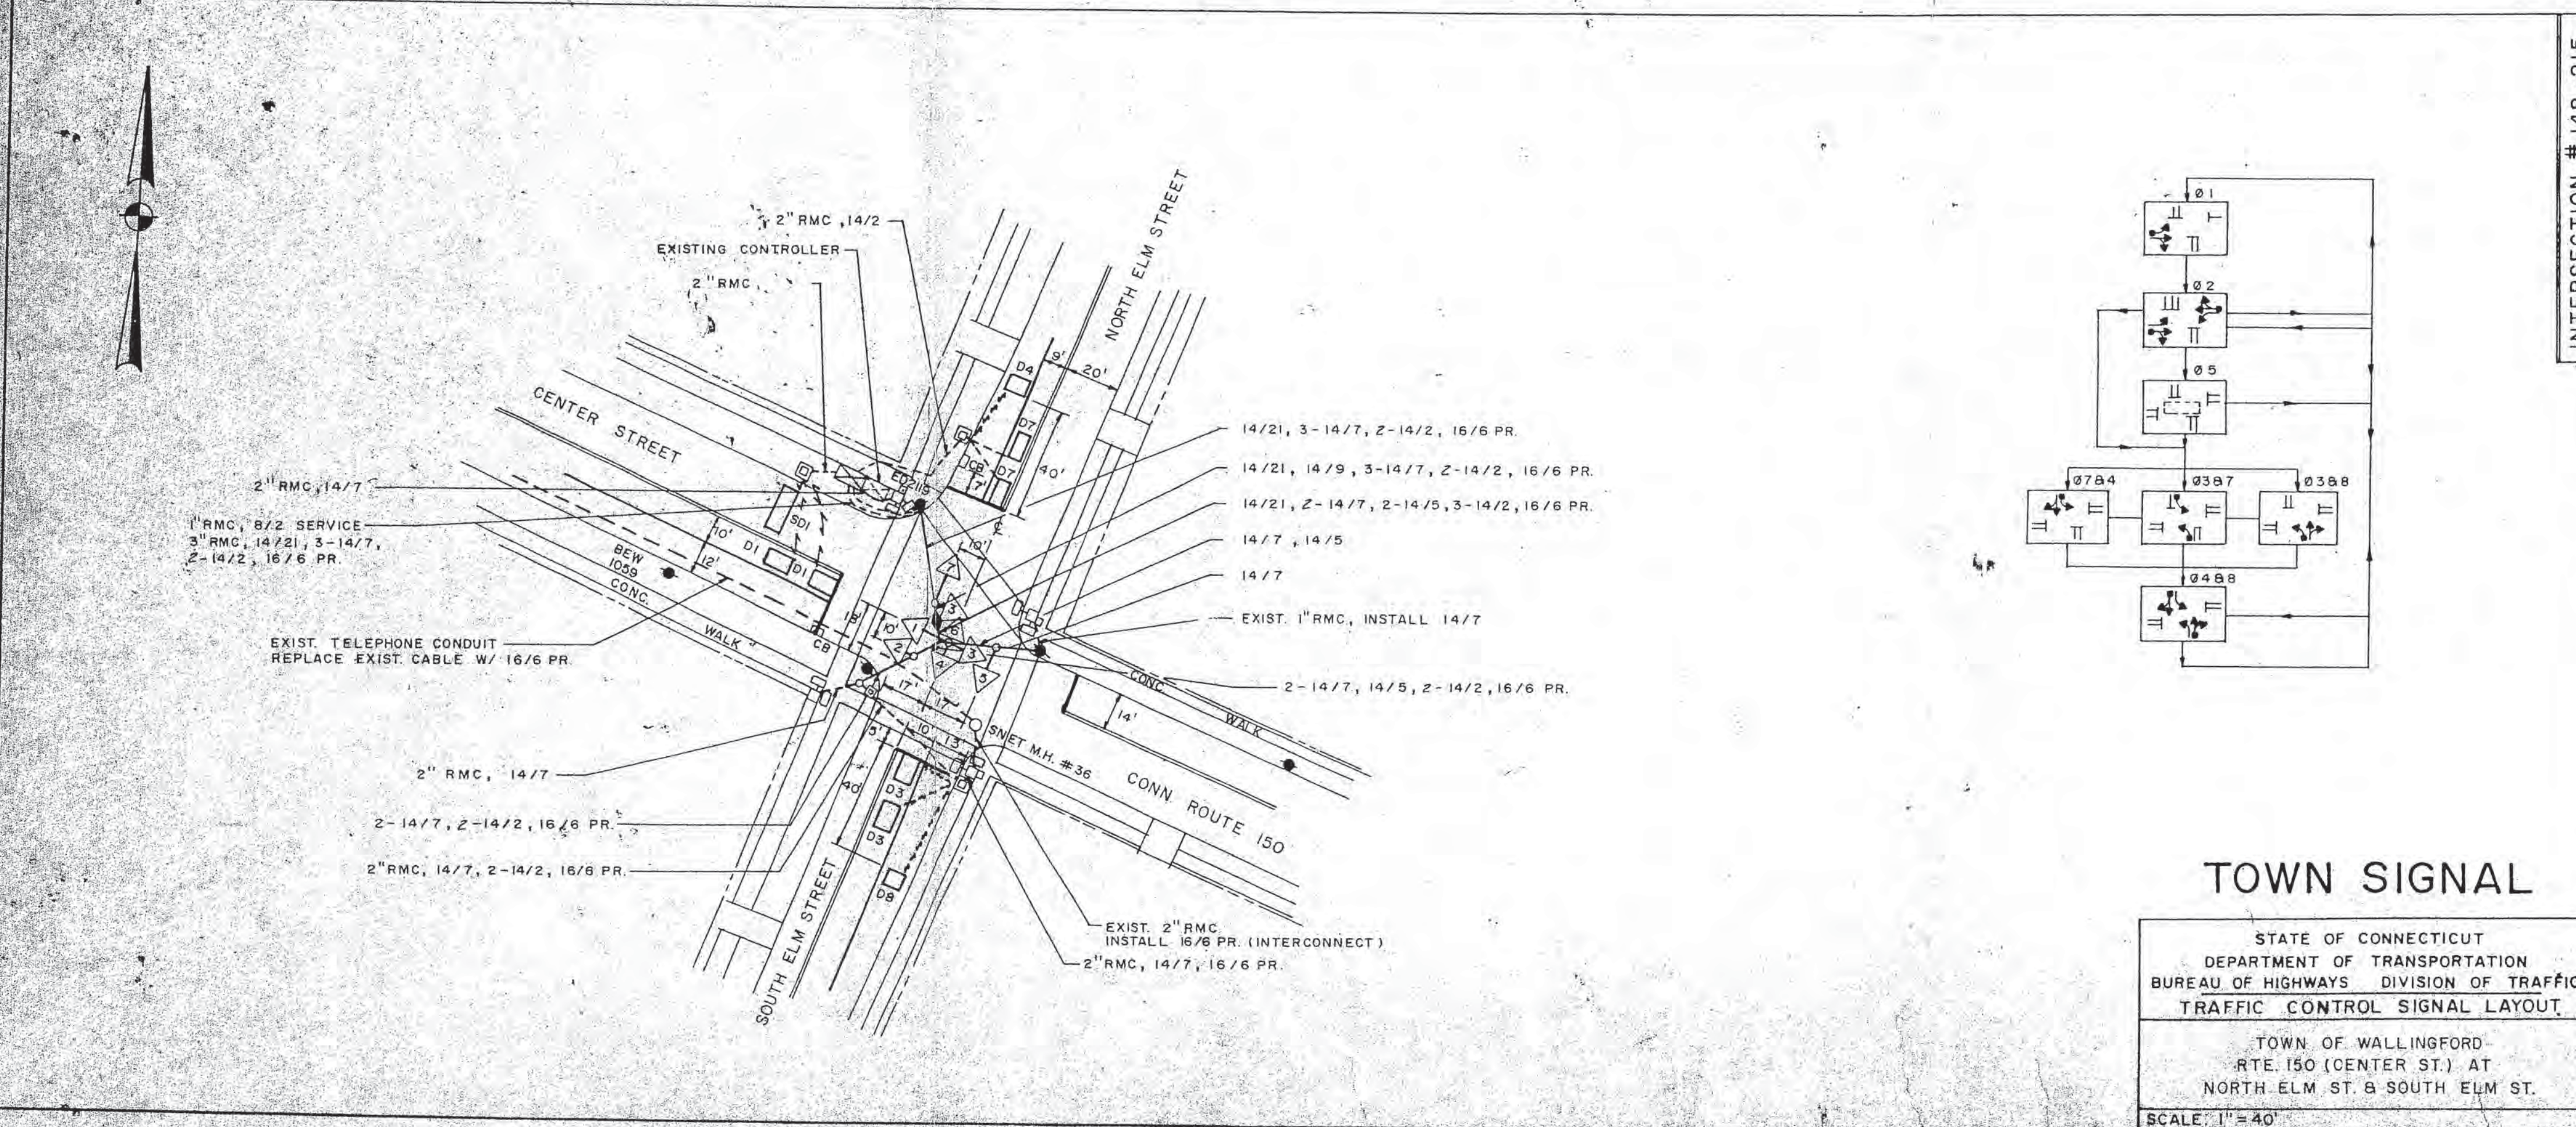

TOWN SIGNAL


STATE OF CONNECTICUT
DEPARTMENT OF TRANSPORTATION
BUREAU OF HIGHWAYS DIVISION OF TRAFFIC
TRAFFIC CONTROL SIGNAL LAYOUT

TOWN OF WALLINGFORD
RTE. 150 (CENTER ST.) AT
NORTH ELM ST. & SOUTH ELM ST.

SCALE: 1" = 40'

CONNECTICUT
DEPARTMENT OF TRANSPORTATION
BUREAU OF HIGHWAYS
DIVISION OF TRAFFIC


TRAFFIC CONTROL SIGNAL

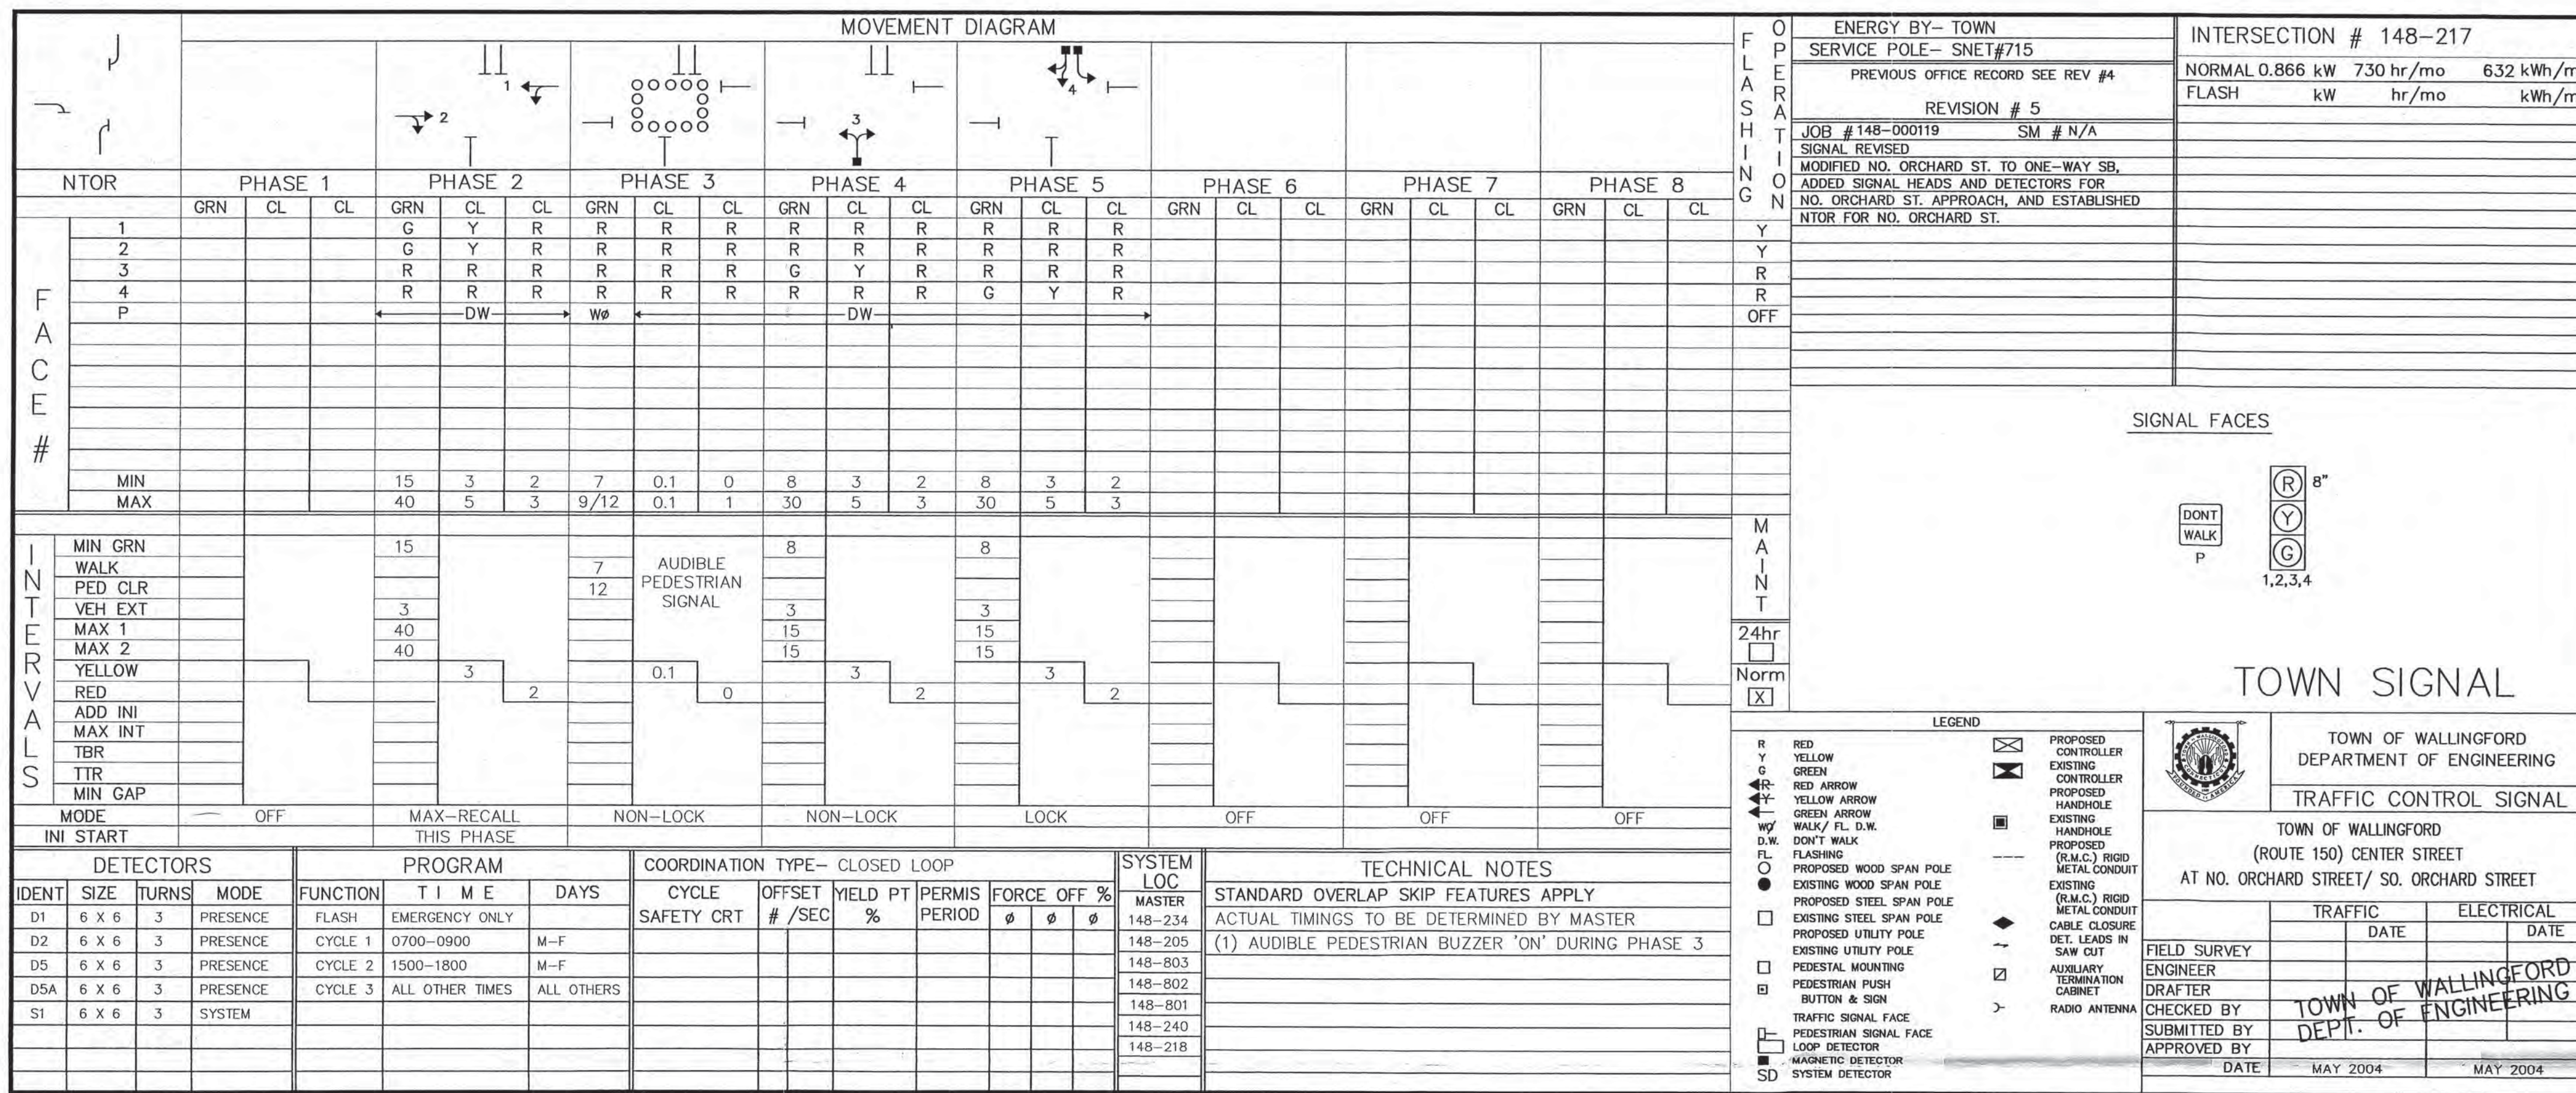

F.H.W.A. REGION NO.	STATE	TOWN	FED. AID PROJ. NO.	PROJ. NO.	YEAR	ROUTE NO.	SHEET NO.	TOTAL SHEETS
1	CONN.	WALLINGFORD			2004	150		

CONSTRUCTION NOTES (REV #5)

- ALL TRAFFIC SIGNAL EQUIPMENT IS EXISTING, EXCEPT AS NOTED.
- EXISTING CONDITIONS ARE BASED ON COMPILATION OF BEST AVAILABLE MAPPING AND SHOULD BE VERIFIED IN THE FIELD.
- INSTALL LOOP DETECTORS 3' OFF EDGE OF ROAD AND 8' APART UNLESS OTHERWISE SPECIFIED.
- SEGMENTED LOOPS TO BE INSTALLED IN SERIES.
- DETECTORS "D5" AND "D5A" ARE NEW.
- SIGNAL HEAD #4 IS NEW, ALL OTHERS ARE EXISTING.
- NOTIFY THE UTILITY CONTACTS LISTED BELOW AT LEAST 72 HOURS PRIOR TO CONDUCTING WORK.
- NOTIFY "CALL BEFORE YOU DIG" AT 1-800-922-4455 72 HOURS PRIOR.
- ALL PAVEMENT MARKINGS ARE EXISTING EXCEPT ON NORTH ORCHARD STREET WHICH ARE TO BE NEW. CONTRACTOR SHALL REMOVE PAVEMENT MARKINGS IN CONFLICT WITH PROPOSED.
- REPLACE 8' PEDESTAL WITH NEW 10' PEDESTAL ON EXISTING FOUNDATION, AND INSTALL NEW 8" 3-SECTION SIGNAL FACE. RELOCATE EXISTING PEDESTRIAN SIGNAL FACES, PUSHBUTTON AND SIGN TO NEW PEDESTAL.
- CONVERT EXISTING 1-WAY TRAFFIC SIGNAL HEAD TO 2-WAY. INSTALL NEW 14/9 CONDUCTOR BACK TO CABLE CLOSURE. USE EXISTING 14/21 CONDUCTOR BACK TO CABINET.
- EXTEND NEW LOOP LEADS INTO EXISTING HAND HOLE AND SPLICE TO NEW 14/2 CONDUCTOR.
- MODIFY EXISTING SOLID STATE 8-PHASE CONTROLLER (TRANSYT MODEL 3000) FOR NEW PHASE (PHASE 5) AND INSTALL NEW LOOP VEHICLE DETECTOR.

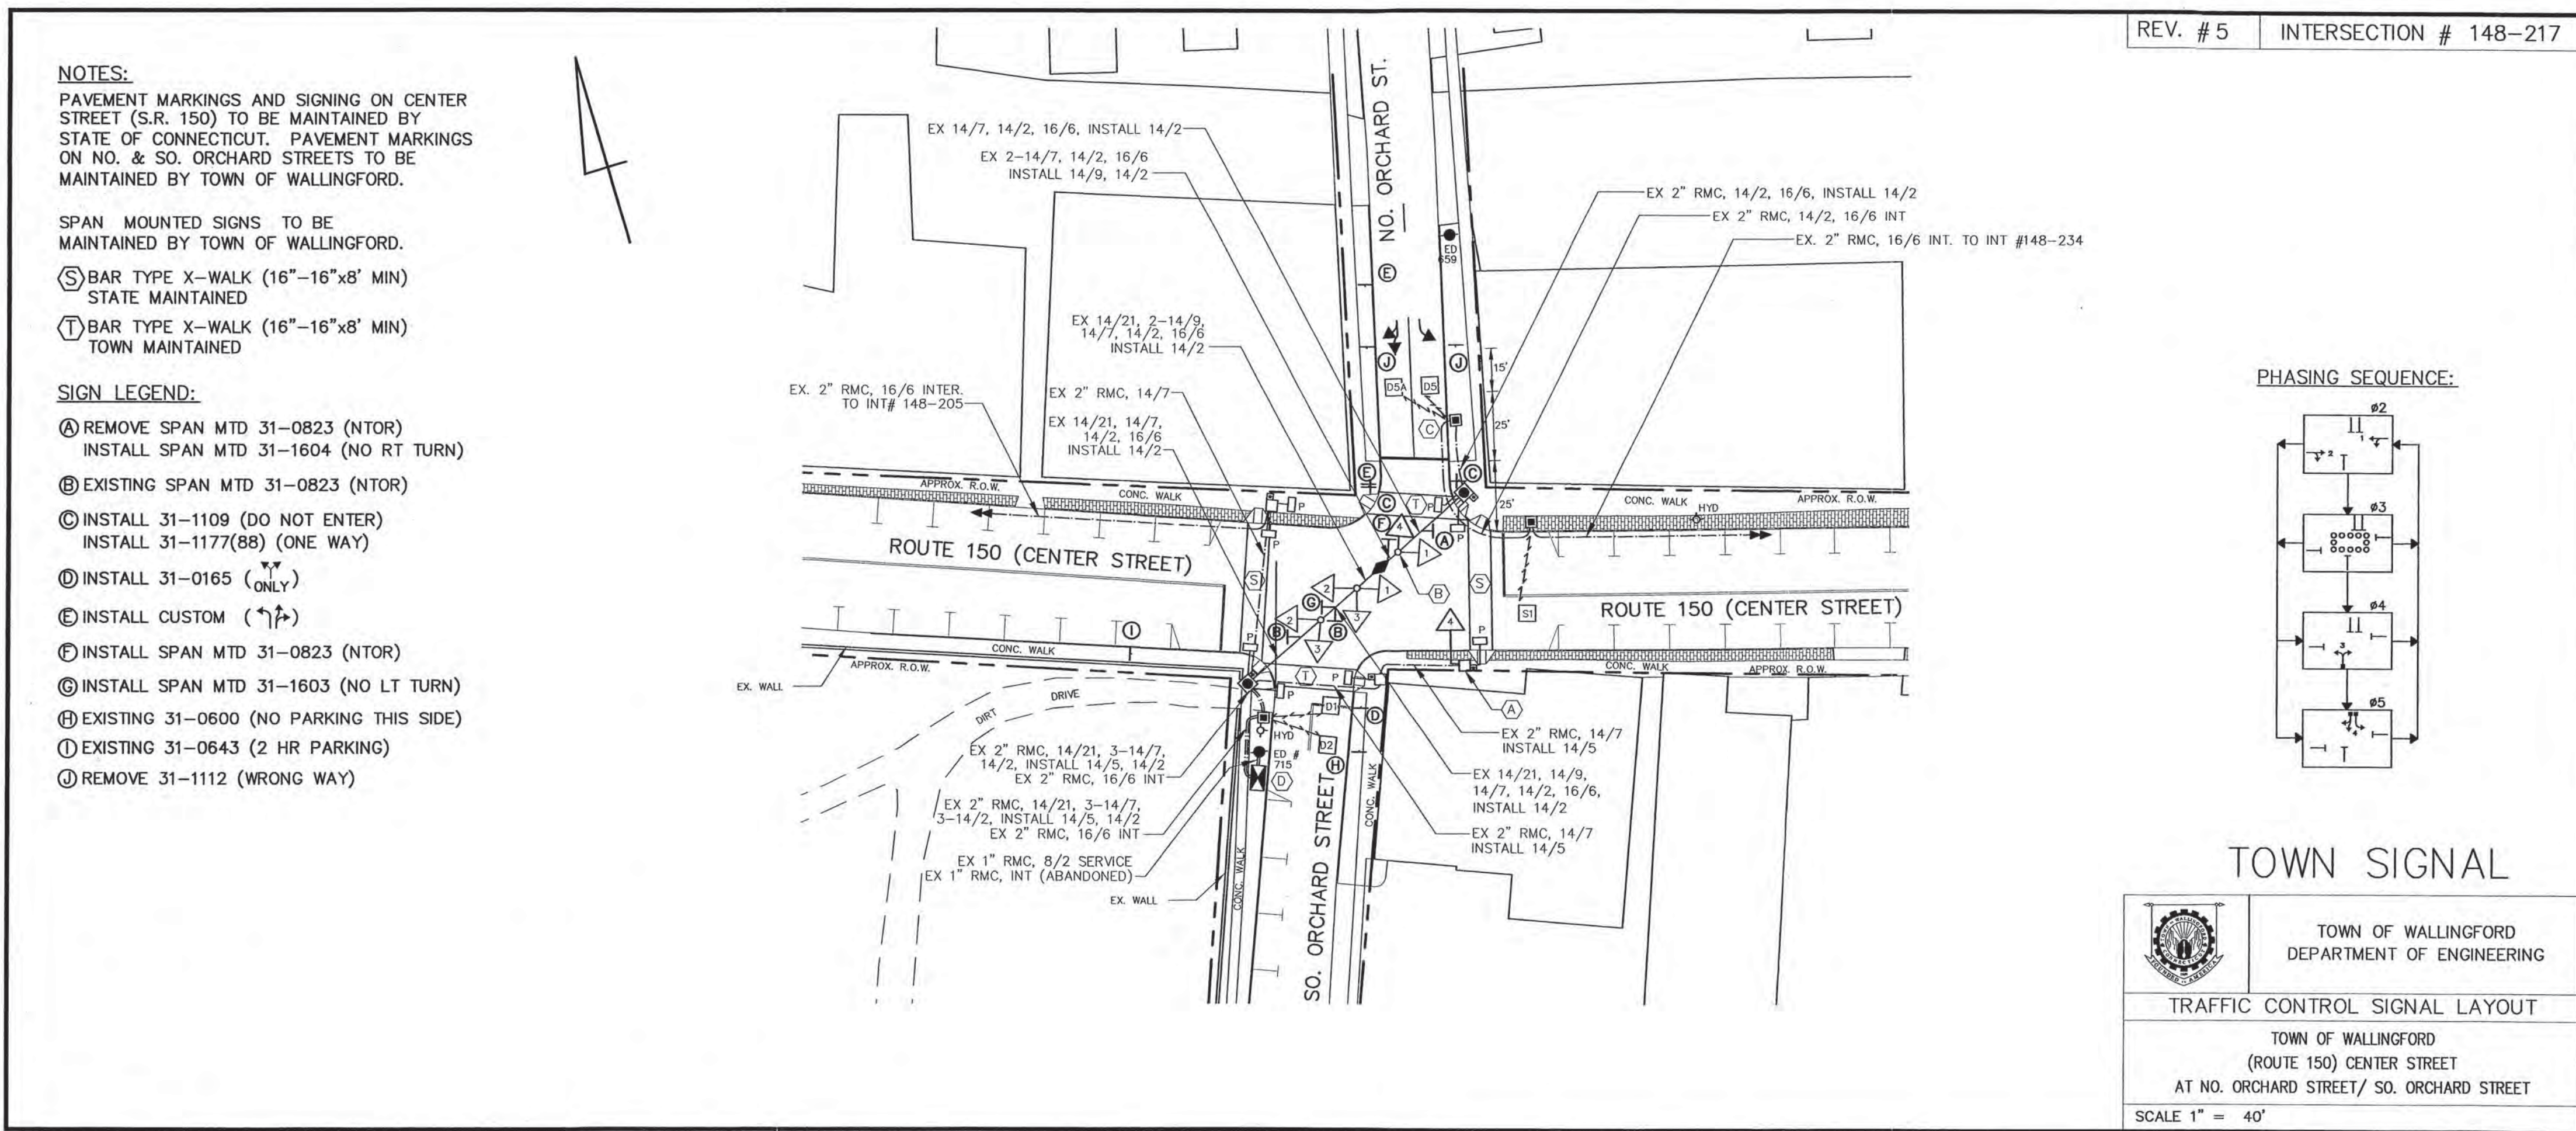

REV. #5 INTERSECTION # 148-217

Table with columns: REGION, TOWN, TOWN NO., FLD. AID PROJ. NO., REV. NO., YEAR, ROUTE NO., SHEET NO., TOTAL SHEETS

RAILROAD PRE-EMPTION NOTES

- 1. RAILROAD PRE-EMPTION SHALL TAKE PRECEDENCE OVER ALL OTHER OPERATIONS.
2. RAILROAD PRE-EMPTION (NORMAL OPERATION)
3. TRAIN ENTERS TRACK CIRCUIT - R.R. PROVIDES IMMEDIATE PRE-EMPTION CIRCUIT TO THE TRAFFIC SIGNAL CONTROLLER CABINET.
4. THE TRAFFIC SIGNAL CONTROLLER IMMEDIATELY ADVANCES THE SEQUENCE TO THE TRACK CLEARANCE PHASE VIA THE PROPER YELLOW AND RED CLEARANCE INTERVALS. IF PEDESTRIAN PHASE IS IN OPERATION PHASE WILL BE IMMEDIATELY TERMINATED.
5. THE TRACK CLEARANCE INTERVAL WILL TERMINATE AND THE TRAFFIC CONTROLLER WILL HOLD AND SEQUENCE BETWEEN PRE-EMPT HOLD #1 AND PRE-EMPT HOLD #2.
6. THE RAILROAD FLASHING LIGHTS WILL COMMENCE OPERATION 15 TO 19 SECONDS INTO THE TRACK CLEAR PHASE DEPENDING UPON WHAT INTERVAL TRAFFIC CONTROLLER IS IN WHEN THE PRE-EMPTION CALL IS RECEIVED. STANDARD R.R. TIMING FOR BELLS, LIGHTS, AND GATES WILL COMMENCE A MINIMUM OF 20 SECONDS PRIOR TO THE TRAIN ENTERING THE CROSSING.
7. WHEN THE TRAIN HAS LEFT THE CROSSING AND THE TRACK CIRCUIT, THE RAILROAD DEVICES WILL DEACTIVATE AND THE TRAFFIC CONTROLLER SIGNAL SHALL RETURN TO NORMAL OPERATION, PHASE 2.

- RAILROAD PRE-EMPTION (FAIL-SAFE FLASHING OPERATION)
1. TRAIN ENTERS TRACK CIRCUIT - R.R. PROVIDES IMMEDIATE PRE-EMPTION CIRCUIT TO THE TRAFFIC SIGNAL CONTROLLER CABINET.
2. THE FLASHING OPERATION IMMEDIATELY CHANGES TO SOLID RED ON FACE 7, AND REMAINS FLASHING RED ON ALL OTHER INDICATIONS.
3. THE RAILROAD FLASHING LIGHTS WILL COMMENCE 20 SECONDS AFTER THE RECEIPT OF THE PRE-EMPT CALL. STANDARD R.R. TIMING FOR BELLS, LIGHTS, AND GATES WILL COMMENCE A MINIMUM OF 20 SECONDS PRIOR TO THE TRAIN ENTERING THE CROSSING.
4. WHEN THE TRAIN HAS LEFT THE CROSSING AND THE TRACK CIRCUIT, THE TRAFFIC CONTROL SIGNAL SHALL REVERT TO FLASHING RED ON ALL SIGNAL FACES AND THE RAILROAD DEVICES SHALL DEACTIVATE.

TECHNICAL NOTES (CONTINUED)
CONTROLLER SHALL IMMEDIATELY ADVANCE OUT OF ANY GREEN, INCLUDING MIN GREEN, INTO CLEARANCE INTERVALS GOING TO PRE-EMPTION, AND THEN GO DIRECTLY TO RAILROAD TRACK CLEAR PHASE DURING RAILROAD PRE-EMPTION.
WHEN RAILROAD PRE-EMPTION OCCURS DURING THE CLEARANCE INTERVAL OF ANY PHASE, THE CONTROLLER TO DROP NEXT PHASE CALL. FINISH TIMING THE CLEARANCE INTERVALS GOING TO PRE-EMPTION, AND THEN GO DIRECTLY TO RAILROAD TRACK CLEAR PHASE.
PEDESTRIAN TIMING TO IMMEDIATELY ADVANCE OUT OF THE WALK AND PED CLEARANCE INTERVAL IN THE CLEARANCE INTERVAL TIMING GOING TO PRE-EMPTION, THEN GO IMMEDIATELY TO RAILROAD TRACK CLEAR PHASE.
POLICE BOX MANUAL SHALL BE ABLE TO BE PRE-EMPTED BY RAILROAD CIRCUIT. THE POLICE BOX MANUAL CONTROL SHALL REMAIN INEFFECTIVE FROM THE TIME A PRE-EMPT CALL IS RECEIVED UNTIL THE CONTROLLER LEAVES THE RAILROAD PHASE AND RETURNS TO PHASE 2 GREEN.
ANY CHANGE IN THE CLEARANCE INTERVALS DENOTED ON THIS PLAN MAY REQUIRE A MODIFICATION OF THE RAILROAD TRACK CIRCUIT.

Table with columns: REV. H, TRAFFIC, ELECTRICAL, DATE. Includes dates for July 1997.

GENERAL PRE-EMPTION NOTES
1. RAILROAD PRE-EMPT OPERATIONS SHALL BE MAINTAINED AT ALL TIMES DURING BOTH ACTIVE AND NON CONSTRUCTION TIME PERIODS.
2. IF FOR ANY REASON NORMAL RAILROAD PRE-EMPT OPERATIONS ARE INTERRUPTED, THE CONTRACTOR SHALL IMMEDIATELY NOTIFY THE WALLINGFORD POLICE DEPARTMENT, THE CONNECTICUT DEPARTMENT OF TRANSPORTATION AND AMTRAK.
3. ANY MODIFICATIONS TO THESE TIMINGS AND RAILROAD PRE-EMPTION OPERATIONS MUST BE APPROVED BY THE TOWN, STATE AND AMTRAK.
4. ANY WORK ON RAILROAD PROPERTY SHALL BE APPROVED BY AND AUTHORIZED BY AMTRAK.

EMERGENCY VEHICLE PRE-EMPTION NOTES
1. THE OPTICAL DETECTOR(S) SHALL BE MOUNTED MID-SPAN IN ACCORDANCE WITH THE MANUFACTURER'S RECOMMENDATIONS. A SEPARATE 2073 CABLE (FOR EACH OPTICAL DETECTOR) SHALL BE INSTALLED CONSPICUOUSLY DIRECTLY TO THE CONTROLLER CABINET.

UTILITY/PROJECT CONTACTS
SNET: BOB BUOFFARD (800) 748-1693
AT&T: RON TAJANI (203) 269-2965
WALLINGFORD ELECTRIC: ART DURAK (603) 265-0108
AMTRAK: JOE HOFBAUER (215) 399-1838
TFCI CABLE: ADAM RUPP (203) 463-8300
TOWN ENGINEER: JOHN P. THOMPSON (203) 271-1771


OWNERS NAME
TOWN OF WALLINGFORD

STATE OF CONNECTICUT
DEPARTMENT OF TRANSPORTATION
BUREAU OF ENGINEERING & HIGHWAY OPERATIONS
DIVISION OF TRAFFIC ENGINEERING



RAILROAD PRE-EMPTION
RT. 150 (Hall Ave) & No. Cherry St.
TRAFFIC CONTROL SIGNAL

Table with columns: REV. NO., DATE, INT., DESCRIPTION. Includes revision 1 on 5/98 for revised pedestrian indicators.


SCALE 1" = 40' DATE: JULY 1997

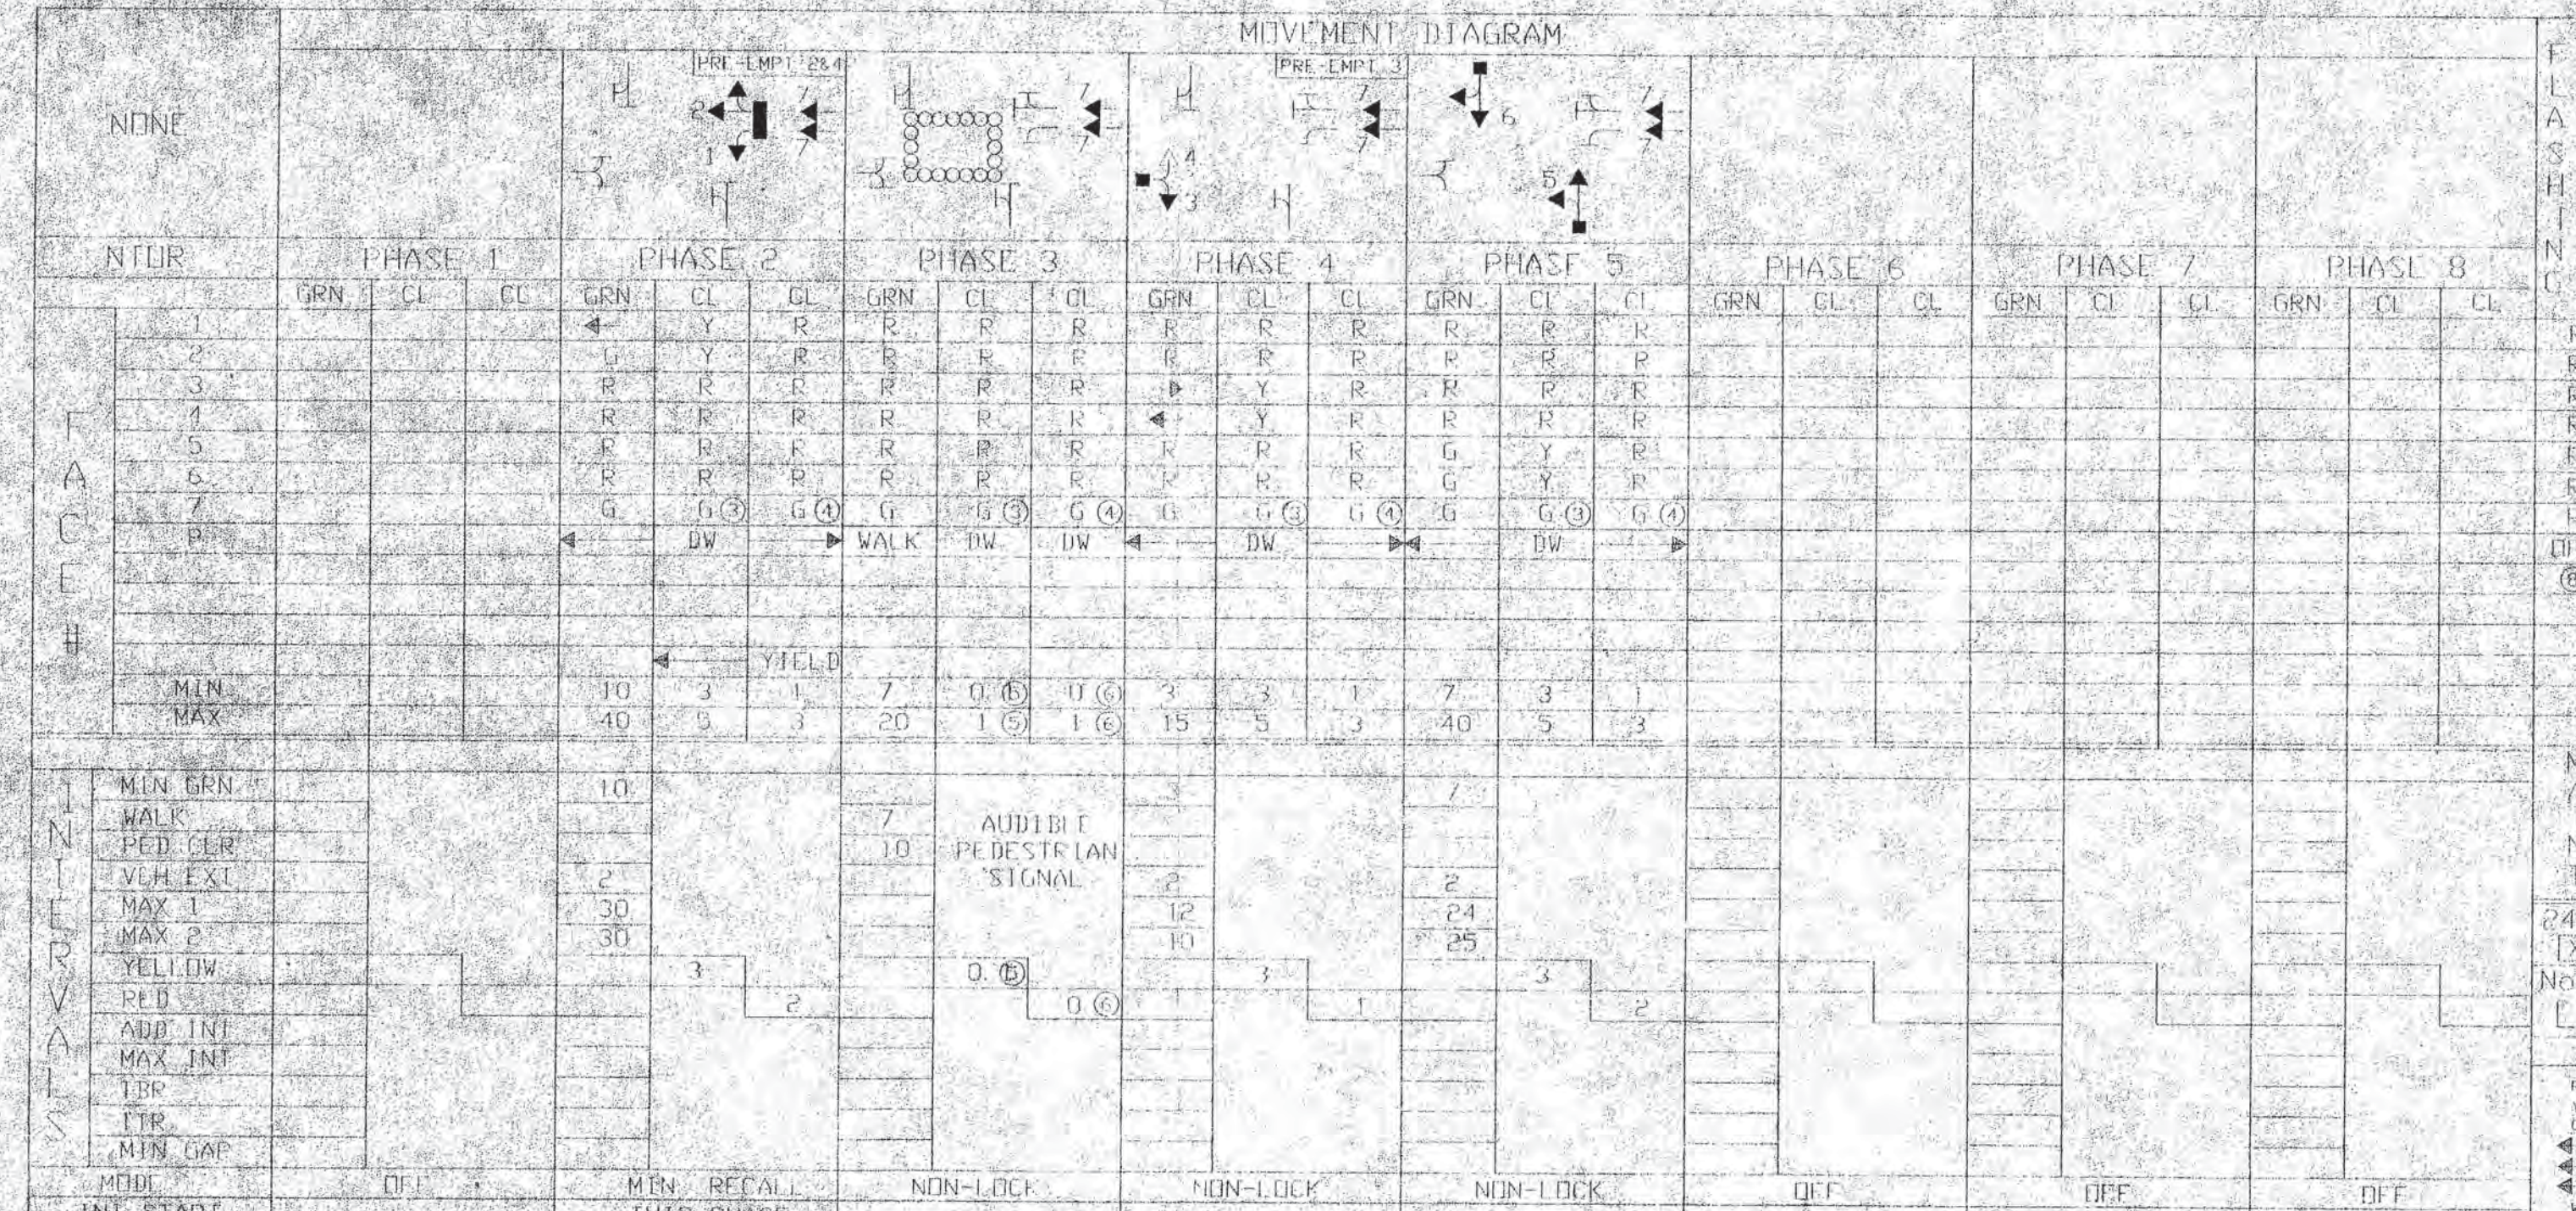

TECHNICAL NOTES
STANDARD OVERLAP SKIP FEATURES APPLY.
PHASE 3 ACTIVATION SHALL INITIATE ADRIBLE PEDESTRIAN SIGNAL.
PRE-EMPT 4 CALLED BY DEB WITH 4 SECOND DELAY ON LOOP.
EMERGENCY VEHICLE PRE-EMPT OPERATIVE DURING FLASH.
TIMINGS SHOWN INDICATE PRE-EMPTION ACTUAL TIMINGS TO BE CONTROLLED BY THE CLOSED LOOP COORDINATION UNIT.
TRAFFIC SIGNAL SHALL NOT BE PLACED IN PROGRAMMED FLASH.
TO BE 3 IF RAILROAD PRE-EMPTION IS NEXT.
TO BE R-11 RAILROAD PRE-EMPTION IS NEXT.
PHASE 2 DETECTORS TO BE INEFFECTIVE DURING COORDINATION.
TO BE 3 SECONDS TO R.R. PRE-EMPT NEXT.
TO BE 3 SECONDS TO R.R. PRE-EMPT NEXT.
TIMING TO BE RE-EVALUATED.

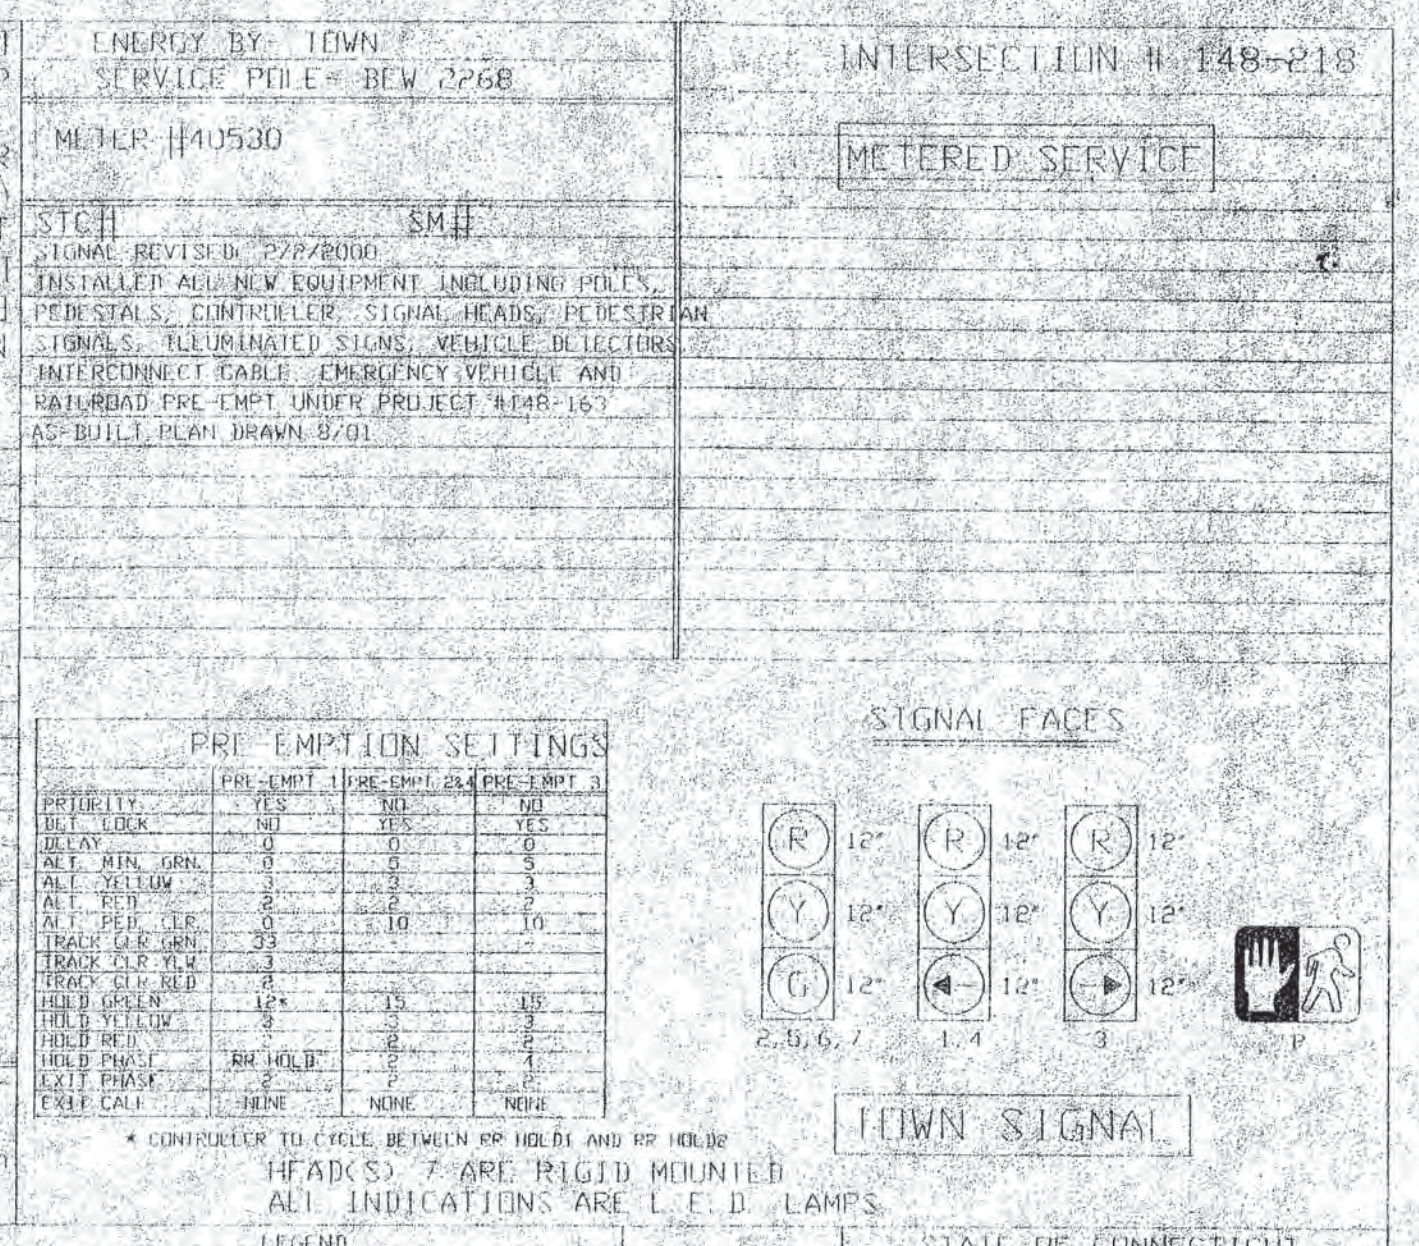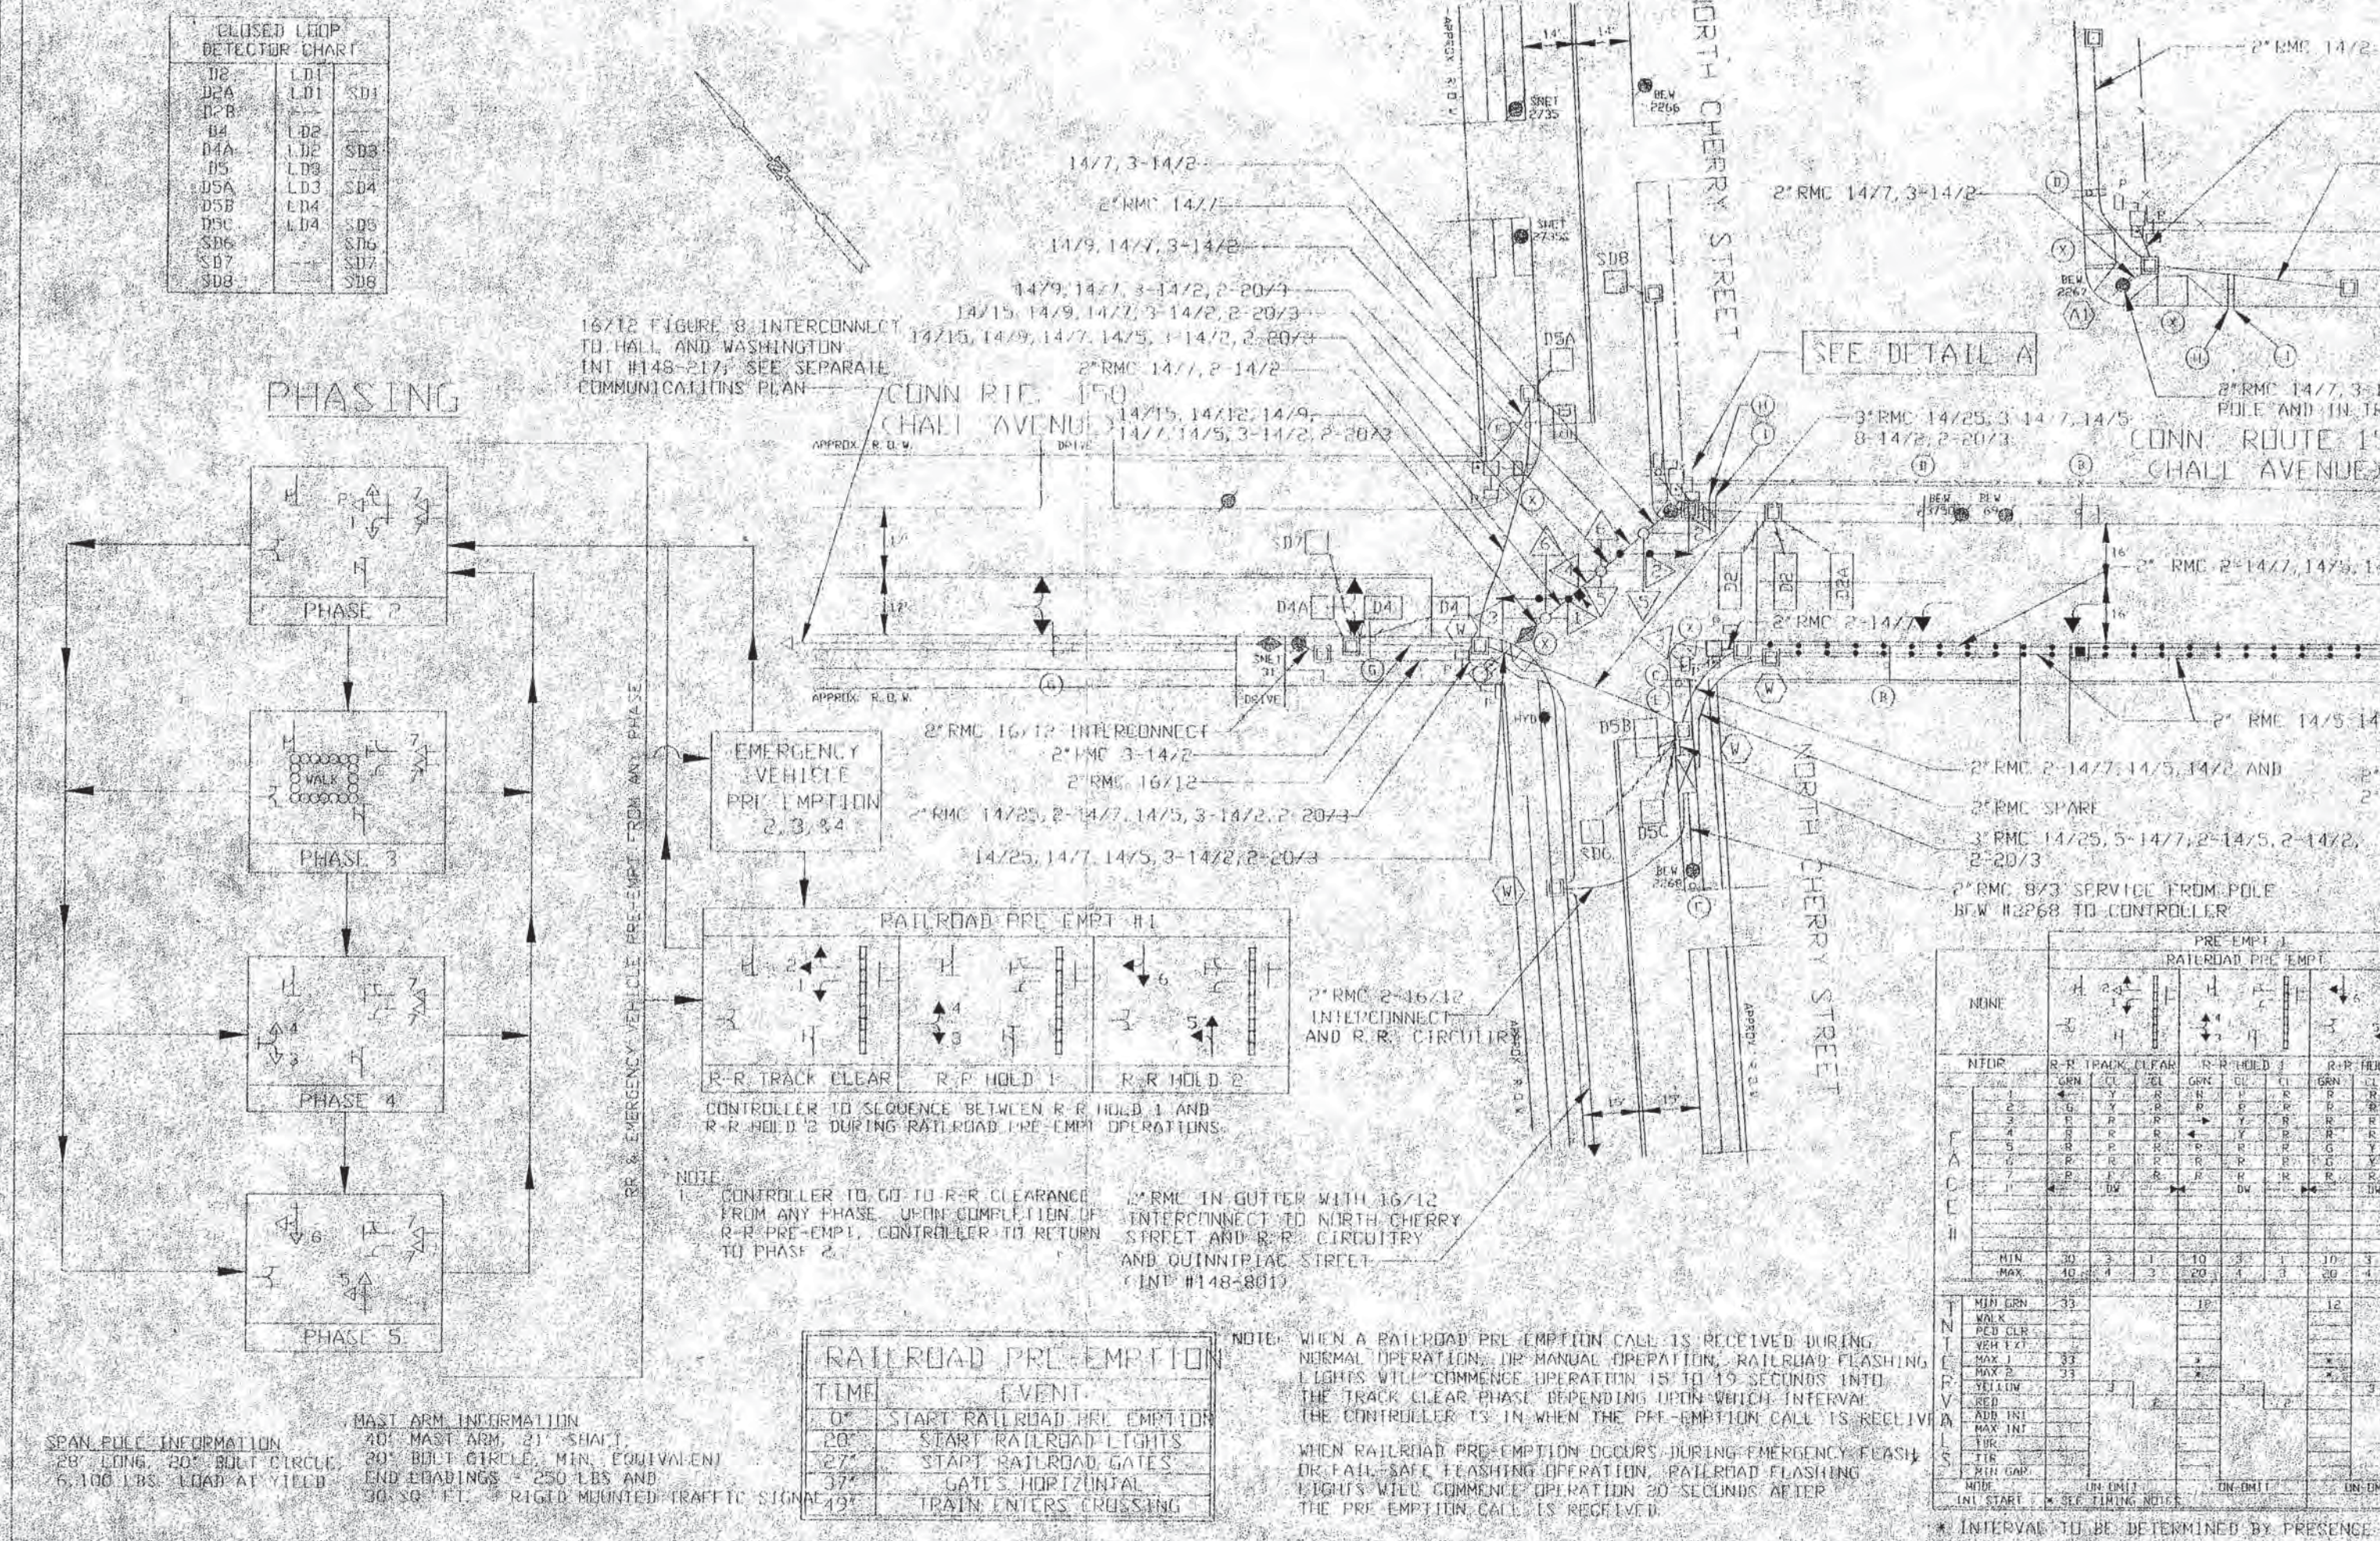


LEGEND
RED, YELLOW, GREEN, BLUE, WHITE, BLACK, SILVER, BRASS, COPPER, ALUMINUM, STEEL, IRON, CEMENT, CONCRETE, ASPHALT, GRAVEL, SAND, SOIL, ROCK, etc.

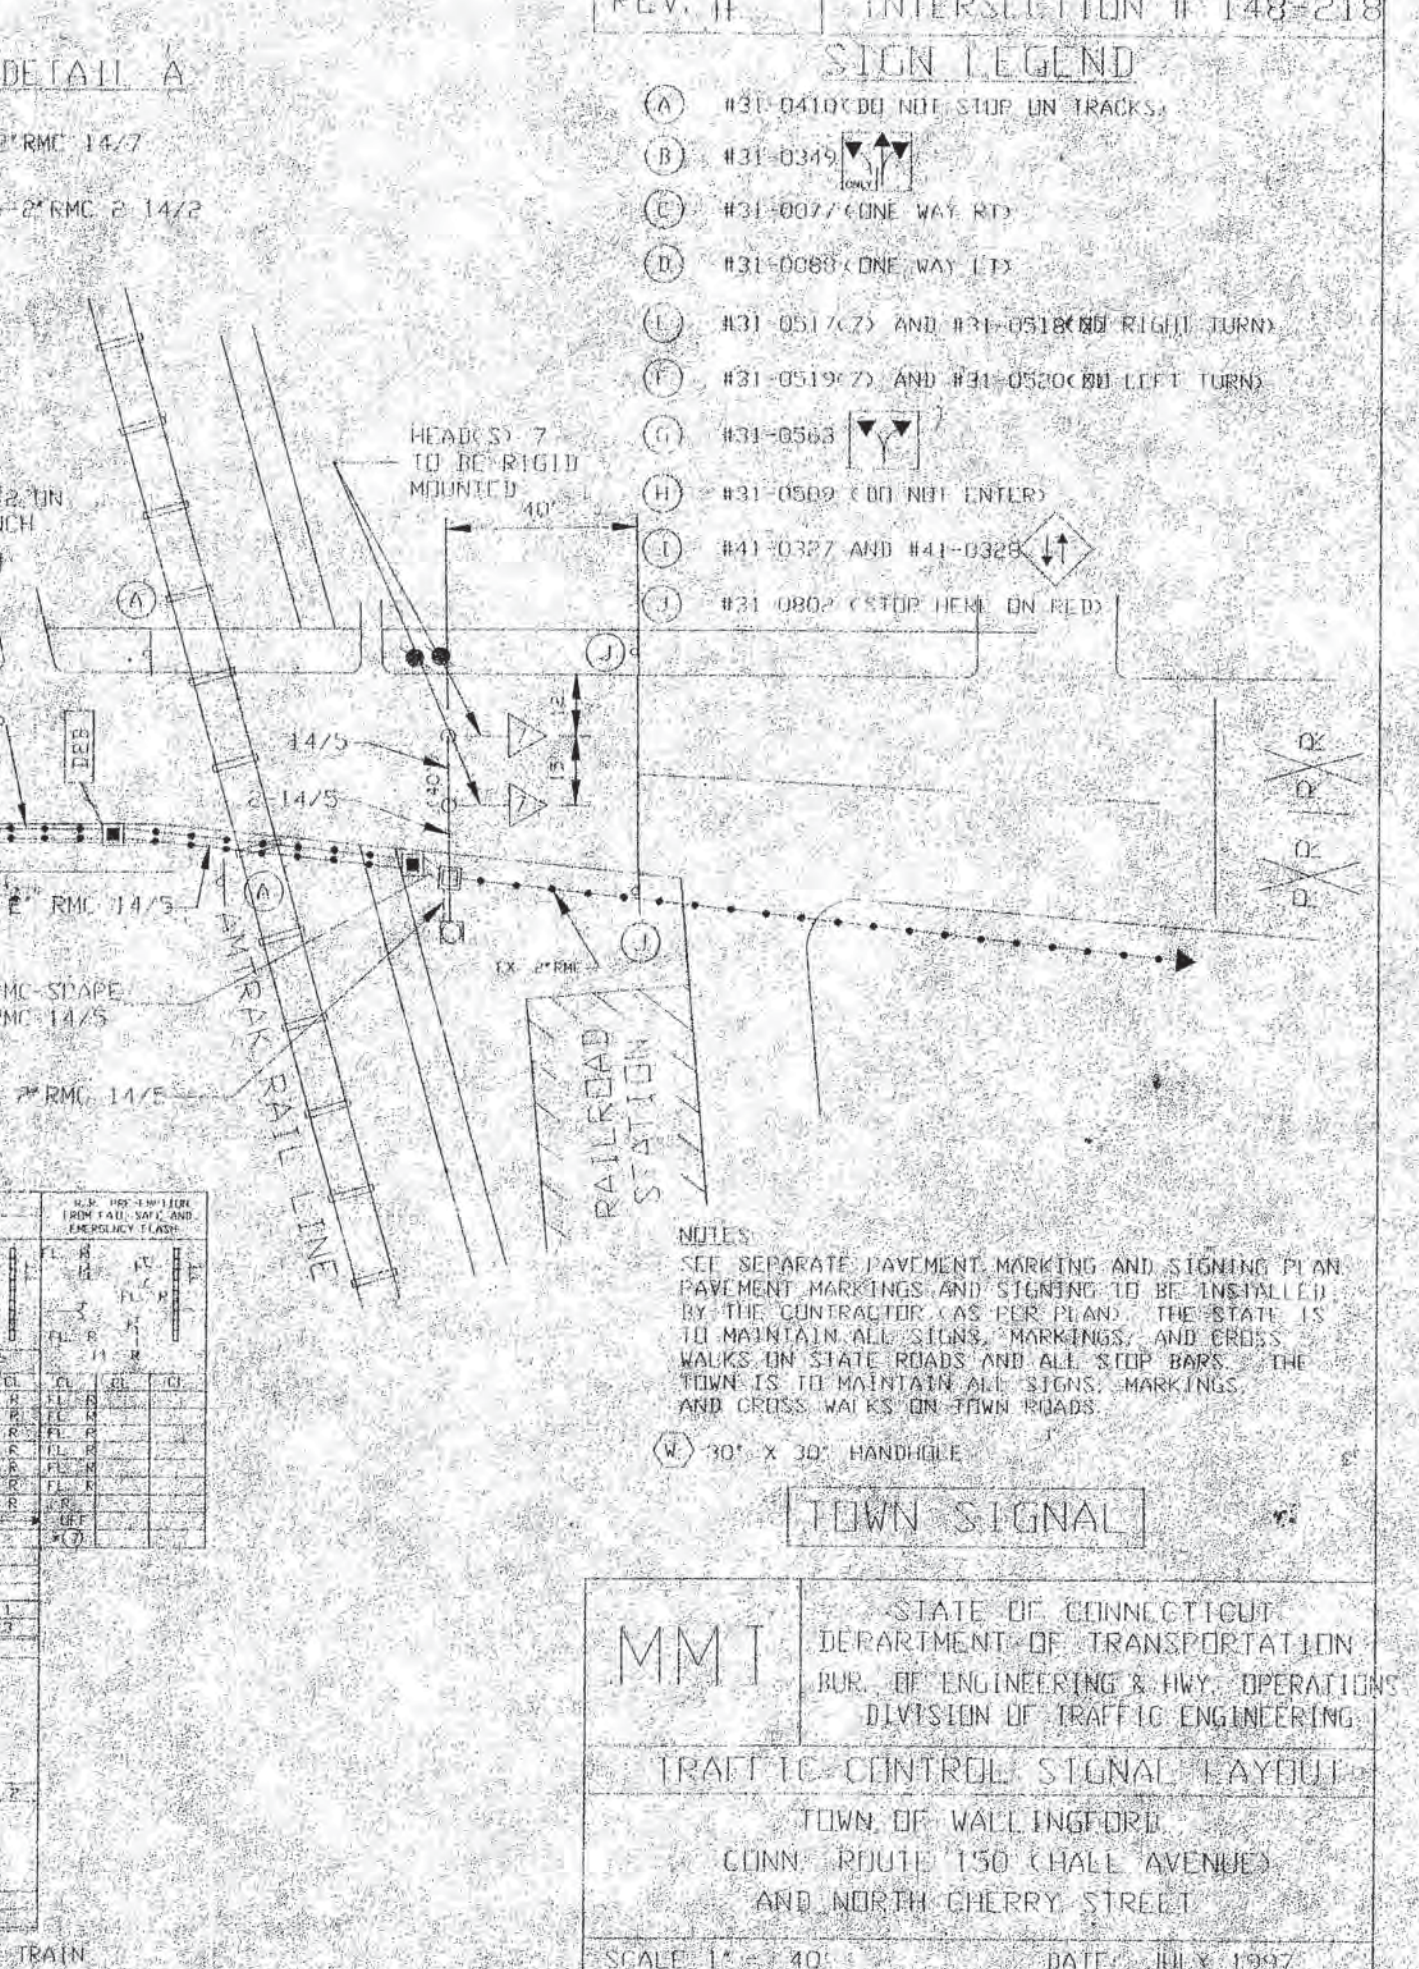

SPANLED INFORMATION
60" HAST ARM, 21" SHAFT
200' HAST ARM, 21" SHAFT
200' HAST ARM, 21" SHAFT
END ENDINGS - 250 LBS AND 200 LB FT. RIGID MOUNTED TRAFFIC SIGNAL

NONE		MOVEMENT DIAGRAM																							
NTOR		PHASE 1			PHASE 2			PHASE 3			PHASE 4			PHASE 5			PHASE 6			PHASE 7			PHASE 8		
	FLASH	GRN	CL	CL	GRN	CL	CL	GRN	CL	CL	GRN	CL	CL	GRN	CL	CL	GRN	CL	CL	GRN	CL	CL	GRN	CL	CL
F A C E #	1	Y			G	Y	R				R	R	R									R	R	R	
	2	Y			G	Y	R				R	R	R									G	G	G	
	3	R			R	R	R				G	Y	R									R	R	R	
	4	Y			FLY	FLY	FLY				FLY	FLY	FLY									R	R	R	
	5	R			FLR	FLR	FLR				FLR	FLR	FLR									G	Y	R	
	MIN				8	3	0.5				5	3	0.5												
	MAX				60	5	3				35	5	3												
I N T E R V A L S	MIN GRN				15						5														
	WALK																								
	PED CLR																								
	VEH EXT				3						1														
	MAX 1				40						20														
	MAX 2				40						20														
	YELLOW					3						3													
	RED						2						2												
	ADD INIT																								
	MAX INIT																								
TBR																									
TTR																									
MIN GAP																									
MODE		OFF			MIN RECALL			OFF			NON-LOCK														
INISTART						THIS PHASE																			ON/OMIT

ENERGY BY- TOWN METERED SERVICE
 MAINT 24hr Norm SERVICE POLE- ED5674 INTERSECTION # 148-231

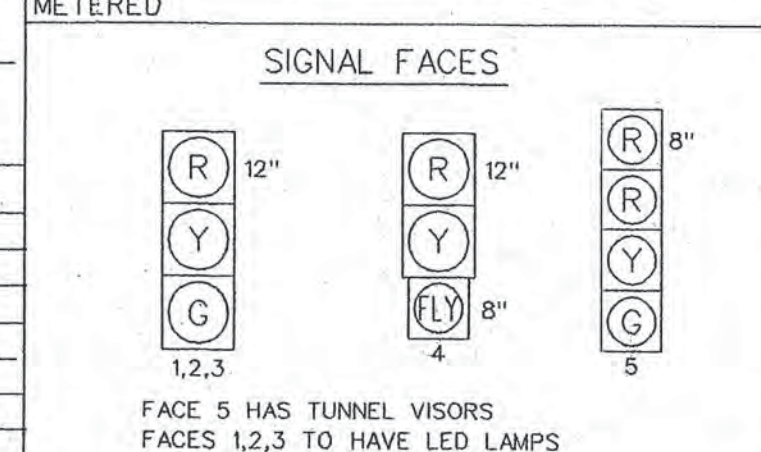

EMERGENCY VEHICLE PRE-EMPT SETTINGS

	PRE-EMPT 1
PRIORITY	NO
DET. LOCK	YES
DELAY	10
ALT. MIN. GRN.	5
ALT. MIN. YELLOW	PARENT
ALT. RED	PARENT
ALT. PED. CLR.	NO
HOLD GREEN	25
HOLD YELLOW	3.0
HOLD RED	2.0
HOLD PHASE	8
EXIT PHASE	2
EXIT CALL	NONE

PLAN SEALED FOR REVISION #3 ONLY

TOWN SIGNAL

LEGEND

R	RED	⊗	PROPOSED CONTROLLER
Y	YELLOW	⊗	EXISTING CONTROLLER
G	GREEN	⊗	PROPOSED HANDHOLE
←R	RED ARROW	⊗	EXISTING HANDHOLE
←Y	YELLOW ARROW	⊗	PROPOSED
←G	GREEN ARROW	⊗	(R.M.C.) RIGID METAL CONDUIT
W/W	WALK/ FL. D.W.	⊗	EXISTING
FL.	DONT WALK	⊗	(R.M.C.) RIGID METAL CONDUIT
○	FLASHING	⊗	CABLE CLOSURE
○	PROPOSED WOOD SPAN POLE	⊗	DET. LEADS IN SAW CUT
○	EXISTING WOOD SPAN POLE	⊗	AUXILIARY TERMINATION CABINET
○	PROPOSED STEEL SPAN POLE	⊗	AUXILIARY EQUIPMENT CABINET
○	EXISTING STEEL SPAN POLE	⊗	AUDIBLE PEDESTRIAN SIGNAL
○	PROPOSED UTILITY POLE	⊗	
○	EXISTING UTILITY POLE	⊗	
□	PEDESTAL MOUNTING	⊗	
□	PEDESTRIAN PUSH BUTTON & SIGN	⊗	
□	TRAFFIC SIGNAL FACE	⊗	
□	PEDESTRIAN SIGNAL FACE	⊗	
□	LOOP DETECTOR	⊗	
□	MAGNETIC DETECTOR	⊗	
SD	SYSTEM DETECTOR	⊗	
○	OPTICAL DETECTOR	⊗	

OFFICE RECORD

REVISION #3

STC * N/A SM * N/A
 UPDATED TRAFFIC SIGNAL EQUIPMENT AT MASONIC DR.
 REVISED PAVEMENT MARKINGS
 REPLACED ALL LOOP DETECTORS
Signal Revised 1-21-99

DETECTORS				PROGRAM			COORDINATION TYPE- NONE								PERMIS PERIOD	SYSTEM LOC	TECHNICAL NOTES						
IDENT	SIZE (WXL)	TURNS	MODE	FUNCTION	T I M E	DAYS	CYCLE	01	02	03	04	05	06	07	08	SEC	%	0	SEC	MASTER			
D2	10'X6'	3	PRESENCE	FLASH	FUTURE																	STANDARD OVERLAP SKIP FEATURES APPLY	
D2A	12'X6'	3	PRESENCE	MAX 1	ALL OTHER TIMES	DAILY																PRE-EMPTION TO BE INOPERATIVE DURING FLASHING OPERATION	
D4	6'X6'	3	PRESENCE	MAX 2	FUTURE																		

STATE OF CONNECTICUT
 DEPARTMENT OF TRANSPORTATION
 BUR. OF ENGINEERING & HWY OPERATIONS
 DIVISION OF TRAFFIC ENGINEERING

TRAFFIC CONTROL SIGNAL

TOWN OF WALLINGFORD
 RTE. 150 (HALL AVENUE) AT
 FIRE HOUSE AND MASONIC HOME

REV # 3	TRAFFIC	ELECTRICAL
ENGINEER	DATE	DATE
DRAFTER		
CHECKED BY		
SUBMITTED BY		
APPROVED BY		
DATE		

MMI
 FEB.1998

F.H.W.A. REGION NO.	STATE	TOWN	FED. AID PROJ. NO.	PROJ. NO.	YEAR	ROUTE NO.	SHEET NO.	TOTAL SHEETS
1	CT	WALLINGFORD	STPN-2571(1)	148-172	1996	--	13	28

CONSTRUCTION NOTES

- ALL TRAFFIC CONTROL EQUIPMENT IS NEW. ALL MATERIALS AND EQUIPMENT SHALL CONFORM TO THE FORM 814A AND AS AMENDED. THE LOCATIONS OF ALL THE TRAFFIC CONTROL EQUIPMENT SHALL BE STAKED, AND APPROVED BY THE TOWN/ENGINEER PRIOR TO CONSTRUCTION.
- ALL CABLING SHALL BE NEW AND INSTALLED WITHOUT SPLICES.
- SPAN WIRE SHALL BE 3/8" DIA. EXTRA STRENGTH 15,400 LBS. MAXIMUM BREAKING STRENGTH.
- CONSTRUCT STANDARD CONNDDOT APPROVED PEDESTRIAN SIDEWALK RAMPS, SEE SEPARATE CONSTRUCTION PLAN AND DETAILS.
- CONTRACTOR SHALL CONTACT "CALL BEFORE YOU DIG" PRIOR TO ANY EXCAVATION. (1-800-922-4455)
- ALL WORK TO BE COORDINATED WITH THE TOWN OF WALLINGFORD POLICE DEPARTMENT, CONTACT OFFICER R. A. DOLL (203)294-2250.
- THE CONTRACTOR WILL SCHEDULE HIS CONSTRUCTION WORK SO THAT POSITIVE TRAFFIC CONTROL (STOP SIGNS, TEMPORARY SIGNALS, ETC.) ARE IN PLACE AND OPERATIONAL AT ALL TIMES.
- THE CONTRACTOR SHALL SUPPLY, INSTALL AND MAKE FULLY OPERATIONAL TO THE SATISFACTION OF THE TOWN THE FOLLOWING:
 - (A) 30' (9.14 METERS) STEEL SPAN POLE ON STANDARD SPAN POLE FOUNDATION STATION 9+52, 24' LEFT ATTACH SPAN WIRE TO EXISTING POLE WED 4762
 - (B) 30' (9.14 METERS) STEEL SPAN POLE ON STANDARD SPAN POLE FOUNDATION WITH POLE MOUNTED ADA APPROVED PUSH BUTTON AND SIGN ASSEMBLY, STATION 10+42.28' RIGHT, IN ACCORDANCE WITH ALL APPLICABLE NEC CODES. THE CONTRACTOR SHALL FURNISH AND INSTALL A 60 AMP WEATHER-PROOF DISCONNECT. THE DISCONNECT SHALL BE A CUTLER-HAMMER SAFETY SWITCH, HEAVY-DUTY SINGLE THROW, 222 NDK-NEMA RATED 12 (3R) DEVICE. THE DISCONNECT SHALL BE MOUNTED TEN (10) FEET ABOVE THE ADJACENT GRADE, AND IN ACCORDANCE WITH THE TOWN'S AND MANUFACTURER'S RECOMMENDATIONS. THE COST FOR THE DISCONNECT SHALL BE INCLUDED IN THE SPAN POLE.
 - (C) INSTALL TOWN APPROVED (STANDARD) FULL ACTUATED 8 PHASE (MASTER) CONTROLLER ON NEW TYPE IV CONTROLLER FOUNDATION, IN "NEW STYLE BC4" MASTER CABINET, AS MANUFACTURED BY THE SOUTHERN MANUFACTURING COMPANY, ORLANDO, FLORIDA, STATION 9+32, 24' LEFT. CONTROLLER SHALL BE EQUIPPED WITH ALL NECESSARY AND/OR REQUIRED COMPONENTS AND INTERNAL COMMUNICATION MODULES FOR INCLUSION IN AND FULL COMPATIBILITY WITH THE TOWNS EXISTING CLOSED LOOP TRAFFIC SIGNAL SYSTEM. THE CONTROLLER CABINET SHALL BE FURNISHED WITH WALLINGFORD ELECTRIC DIVISION APPROVED METER SOCKET, SPECIAL DOOR IN DOOR ASSEMBLY AND WEATHERPROOF DISCONNECT UNIT. WORK WILL ALSO INCLUDE THE INSTALLATION OF A 3'-0" X 5'-0" 4'-0" CONCRETE PAD ON THE DOOR SIDE OF THE CONTROLLER. THE DOOR TO THE CABINET WILL OPEN FIELD SIDE.
 - (D) INSTALL 4'-4" (1.30 METERS) ALUMINUM PEDESTAL ON TYPE I PEDESTAL FOUNDATION, WITH ADA APPROVED PUSH BUTTON AND SIGN ASSEMBLY, STATION 9+65, 27' RIGHT.
 - (E) INSTALL TYPE II HANDHOLES, (TYPICALLY 1'-0" (0.305 METERS) FROM NEW CURB, UNLESS OTHERWISE NOTED)
 - (F) INSTALL TYPE II HANDHOLES AND 1" RMC WITH 16/10 TWISTED PAIR CABLE TO THE NEAREST RELOCATED UTILITY POLE.
 - (G) INSTALL 4000 L.F. 16/10 TWISTED PAIR FIGURE 8 COMMUNICATION CABLE ON RELOCATED AND EXISTING UTILITY POLES ALONG SOUTH TURNPIKE ROAD BETWEEN COOK HILL ROAD AND CHESHIRE ROAD. ALL COSTS ASSOCIATED WITH THIS WORK WILL BE INCLUDED IN THE UNIT PRICE BID FOR THIS ITEM. 16/10 TWISTED PAIR FIGURE 8 COMMUNICATION CABLE TO BE INSTALLED UNDER PROTECT NO. 148-156/165.
 - (H) INSTALL 30" X 30" CONCRETE HANDHOLES.
- ELECTRICAL SERVICE TO THE CONTROLLER SHALL BE COORDINATED WITH THE WALLINGFORD ELECTRICAL DIVISION. THE CONTRACTOR SHALL PAY ALL FEES AND COSTS FOR OBTAINING, CONTACT MR. JAMES H. RAINEY AT WALLINGFORD ELECTRIC DIVISION (203) 265-0308 TO COORDINATE.
- ALL SIGNALS SHALL BE HUNG SO THAT A MINIMUM VERTICAL CLEARANCE OF 17 FEET (5.18 METERS) IS MAINTAINED BETWEEN THE FINAL ROADWAY SURFACE AND THE BOTTOM OF THE SIGNALS.
- THE OPTICOM RECEIVER(S) SHALL BE MOUNTED ON THE SPAN WIRE IN ACCORDANCE WITH THE MANUFACTURER'S RECOMMENDATIONS. A SEPERATE 20/3 CABLE SHALL BE INSTALLED (UNSPliced) DIRECTLY TO THE CONTROLLER.
- INSTALL LOOP DETECTORS IN BASE COURSE OF EXISTING PAVEMENT 3' (0.914 METERS) OFF OF CURB LINE OR EDGE OF ROAD, AND 8' (2.438 METERS) APART UNLESS OTHERWISE NOTED. SEGMENTED LOOPS TO BE SPLICED IN SERIES.
- THE CONTRACTOR SHALL STAKE ALL R.O.W. PRIOR TO ANY EXCAVATION.
- INSTALL CABLE CLOSURE ON SPAN ±5' FROM CURB LINE.
- INSTALL RMC STAND-OFFS ON ALL UTILITY POLES WHERE REQUIRED.
- CONTACT BELOW NOTED UTILITY/PROJECT REPRESENTATIVES A MINIMUM OF TWO (2) WEEKS PRIOR TO CONSTRUCTION.
- ALL TRAFFIC SIGNAL WORK SHALL BE CONSTRUCTED IN ACCORDANCE WITH THE TOWN OF WALLINGFORD AND CONNDDOT'S STANDARD INSTALLATION DETAIL SHEETS.
- ALL STATIONING AND OFFSETS REFER TO THE CONSTRUCTION BASELINE FOR THE OVERALL INTERSECTION RECONSTRUCTION PROJECT. SEE SHEET NUMBER 3 FOR BASELINE COORDINATES. SEE SHEET NUMBER 13 FOR LOCATIONS OF PAVEMENT MARKING AND SIGNALING.
- ALL LOOP DETECTOR INSTALLATIONS AND WIRING SHALL BE PERFORMED IN ACCORDANCE WITH THE STANDARD CONSTRUCTION DETAILS IN ORDER TO ACHIEVE THE REQUIRED VEHICLE DETECTION AND DETECTOR COUNT FUNCTIONS.
- FOLLOWING CONSTRUCTION, AND ACCEPTANCE OF ALL TRAFFIC CONTROL EQUIPMENT, (INCLUDING THE EMERGENCY VEHICLE PRE-EMPT EQUIPMENT) THE TOWN OF WALLINGFORD WILL OWN, OPERATE AND MAINTAIN.

UTILITY/PROJECT CONTACTS
 TOWN / POLICE: R. A. DOLL: 294-2250
 SNET: BOB WENTWORTH: (203)725-4436
 AT&T: RON TARINI: (203)269-2565
 WALLINGFORD ELECTRIC: JAMES RAINEY: 265-0308
 TCI CABLE: JIM HUBBARD: (203)483-3623
 DESIGNER: M.M.I., JOHN P. THOMPSON (203)271-1773

STATE OF CONNECTICUT
 DEPARTMENT OF TRANSPORTATION
 BUREAU OF ENGINEERING & HIGHWAY OPERATIONS
 DIVISION OF TRAFFIC ENGINEERING

RECORD PLAN
 TRAFFIC CONTROL SIGNAL
 BY CONNDDOT
 MAY, 1998

OWNERS NAME
 TOWN OF
 WALLINGFORD

THIS SHEET IS PART OF PROJECT NO. 148-172

MOVEMENT DIAGRAM

ENERGY BY- TOWN
 SERVICE POLE- WED# 7653

INTERSECTION # 148-807
METERED SERVICE

STC# 148-807 SM#
 SIGNAL OPERATION 6-18-97
 SIGNAL INSTALLED UNDER PROJECT# 148-72.
 AS BUILT PLAN DRAWN 4/98.

FACE #	NTOR	PHASE 1		PHASE 2		PHASE 3		PHASE 4		PHASE 5		PHASE 6		PHASE 7		PHASE 8	
		GRN	CL	GRN	CL	GRN	CL	GRN	CL	GRN	CL	GRN	CL	GRN	CL	GRN	CL
1	G	G	G	G	G	G	G	G	G	G	G	G	G	G	G	G	G
2	G	G	G	G	G	G	G	G	G	G	G	G	G	G	G	G	G
3	R	R	R	R	R	R	R	R	R	R	R	R	R	R	R	R	R
4	R	R	R	R	R	R	R	R	R	R	R	R	R	R	R	R	R
5	R	R	R	R	R	R	R	R	R	R	R	R	R	R	R	R	R
MIN		10	3	1	15	3	1		10	3	1						
MAX		30	5	3	60	5	3		50	5	3						

INTERVALS

MIN GRN	5		15														
WALK																	
PED CLR																	
VEH EXT	2			4													
MAX 1	12			25													
MAX 2	15			35													
YELLOW		3		3					3								
RED			1		2					1							
ADD INT																	
MAX INT																	
TBR																	
TTR																	
MIN GAP																	

OPERATION

24hr Norm

EMERGENCY VEHICLE PRE-EMPT SETTINGS

PRIORITY	YES	PRE-EMPT 1
REL. LOCK	YES	
REL. MIN GRN	NO	
ALT. YEL. CLR.	NO	
HOLD. YEL. CLR.	NO	
HOLD. RED	NO	
HOLD. PHASE	NO	
EXIT CALL	NO	

SIGNAL FACES

TOWN SIGNAL

STATE OF CONNECTICUT
 DEPARTMENT OF TRANSPORTATION
 BUR. OF ENGINEERING & HWY OPERATIONS
 DIVISION OF TRAFFIC ENGINEERING

TRAFFIC CONTROL SIGNAL

TOWN OF WALLINGFORD
 COOK HILL ROAD AND
 SOUTH TURNPIKE ROAD

REV. #	TRAFFIC	ELECTRICAL
1	FEB 1996	FEB 1996
2	FEB 1996	FEB 1996

ENGINEER: M.M.I. DATE: FEB 1996
 DRAFTER: M.M.I. DATE: FEB 1996
 CHECKED BY: M.M.I. DATE: FEB 1996
 SUBMITTED BY: M.M.I. DATE: FEB 1996
 APPROVED BY: M.M.I. DATE: FEB 1996

AS-BUILT BY CONNDDOT MAY, 1998

DETECTORS

IDENT	SIZE	TURNS	MODE	FUNCTION	PROGRAM	COORDINATION TYPE	SYSTEM LOC
D1	6'X10'	3	8" DELAY	FLASH	EMERGENCY ONLY	NON-LOCK	148-807
D1A	6'X6'	3	PRESENCE	MAX 1	ALL TIMES	NON-LOCK	
D2A	6'X15'	3	PRESENCE	MAX 2	FUTURE	OFF	
D2B	6'X15'	3	PRESENCE			OFF	
D4	6'X10'	3	8" DELAY			OFF	
D4A	6'X6'	3	PRESENCE			OFF	
D4B	6'X10'	3	PRESENCE			OFF	
D4C	6'X6'	3	PRESENCE			OFF	
SD1	6'X6'	3	PRESENCE			OFF	
SD2	6'X6'	3	PRESENCE			OFF	
SD3	6'X6'	3	PRESENCE			OFF	

TECHNICAL NOTES

STANDARD OVERLAP SKIP FEATURES APPLY


DETECTOR D1 AND D1A TO CALL #1 AND EXTEND #2

DETECTOR D2A & D2B CALL AND EXTEND #2

DETECTOR D4, D4A, D4B & D4C TO CALL AND EXTEND #4

DETECTOR D1 TO BE SET AT 8 SECOND DELAY

REAR DETECTORS, D1A, D4A, AND D4C TO BE 6'X6" AND WIRED SEPARATELY TO PROVIDE COUNT DATA.

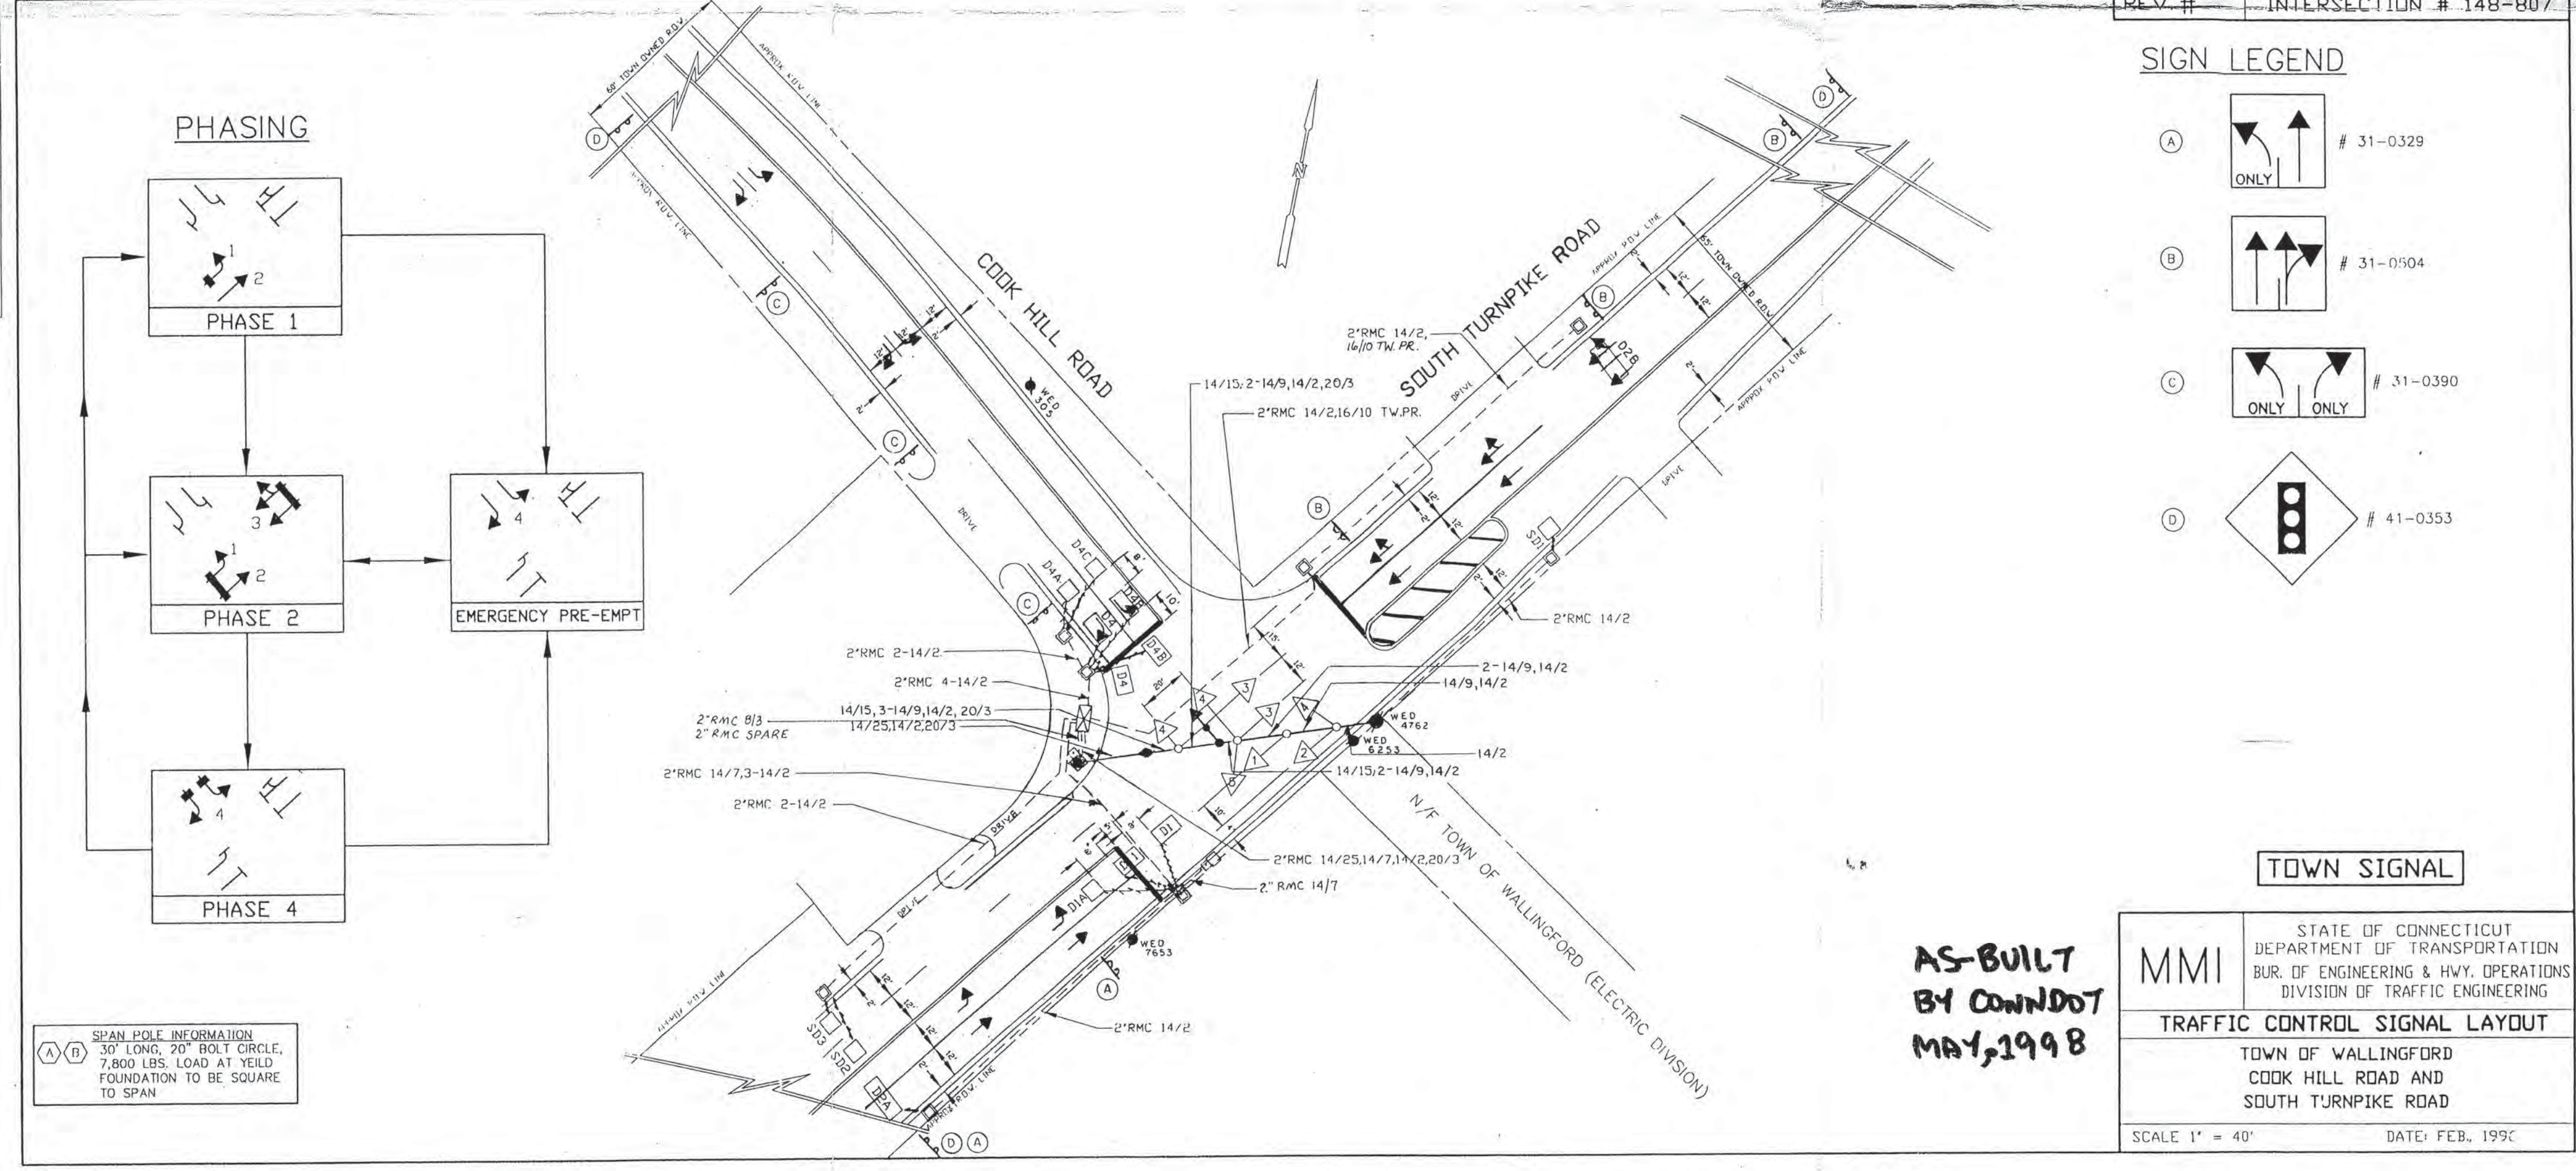

REV. # INTERSECTION # 148-807

SIGN LEGEND

- (A) # 31-0329
- (B) # 31-0504
- (C) # 31-0390
- (D) # 41-0353

TOWN SIGNAL

STATE OF CONNECTICUT
 DEPARTMENT OF TRANSPORTATION
 BUR. OF ENGINEERING & HWY OPERATIONS
 DIVISION OF TRAFFIC ENGINEERING



TRAFFIC CONTROL SIGNAL LAYOUT

TOWN OF WALLINGFORD
 COOK HILL ROAD AND
 SOUTH TURNPIKE ROAD

SCALE 1" = 40' DATE: FEB. 1996


AS-BUILT BY CONNDDOT MAY, 1998

REV. # INTERSECTION # 148-807

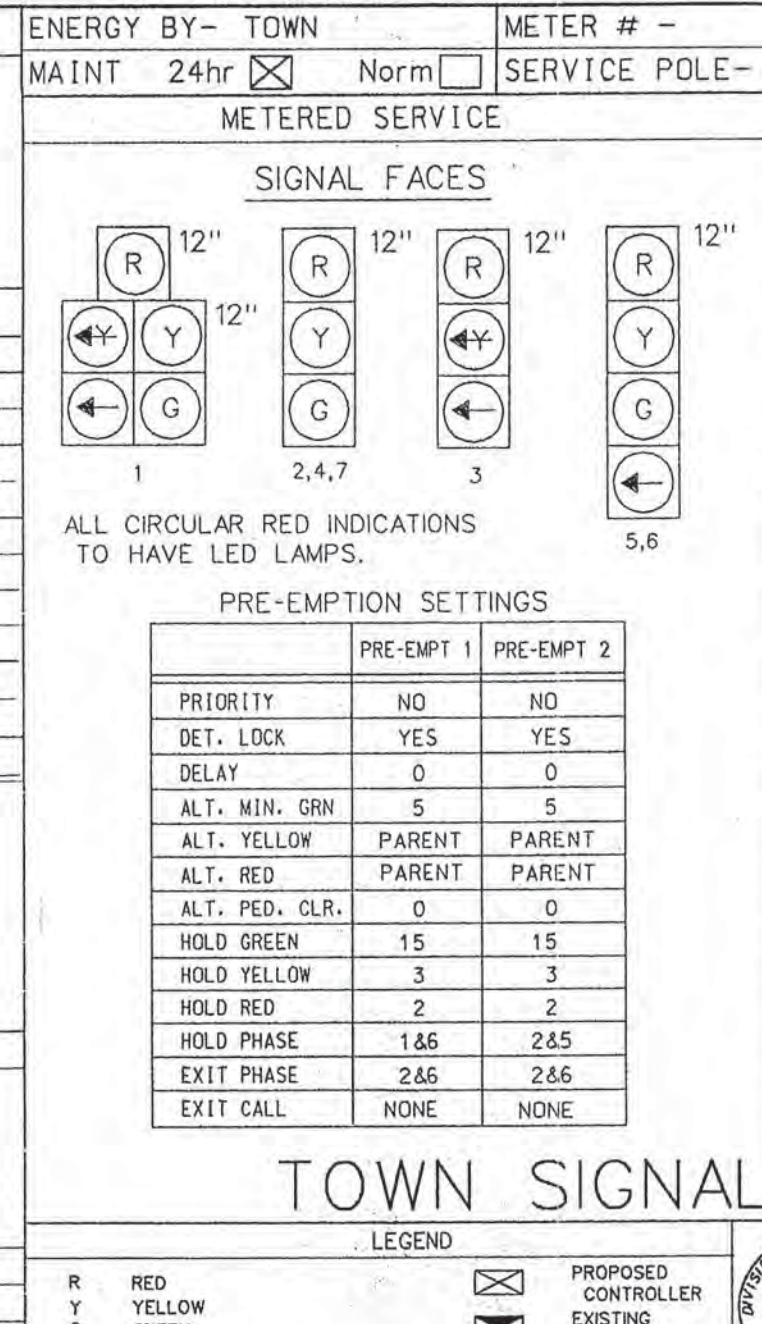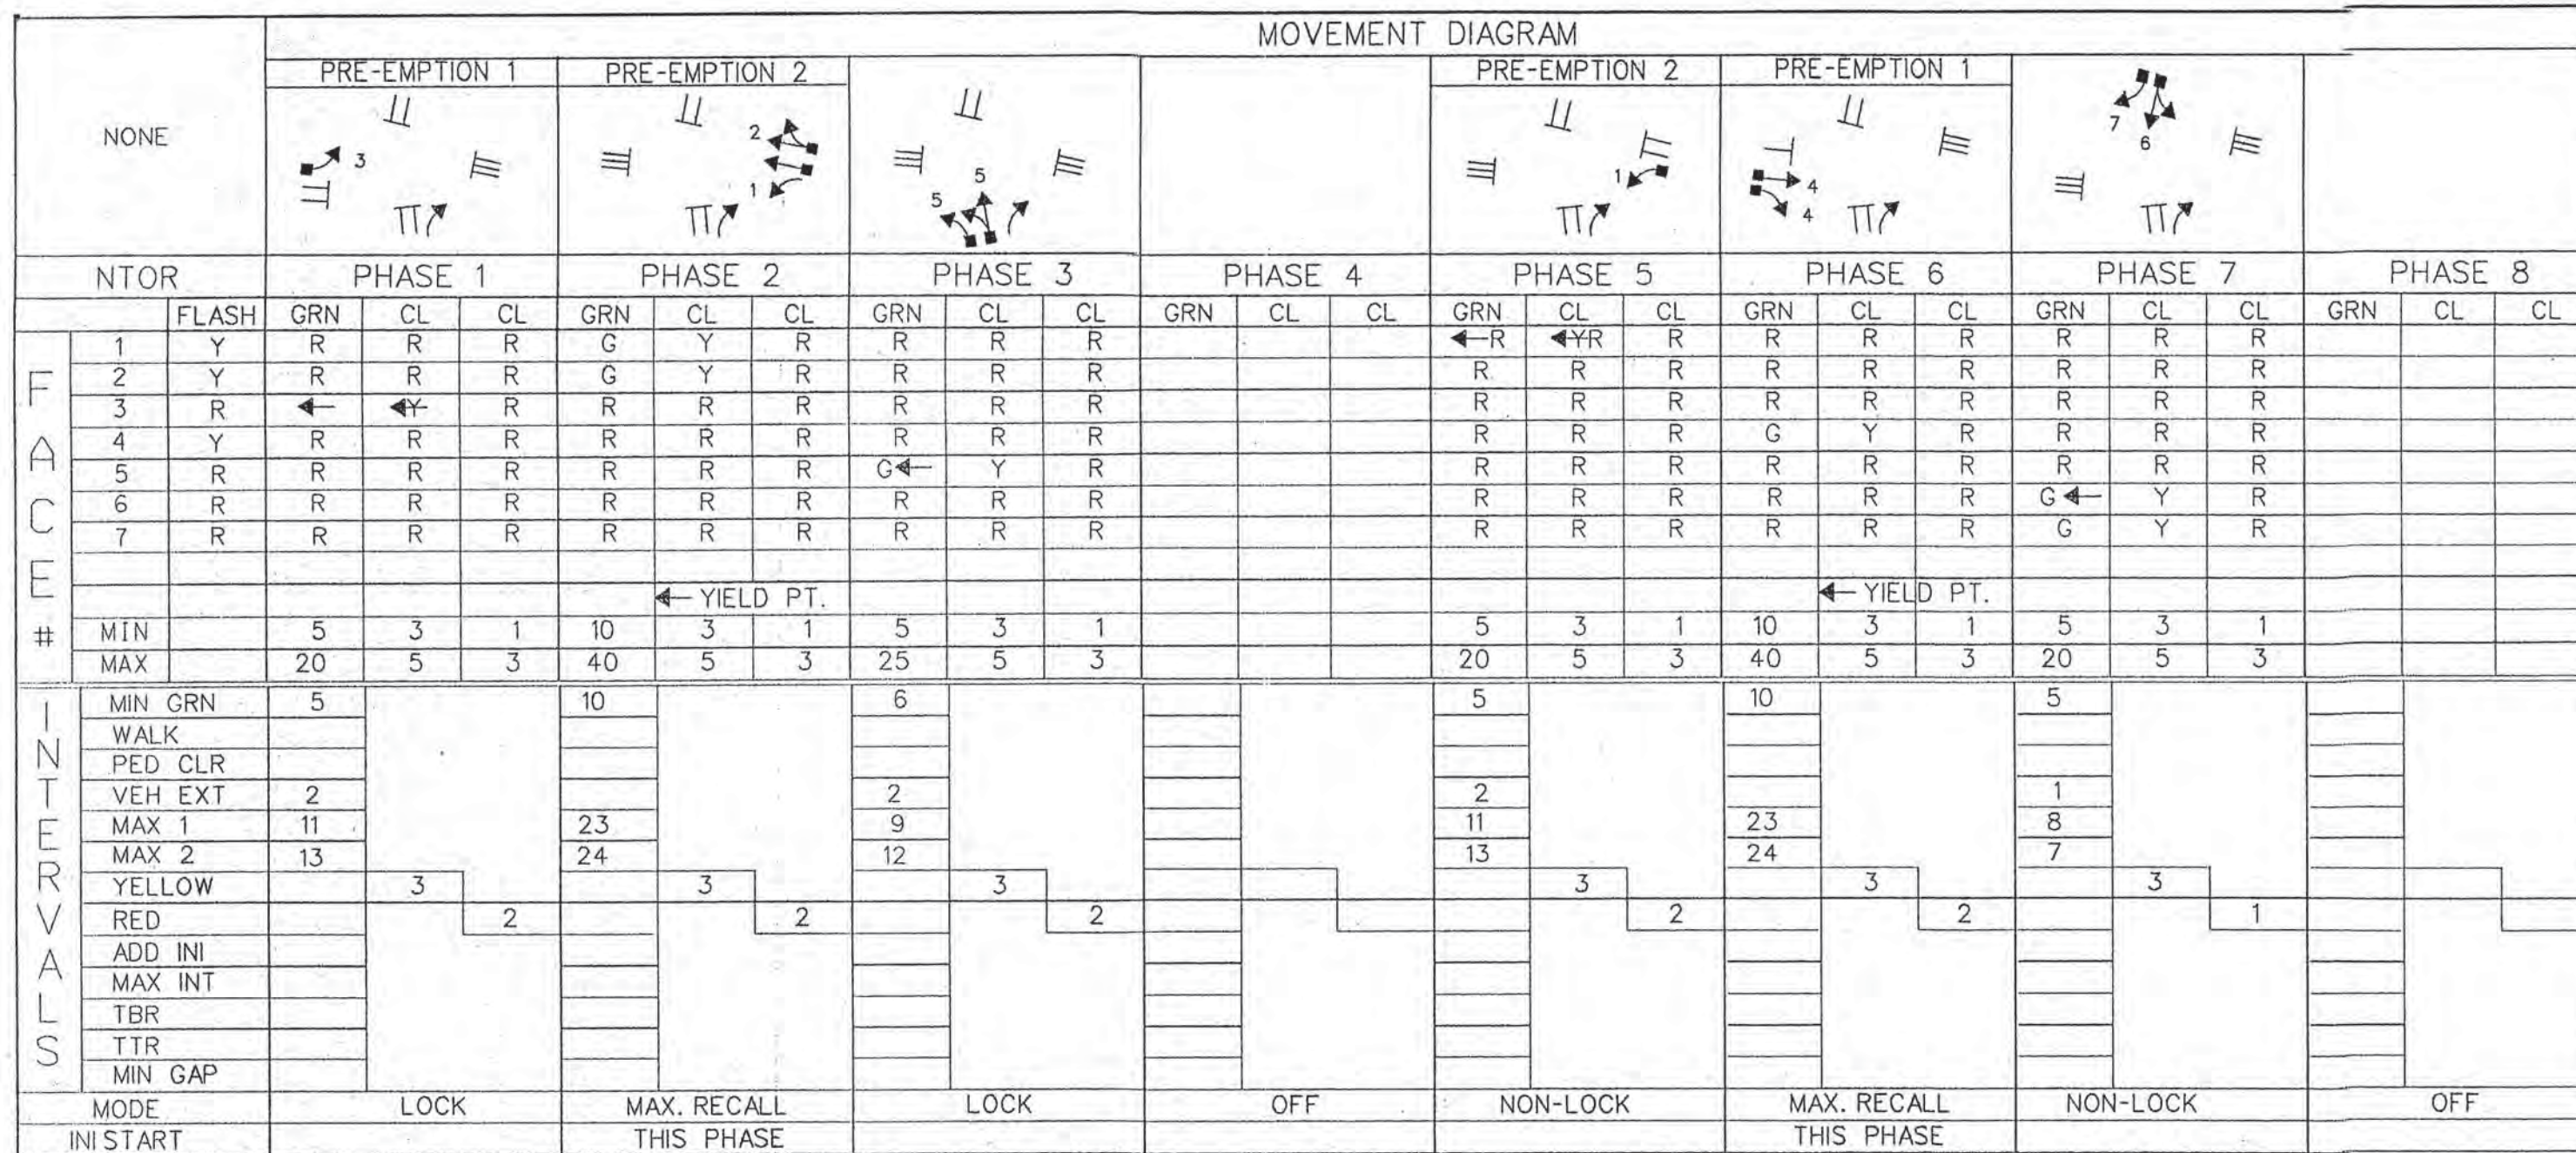

REV #	DATE	TRAFFIC	ELECTRICAL	
ENGINEER	JNT	11-95	JSS	3-96
DRAFTER	PSF	11-95	PSF	3-96
CHECKED BY	PEW	5-96	RMW	3-96
SUBMITTED BY	CRM	5-29-96	MJG	15-30-96
APPROVED BY	VINCENT AVINO		D.P. MCCALL	
DATE	5-30-96		5-30-96	
			ORIGINAL SIGNED	



DETECTORS		PROGRAM		COORDINATION TYPE - CLOSED LOOP		PERMITS		SYSTEM LOC		TECHNICAL NOTES	
IDENT	SIZE (WXL)	URNS	MODE	FUNCTION	TIME	DAYS	CYCLE	PHASE SPLITS	%/SEC	OFFSET	PERIOD
D1	6X6	3	PRESENCE	FLASH	EMERGENCY ONLY						148-263
D2,2A	6X6	4	PRESENCE	MAX. 1	ALL OTHER TIMES						148-246
D2B,2C	6X6	3	PRESENCE	MAX. 2	1500-1800	DAILY					148-905
D3	6X6	3	PRESENCE	CYCLE 1	ALL OTHER TIMES		70"	23 16 40 20 14	23 16 49 28 17 12	0 0	
D5A	6X6	3	ABANDON	CYCLE 2	1500-1800	DAILY	75"	24 18 38 23 17	24 18 38 29 15 11	0 0	
D6	6X6	4	3" DELAY	CYCLE 3	FUTURE						
D6A	6X6	3	8" DELAY	FREE	FUTURE						
D6B	7X6	3	8" DELAY								
D6C	10X6	3	8" DELAY								

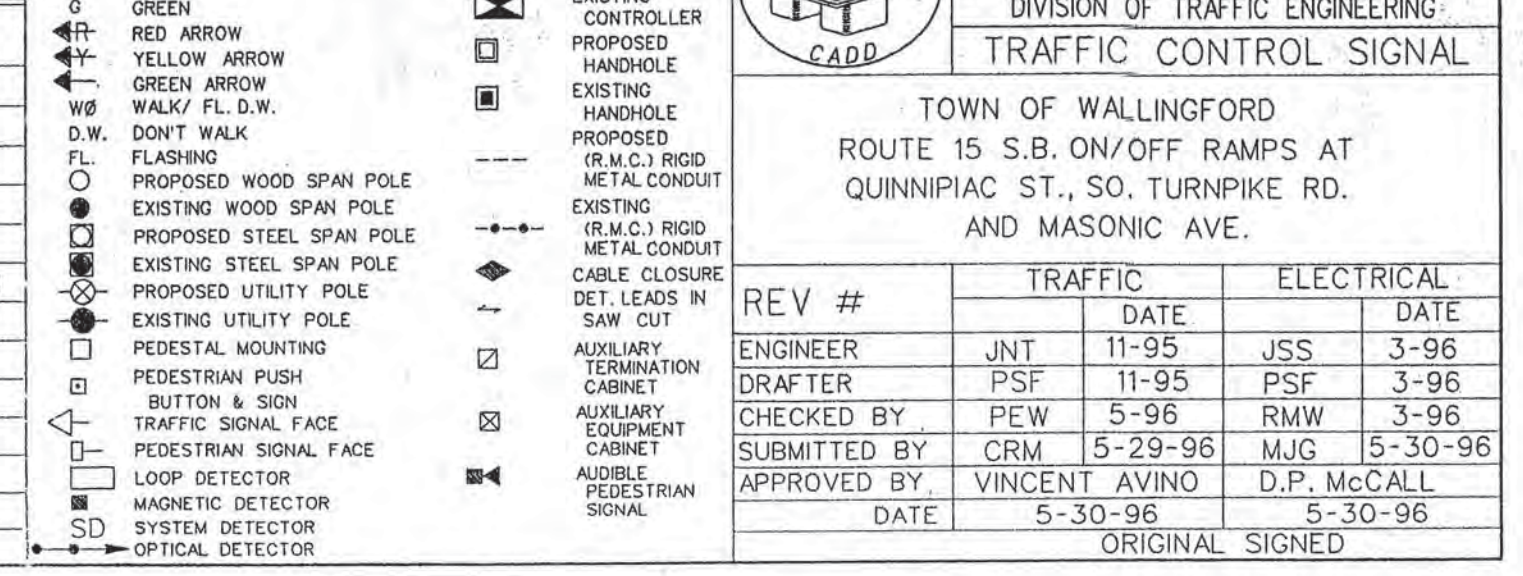

F.H.W.A. REGION NO.	STATE	TOWN	FED. AID PROJ. NO.	PROJ. NO.	YEAR	ROUTE NO.	SHEET NO.	TOTAL SHEETS
1	CONN.	WALLINGFORD	DPM-0009(4)	148-156	1996	15	140A	

CONSTRUCTION NOTES

ALL TRAFFIC SIGNAL EQUIPMENT IS NEW.
 STAKE ALL R.O.W. PRIOR TO EXCAVATION.
 INSTALL 30" X 30" HANDHOLE. ALL OTHERS TYPE II.
 INSTALL HANDHOLES APPROX. 1' BEHIND CURB OR EDGE OF ROAD UNLESS OTHERWISE SPECIFIED.
 INSTALL R.M.C. STAND-OFFS ON ALL UTILITY POLES.
 INSTALL LOOP DETECTORS 3' OFF EDGE OF ROAD AND 8' APART UNLESS OTHERWISE SPECIFIED. SEGMENTED LOOPS TO BE SPLICED IN SERIES.
 LOOP DETECTOR SAWCUT WIRES SHALL BE PULLED THROUGH HANDHOLE (WITH NO SPLICES) AND THROUGH THE 2" R.M.C., THEN SPLICED TO CORRESPONDING LOOPS IN EACH LANE, IN HANDHOLE. TWIST LOOP DETECTOR SAWCUT WIRES INSIDE THE 2" R.M.C. ACCORDING TO TYPICAL PLAN.
 INSTALL CONCRETE SIDEWALK ON CABINET DOOR SIDE OF CONTROLLER FOUNDATION AS SHOWN ON TYPICAL INSTALLATION DETAIL SHEET. CABINET DOOR TO OPEN FIELD SIDE.
 TWO WEEKS PRIOR TO INSTALLATION CONTACT WALLINGFORD ELECTRIC DIVISION REPRESENTATIVE ART DUTRA AT (203) 265-0308 AND SNET REPRESENTATIVE LEROY WALKER AT (860) 725-4514.
 TRAFFIC SIGNAL CABLE CLOSURE SHALL BE INSTALLED ON THE SPAN ± 5' FROM THE CURBLINE.
 SPAN ATTACHMENT ON ED 4569 SHALL BE APPROX. 30'. CONTRACTOR TO VERIFY LOCATION WITH UTILITIES PRIOR TO ATTACHMENT.
 ED 4569 TO BE ANCHORED AND GUYED.
 PRE-EMPTION IS TO OPERATE THROUGH THE INTERNAL PRE-EMPTION OF THE SIGNAL CONTROLLER.
 THE CONTRACTOR IS TO INSTALL A SWITCH IN THE SIGNAL CABINET TO EFFECTIVELY DISCONNECT THE PRE-EMPTION EQUIPMENT FROM THE TRAFFIC SIGNAL CONTROLLER.
 OPTICAL DETECTOR LOCATIONS ON SPAN WIRE ARE FOR ILLUSTRATION ONLY. EXACT LOCATIONS SHALL BE DETERMINED BY THE MANUFACTURER OR THEIR DESIGNATED REPRESENTATIVE.

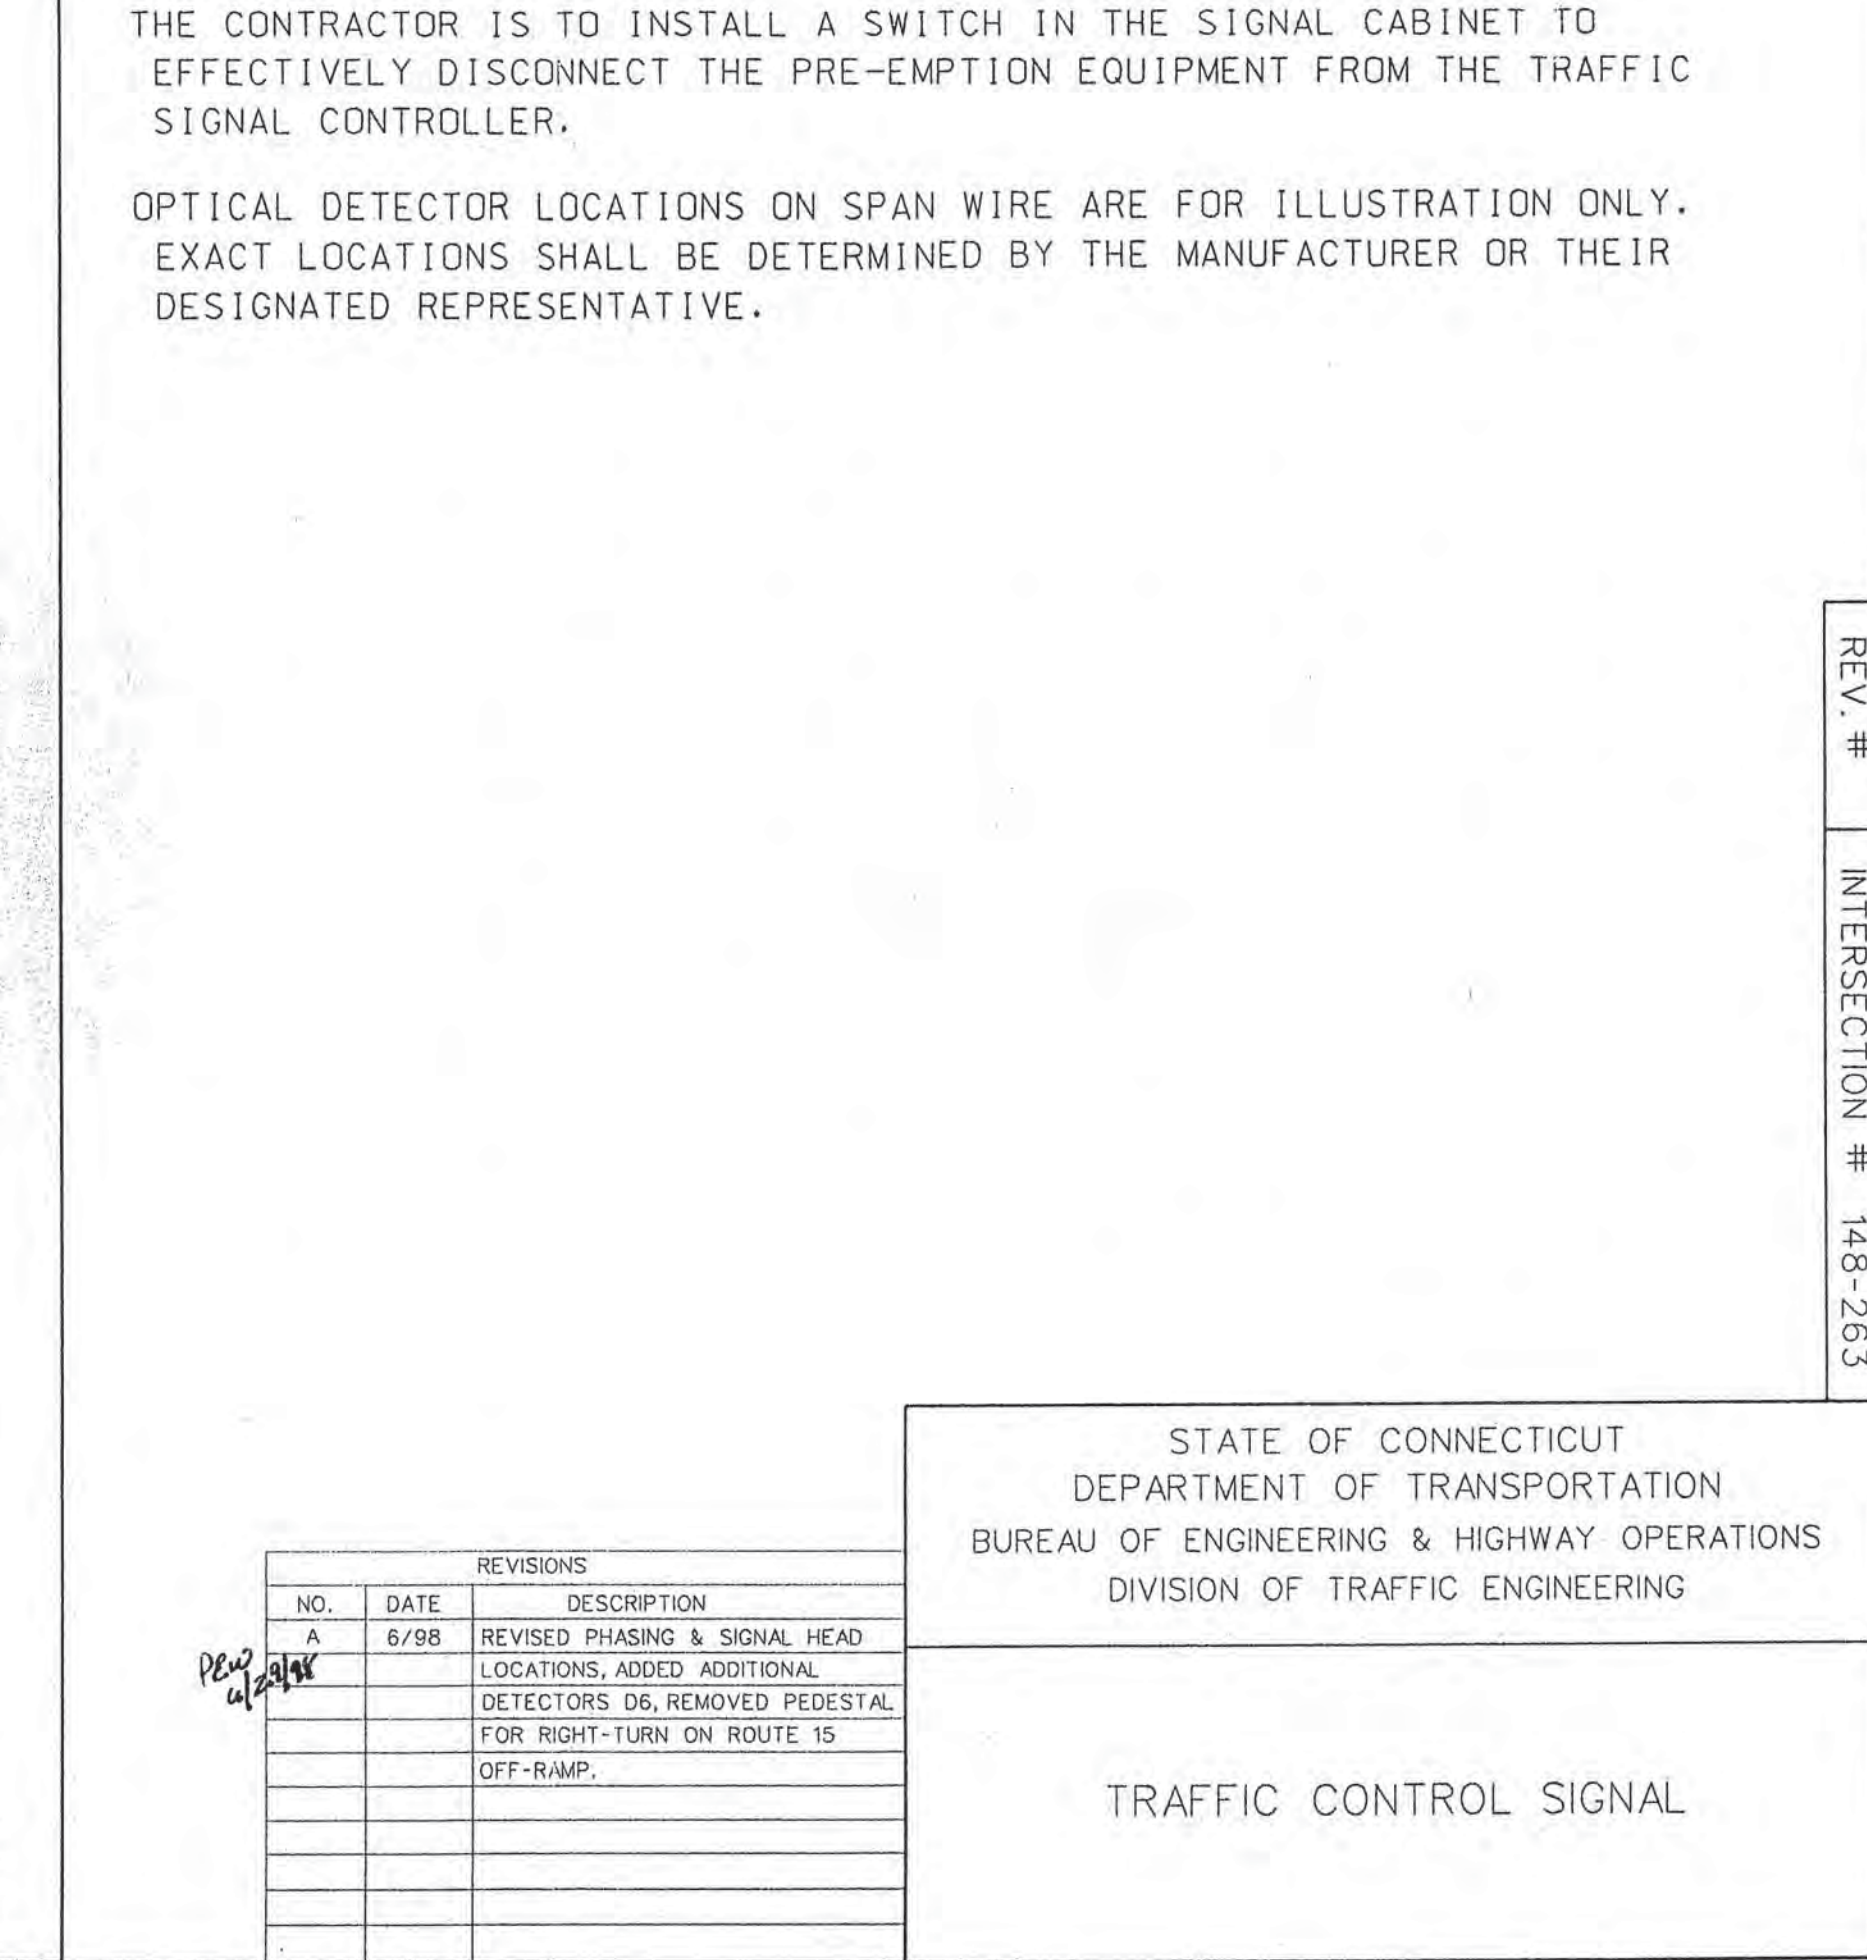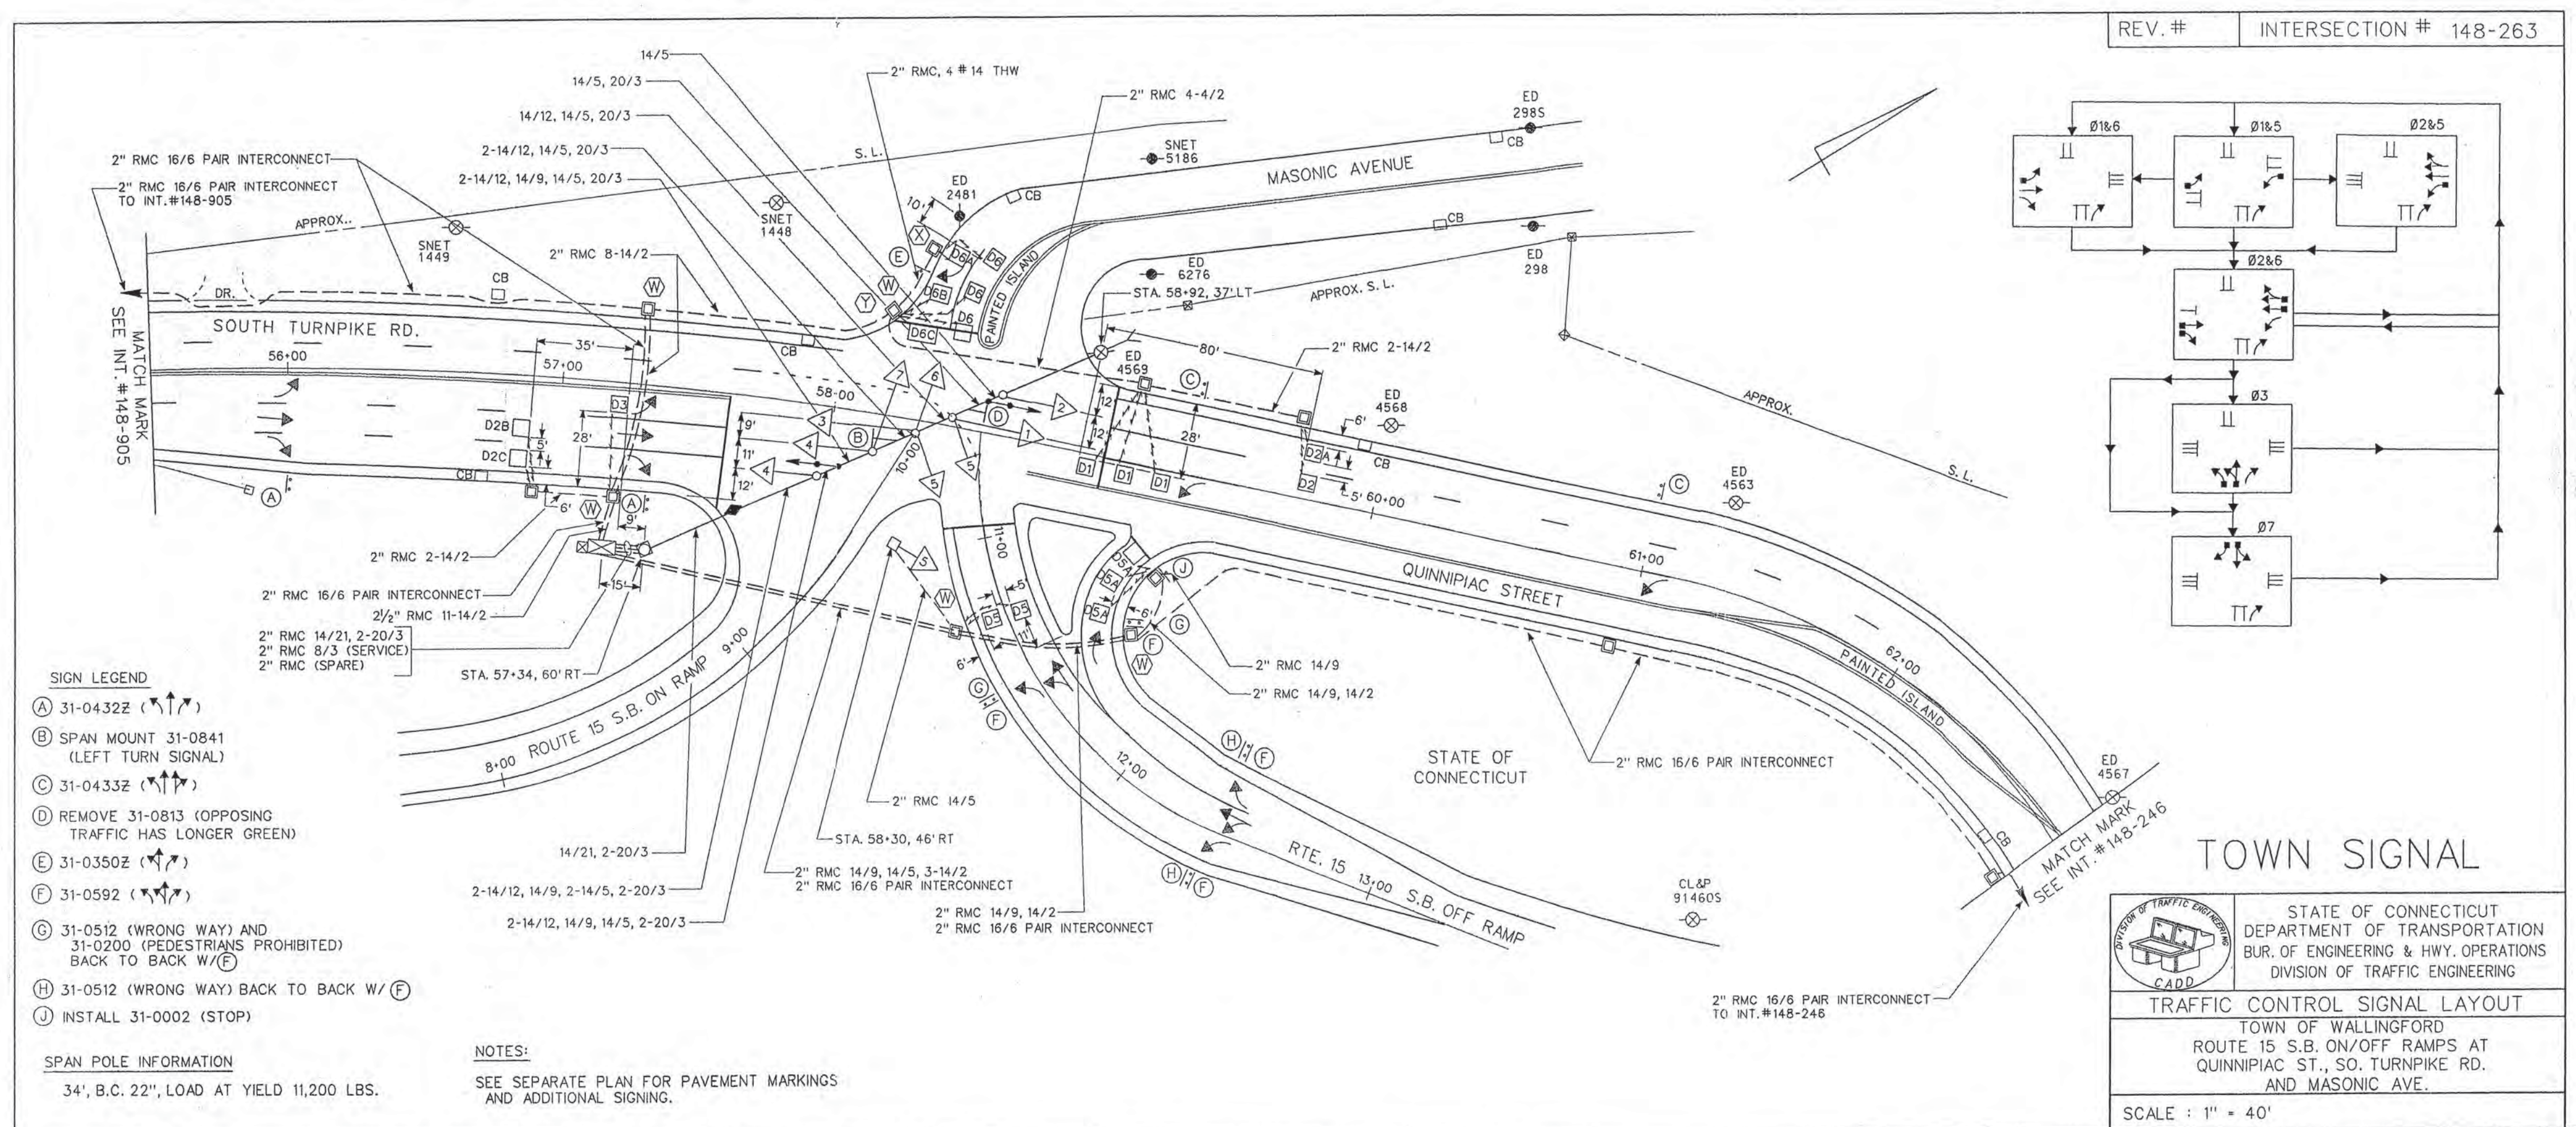

REVISIONS			
NO.	DATE	REVISIONS	DESCRIPTION
A	6/98	REVISED PHASING & SIGNAL HEAD LOCATIONS, ADDED ADDITIONAL DETECTORS D6, REMOVED PEDESTAL FOR RIGHT-TURN ON ROUTE 15 OFF-RAMP.	

REV. # INTERSECTION # 148-263

		PRE-EMPT. 1		MOVEMENT DIAGRAM																													
		PHASE 1				PHASE 2				PHASE 3				PHASE 4				PHASE 5				PHASE 6				PHASE 7				PHASE 8			
NTOR		GRN	CL	CL	GRN	CL	CL	GRN	CL	CL	GRN	CL	CL	GRN	CL	CL	GRN	CL	CL	GRN	CL	CL	GRN	CL	CL	GRN	CL	CL	GRN	CL	CL		
F A C E #	1	FLASH	GRN	CL	CL	GRN	CL	CL	GRN	CL	CL	GRN	CL	CL	GRN	CL	CL	GRN	CL	CL	GRN	CL	CL	GRN	CL	CL	GRN	CL	CL	GRN	CL	CL	
	2	R	G	G	G	G	Y	R	R	R	R	R	R	R	R	R	R	R	R	R	R	R	R	R	R	R	R	R	R	R	R	R	
	3	R	R	R	R	R	G	Y	R	R	R	R	R	R	R	R	R	R	R	R	R	R	R	R	R	R	R	R	R	R	R	R	
	4	R	R	R	R	R	R	R	R	R	R	R	R	R	R	R	R	R	R	R	R	R	R	R	R	R	R	R	R	R	R	R	
	5	R	R	R	R	R	R	R	R	R	R	R	R	R	R	R	R	R	R	R	R	R	R	R	R	R	R	R	R	R	R	R	
	6	R	R	R	R	R	R	R	R	R	R	R	R	R	R	R	R	R	R	R	R	R	R	R	R	R	R	R	R	R	R	R	
	7	R	R	R	R	R	R	R	R	R	R	R	R	R	R	R	R	R	R	R	R	R	R	R	R	R	R	R	R	R	R	R	
	8	R	R	R	R	R	R	R	R	R	R	R	R	R	R	R	R	R	R	R	R	R	R	R	R	R	R	R	R	R	R	R	
	9	R	R	R	R	R	R	R	R	R	R	R	R	R	R	R	R	R	R	R	R	R	R	R	R	R	R	R	R	R	R	R	
	MIN	3	3	0.1	9	3	1	9	3	1	9	3	1	9	3	1	9	3	1	9	3	1	9	3	1	9	3	1	9	3	1	9	3
MAX	10	5	0.1	30	5	3	30	5	3	30	5	3	30	5	3	30	5	3	30	5	3	30	5	3	30	5	3	30	5	3	30	5	
I N T E R V A L S	MIN GREEN	3			9	←YIELD PT.	9																										
	WALK																																
	PED CLR																																
	VEH EXT	1																															
	MAX 1	6																															
	MAX 2	5																															
	YELLOW		3																														
	RED			0.1																													
	ADD INIT																																
	MAX INIT																																
TBR																																	
TTR																																	
MIN GAP																																	
MODE		NON-LOCK		MAX RECALL		LOCK		OFF		NON-LOCK		OFF		OFF		OFF																	
INSTART				THIS PHASE																													

ENERGY BY - TOWN METER # -
 MAINT 24hr Norm SERVICE POLE-SNET 1943 INTERSECTION # 148-246

METERED SERVICE OFFICE RECORD

SIGNAL FACES

PRE-EMPTION SETTINGS

PRIORITY	NO
DET. LOCK	YES
DELAY	0
ALT. MIN. GRN	5
ALT. YELLOW	PARENT
ALT. RED	PARENT
ALT. PED. CLR.	0
HOLD GREEN	15
HOLD YELLOW	4
HOLD RED	1
HOLD PHASE	2
EXIT PHASE	3
EXIT CALL	NONE

ALL CIRCULAR RED INDICATIONS TO BE LED LAMPS
 SIGNAL FACE 8 TO HAVE TUNNEL VISORS.

LEGEND

R	RED	PROPOSED CONTROLLER
Y	YELLOW	EXISTING CONTROLLER
G	GREEN	PROPOSED CONTROLLER
←	RED ARROW	EXISTING CONTROLLER
↔	YELLOW ARROW	PROPOSED CONTROLLER
→	GREEN ARROW	EXISTING CONTROLLER
WB	WALK/FL D.W.	EXISTING HANDHOLE
D.W.	DON'T WALK	PROPOSED HANDHOLE
FL	FLASHING	EXISTING (R.M.C.) RIGID METAL CONDUIT
○	PROPOSED WOOD SPAN POLE	EXISTING (R.M.C.) RIGID METAL CONDUIT
●	EXISTING WOOD SPAN POLE	EXISTING (R.M.C.) RIGID METAL CONDUIT
○	PROPOSED STEEL SPAN POLE	EXISTING (R.M.C.) RIGID METAL CONDUIT
●	EXISTING STEEL SPAN POLE	EXISTING (R.M.C.) RIGID METAL CONDUIT
○	PROPOSED UTILITY POLE	EXISTING (R.M.C.) RIGID METAL CONDUIT
●	EXISTING UTILITY POLE	EXISTING (R.M.C.) RIGID METAL CONDUIT
□	EXISTING MOUNTING	EXISTING (R.M.C.) RIGID METAL CONDUIT
□	PEDESTRIAN MOUNTING	EXISTING (R.M.C.) RIGID METAL CONDUIT
□	PEDESTRIAN PUSH BUTTON & SIGN	EXISTING (R.M.C.) RIGID METAL CONDUIT
□	TRAFFIC SIGNAL FACE	EXISTING (R.M.C.) RIGID METAL CONDUIT
□	PEDESTRIAN SIGNAL FACE	EXISTING (R.M.C.) RIGID METAL CONDUIT
□	LOOP DETECTOR	EXISTING (R.M.C.) RIGID METAL CONDUIT
□	MAGNETIC DETECTOR	EXISTING (R.M.C.) RIGID METAL CONDUIT
□	SYSTEM DETECTOR	EXISTING (R.M.C.) RIGID METAL CONDUIT
□	OPTICAL DETECTOR	EXISTING (R.M.C.) RIGID METAL CONDUIT

STATE OF CONNECTICUT DEPARTMENT OF TRANSPORTATION
 BUR. OF ENGINEERING & HWY OPERATIONS
 DIVISION OF TRAFFIC ENGINEERING
 TRAFFIC CONTROL SIGNAL

TOWN OF WALLINGFORD
 ROUTE 15 N.B. OFF-RAMP AT
 QUINNIPIAC ST. AND RIVER RD.


REV #	DATE	TRAFFIC	ELECTRICAL
ENGINEER	JNT 5/96	AS	5/96
DRAFTER	MJC 5/96	MJC	5/96
CHECKED BY	PEW 5/96	JSS	5/96
SUBMITTED BY	CRM 6-3-96	MJC	6-3-96
APPROVED BY	VINCENT AVINO 6/4/96	D.P. McCALL	6-4-96

ORIGINAL SIGNED


F.H.W.A. REGION NO.	STATE	TOWN	FED. AID PROJ. NO.	PROJ. NO.	YEAR	ROUTE NO.	SHEET NO.	TOTAL SHEETS
1	CONN.	WALLINGFORD	DPM-0009(4)	148-156	1996	15	139A	

CONSTRUCTION NOTES

- ALL TRAFFIC SIGNAL EQUIPMENT IS NEW EXCEPT AS NOTED.
- STAKE ALL R.O.W. PRIOR TO EXCAVATION.
- LOOP DETECTORS D2A AND D2B ARE EXISTING.
- INSTALL LOOP DETECTORS 3' OFF EDGE OF ROAD AND 8' APART UNLESS OTHERWISE NOTED.
- INSTALL LOOP DETECTORS D1 IN CENTER OF LANE AND 8' APART.
- SEGMENTED LOOPS TO BE INSTALLED IN SERIES.
- INSTALL 30" X 30" HANDHOLE. ALL OTHERS TYPE II.
- INSTALL HANDHOLES APPROX. 1' BEHIND CURB OR EDGE OF ROAD UNLESS OTHERWISE SPECIFIED.
- INSTALL PEDESTAL ADJACENT TO SIDEWALK RAMP AT BACK EDGE.
- INSTALL DISCONNECT BOX IN PLACE OF FLASHER CABINET.
- REPLACE ENTIRE SECTION OF SIDEWALK DAMAGED DUE TO INSTALLATION OF CONDUIT, HANDHOLE OR FOUNDATION.
- CABINET DOOR TO OPEN FIELD SIDE.
- REMOVE ALL ABANDONED TRAFFIC SIGNAL EQUIPMENT INCLUDING, BUT NOT LIMITED TO FOUNDATIONS, HANDHOLES, CONDUIT RISERS & CABLE, MESSENGER & INTERCONNECT, STEEL POLES, AND WOOD POLES.
- TRAFFIC SIGNAL CABLE CLOSURE SHALL BE INSTALLED ON THE SPAN ± 5' FROM THE CURBLINE.
- TWO WEEKS PRIOR TO INSTALLATION CONTACT WALLINGFORD ELECTRICAL DIVISION REPRESENTATIVE ART DUTRA AT (203) 265-0308 AND SNET REPRESENTATIVE LEROY WALKER AT (860) 725-4514.

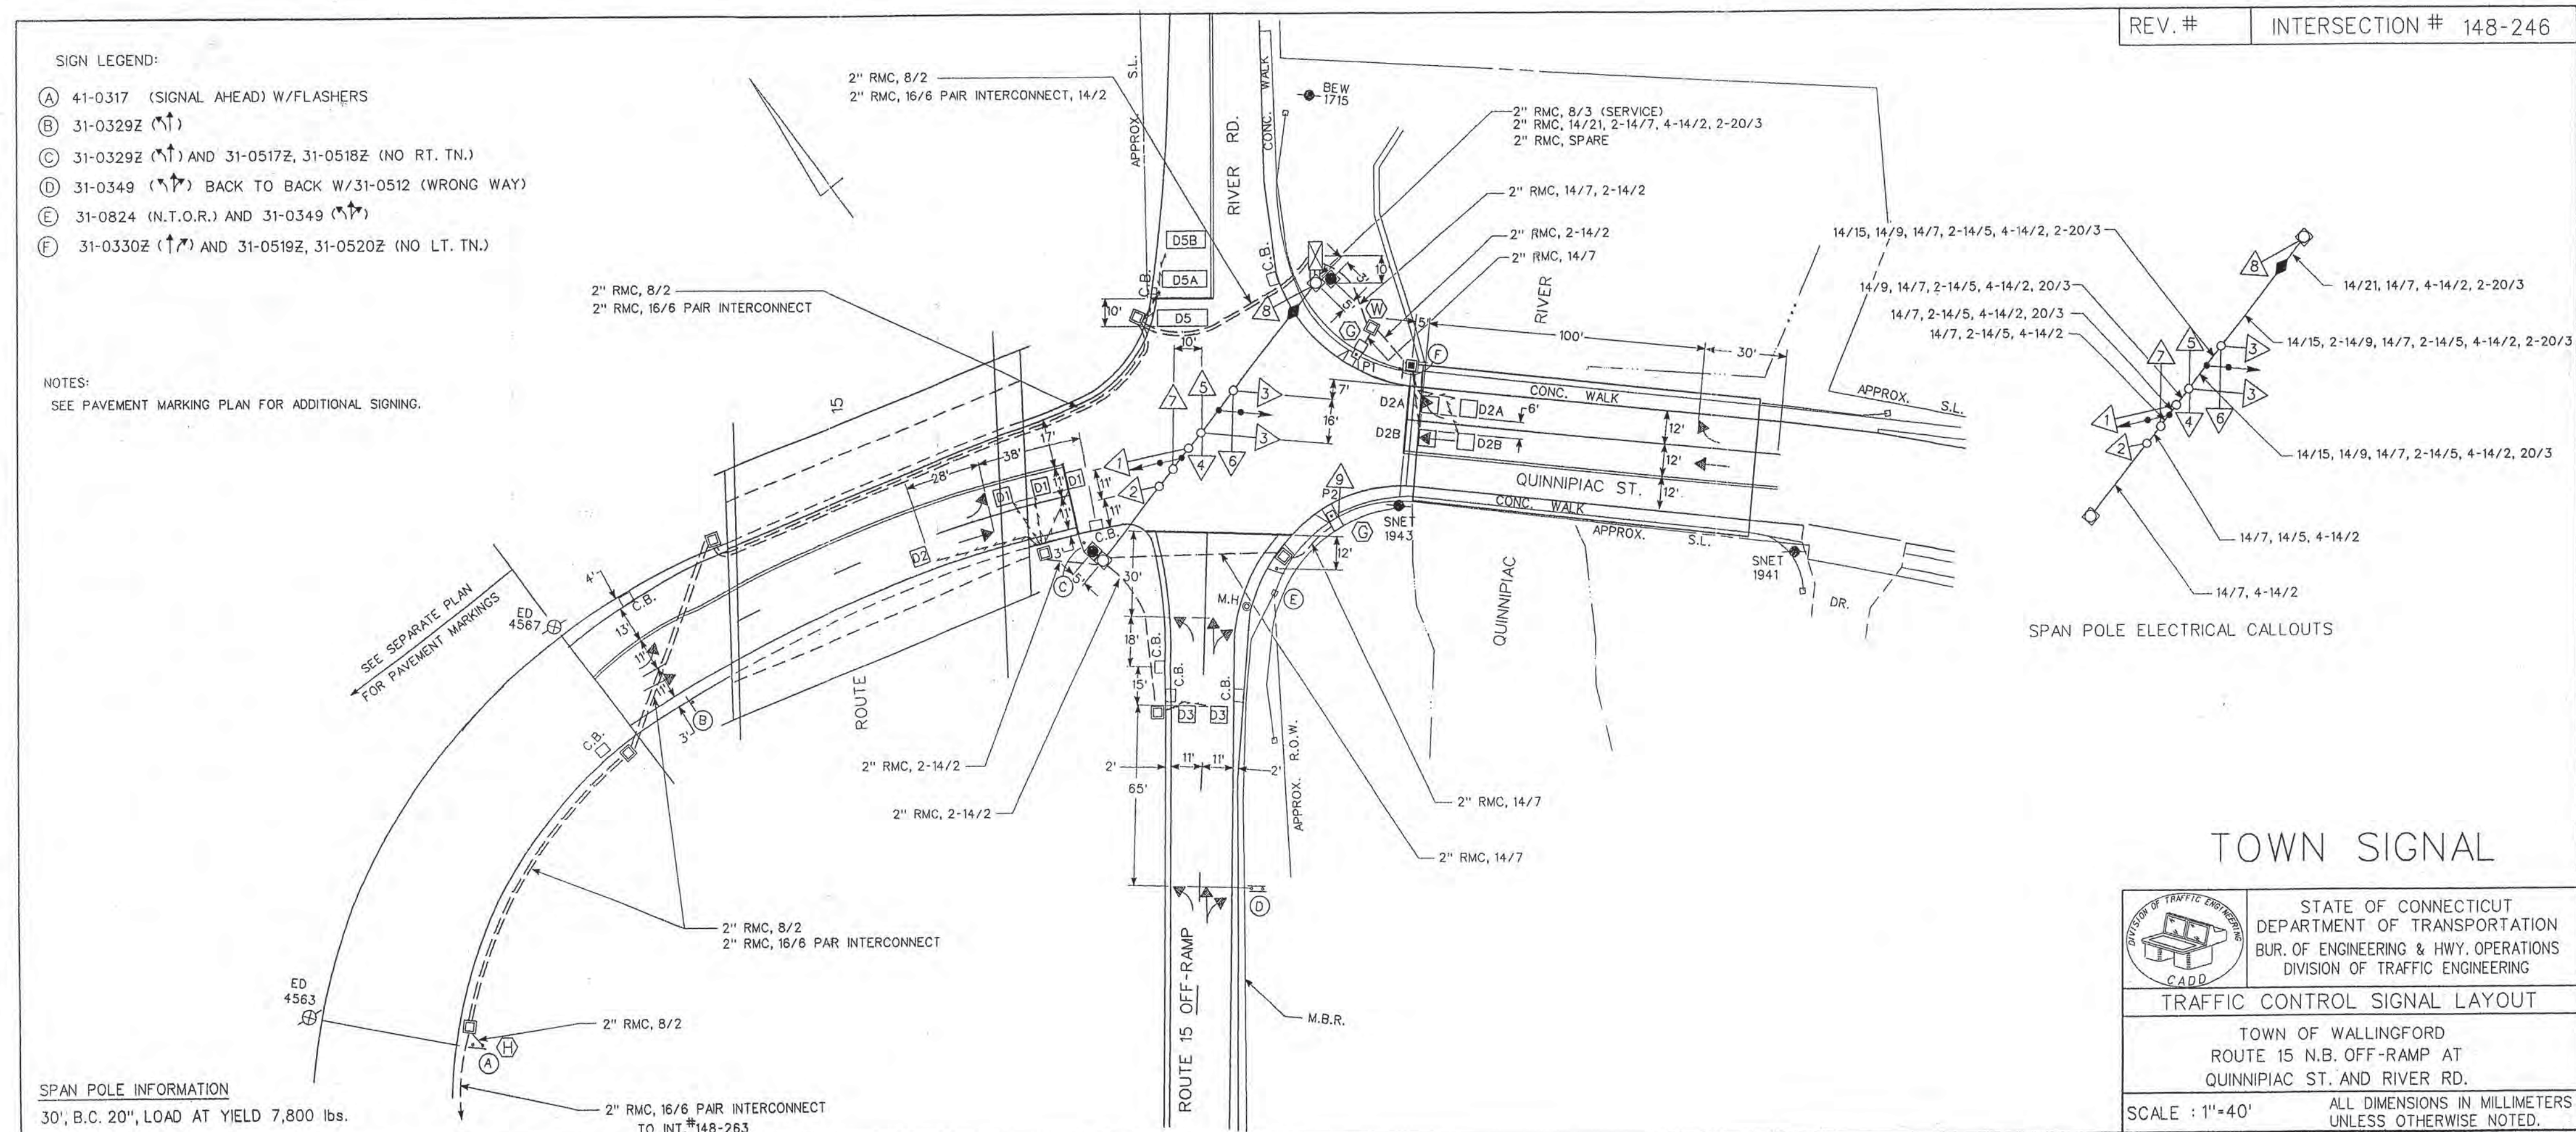



- PRE-EMPTION IS TO OPERATE THROUGH THE INTERNAL PRE-EMPTION OF THE SIGNAL CONTROLLER.
- THE CONTRACTOR IS TO INSTALL A SWITCH IN THE SIGNAL CABINET TO EFFECTIVELY DISCONNECT THE PRE-EMPTION EQUIPMENT FROM THE TRAFFIC SIGNAL CONTROLLER.
- OPTICAL DETECTOR LOCATIONS ON SPAN WIRE ARE FOR ILLUSTRATION ONLY. EXACT LOCATIONS SHALL BE DETERMINED BY THE MANUFACTURER OR HIS DESIGNATED REPRESENTATIVE.
- CONTRACTOR TO INITIALLY INSTALL PAVEMENT MARKINGS AS INDICATED BELOW:
 - ALL PAVEMENT MARKINGS ON ROUTE 15 OFF RAMP
 - ALL PAVEMENT MARKINGS ON QUINNIPIAC ST. EASTBOUND APPROACH.

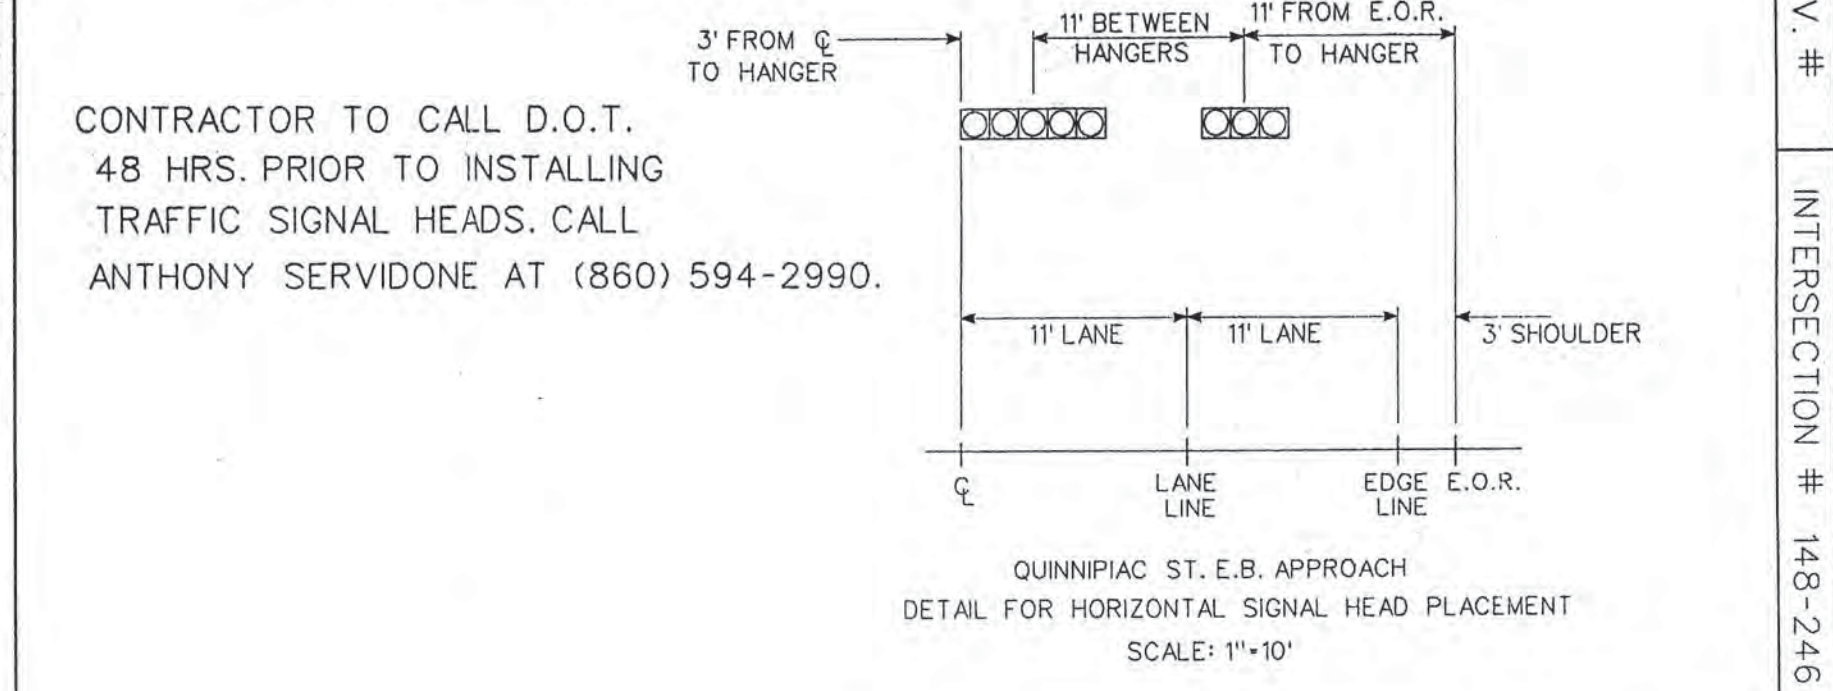



REVISIONS			
NO.	DATE	INIT.	DESCRIPTION
A	6/98	PEW	REVISED OFFSETS DUE TO REVISED PHASING OF ADJACENT SIGNAL 148-263

STATE OF CONNECTICUT DEPARTMENT OF TRANSPORTATION
 BUREAU OF ENGINEERING & HIGHWAY OPERATIONS
 DIVISION OF TRAFFIC ENGINEERING

TRAFFIC CONTROL SIGNAL

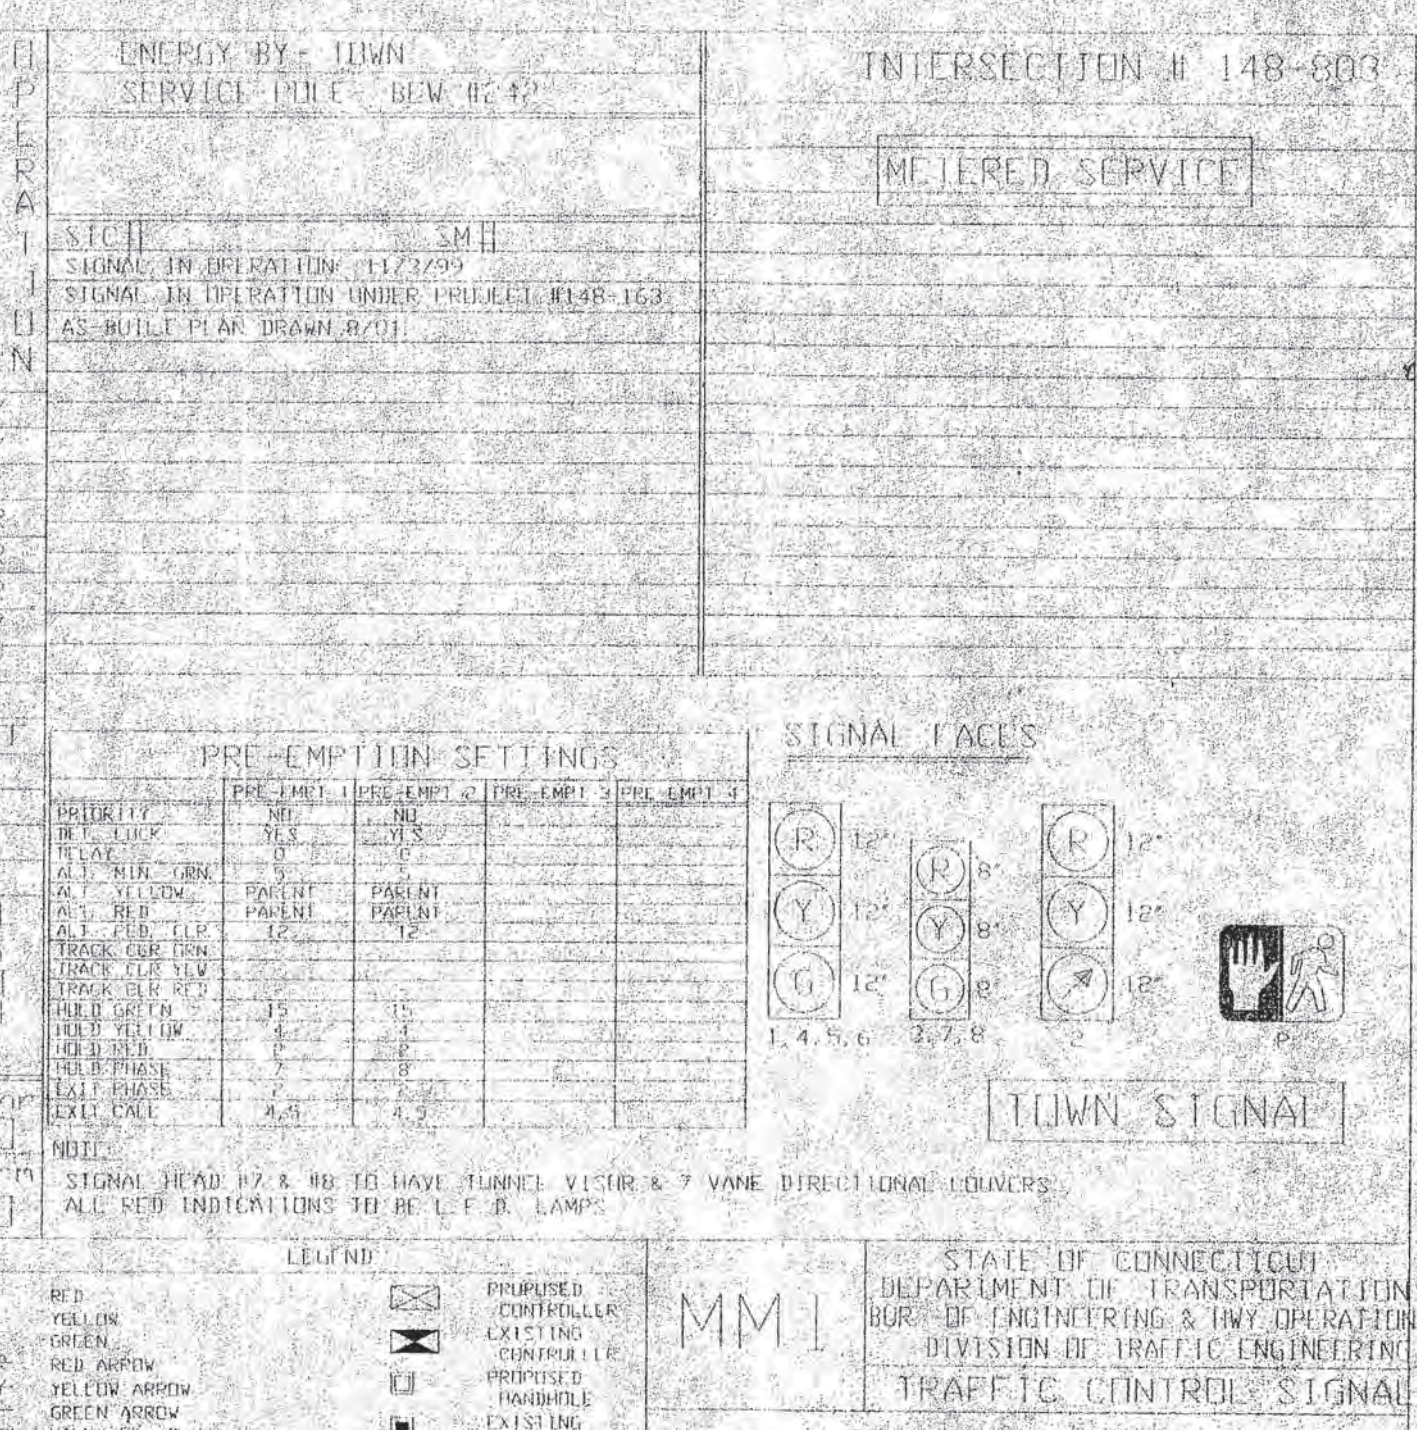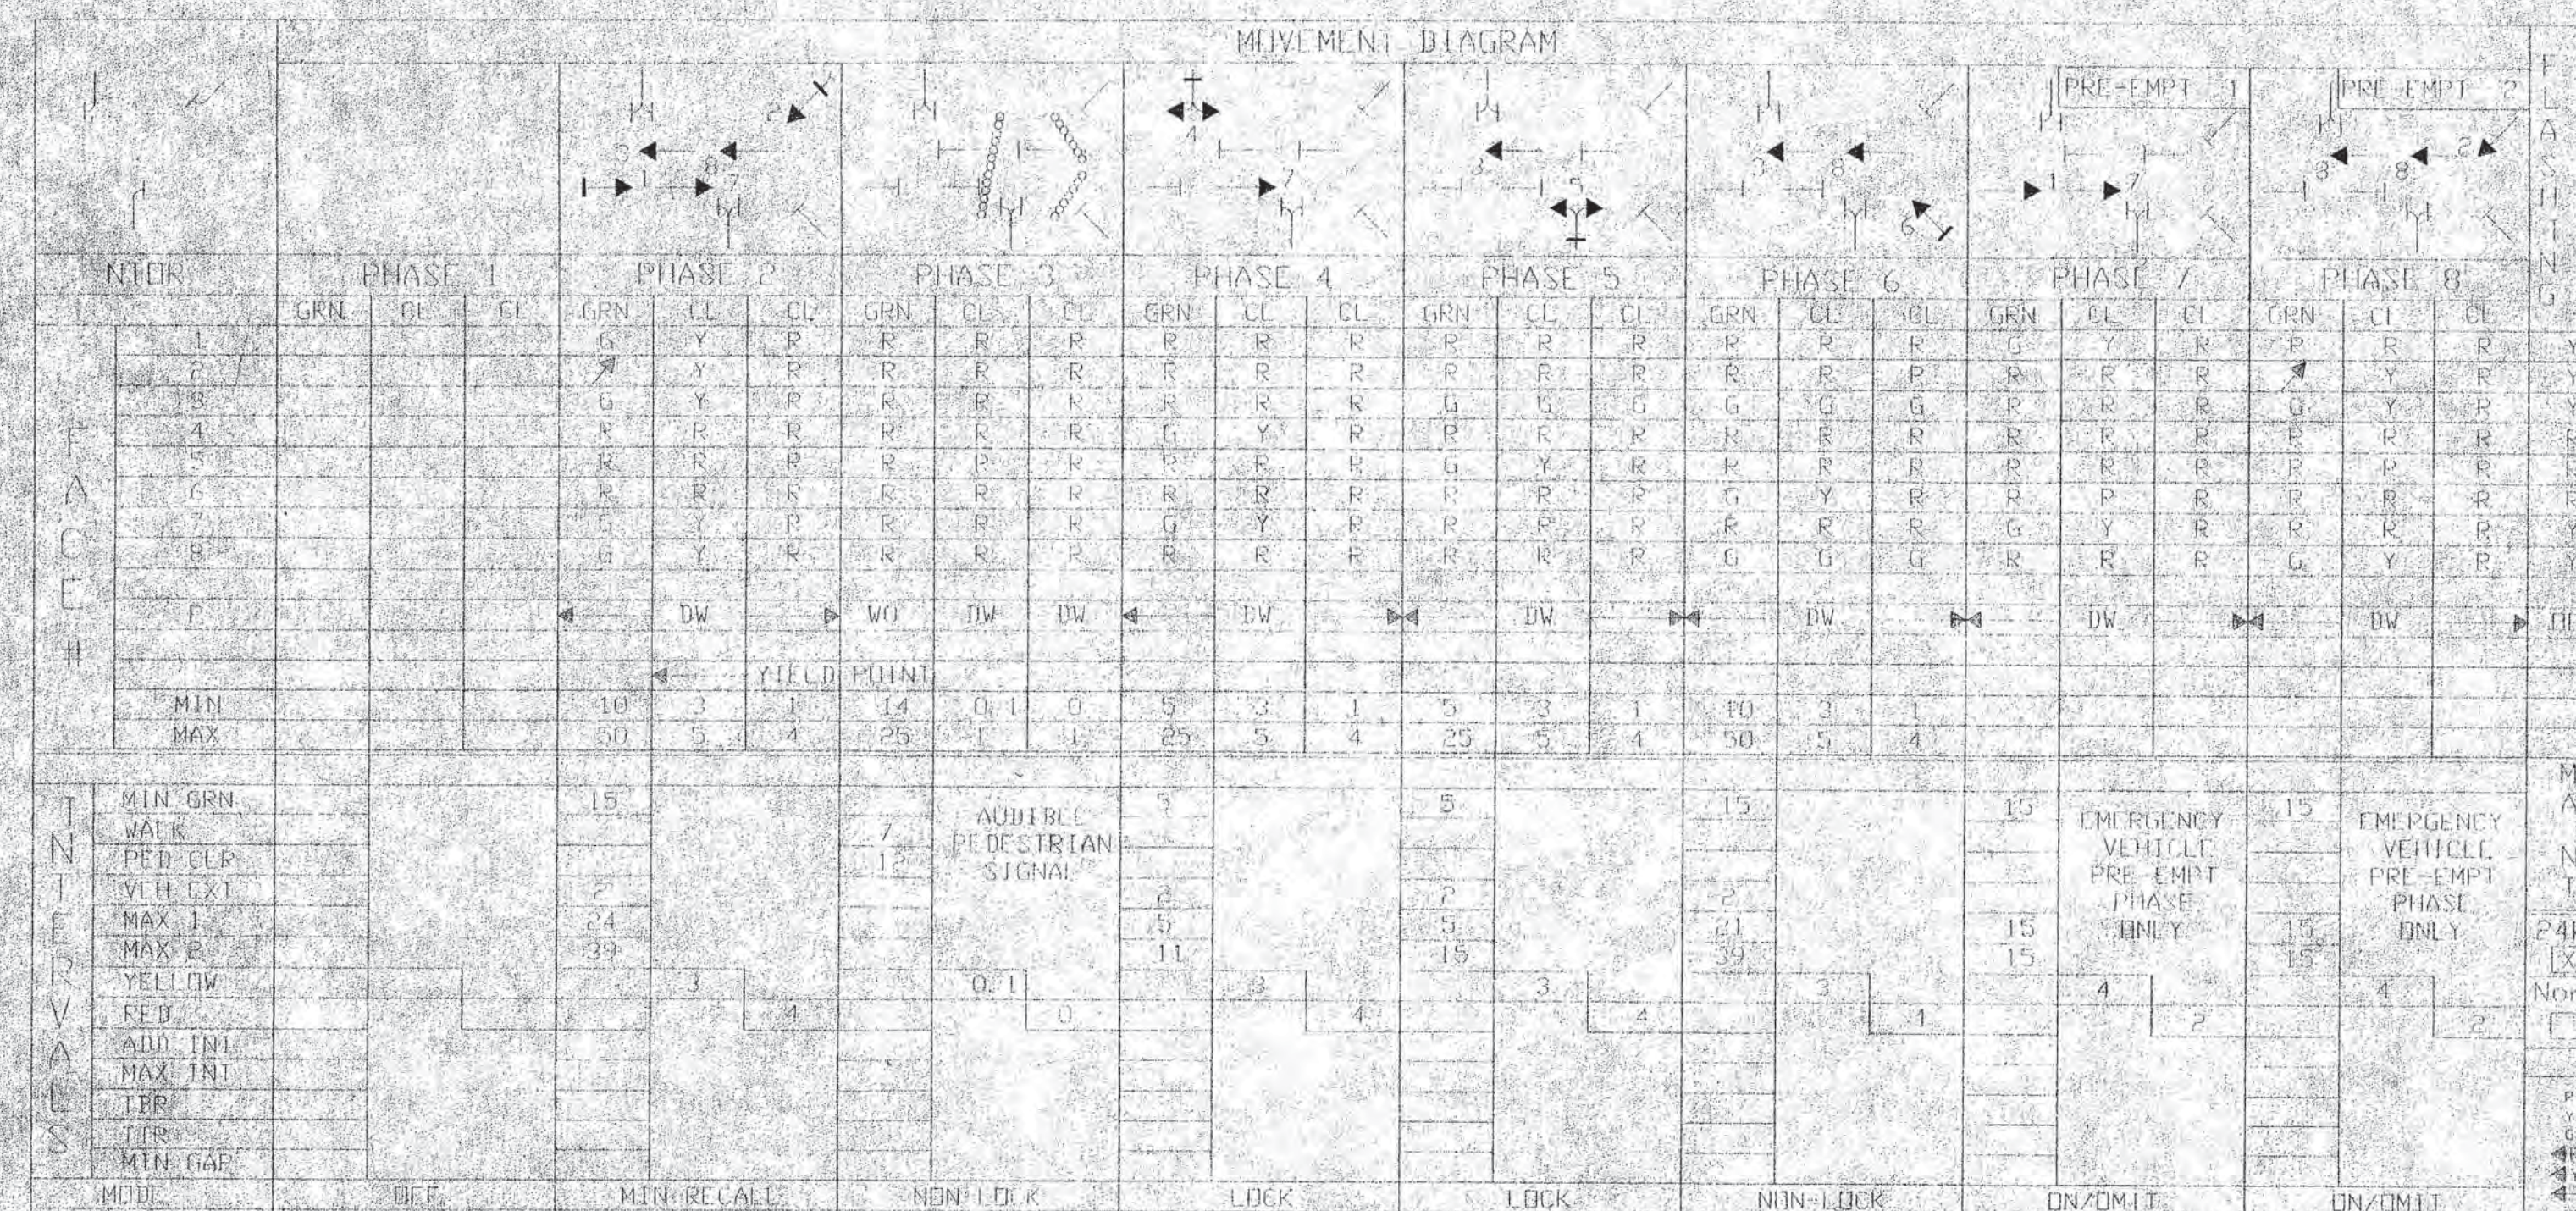

DETECTOR	SIZE	SENS	MODE	FUNCTION	PROGRAM	DAY	COORDINATION	TYPE	CLOSED LOOP	SYSTEM	TECHNICAL NOTES
D2A	6' X 10'	3	PRESENCE	FLASH	EMERGENCY	ONE				148-234	STANDARD OVERLAP SKIP FEATURES APPLY
D2B	6' X 10'	3	PRESENCE	MAX 2	ALL TIMES	FUTURE				148-203	PHASE 8 TO CALL THE PEDESTRIAN BUZZER
D2C	6' X 6'	4	PRESENCE	PATTERN 1	0200-0900, 1500-1800	ROOM-F	85	46	54%	148-802	TIMINGS SHOWN INDICATE TRIP OPERATION. ACTUAL TIMINGS TO BE CONTROLLED BY CLOSED LOOP LOCAL COORDINATION ONLY
D4A	6' X 10'	3	PRESENCE	FRG	ALL OTHER LANE	DAILY				148-240	EMERGENCY VEHICLE PRE-EMPT TO BE INOPERATIVE DURING FLASHING OPERATION.
D4B	6' X 6'	4	PRESENCE							148-218	PHASE 2 DETECTORS TO BE INOPERATIVE DURING COORDINATION
D5A	6' X 10'	3	PRESENCE							148-217	UNUSED TIME TO BE REALLOCATED.
D5B	6' X 6'	4	PRESENCE								
D6A	6' X 6'	4	PRESENCE								
D6B	6' X 6'	4	PRESENCE								

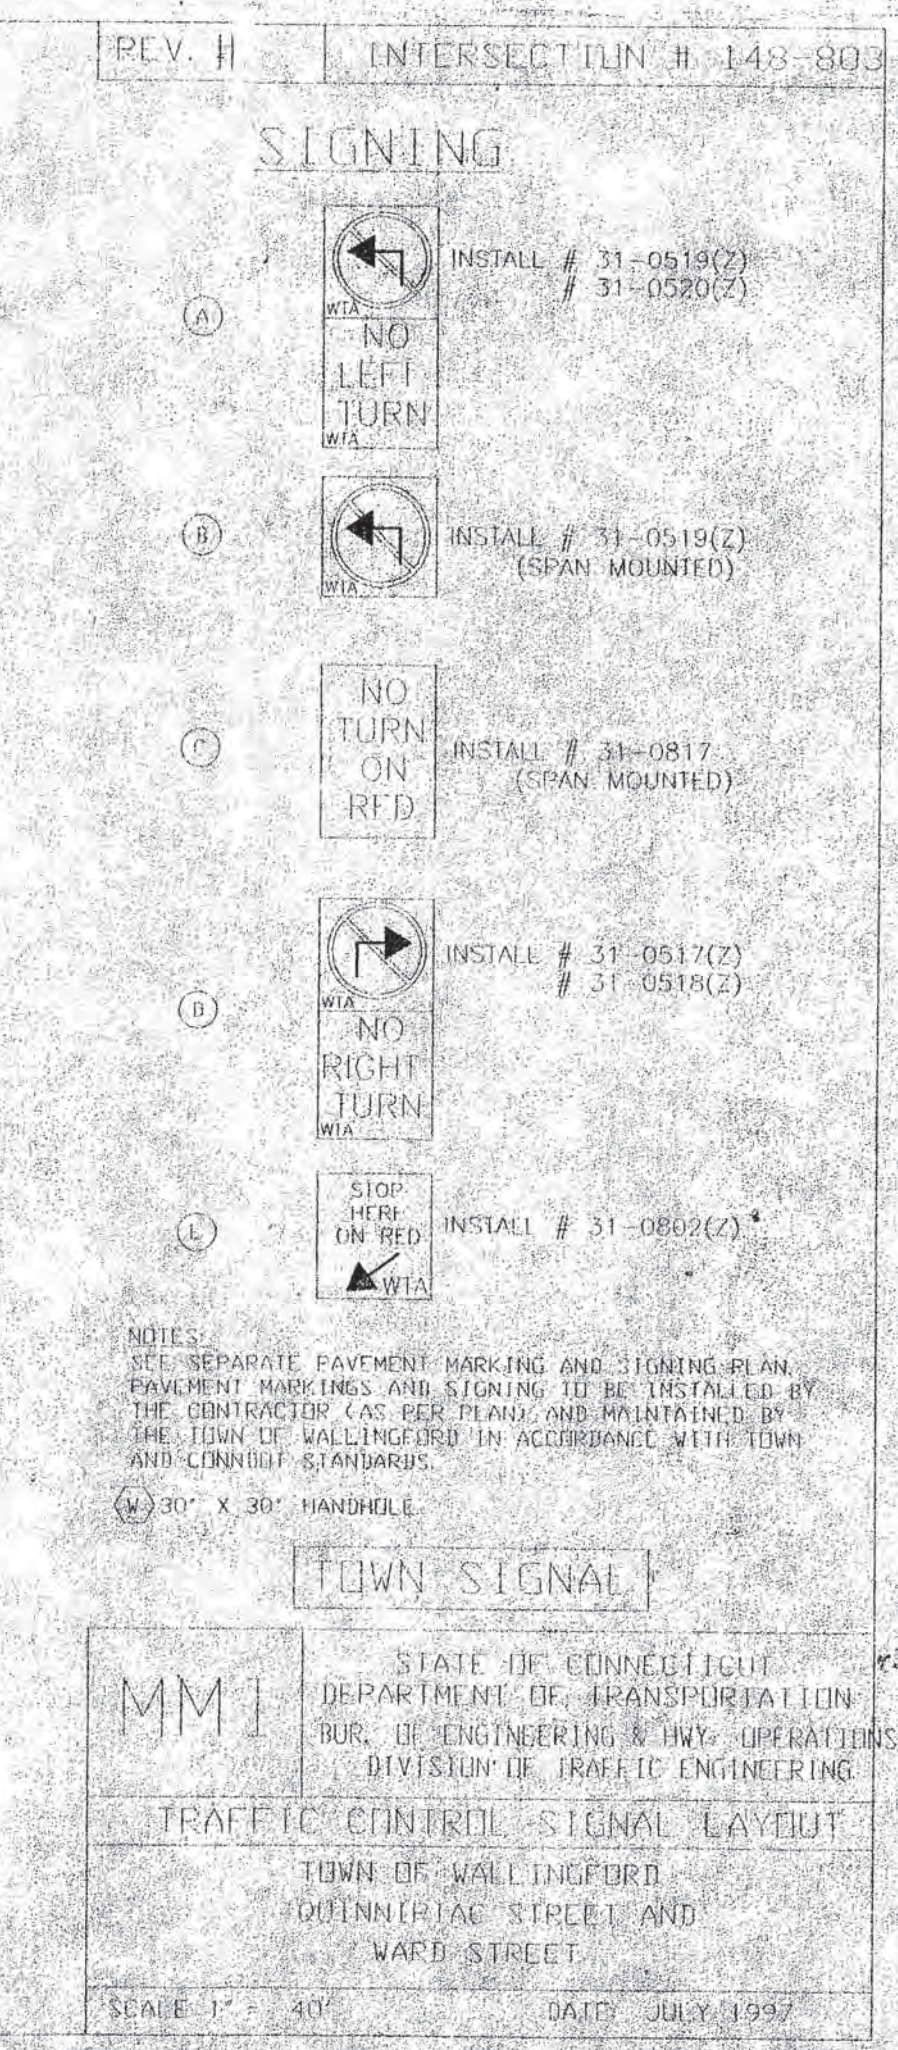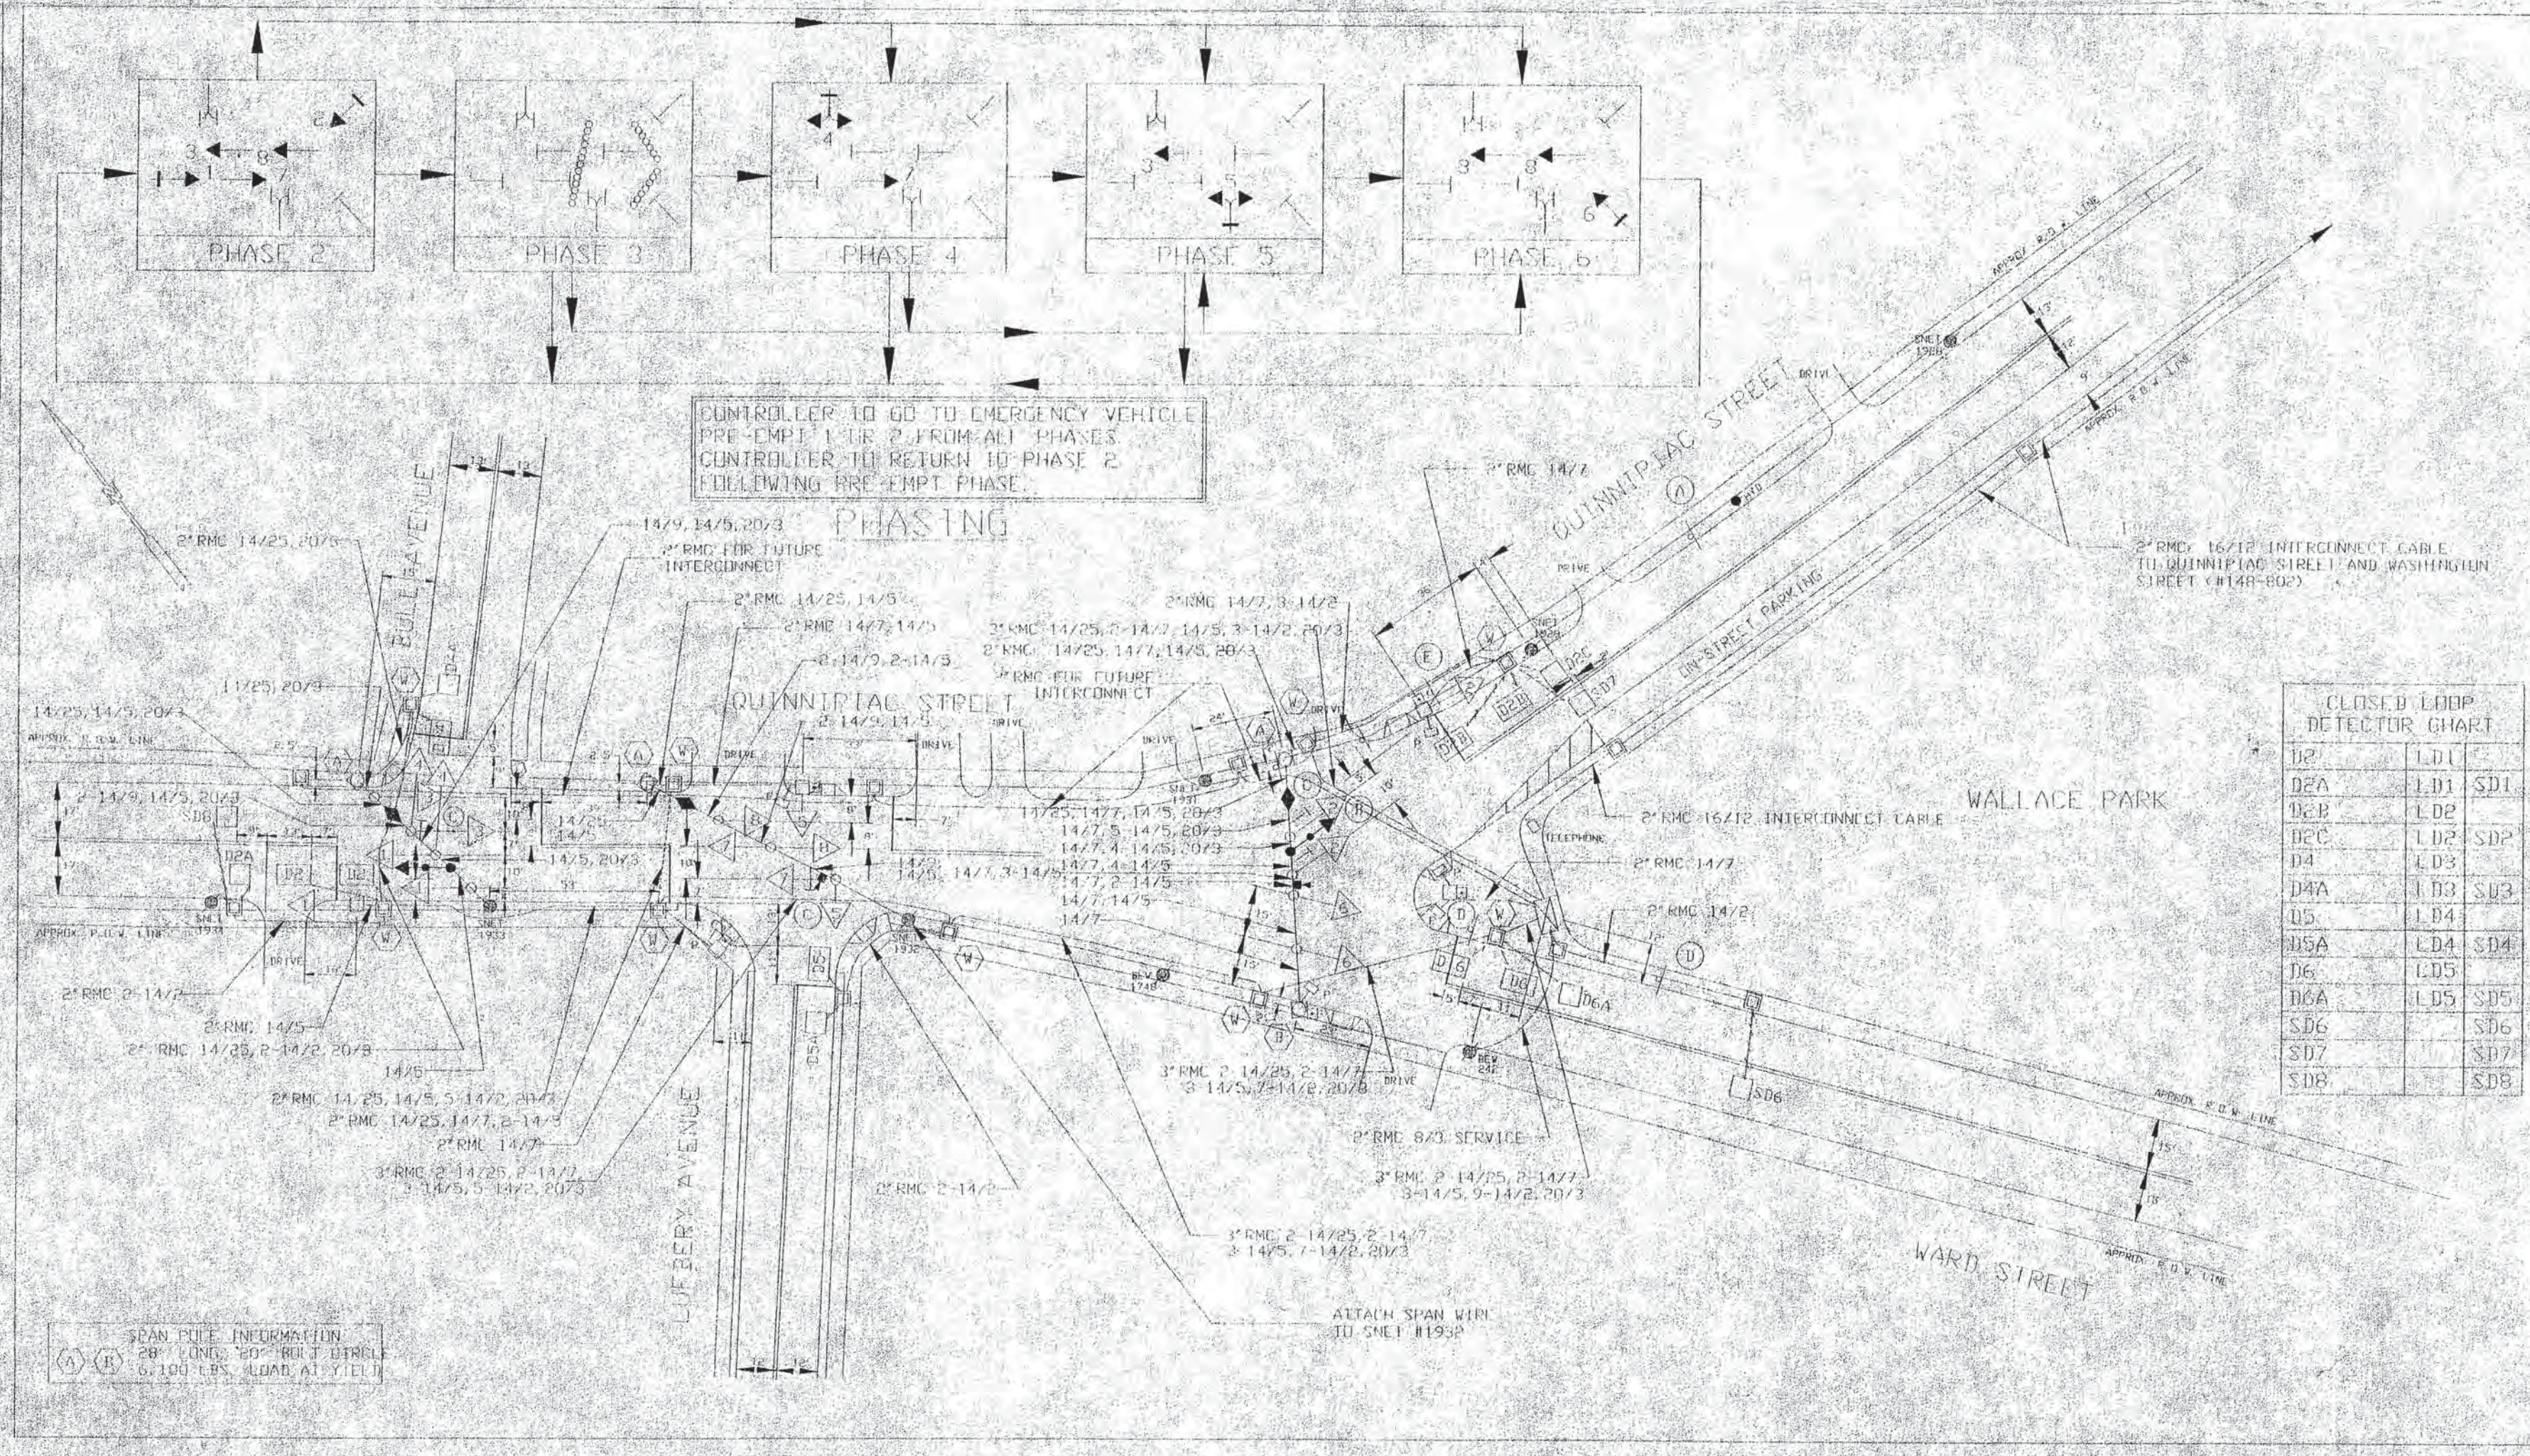

CONSTRUCTION NOTES

- ALL TRAFFIC CONTROL EQUIPMENT UNLESS OTHERWISE NOTED IS NEW. ALL MATERIALS AND EQUIPMENT SHALL CONFORM TO THE FORM 814A AND AS AMENDED. ALL NEW TRAFFIC CONTROL EQUIPMENT SHALL BE FIELD LOCATED AND APPROVED BY THE ENGINEER AND THE TOWN PRIOR TO CONSTRUCTION.
- ALL CABLEING SHALL BE #12 AND INSTALLED WITHOUT SPLICERS.
- SPAN WIRE SHALL BE 3/8" X 1/2" DIA. EXTRA STRENGTH 15,400 LBS. MAXIMUM BREAKING STRENGTH.
- TYPE 3 PEDESTRIAN SIDEWALK RAMP.
- CONTRACTOR SHALL CONTACT "CALL BEFORE YOU DIG" 1-800-929-4459 PRIOR TO ANY EXCAVATION.
- ALL WORK TO BE COORDINATED WITH THE TOWN OF WALLINGFORD POLICE DEPARTMENT. CONTACT OFFICER R. A. BULL 294-2200.
- THE CONTRACTOR WILL SCHEDULE HIS CONSTRUCTION WORK SO THAT POSITIVE TRAFFIC CONTROL (STOP SIGNS, TEMPORARY SIGNALS, ETC.) ARE IN PLACE AND OPERATIONAL AT ALL TIMES.
- THE CONTRACTOR SHALL SUPPLY, INSTALL AND MAKE FULLY OPERATIONAL THE FOLLOWING:
 - 26" STEEL SPAN POLE ON STANDARD SPAN POLE FOUNDATION.
 - 28" STEEL SPAN POLE ON STANDARD SPAN POLE FOUNDATION WITH POLE MOUNTED ADA APPROVED PUSH BUTTON AND SIGN ASSEMBLY, AND 2 ONE-WAY PEDESTRIAN SIGNAL.
 - INSTALL TOWN APPROVED (STANDARD) FULL ACTUATED 6 PHASE (MASTER) CONTROLLER ON NEW TYPE IV CONTROLLER FOUNDATION. CONTROLLER SHALL BE EQUIPPED WITH INTERNAL EMERGENCY VEHICLE PRE-EMPT CAPABILITY. THE CONTROLLER SHALL BE EQUIPPED WITH ALL NECESSARY AND FOR FUTURE COMPONENTS AND INTERNAL COMMUNICATION MODULES FOR INCLUSION IN AND FULL COMPATIBILITY WITH THE TOWN'S EXISTING CLOSED LOOP TRAFFIC SIGNAL SYSTEM. THE CONTROLLER TYPE IV CABINET SHALL BE EQUIPPED WITH A WALLINGFORD ELECTRIC DIVISION APPROVED METER SOCKET, AND A WEATHERPROOF DISCONNECT.
 - INSTALL 8'-0" ALUMINUM PEDESTAL ON TYPE I PEDESTAL FOUNDATION WITH ADA APPROVED PUSH BUTTON AND SIGN ASSEMBLY AND TWO-WAY PEDESTRIAN SIGNAL.
 - INSTALL 8'-0" ALUMINUM PEDESTAL ON TYPE I PEDESTAL FOUNDATION WITH ADA APPROVED PUSH BUTTON AND SIGN ASSEMBLY AND ONE-WAY PEDESTRIAN SIGNAL.
 - INSTALL TYPE II HANDHOLES, CYCLICALLY 1'-0" FROM NEW CURB UNLESS OTHERWISE NOTED.
 - INSTALL 10'-0" ALUMINUM PEDESTAL WITH ONE-WAY VEHICULAR TRAFFIC SIGNAL.
 - INSTALL 10'-0" ALUMINUM PEDESTAL WITH ONE-WAY VEHICULAR TRAFFIC SIGNAL AND ADA APPROVED PUSH BUTTON AND SIGN ASSEMBLY AND ONE-WAY PEDESTRIAN SIGNAL.
 - INSTALL TOWN/STATE APPROVED AUDIBLE PEDESTRIAN SIGNAL WITH ADJUSTABLE FREQUENCY IN CONTROLLER CABINET.
 - INSTALL 2" FMC FOR TRAFFIC CONTROL. COORDINATE EXACT LOCATION WITH OTHERS PERFORMING SIDEWALK AND LIGHTING WORK IN PARK.
 - INSTALL 18" X 24" SECONDARY OFFICE BOX (SFB) METAL PROVIDED IN THE ORNAMENTAL LIGHT STAND.
 - INSTALL 30" X 30" CONCRETE HANDHOLE (ALL OTHERS TO BE TYPE III).
- ELECTRICAL SERVICE TO THE CONTROLLER SHALL BE COORDINATED WITH THE WALLINGFORD ELECTRICAL DIVISION. CONTRACTOR SHALL PAY ALL FEES AND COSTS FOR OBTAINING CENTRAL TAP OFF FROM AT WALLINGFORD ELECTRICAL DIVISION (203) 269-2200 TO COORDINATE.
- THE OPTICUM RECEIVERS SHALL BE MOUNTED MIN SPAN IN ACCORDANCE WITH THE MANUFACTURER'S RECOMMENDATION, AND SHALL BE APPROVED BY AN AUTHORIZED REPRESENTATIVE OF 3M PRIOR TO INSTALLATION OR TURN-ON. A SEPARATE 20/3 CABLE FOR EACH OPTICAL DETECTOR SHALL BE INSTALLED UNAMPLIFIED DIRECTLY TO THE CONTROLLER CABINET.
- ALL SIGNALS SHALL BE HUNG SO THAT A MINIMUM VERTICAL CLEARANCE OF 16 FEET (4.88 METERS) IS MAINTAINED BETWEEN THE FINAL ROADWAY SURFACE AND THE BOTTOM OF THE SIGNALS.
- INSTALL LOOP DETECTORS IN BASE COURSE OF NEW PAVEMENT, CENTER OF LANE AND 8' (2.438 METERS) APART UNLESS OTHERWISE NOTED. SEGMENTED LINES TO BE SPACED IN SERIES.
- INSTALL TRAFFIC SIGNAL CABLE CLOSURE ON SPAN 5 FEET FROM CURBLINE.
- INSTALL RMC STAND-OFF ON UTILITY POLE BSW 11749. INSTALL POLE MOUNTED SERVICE DISCONNECT 10 FEET ABOVE THE GROUND ON POLE BSW 11749.
- CONTACT NEILD UTILITY COMPANY A MINIMUM OF TWO (2) WEEKS PRIOR TO CONSTRUCTION.
- ALL TRAFFIC SIGNAL WORK SHALL BE CONSTRUCTED IN ACCORDANCE WITH CONDUIT AND WALLINGFORD'S STANDARDS.
- THE TRAFFIC SIGNAL CONTRACTOR SHALL COORDINATE THE PLACEMENT OF THE NEW TRAFFIC CONTROL APPURTENANCES AT WALLACE PARK WITH OTHERS WHO MAY BE WORKING IN THE SAME AREA.
- ATTACH SPANWIRE TO UTILITY POLE SNET 11232 AT APPROXIMATELY 24.5 FEET ABOVE THE GROUND AND UTILITY POLE SNET 11932 AT APPROXIMATELY 23.0 FEET ABOVE THE GROUND.
- ANCHOR BOLTS FOR POLE FOUNDATIONS SHALL BE SET SQUARE TO THE SPAN POLE SURFACE THAT TWO BOLTS ARE IN TENSION AND TWO ARE IN COMPRESSION.
- CONTRACTOR TO COORDINATE WITH WALLINGFORD ELECTRIC DIVISION TO PROVIDE BACK GAYS AND ANCHORS TO POLES WED 11932 AND 1993 FOR SPAN INSTALLATION.


UTILITY/PROJECT CONTACTS:
 TOWN OF WALLINGFORD R. A. BULL 294-2250
 SNET - BOB DOUTARD (800) 749-1693
 A&T - BOB TARTINI (203) 269-2565
 WALLINGFORD ELECTRIC - ART BUTRA (203) 269-0035
 TCI CABLE - ADAM BULK (203) 493-2300
 DESIGNER: M.M.E. JOHN P. THOMPSON (203) 271-7730

STATE OF CONNECTICUT
 DEPARTMENT OF TRANSPORTATION
 BUREAU OF ENGINEERING & HIGHWAY OPERATIONS
 DIVISION OF TRAFFIC ENGINEERING

OWNERS NAME
 TOWN OF WALLINGFORD

QUINNIPIAC ST. & WARD ST.
 TRAFFIC CONTROL SIGNAL

MMI DEPARTMENT OF TRANSPORTATION
 BUREAU OF ENGINEERING & HIGHWAY OPERATIONS
 DIVISION OF TRAFFIC ENGINEERING
 TOWN OF WALLINGFORD
 QUINNIPIAC STREET AND WARD STREET
 SCALE 1" = 40' DATE: JULY 1997


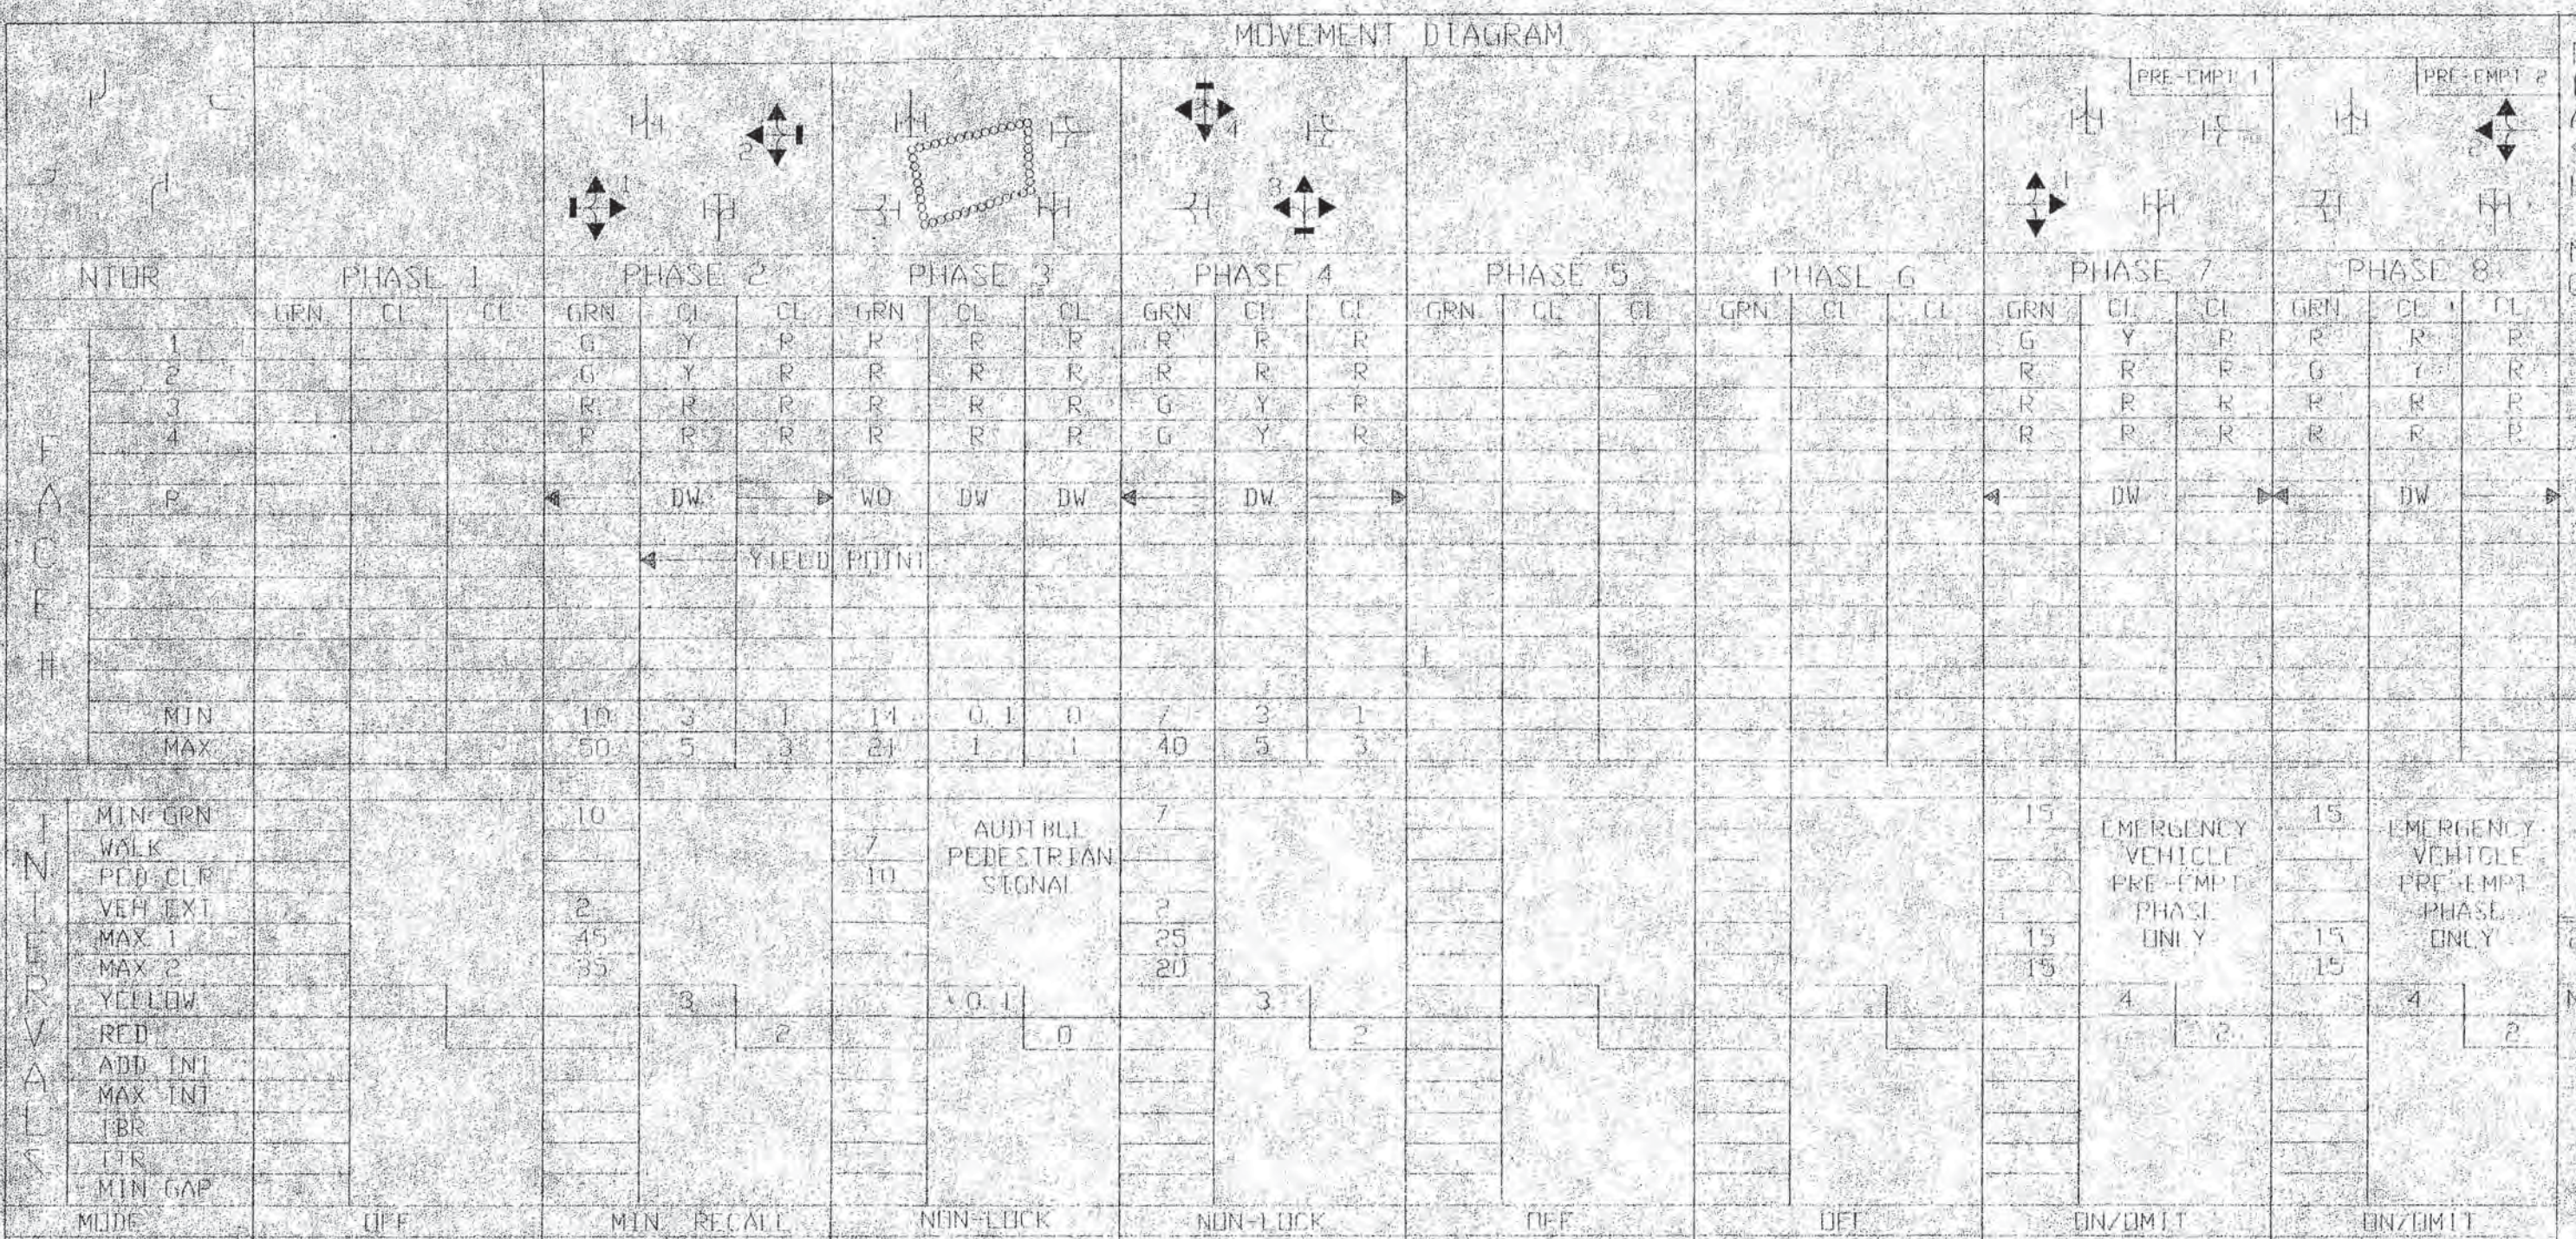


PHASE	GRN	YEL	RED	PRE-EMPT
PHASE 1	10	3	11	
PHASE 2	14	0	0	7
PHASE 3	1	1	40	3
PHASE 4	7	3	1	
PHASE 5				15
PHASE 6				15
PHASE 7				15
PHASE 8				15

DETECTORS	PROGRAM	COORDINATION	TYPE	CLOSED LOOP
D01 6' X 10'	PHASE 1	EMERGENCY	ONLY	
D02 6' X 6'	PHASE 2	ALL TIMES		
D03 6' X 10'	PHASE 3	FUTURE		
D04 6' X 6'	PHASE 4	0700-0900, 1300-1800	DAILY	
D05 6' X 10'	PHASE 5	ALL OTHER TIMES	DAILY	
D06 6' X 6'	PHASE 6	FREE	DAILY	
D07 6' X 10'	PHASE 7	FREE	DAILY	
D08 6' X 6'	PHASE 8	FREE	DAILY	

SYSTEM	MASTER	SLAVE
148-234		
148-205		
148-803		
148-804		
148-240		
148-218		
148-217		

TECHNICAL NOTES: STANDARD OVERLAP SKIP FEATURES APPLY. PEDESTRIAN ACTIVATION OF PHASE 3 TO CALL FOR PEDESTRIAN BUZZER. TIMINGS SHOWN INDICATE FREE OPERATION. ACTUAL TIMINGS TO BE CONTROLLED BY THE CLOSED LOOP COORDINATION UNIT. EMERGENCY VEHICLE PRE-EMPTION TO BE INOPERATIVE DURING FLASHING OPERATION. PHASE 2 DETECTORS TO BE INOPERATIVE DURING COORDINATION. PHASE 1 TO BE REACTIVATED.

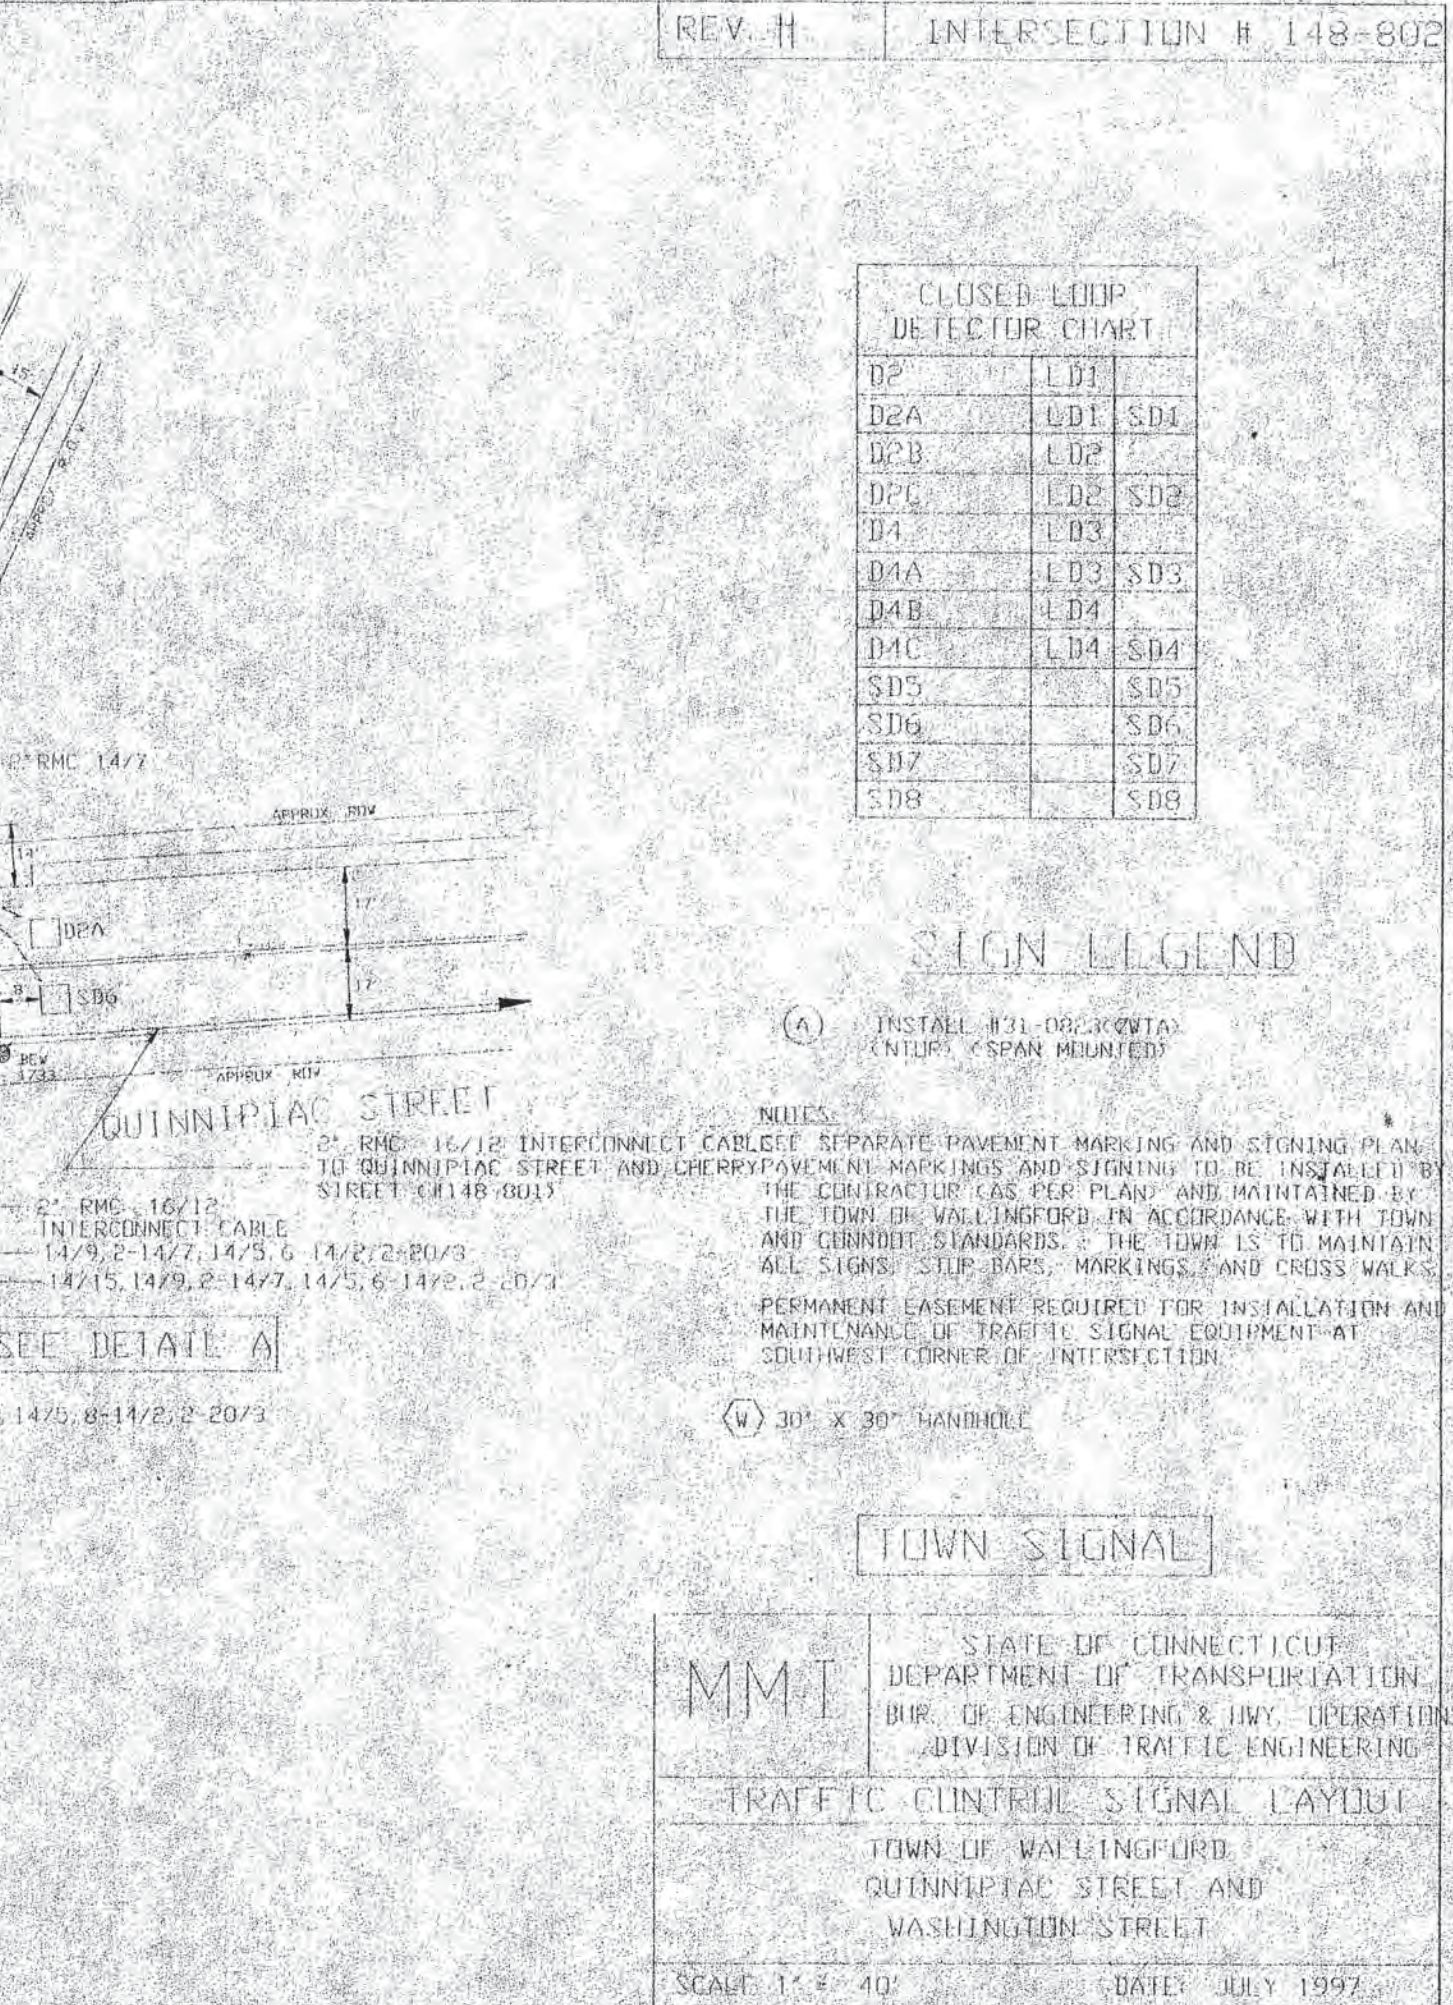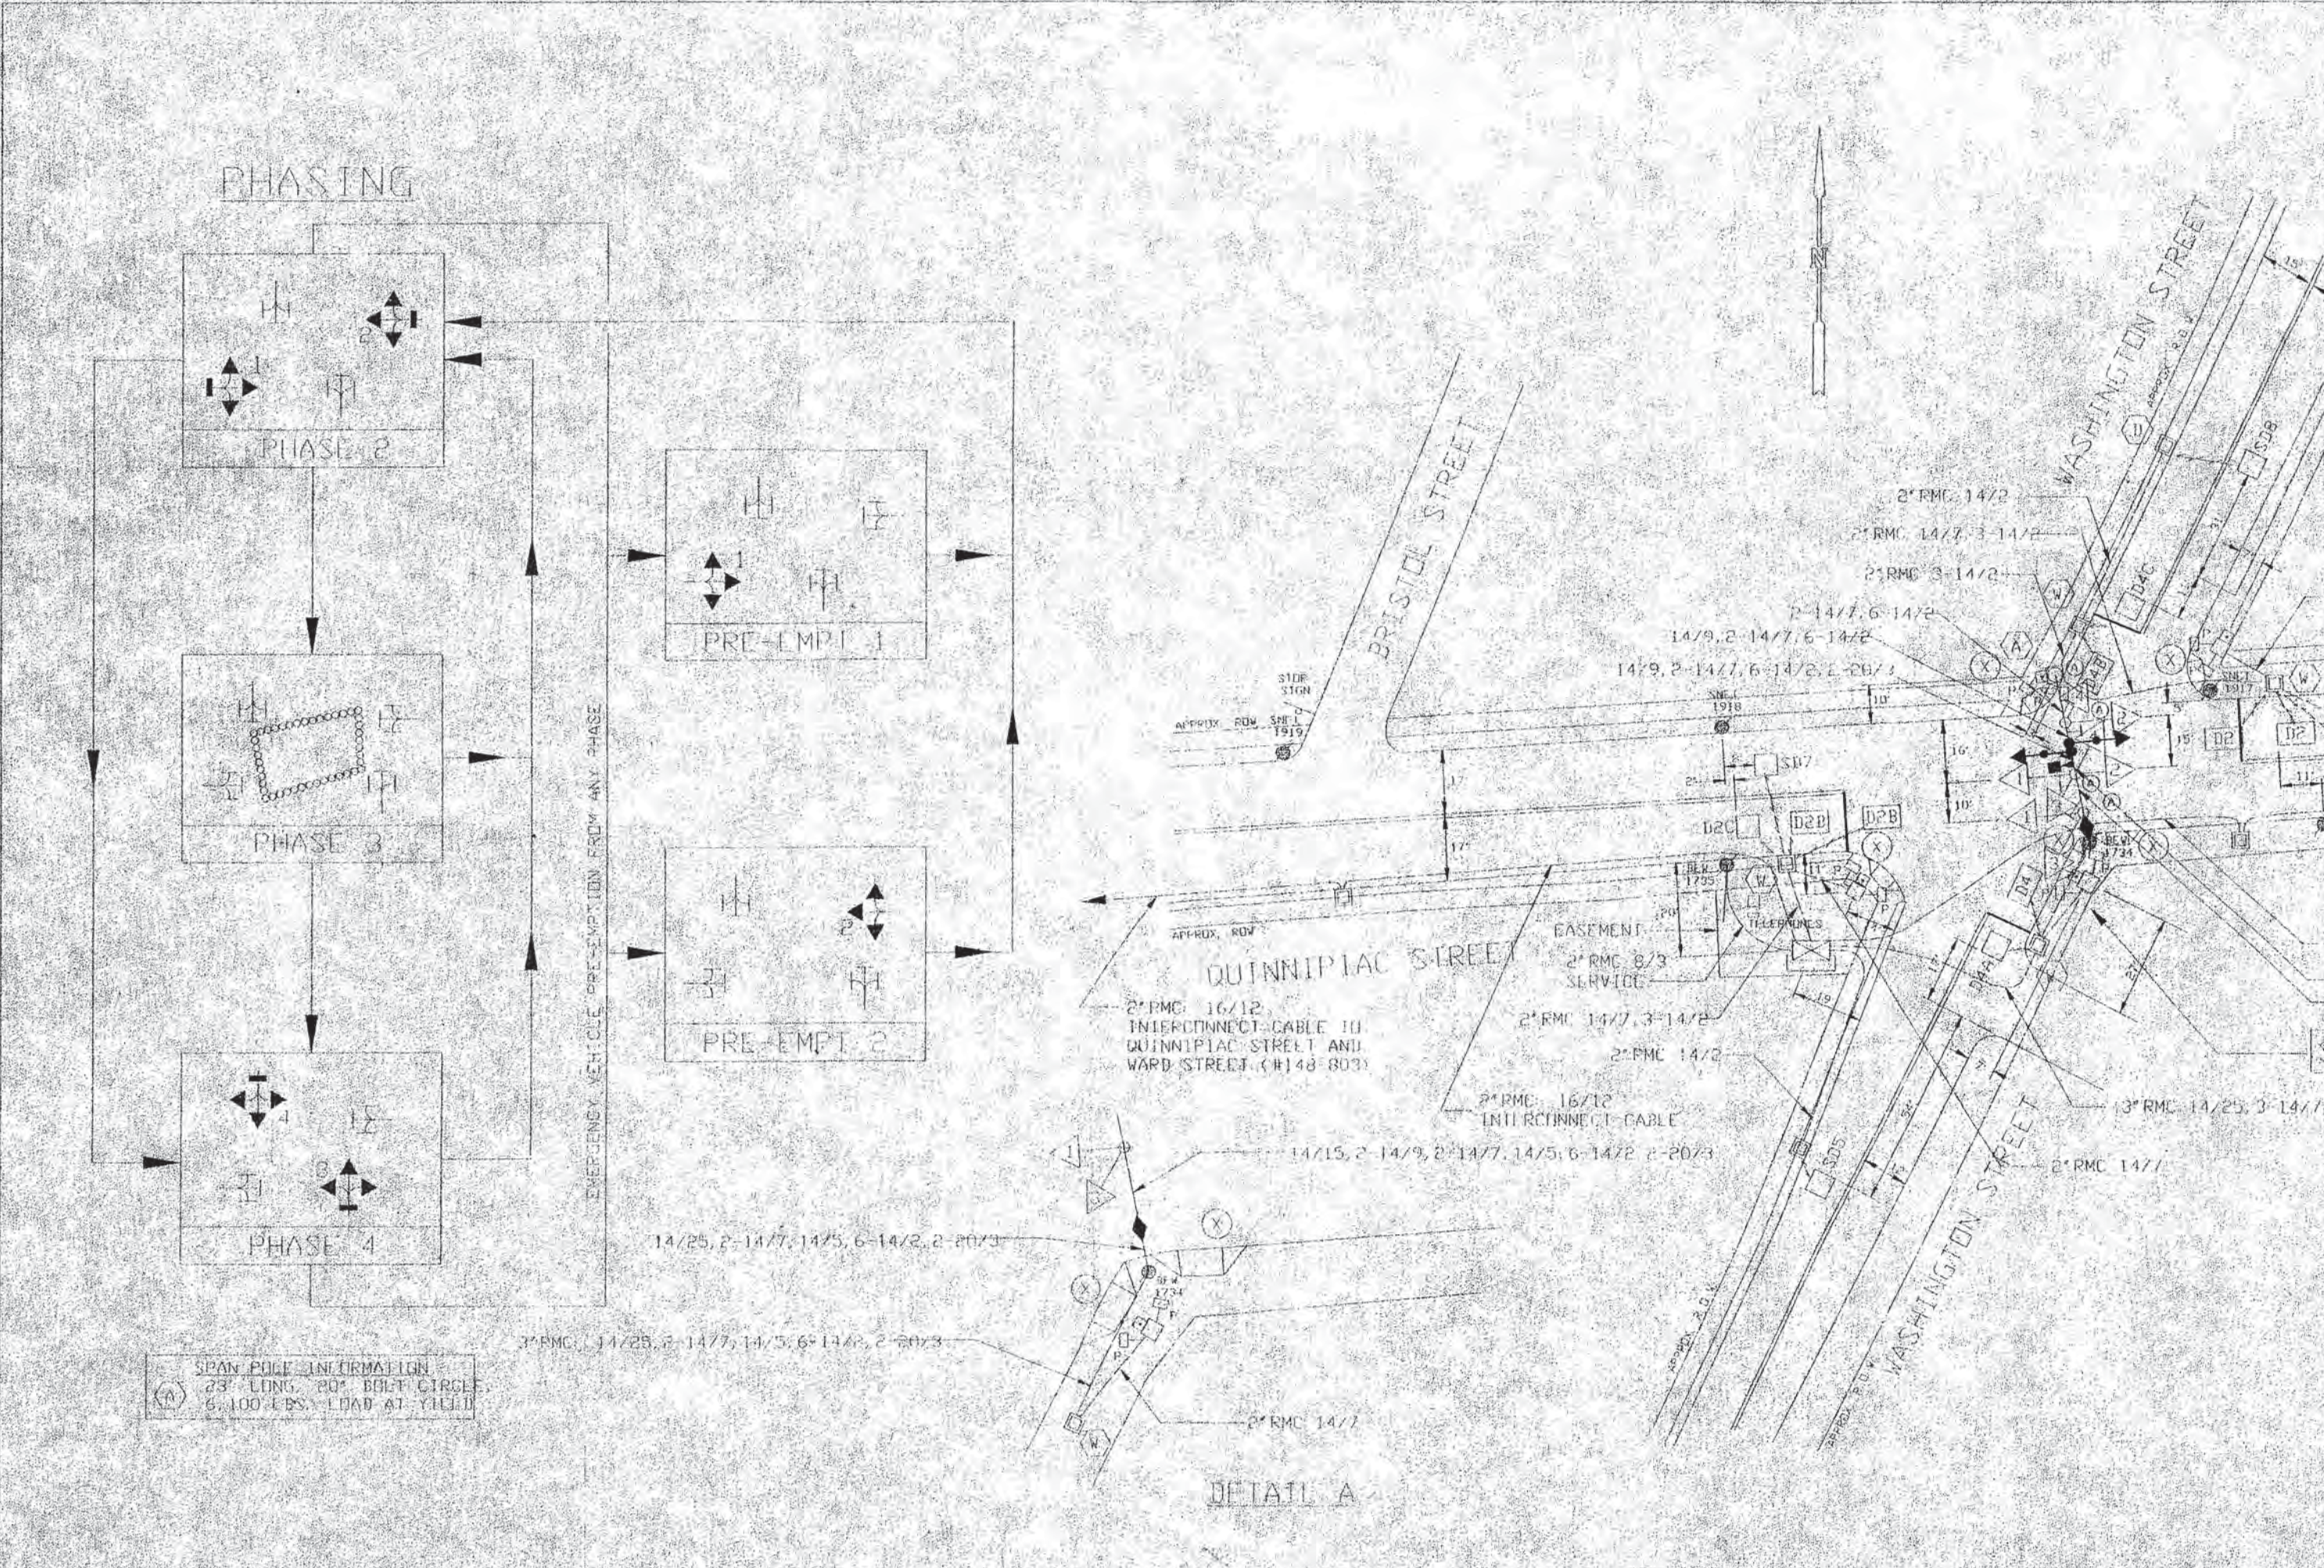

SCALE 1" = 40'

DATE: JULY 1997

TOWN	PROJECT NO.	PROJ. NO.	PROJ. YEAR	ROUTE NO.	SHEET NO.	TOTAL SHEETS
WALLINGFORD	148-803	148-163	1997		30	54

CONSTRUCTION NOTES

- ALL TRAFFIC CONTROL EQUIPMENT, UNLESS OTHERWISE NOTED IS NEW. ALL MATERIALS AND EQUIPMENT SHALL CONFORM TO THE TYPICAL SPECIFICATIONS AND AS AMENDED. ALL NEW TRAFFIC CONTROL EQUIPMENT SHALL BE FIELD-LOCATED AND APPROVED BY THE ENGINEER AND THE TOWN PRIOR TO CONSTRUCTION.
- ALL CABLEING SHALL BE NEW AND INSTALLED WITHOUT SPLICES.
- SPAN WIRE SHALL BE 3/8" 120 DIA. EXTRA STRENGTH 15,400 LBS. MAXIMUM BREAKING STRENGTH.
- TYPE 3 PEDESTRIAN SIDEWALK RAMPAS.
- CONTRACTOR SHALL CONTACT "CALL BEFORE YOU DIG" (1-800-922-4455) PRIOR TO ANY EXCAVATION.
- ALL WORK TO BE COORDINATED WITH THE TOWN OF WALLINGFORD POLICE DEPARTMENT. CONTACT OFFICER R. A. DULL 294-2250.
- THE CONTRACTOR WILL SCHEDULE HIS CONSTRUCTION WORK SO THAT POSITIVE TRAFFIC CONTROL (STOP SIGNS, TEMPORARY SIGNALS, ETC.) ARE IN PLACE AND OPERATIONAL AT ALL TIMES.
- THE CONTRACTOR SHALL SUITELY INSTALL AND MAKE FULLY OPERATIONAL THE FOLLOWING:
 - 23" (58.53 METERS) STEEL SPAN POLE ON STANDARD SPAN POLE FOUNDATION WITH POLE MOUNTED ADA APPROVED PUSH BUTTON AND SIGN ASSEMBLY AND 2 ONE-WAY PEDESTRIAN SIGNALS.
 - INSTALL TOWN APPROVED STANDARD FULL ACTUATED 8 PHASE CONTROLLER ON NEW TYPE IV CONTROLLER FOUNDATION. CONTROLLER SHALL BE EQUIPPED WITH INTERNAL EMERGENCY VEHICLE PRE-EMPT CAPABILITY. THE CONTROLLER SHALL BE EQUIPPED WITH ALL NECESSARY AND/OR REQUIRED COMPONENTS AND INTERNAL COMMUNICATION MODULES FOR INCLUSION IN AND FULL COMPATIBILITY WITH THE TOWN'S EXISTING CLOSED LOOP TRAFFIC SIGNAL SYSTEM. THE CONTROLLER TYPE IV CABINET SHALL BE EQUIPPED WITH A WALL MOUNTED ELECTRIC DIVISION APPROVED METER SOCKET AND A WEATHERPROOF DISCONNECT. THE CONTRACTOR SHALL INSTALL A 3" X 6" CONCRETE SIDEWALK PAD ON THE CABINET.
 - INSTALL 8'-0" (2.438 METERS) ALUMINUM PEDESTAL ON TYPE I PEDESTAL FOUNDATION WITH ADA APPROVED PUSH BUTTON AND SIGN ASSEMBLY, AND TWO WAY PEDESTRIAN SIGNAL.
 - INSTALL TYPE III CONCRETE HANDHOLES (TYPICALLY 1'-0" (0.305 METERS) FROM NEW CURB, UNLESS OTHERWISE NOTED).
 - INSTALL TOWN STATE APPROVED ADJUSTABLE PEDESTRIAN SIGNAL WITH ADJUSTABLE PRESTAY IN CONTROLLER CABINET.
 - UTILITY POLE BEW 1734 TO BE REPLACED BY OTHERS, AS NEW POLE BEW #84 AND TO BE GUAYED BY WALLINGFORD ELECTRIC DIVISION.
 - INSTALL 30" X 30" CONCRETE HANDHOLE, ALL OTHERS TO BE TYPE 11.
- ELECTRICAL SERVICE TO THE CONTROLLER SHALL BE COORDINATED WITH THE WALLINGFORD ELECTRICAL DIVISION. THE CONTRACTOR SHALL PAY ALL FEES AND COSTS FOR OBTAINING. CONTACT MR. JAMES H. RAINEY AT WALLINGFORD ELECTRIC DIVISION (203) 265-6309 TO COORDINATE.
- THE OPTICOM RECEIVER(S) SHALL BE MOUNTED MID-SPAN IN ACCORDANCE WITH THE MANUFACTURER'S RECOMMENDATIONS, AND SHALL BE APPROVED BY AN AUTHORIZED REPRESENTATIVE OF 3-M PRIOR TO INSTALLATION OR TURN ON. A SEPARATE TO 3 CABLE FOR EACH OPTICAL DETECTOR SHALL BE INSTALLED CONSPICUOUSLY DIRECTLY TO THE CONTROLLER CABINET.
- ALL SIGNALS SHALL BE BUNGED SO THAT A MINIMUM VERTICAL CLEARANCE OF 16 FEET (4.88 METERS) IS MAINTAINED BETWEEN THE FINAL ROADWAY SURFACE AND THE BOTTOM OF THE SIGNALS.
- INSTALL LOOP DETECTORS IN BASE COURSE OF NEW PAVEMENT, CENTERED IN LANE AND 8" (2.438 METERS) APART UNLESS OTHERWISE NOTED. SEGMENTED LOOPS TO BE SPLICED IN SERIES.
- INSTALL TRAFFIC SIGNAL CABLE CLOSURE ON SPAN 5 FEET FROM CURBLINE.
- INSTALL 2" RMC STAND-OFF ON UTILITY POLE BEW #1735 AND 3" RMC STAND-OFF ON NEW BEW #84. INSTALL POLE MOUNTED SERVICE DISCONNECT 10 FEET ABOVE THE GROUND ON POLE BEW #1735.
- CONTACT NOTED UTILITY COMPANIES A MINIMUM OF TWO (2) WEEKS PRIOR TO CONSTRUCTION.
- ALL TRAFFIC SIGNAL WORK SHALL BE CONSTRUCTED IN ACCORDANCE WITH CONDOT'S AND WALLINGFORD'S STANDARDS.
- THE CONTRACTOR SHALL RESTORE THE EASEMENT AREA ON THE SOUTHWEST CORNER OF INTERSECTION TO THE SATISFACTION OF TOWN OF WALLINGFORD HOUSING AUTHORITY. THIS WORK WILL INCLUDE ALL NECESSARY REGRADING, LOAMING, SEEDING AND TURF ESTABLISHMENT.
- ATTACH SPANWIRE TO NEW UTILITY POLE BEW #84 AT APPROXIMATELY 22.5 FEET ABOVE THE GROUND.
- ANCHOR BOLTS FOR POLE FOUNDATIONS SHALL BE SET SQUARE TO THE SPAN POLE SUCH THAT TWO BOLTS ARE IN TENSION AND TWO ARE IN COMPRESSION.

DATE: JULY 1997

TRAFFIC CONTROL SIGNAL LAYOUT

DETECTOR	SD1	SD2	SD3	SD4	SD5	SD6	SD7	SD8
D01	LD1							
D02	LD1	SD4						
D03	LD2							
D04	LD2	SD2						
D05	LD3							
D06	LD3	SD3						
D07	LD4							
D08	LD4	SD4						
D09	LD4	SD4						
D10	LD4	SD4						
D11	LD4	SD4						
D12	LD4	SD4						
D13	LD4	SD4						
D14	LD4	SD4						
D15	LD4	SD4						
D16	LD4	SD4						
D17	LD4	SD4						
D18	LD4	SD4						
D19	LD4	SD4						
D20	LD4	SD4						

TRAFFIC CONTROL SIGNAL LAYOUT

DETECTOR	SD1	SD2	SD3	SD4	SD5	SD6	SD7	SD8
D01	LD1							
D02	LD1	SD4						
D03	LD2							
D04	LD2	SD2						
D05	LD3							
D06	LD3	SD3						
D07	LD4							
D08	LD4	SD4						
D09	LD4	SD4						
D10	LD4	SD4						
D11	LD4	SD4						
D12	LD4	SD4						
D13	LD4	SD4						
D14	LD4	SD4						
D15	LD4	SD4						
D16	LD4	SD4						
D17	LD4	SD4						
D18	LD4	SD4						
D19	LD4	SD4						
D20	LD4	SD4						

OWNERS NAME
TOWN OF WALLINGFORD

STATE OF CONNECTICUT
DEPARTMENT OF TRANSPORTATION
BUREAU OF ENGINEERING & HIGHWAY OPERATIONS
DIVISION OF TRAFFIC ENGINEERING

Quinnipiac St. & Washington St.

TRAFFIC CONTROL SIGNAL

F.H.V.A. REGION NO.	STATE	TOWN	FED. AID PROJ. NO.	PRD. NO.	YEAR	ROUTE NO.	SHEET NO.	TOTAL SHEETS
1	CONN	WALLINGFORD	STPN-2565 (2)	148-163	1997		29	54

RAILROAD PRE-EMPTION NOTES

RAILROAD PRE-EMPTION SHALL TAKE PRECEDENCE OVER ALL OTHER OPERATIONS

RAILROAD PRE-EMPTION (NORMAL OPERATION)

1. TRAIN ENTERS TRACK CIRCUIT - R.R. PROVIDES IMMEDIATE PRE-EMPTION CIRCUIT TO THE TRAFFIC SIGNAL CONTROLLER CABINET.
2. THE TRAFFIC SIGNAL CONTROLLER IMMEDIATELY ADVANCES THE SEQUENCE TO THE TRACK CLEARANCE PHASE VIA THE PROPER YELLOW AND RED CLEARANCE INTERVALS. IF PEDESTRIAN PHASE IS IN OPERATION PHASE WILL BE IMMEDIATELY TERMINATED.
3. THE INTERNALLY ILLUMINATED TURN RESTRICTION SIGNS WILL BE ILLUMINATED IMMEDIATELY WITH THE TRAFFIC SIGNAL PRE-EMPTION.
4. THE TRACK CLEARANCE PHASE WILL TERMINATE AND THE TRAFFIC CONTROLLER WILL HOLD IN THE RAILROAD PRE-EMPTION HOLD PHASE.
5. THE RAILROAD FLASHING LIGHTS WILL COMMENCE OPERATION 17 TO 22 SECONDS INTO THE TRACK CLEAR PHASE DEPENDING UPON WHAT INTERVAL THE TRAFFIC SIGNAL CONTROLLER IS IN WHEN THE PRE-EMPTION CALL IS RECEIVED. STANDARD R.R. TIMING FOR BELLS, LIGHTS AND GATES WILL COMMENCE A MINIMUM 29 SECONDS PRIOR TO THE TRAIN ENTERING THE CROSSING.
6. WHEN THE TRAIN HAS LEFT THE CROSSING AND THE TRACK CIRCUIT, THE RAILROAD DEVICES AND TURN RESTRICTION SIGNS SHALL DEACTIVATE AND THE TRAFFIC CONTROL SIGNAL SHALL RETURN TO NORMAL OPERATION, PHASE 2.

RAILROAD PRE-EMPTION (FAIL SAFE FLASHING OPERATION)

1. TRAIN ENTERS TRACK CIRCUIT - R.R. PROVIDES IMMEDIATE PRE-EMPTION CIRCUIT TO THE TRAFFIC SIGNAL CONTROLLER CABINET.
2. THE FLASHING OPERATION IMMEDIATELY CHANGES TO A SOLID RED ON FACE 6, FACES 1 AND 2 REMAIN FLASHING YELLOW AND FACES 3, 4 AND 5 REMAIN FLASHING RED AND WILL HOLD IN THIS MODE.
3. THE INTERNALLY ILLUMINATED TURN RESTRICTION SIGNS WILL BE ILLUMINATED IMMEDIATELY WITH THE TRAFFIC SIGNAL PRE-EMPTION.
4. THE RAILROAD FLASHING LIGHTS WILL COMMENCE OPERATION 23 SECONDS AFTER THE RECEIPT OF THE PRE-EMPTION CALL. STANDARD R.R. TIMING FOR BELLS, LIGHTS AND GATES WILL COMMENCE A MINIMUM 29 SECONDS PRIOR TO THE TRAIN ENTERING THE CROSSING.
5. WHEN THE TRAIN HAS LEFT THE CROSSING AND THE TRACK CIRCUIT, THE TRAFFIC SIGNAL CONTROLLER SHALL RETURN TO FLASHING YELLOW ON FACES 1 AND 2, FLASHING RED ON FACES 3, 4, 5 AND 6 AND THE RAILROAD DEVICES SHALL DEACTIVATE.

TECHNICAL NOTES CONTINUED

CONTROLLER SHALL IMMEDIATELY ADVANCE OUT OF ANY GREEN, INCLUDING MIN GREEN, INTO CLEARANCE INTERVALS GOING TO PRE-EMPTION, AND THEN GO DIRECTLY TO RAILROAD TRACK CLEAR PHASE DURING RAILROAD PRE-EMPTION.

WHEN RAILROAD PRE-EMPTION OCCURS DURING THE CLEARANCE INTERVAL OF ANY PHASE, THE CONTROLLER TO DROP NEXT PHASE, FINISH TIMING THE CLEARANCE INTERVALS GOING TO PRE-EMPTION, AND THEN GO DIRECTLY TO RAILROAD TRACK CLEAR PHASE.

PEDESTRIAN TIMING TO IMMEDIATELY ADVANCE OUT OF THE WALK AND PED CLEARANCE INTERVAL INTO THE CLEARANCE INTERVAL TIMINGS GOING TO PRE-EMPTION, THEN GO IMMEDIATELY TO RAILROAD TRACK CLEAR PHASE.

POLICE BOX MANUAL SHALL BE ABLE TO BE PRE-EMPTED BY RAILROAD CIRCUIT. THE POLICE BOX MANUAL CONTROL SHALL REMAIN INOPERATIVE FROM THE TIME A PRE-EMPTION CALL IS RECEIVED UNTIL THE CONTROLLER LEAVES THE RAILROAD HOLD PHASE AND RETURNS TO PHASE 2 GREEN.

ANY CHANGE IN THE CLEARANCE INTERVALS DENOTED ON THIS PLAN MAY REQUIRE A MODIFICATION OF THE RAILROAD TRACK CIRCUIT.

THE CONTROLLER SHALL BE A "MENU DRIVEN" TYPE WITH INTERNAL RAILROAD PRE-EMPTION.

RAILROAD FLASHING LIGHTS TO START 23 SECONDS INTO THIS INTERVAL

TRAFFIC SIGNAL TO BE IMMEDIATELY FORCED OUT OF CLOSED LOOP COORDINATED OPERATION UPON RECEIPT OF RAILROAD PRE-EMPTION CALL

FLASHING OPERATION TO REVERT TO RR PRE-EMPT FROM FAIL SAFE FLASH UPON RECEIPT OF RR PRE-EMPTION CALL

GENERAL PRE-EMPTION NOTES

1. RAILROAD PRE-EMPT OPERATIONS SHALL BE MAINTAINED AT ALL TIMES DURING BOTH ACTIVE AND NON CONSTRUCTION TIME PERIODS.
2. IF FOR ANY REASON NORMAL RAILROAD PRE-EMPT OPERATIONS ARE INTERRUPTED, THE CONTRACTOR SHALL IMMEDIATELY NOTIFY THE WALLINGFORD POLICE DEPARTMENT, THE CONNECTICUT DEPARTMENT OF TRANSPORTATION AND AMTRAK.
3. ANY MODIFICATIONS TO THESE TIMINGS AND RAILROAD PRE-EMPTION OPERATIONS MUST BE APPROVED BY THE TOWN, STATE AND AMTRAK.
4. ANY WORK ON RAILROAD PROPERTY SHALL BE APPROVED BY AND AUTHORIZED BY AMTRAK.

EMERGENCY VEHICLE PRE-EMPTION NOTES

1. THE OPTICAL DETECTOR(S) SHALL BE MOUNTED MID-SPAN; IN ACCORDANCE WITH THE MANUFACTURER'S RECOMMENDATIONS. A SEPARATE 20/3 CABLE (FOR EACH OPTICAL DETECTOR) SHALL BE INSTALLED (UNSPliced) DIRECTLY TO THE CONTROLLER CABINET.

UTILITY/PROJECT CONTACTS

TOWN / POLICE:	R. A. DOLL: 294-2250
SNET:	BOB BOUFFARD: (800)748-1693
AT&T:	RON TARINI: (203)269-2565
WALLINGFORD ELECTRIC:	ART DUTRA: (203)265-0308
AMTRAK:	JOE HOFBAUER: (215)349-1038
TCI CABLE:	ADAM BURR: (203)483-2300
DESIGNER:	M.M.I., JOHN P. THOMPSON (203)271-1773

SEE SHEET 32 FOR CONSTRUCTION NOTES

STATE OF CONNECTICUT
DEPARTMENT OF TRANSPORTATION
BUREAU OF ENGINEERING & HIGHWAY OPERATIONS
DIVISION OF TRAFFIC ENGINEERING

OWNERS NAME
TOWN OF WALLINGFORD

TRAFFIC CONTROL SIGNAL

MOVEMENT DIAGRAM

OPERATION FLASHING

ENERGY BY-- TOWN SERVICE POLE-SNET #2754

INTERSECTION # 148-801

METERED SERVICE

STC# _____ SM# _____

SIGNAL REVISED
INSTALLED ALL NEW EQUIPMENT INCLUDING POLES, PEDESTALS, CONTROLLER SIGNAL HEADS, PEDESTRIAN SIGNALS, ILLUMINATED SIGNS, VEHICLE DETECTORS, INTERCONNECT CABLE, EMERGENCY VEHICLE AND RAILROAD PRE-EMPT UNDER PROJECT #148-163

PHASE	GRN	CL	CL	GRN	CL	CL	GRN	CL	CL	GRN	CL	CL	GRN	CL	CL	GRN	CL	CL	GRN	CL	CL		
1																							
2																							
3																							
4																							
5																							
6																							

PRE-EMPTION SETTINGS

PROPERTY	PRE-EMPT 1	PRE-EMPT 2	PRE-EMPT 3	PRE-EMPT 4
EMERGENCY VEHICLE	Y	Y	Y	Y
RAILROAD	Y	Y	Y	Y
TRAFFIC SIGNAL	Y	Y	Y	Y
HEADS 6 TO BE RIGID MOUNTED	Y	Y	Y	Y
ALL RED INDICATIONS TO BE L.E.D. LAMPS	Y	Y	Y	Y
SIGNAL FACE 3 TO HAVE 12" BI-COLORED YELLOW/GREEN ARROW	Y	Y	Y	Y

TECHNICAL NOTES

STANDARD OVERLAP SKIP FEATURES APPLY

EMERGENCY VEHICLE PRE-EMPT TO BE INOPERATIVE DURING FLASH

RAILROAD PRE-EMPT TO BE OPERATIVE AT ALL TIMES

RAILROAD PRE-EMPT TO OVERRIDE ALL OTHER OPERATIONS

TIMINGS SHOWN INDICATED FREE OPERATION. ACTUAL TIMINGS SHOWN TO BE CONTROLLED BY THE CLOSED LOOP LOCAL COORDINATION UNIT.

(1) TRAFFIC SIGNAL SHALL NOT BE PLACED ON PROGRAMMED FLASH

DETECTORS D4 AND D4A TO CALL AND EXTEND PHASE 4 AND EXTEND PHASE 5

(2) TO BE Y IF RAILROAD PRE-EMPTION IS NEXT

(3) TO BE R IF RAILROAD PRE-EMPTION IS NEXT

(4) TO BE Y IF PHASE 5 IS NOT NEXT

(5) TO BE R IF PHASE 3 IS NOT NEXT

(6) TO BE 3 SECONDS IF RR PRE-EMPTION NEXT

(7) TO BE 1 SECOND IF RR PRE-EMPTION NEXT

PHASING

DETAIL A

RAILROAD PRE-EMPTION

TIME	EVENT
0"	START RAILROAD PRE-EMPTION
29"	START RAILROAD LIGHTS
30"	START RAILROAD GATES
40"	GATES HORIZONTAL
52"	TRAIN ENTERS CROSSING

NOTE: WHEN A RAILROAD PRE-EMPTION CALL IS RECEIVED DURING NORMAL OPERATION, OR MANUAL OPERATION, RAILROAD FLASHING LIGHTS WILL COMMENCE OPERATION 17 TO 22 SECONDS INTO THE TRACK CLEAR PHASE DEPENDING UPON WHICH INTERVAL THE CONTROLLER IS IN WHEN THE PRE-EMPTION CALL IS RECEIVED.

WHEN RAILROAD PRE-EMPTION OCCURS DURING EMERGENCY FLASH OR FAIL-SAFE FLASHING OPERATION, RAILROAD

TOWN SIGNAL


TRAFFIC CONTROL SIGNAL LAYOUT

STATE OF CONNECTICUT
DEPARTMENT OF TRANSPORTATION
BUR. OF ENGINEERING & HWY. OPERATIONS
DIVISION OF TRAFFIC ENGINEERING

TOWN OF WALLINGFORD
NORTH AND SOUTH CHERRY STREET
AND QUINNIPIAC STREET

REV. # INTERSECTION # 148-801


F.H.W.A. REGION NO.	STATE	TOWN	FED. AID PROJ. NO.	PROJ. NO.	YEAR	ROUTE NO.	SHEET NO.	TOTAL SHEETS
1	CONN.	WALLINGFORD	---		1997	---		

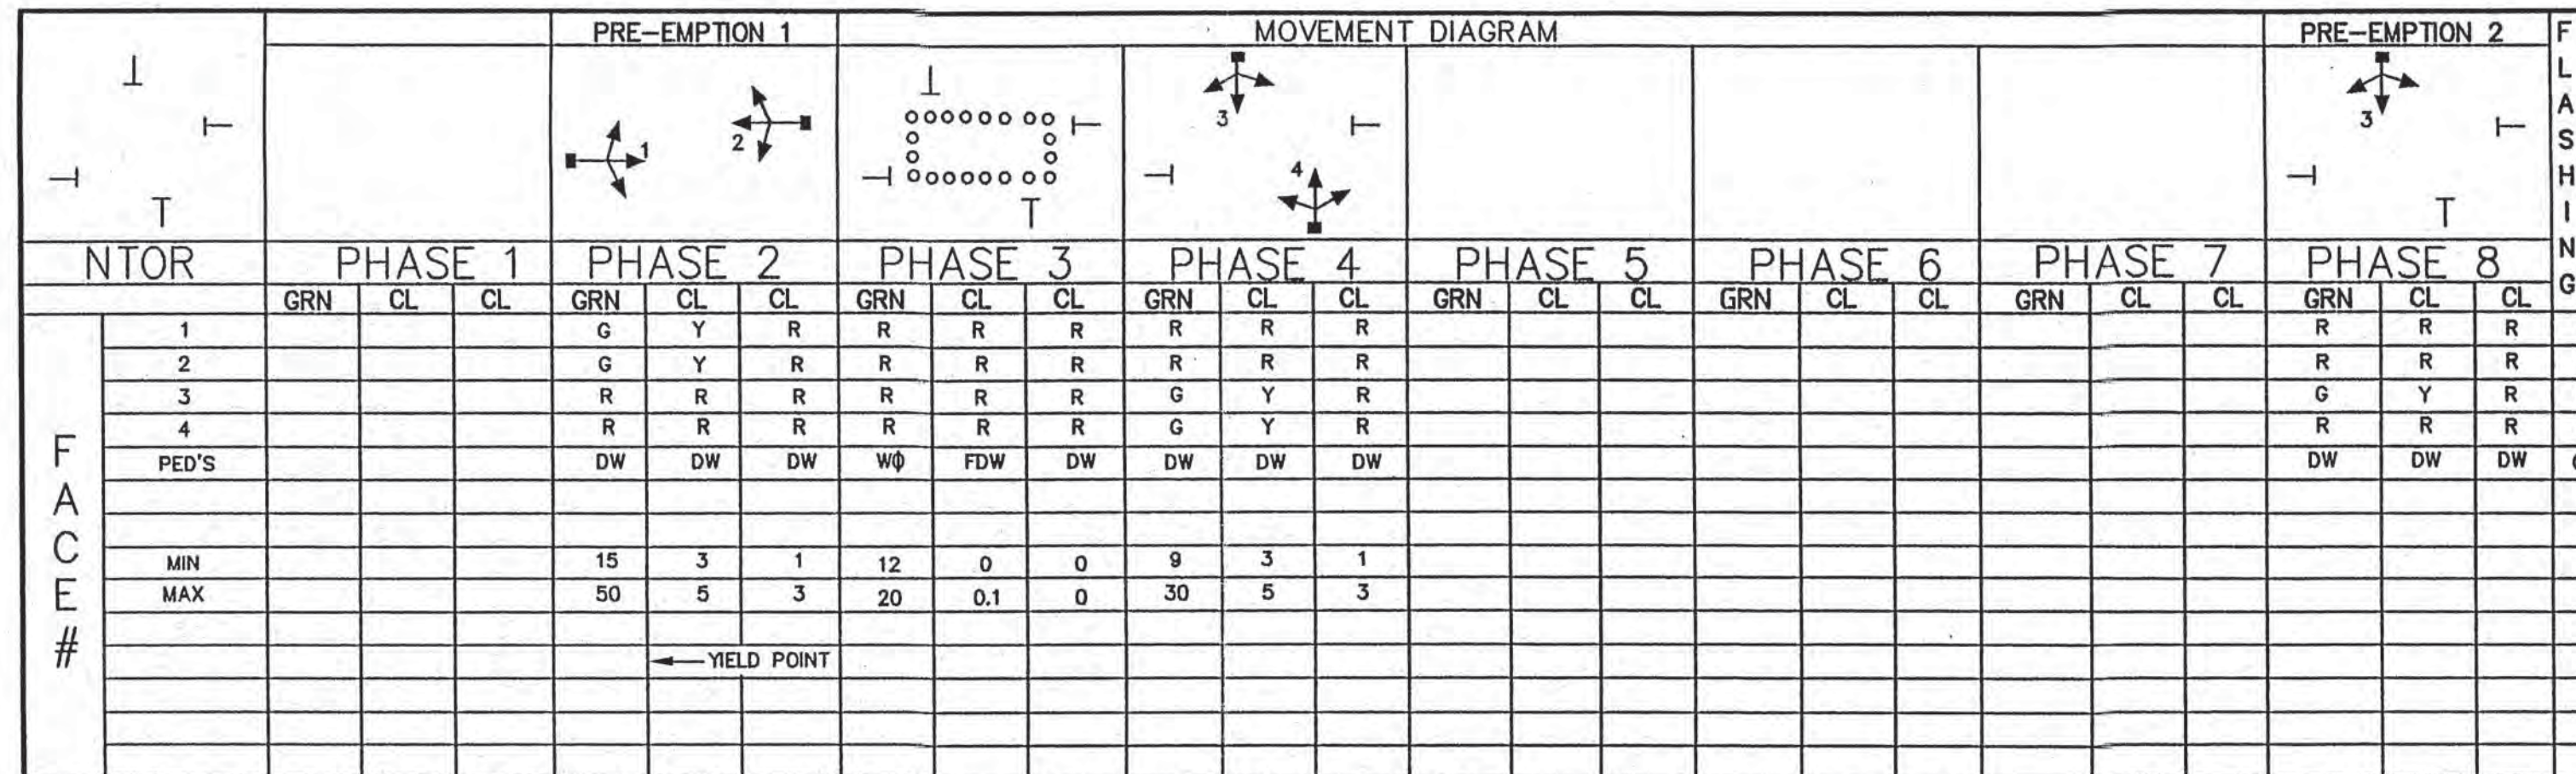

FACE #	PHASE 1		PHASE 2		PHASE 3		PHASE 4		PHASE 5		PHASE 6		PHASE 7		PHASE 8	
	GRN	CL	GRN	CL	GRN	CL	GRN	CL	GRN	CL	GRN	CL	GRN	CL	GRN	CL
1			G	Y	R	R	R	R	R	R	R	R	R	R	R	R
2			G	Y	R	R	R	R	R	R	R	R	R	R	R	R
3			R	R	R	R	R	R	R	G	Y	R	R	R	R	R
4			R	R	R	R	R	R	R	R	R	R	R	R	R	R
PED'S			DW	DW	DW	W	FDW	DW	DW	DW	DW	DW	DW	DW	DW	DW
MIN			15	3	1	12	0	0	9	3	1					
MAX			50	5	3	20	0.1	0	30	5	3					

INTERVALS	PHASE 1		PHASE 2		PHASE 3		PHASE 4		PHASE 5		PHASE 6		PHASE 7		PHASE 8	
	MIN GRN	WALK	PED CLR	VEH EXT	MAX 1	MAX 2	YELLOW	RED	ADD INI	MAX INT	TBR	TTR	MIN GAP	MODE	INI START	
MIN GRN	15													OFF		
WALK														MIN RECALL THIS PHASE		
PED CLR														LOCK		
VEH EXT														LOCK		
MAX 1														OFF		
MAX 2														OFF		
YELLOW														OFF		
RED														OFF		
ADD INI														OFF		
MAX INT														OFF		
TBR														OFF		
TTR														OFF		
MIN GAP														OFF		

ENERGY BY - TOWN	INTERSECTION 148-219 ?
SERVICE BY - SNET 927	NORMAL kW hr/mo kWh/mo
OFFICE RECORD	FLASH kW hr/mo kWh/mo
	METER SERVICE
JOB#	SM# N/A
REVISION	
REVISION # 2	
INSTALL LOOP DETECTORS, SIGNAL HEADS,	
FIRE PRE-EMPTION AND AUDIBLE PEDESTRIAN SIGNAL	

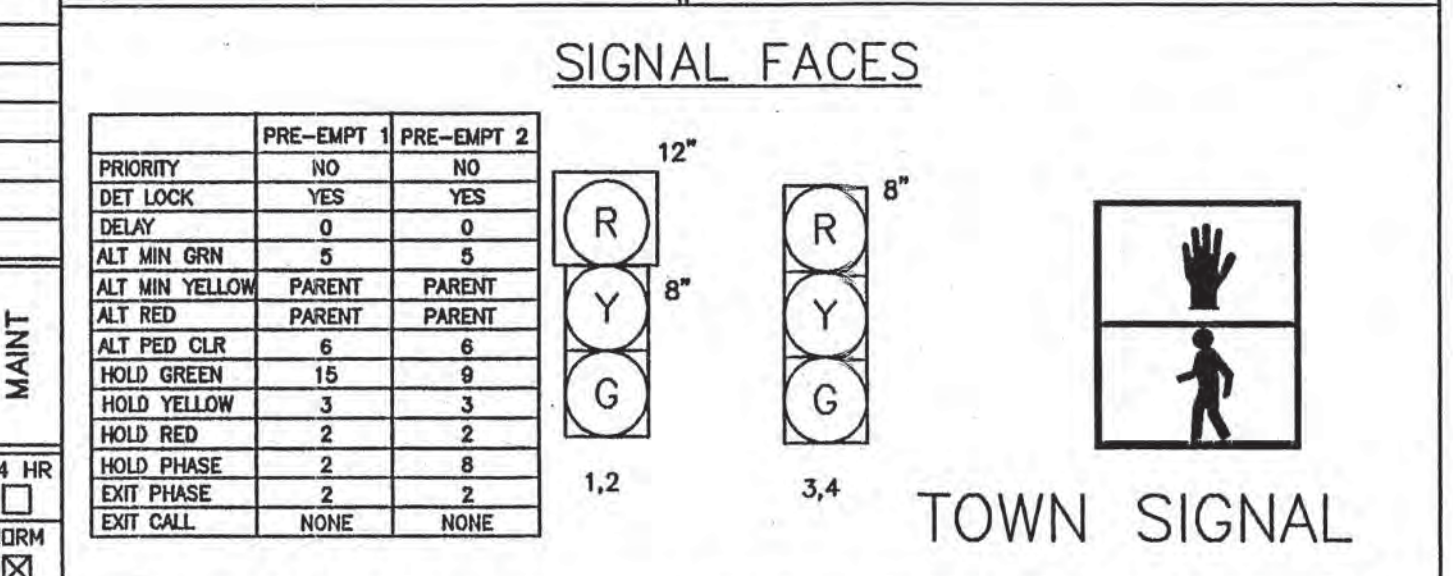

MAINT	PRE-EMPT 1	PRE-EMPT 2
PRIORITY	NO	NO
DET LOCK	YES	YES
DELAY	0	0
ALT MIN GRN	5	5
ALT MIN YELLOW	PARENT	PARENT
ALT RED	PARENT	PARENT
ALT PED CLR	6	6
HOLD GREEN	15	9
HOLD YELLOW	3	3
HOLD RED	2	2
HOLD PHASE	2	8
EXIT PHASE	2	2
EXIT CALL	NONE	NONE

LEGEND	CONTROLLER
R RED	CONTROLLER
Y YELLOW	HANDHOLE
G GREEN	EXIST. HANDHOLE
RED ARROW	EXIST. RIGID METAL CONDUIT
YELLOW ARROW	(RMC) RIGID METAL CONDUIT
GREEN ARROW	STRAIN INSULATOR
WALK/FL DW	PROPOSED WOOD SPAN POLE
DW DON'T WALK	EXISTING WOOD SPAN POLE
FL FLASHING	PROPOSED STEEL SPAN POLE
PROPOSED WOOD SPAN POLE	EXISTING STEEL SPAN POLE
EXISTING WOOD SPAN POLE	PROPOSED UTILITY POLE
PROPOSED STEEL SPAN POLE	EXISTING UTILITY POLE
EXISTING STEEL SPAN POLE	PEDESTAL MOUNTING
PROPOSED UTILITY POLE	PEDESTRIAN PUSH BUTTON
EXISTING UTILITY POLE	TRAFFIC SIGNAL FACE
PEDESTAL MOUNTING	PEDESTRIAN SIGNAL FACE
PEDESTRIAN PUSH BUTTON	LOOP DETECTOR
TRAFFIC SIGNAL FACE	EXISTING PEDESTAL MOUNTING
PEDESTRIAN SIGNAL FACE	SYSTEM DETECTOR
LOOP DETECTOR	
EXISTING PEDESTAL MOUNTING	
SYSTEM DETECTOR	

STATE OF CONNECTICUT
DEPARTMENT OF TRANSPORTATION
BUREAU OF HIGHWAYS
DIV. OF TRAFFIC ENGINEERING


TRAFFIC CONTROL SIGNAL

TOWN OF WALLINGFORD
WARD STREET AT SOUTH ORCHARD STREET

REV. # 2	TRAFFIC	ELECTRICAL
	DATE	DATE
FIELD SURVEY	URS GREINER INC.	4/07/97
ENGINEER		
DRAFTER		
CHECKED BY		
SUBMITTED BY		
APPROVED BY		
DATE		

- ### CONSTRUCTION NOTES
- CONNDOT LATEST STANDARDS AND SPECIFICATIONS GOVERN.
 - ALL SIGNAL EQUIPMENT ARE NEW UNLESS NOTED.
 - ALL HANDHOLES TO BE INSTALLED 2' OFF EDGE OF ROAD.
 - INSTALL LOOP DETECTORS 3' OFF EDGE OF ROAD AND 8' APART UNLESS OTHERWISE SPECIFIED.
 - REMOVE ALL PAVEMENT MARKINGS/SIGNS THAT CONFLICT WITH THIS PLAN.
 - INSTALL AN EIGHT PHASE CONTROLLER PEEK/TRANSYT MODEL 3000 IN A TYPE C CABINET, ON A TYPE IV FOUNDATION. CABINET DOOR TO OPEN SIDEWALK SIDE.
 - THE CONTRACTOR SHALL CONTACT "CALL BEFORE YOU DIG" 48 HOURS PRIOR TO ANY EXCAVATION TO BE PERFORMED (CALL B.U.D. 1-800 922-4455).
 - ALL TRAFFIC CONTROL EQUIPMENT REMOVED DURING CONSTRUCTION SHALL BE DELIVERED TO WALLINGFORD POLICE TRAFFIC MAINTENANCE DIVISION LOCATED AT 282 WASHINGTON STREET.
 - THE SPAN WIRE SHOULD BE A MINIMUM OF 40" ABOVE COMMUNICATION CABLES AND A MINIMUM OF 12" BELOW THE SECONDARY WIRES.
 - CONTACT MR. JAMES RAINEY AT WALLINGFORD ELECTRIC DIVISION (265-0308) FOR ELECTRIC SERVICE.
 - N.T.O.R. SHALL BE SPAN MOUNTED USING COST CAST INC. HAINES CITY, FL.
 - TRANSFER OF INTERSECTION SHALL BE COMPLETED IN ONE WORKING DAY. THERE SHALL BE NO DOWN TIME OF THE INTERSECTION.
 - INSTALL "3M OPTICOM" DETECTORS, OPTICAL DETECTOR LOCATIONS ARE FOR ILLUSTRATION ONLY, EXACT LOCATIONS SHALL BE DETERMINED BY THE MFG. OR HIS DESIGNATED REPRESENTATIVES. DETECTOR CABLE ARE TO BE INSTALLED CONTINUOUS BETWEEN EACH OPTICAL DETECTORS & THE CONTROLLER CABINET.
 - TOWN WILL PROVIDE OFFSETS BETWEEN THE INTERSECTION AS NOTED UNDER THE SYSTEM LOC. CHART.
 - INSTALL CUTLER HAMMER 60 AMP WEATHER PROOF DICONNECT TO EXISTING STEEL SPAN 11' FROM GROUND LEVEL.
 - REPLACE PEDESTRIAN SIGNAL FACE, PUSH BUTTON AND PEDESTAL. USE EXISTING PEDESTAL FOUNDATION.

CONTRACTOR TO INSTALL PAVEMENT MARKINGS, AS INDICATED BELOW:
 BAR TYPE CROSS WALKS (24"-24"x8")
 10' OF DYCL ON SOUTH ORCHARD STREET
 100' OF DYCL ON WARD STREET
 12" STOP BAR

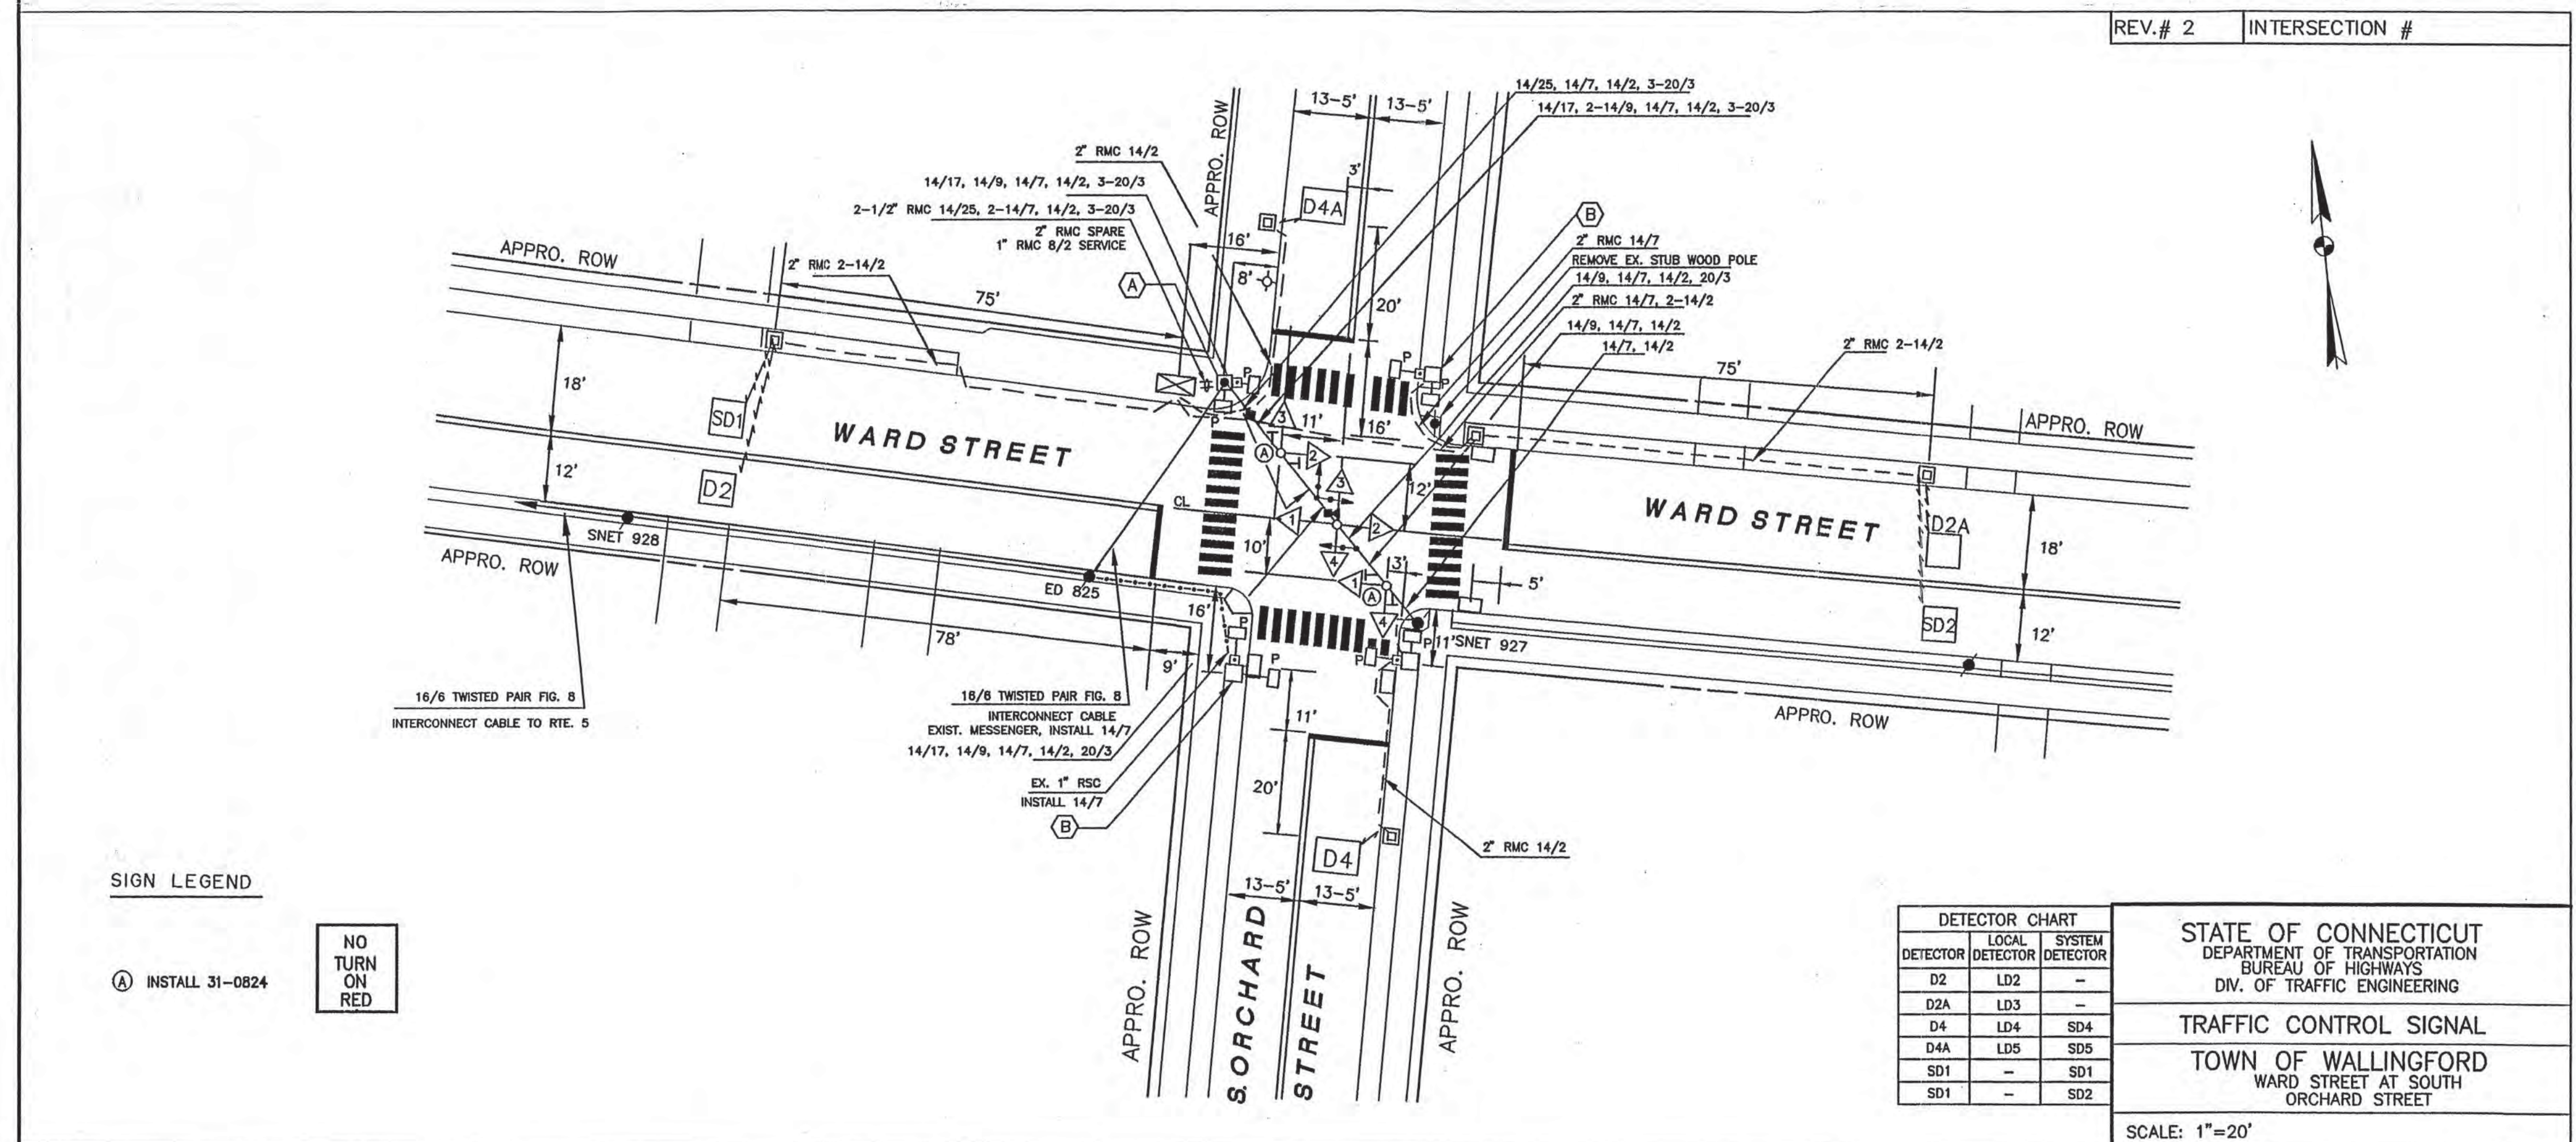

DETECTOR CHART		
DETECTOR	LOCAL	SYSTEM
D2	LD2	-
D2A	LD3	-
D4	LD4	SD4
D4A	LD5	SD5
SD1	-	SD1
SD2	-	SD2

STATE OF CONNECTICUT
DEPARTMENT OF TRANSPORTATION
BUREAU OF HIGHWAYS
DIV. OF TRAFFIC ENGINEERING

TRAFFIC CONTROL SIGNAL

TOWN OF WALLINGFORD
WARD STREET AT SOUTH ORCHARD STREET

SCALE: 1"=20'

TOWN SIGNAL

STATE OF CONNECTICUT
DEPARTMENT OF TRANSPORTATION
BUREAU OF HIGHWAYS
DIV. OF TRAFFIC ENGINEERING

TRAFFIC CONTROL SIGNAL

SCALE: 1"=20'

V-243
627

		PRE-EMPTION 1		PRE-EMPTION 2		MOVEMENT DIAGRAM		PRE-EMPTION 2		PRE-EMPTION 1			
		[Diagram]		[Diagram]		[Diagram]		[Diagram]		[Diagram]			
N T O R		PHASE 1		PHASE 2		PHASE 3		PHASE 4		PHASE 5		PHASE 6	
F A C E #	1	GRN	CL	CL	GRN	CL	CL	GRN	CL	CL	GRN	CL	CL
	2	R	R	R	R	R	R	R	R	R	R	R	R
	3	R	R	R	G	Y	R	R	R	R	G	Y	R
	4	R	R	R	G	Y	R	R	R	R	R	R	R
	5	R	R	R	R	R	R	R	R	R	R	R	R
	6	R	R	R	R	R	R	R	R	R	R	R	R
MIN		3	3	1	15	3	1	5	3	1	3	3	1
MAX		20	5	3	60	5	3	45	5	3	20	5	3
INTERVALS		NON-LOCK		MIN. RECALL THIS PHASE		OFF		NON-LOCK		NON-LOCK		MIN. RECALL THIS PHASE	
DETECTORS		PROGRAM		COORDINATION TYPE - CLOSED LOOP		SYSTEM LIVES		TECHNICAL NOTES					
IDENT	SIZE	URNS	MODE	FUNCTION	TIME	DAYS	CYCLE SEC	OFFSET #/SEC	YIELD %	PERMIS PERIOD	FORCE OFF %	STANDARD OVERLAP SKIP FEATURES APPLY	
D1	8' x 6'	3	PULSE	MAX 1	ALL OTHER TIMES	DAILY	85	1	0	64		TIMINGS SHOWN INDICATE FREE OPERATION. ACTUAL TIMINGS TO BE DETERMINED BY CLOSED LOOP LOCAL COORDINATION UNIT. PRE-EMPTION TO BE INOPERATIVE DURING FLASHING OPERATION.	
D2	8' x 6'	3	PULSE	MAX 2	1100 - 1400	SAT-SUN	110	2	0	63			
D3A	14' x 6'	3	5" DELAY	CYCLE 1	ALL OTHER TIMES	DAILY							
D3B	7' x 6'	3	5" DELAY	CYCLE 2	1100 - 1400	SAT-SUN							
D3C	11' x 6'	3	5" DELAY	CYCLE 3	FUTURE								
D3D	20' x 6'	3	5" DELAY	FREE	2300 - 0600	DAILY							
D3E	6' x 6'	3	PULSE										
D5	6' x 6'	3	PULSE										
D6	15' x 6'	3	PULSE										
SD1	7' x 6'	3	PULSE										
SD2	7' x 6'	3	PULSE										

ENERGY BY - DEVELOPER
SERVICE POLE # SNET 80
OFFICE RECORD

INTERSECTION #
METERED SERVICE

PRE-EMPTION SETTINGS

PRIORITY	PRE-EMPT 1	PRE-EMPT 2
DET. LOCK	NO	NO
DELAY	0	0
ALT. MIN GREEN	5	5
ALT. YELLOW	N/A	N/A
ALT. RED	PARENT PHASE	
ALT. PED. CLR.	N/A	N/A
HOLD GREEN	15	15
HOLD YELLOW	3	3
HOLD RED	1	1
HOLD PHASE	1 & 6	2 & 3
EXIT PHASE	2 & 6	2 & 6
EXIT CALL	NONE	NONE

SIGNAL FACES

TOWN SIGNAL

STATE OF CONNECTICUT
DEPARTMENT OF TRANSPORTATION
BUREAU OF HIGHWAYS
OFFICE OF TRAFFIC ENGINEERING
TRAFFIC CONTROL SIGNAL LAYOUT

TOWN OF WALLINGFORD
NORTH MAIN ST. AT BARNES INDUSTRIAL ROAD
AND K MART DRIVE

LEGEND

- R RED
- Y YELLOW
- G GREEN
- AR RED ARROW
- AY YELLOW ARROW
- AG GREEN ARROW
- W/F WALK/FEL. DIV.
- D.V. DON'T WALK
- F.L. FLASHING
- PROPOSED WOOD SPAN POLE
- EXISTING WOOD SPAN POLE
- PROPOSED STEEL SPAN POLE
- EXISTING STEEL SPAN POLE
- PROPOSED UTILITY POLE
- EXISTING UTILITY POLE
- PEDESTRIAN MOUNTING
- PEDESTRIAN PUSH BUTTON & SIGN
- TRAFFIC SIGNAL FACE
- PEDESTRIAN SIGNAL FACE
- LOOP DETECTOR
- MAGNETIC DETECTOR
- SD SYSTEM DETECTOR
- MANHOLE
- PROPOSED CONTROLLER
- EXISTING MANHOLE
- PROPOSED MANHOLE
- CATCH BASIN GRATE
- RIGID METAL CONDUIT
- STRAIN INSULATOR
- MAGNETOMETER PROBES
- CABLE CLOSURE
- BELLS IN SAW CUT
- RADIO ANTENNA
- OPICOM DETECTORS

FIELD SURVEY ENGINEER
DRAFTER
CHECKED BY
SUBMITTED BY
APPROVED BY

DATE

CONSTRUCTION NOTES

ALL WORK SHALL BE DONE IN ACCORDANCE WITH TOWN OF WALLINGFORD DETAILS AND SPECIFICATIONS. WHERE THESE SPECIFICATIONS DO NOT EXIST, CONNECTICUT DEPARTMENT OF TRANSPORTATION DETAILS AND SPECIFICATIONS FORM 814A, AS REVISED, SHALL APPLY.

INSTALL LOOP DETECTORS IN EXISTING PAVEMENT 3' OFF EDGE OF ROAD AND 8' APART UNLESS OTHERWISE NOTED.

SEGMENTED LOOPS TO BE INSTALLED IN SERIES.

ALL TRAFFIC EQUIPMENT IS NEW.

STAKE ALL R.O.W. PRIOR TO EXCAVATION.

INSTALL PEEK/TRANSYT MODEL 3800 MASTER AND 3800 LOCAL CONTROLLERS. INSTALL TELEPHONE DROP FOR CLOSED LOOP SYSTEM. CONNECT INTERCONNECT CABLE TO NORTH.

INSTALL 6 TWISTED PAIR, #16 GAUGE, COPPER SHIELD INTERCONNECT CABLE AND MESSENGER. CABLE SHALL MEET IMSA SPECIFICATIONS AND BE ACCEPTABLE TO THE TOWN OF WALLINGFORD. NO SPLICES SHALL BE PERMITTED.

CABINET DOOR TO OPEN STREET SIDE, CONCRETE PAD TO BE 3' x 4'.

TWO WEEKS PRIOR TO INSTALLATION CONTACT WALLINGFORD ELECTRIC DIVISION. REPRESENTATIVE ART DUTRA AT (203) 265-0308 AND SNET REPRESENTATIVE BOB WENTWORTH AT (203) 725-4519.

TRAFFIC SIGNAL CABLE CLOSURE SHALL BE INSTALLED ON THE SPAN +/- 5' FROM CURBLINE.

INSTALL 3M OPTICAL DETECTORS, MODEL 511, SYSTEM CHASSIS MODEL 560, AND PHASE SELECTOR MODEL 562. USE OPTICOM DETECTOR CABLE MODEL 138 TO CONNECT EACH DETECTOR SEPARATELY TO PHASE SELECTOR. NO SPLICES SHALL BE PERMITTED. LOCATION OF OPTICOM SENSORS TO BE LOCATED IN FIELD WITH TOWN.

INSTALL 60 AMP WEATHERPROOF DISCONNECT BOX AT SERVICE POLE IN ACCORDANCE WITH TOWN OF WALLINGFORD REQUIREMENTS.

INSTALL AND CONNECT TOWN OF WALLINGFORD APPROVED ELECTRIC METER SOCKET ON OUTSIDE OF CONTROLLER CABINET.

INSTALL STEEL POLE FOUNDATION ADJACENT TO AND WITHIN R.O.W. BOLTS TO BE SET SQUARE TO SPAN.

SPAN WIRE HEIGHT THRU UTILITY LINES APPROXIMATELY: 27.0' ABOVE SPAN POLE FOUNDATION ON NORTHEAST CORNER.

SPAN WIRE SIZE SHALL BE 3/8" Ø.

CABLE CLOSURE TO BE LOCATED 5' OFF OF CURB.

CBYD SHALL BE NOTIFIED.

HANDHOLE SHALL BE 30" BY 30".



CONTRACTOR TO STAKE R.O.W. PRIOR TO CONSTRUCTION.

PEDESTRIAN PUSHBUTTONS AND SIGNAGE SHALL BE ADA APPROVED. HANDICAPPED RAMPS SHALL BE PROVIDED IN CONJUNCTION WITH PEDESTRIAN PUSHBUTTONS.

ALL SPAN POLE SPECIFICATIONS SHALL BE IN ACCORDANCE WITH CONNECTICUT DEPARTMENT OF TRANSPORTATION, "TYPICAL STEEL SPAN POLE" 4/4/90, REVISIONS 3/90, 3/93.

FINAL TIMINGS AND CYCLE LENGTH WILL BE DETERMINED BY THE TOWN OF WALLINGFORD.

PRE-EMPTION IS TO OPERATE THROUGH THE INTERNAL PRE-EMPTION OF THE SIGNAL CONTROLLER.

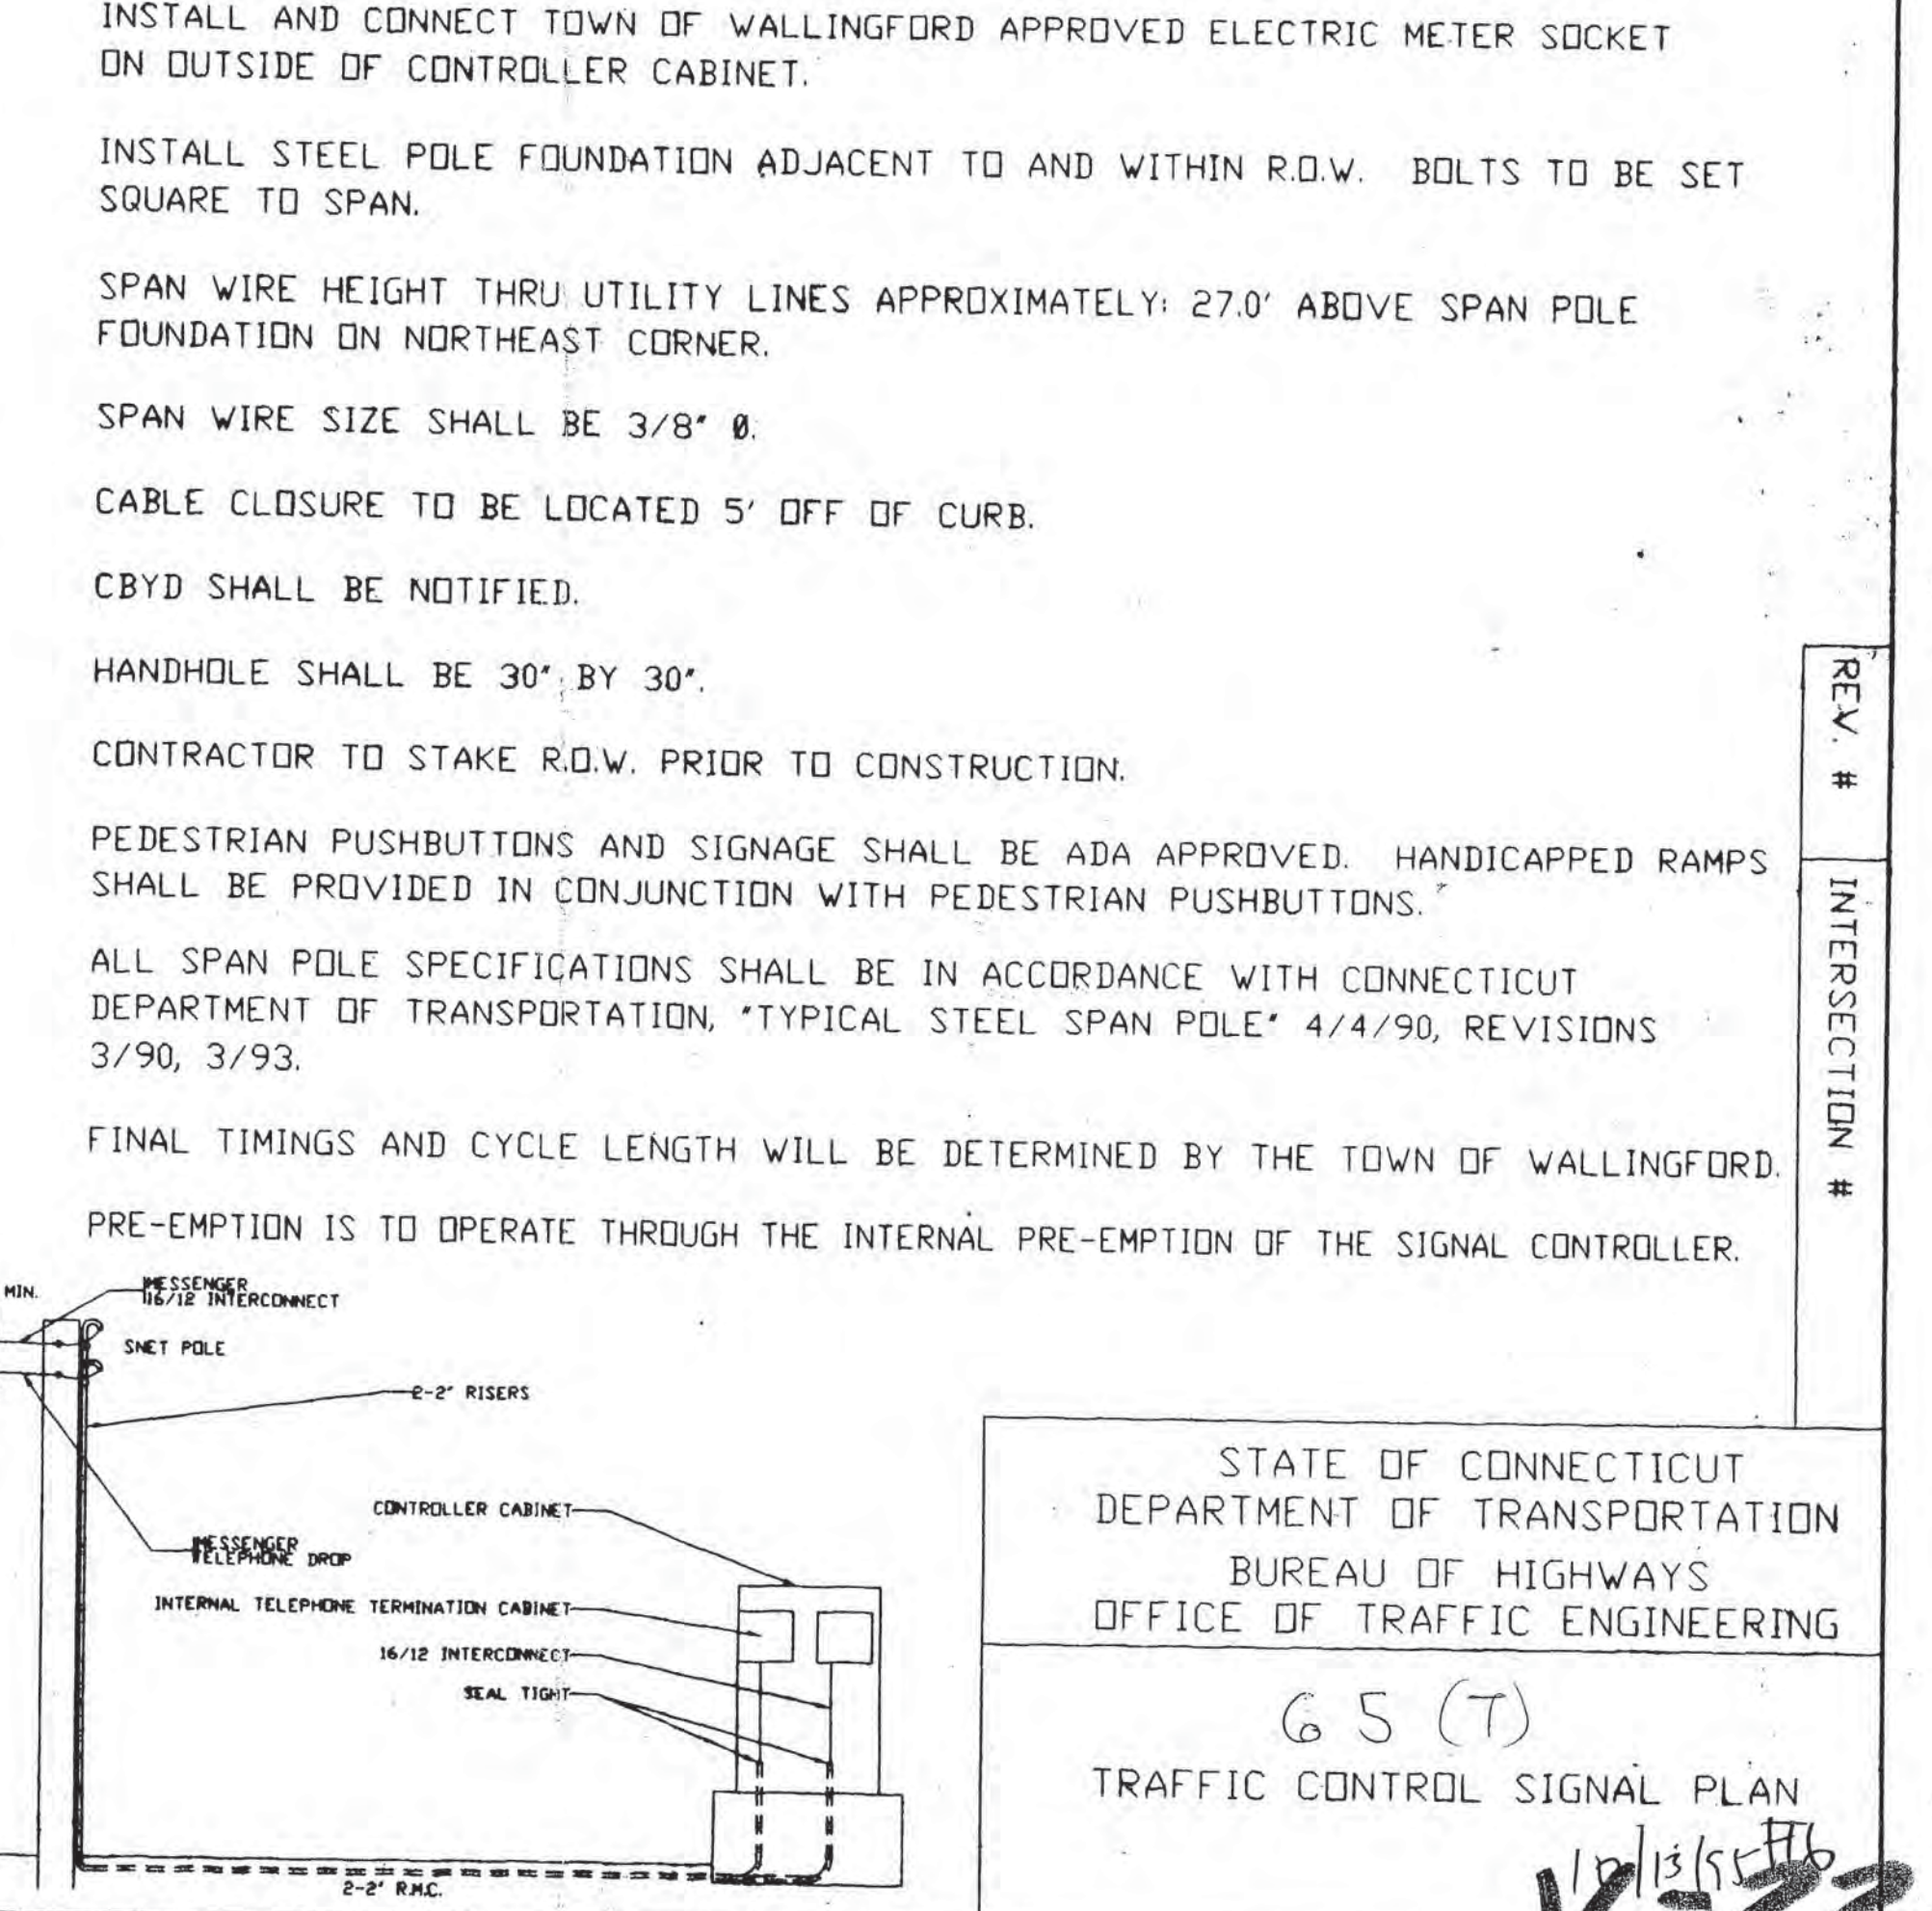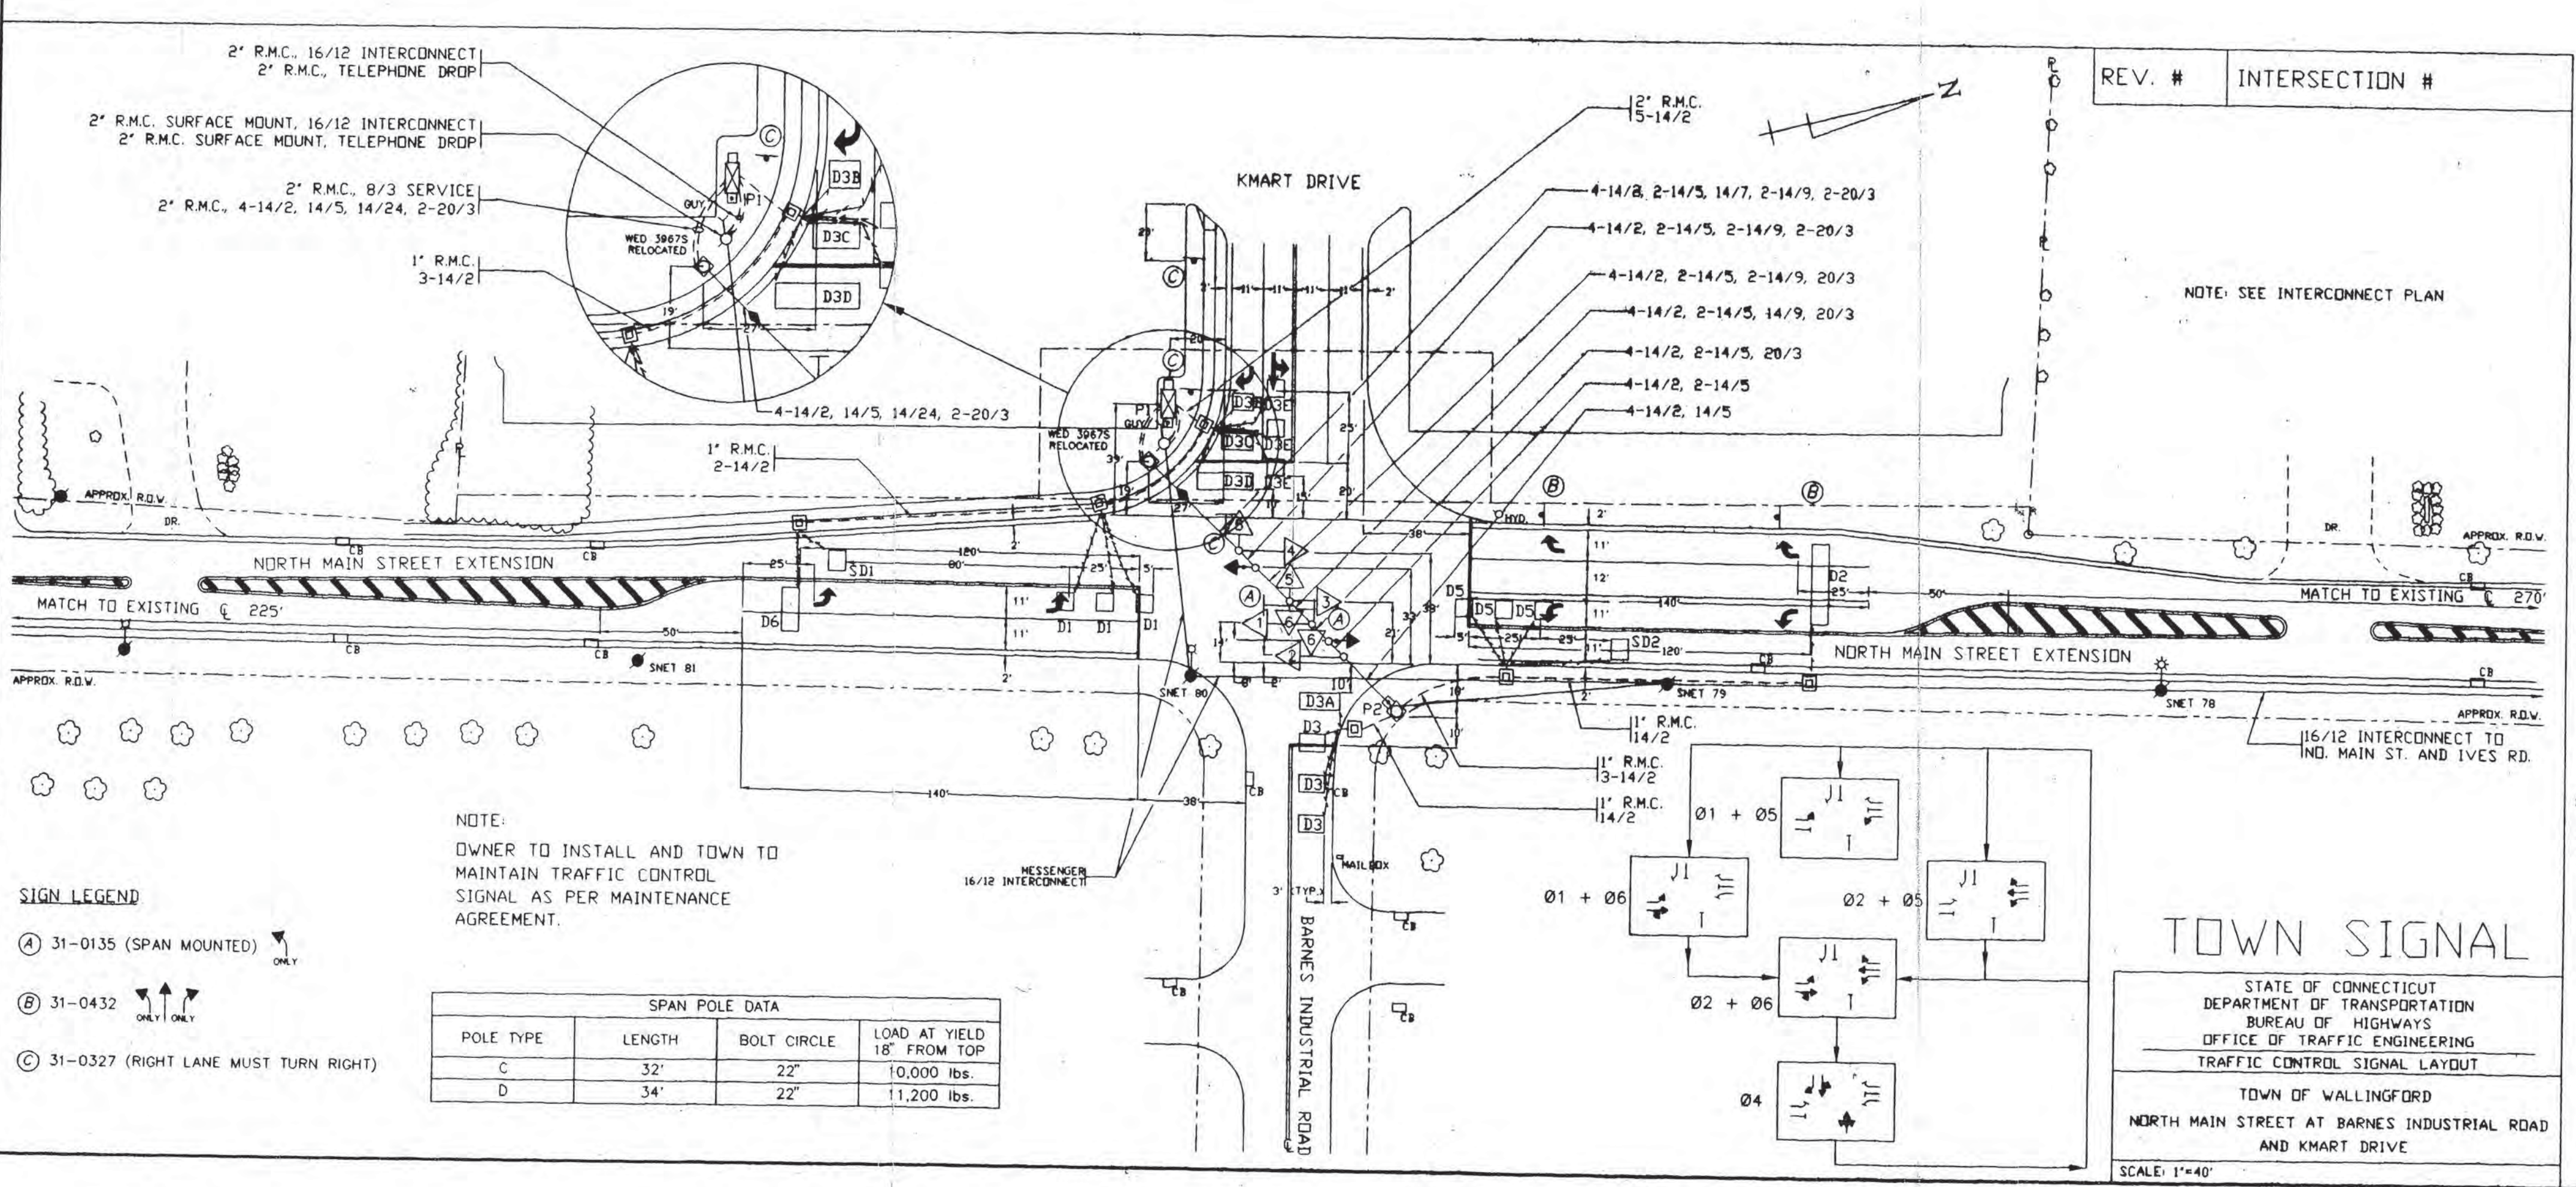

B:\K\MART2 Fr Oct 13 12:49:36 1995

F.H.W.A. REGION NO.	STATE	TOWN	FED. AID PROJ. NO.	PROJ. NO.	YEAR	ROUTE NO.	SHEET NO.	TOTAL SHEETS
1	CONN.	WALLINGFORD	N/A		1988	N/A	19	43

N/T OR	MOVEMENT DIAGRAM																								F O P L A S H I N G O N		
	PHASE 1			PHASE 2			PHASE 3			PHASE 4			PHASE 5			PHASE 6			PHASE 7			PHASE 8					
	GRN	CL	CL	GRN	CL	CL	GRN	CL	CL	GRN	CL	CL	GRN	CL	CL	GRN	CL	CL	GRN	CL	CL	GRN	CL	CL	GRN	CL	CL
1	G	Y	G	G	Y	R				R	R	R															
2	G	G	G	G	Y	R				R	R	R															
3	R	R	R	G	Y	R				R	R	R															
4	R	R	R	R	R	R				G	Y	R															
MIN	3	3	0	15	3	0				5	3	0															
MAX	12	5	2	40	5	2				20	5	2															

MIN GRN	3	15		5		
WALK				10		
PED CLR				1		
VEH EXT	2	2		2		
MAX 1	6	25		15		
MAX 2	6	25		15		
YELLOW	3	3		3		
RED		2		1		
ADD INI						
MAX INT						
TBR						
TTR						
MIN GAP						
MODE	MIN - RECALL	MIN - RECALL	OFF	NON - LOCK		
INI START						

IDENT	SIZE	TURNS	MODE	FUNCTION	PROGRAM	TIME	DAYS	COORDINATION	SYSTEM LOC	TECHNICAL NOTES
D1	6x6	3	PRESENCE							1 PHASE 2 TO OMIT PHASE 1
D2	6x6	3	DELAY 2"	FLASH	0000 - 0800	DAILY				2 PHASE 1 MUST PRECEDE PHASE 2
D3	6x6	3	PRESENCE		MAX 1	ALL TIMES	DAILY			
D4	6x15	2	DELAY 8"		MAX 2		FUTURE			
D5	6x6	3	DELAY 8"							
D6	6x10	3	PRESENCE							
D7	6x10	3	PRESENCE							

ENERGY BY - SHOPPING CENTER
SERVICE POLE - WED # 1874

OFFICE RECORD

JOB # 148-8810-03 SM # N/A
SIGNAL INSTALLED

INTERSECTION #

NORMAL 0.591 kW 487 hr/mo 287.82 kWh/mo
FLASH 0.308 kW 243 hr/mo 74.84 kWh/mo

24 hr
Norm

SIGNAL FACES

SIGNALS 4 TO HAVE 5" BACK PLATES

LEGEND

- R RED
- Y YELLOW
- G GREEN
- ← RED ARROW
- ← YELLOW ARROW
- ← GREEN ARROW
- WS WALK/FL DW
- DW DON'T WALK
- FL FLASHING
- PROPOSED WOOD SPAN POLE
- EXISTING WOOD SPAN POLE
- PROPOSED STEEL SPAN POLE
- EXISTING STEEL SPAN POLE
- PROPOSED UTILITY POLE
- EXISTING UTILITY POLE
- PEDESTAL MOUNTING
- PEDESTRIAN PUSH BUTTON AND SIGN
- TRAFFIC SIGNAL FACE
- PEDESTRIAN SIGNAL FACE
- LOOP DETECTOR
- MAGNETIC DETECTOR
- ED SYSTEM DETECTOR

CONTROLLER

HANDHOLE

(RMC) RIBID METAL CONDUIT

STRAIN INSULATOR

MAGNETOMETER PROBES

CABLE CLOSURE

DET. LEADS IN SAW CUT

AUXILIARY TERMINATION CABINET

RADIO ANTENNA

TOWN SIGNAL

STATE OF CONNECTICUT
DEPT. OF TRANSPORTATION
BUREAU OF HIGHWAYS
DIVISION OF TRAFFIC

TRAFFIC CONTROL SIGNAL

TOWN OF WALLINGFORD
NORTH MAIN STREET AT
STOP & SHOP SHOPPING CENTER DRIVE


TRAFFIC	ELECTRICAL
DATE	DATE

FIELD SURVEY VANASSE HANGEN VANASSE HANGEN
ENGINEER BRUSTLIN, INC. BRUSTLIN, INC.
DRAFTER 8/24/88 8/24/88

CHECKED BY
SUBMITTED BY
APPROVED BY
DATE

CONSTRUCTION NOTES

- ALL TRAFFIC SIGNAL EQUIPMENT SHALL BE NEW.
 - CONTROLLER SHALL BE 4-PHASE TRANSYT MODEL 1880E LARGE FRAME WITH TIME BASE COORDINATOR MANUFACTURED BY TRANSYT CORPORATION OF TALLAHASSEE, FLA
 - DETECTORS SHALL BE CENTERED WITHIN THE LANE AND 8' APART UNLESS OTHERWISE SPECIFIED.
 - STRAIN POLES:
 - POLE #1: 32' STEEL STRAIN POLE, Ø GAUGE, F_y = 48,000 PSI-ASTM A595, 14" DIAMETER, BASE PLATE 2" x 20 1/2" x 20 1/2" - ASTM A36, BOLT CIRCLE - 20" DIAMETER, ANCHOR BOLTS 2"x96" ASTM A-675 GR90 OR APPROVED EQUAL.
 - POLE #2: 28' STEEL STRAIN POLE, Ø GAUGE, F_y = 48,000 PSI-ASTM A595, 14" DIAMETER, BASE PLATE 2" x 20 1/2" x 20 1/2" - ASTM A36, BOLT CIRCLE - 20" DIAMETER, ANCHOR BOLTS 2"x96" - ASTM A-675 GR90 OR APPROVED EQUAL.
 - THE CONTRACTOR WILL BE REQUIRED TO PROVIDE AND INSTALL A 60 AMP WEATHERPROOF DISCONNECT ON THE STEEL SPAN POLE. THE DISCONNECT SHALL BE A CUTLER - HAMMER SAFETY SWITCH, HEAVY DUTY SINGLE THROW, 222 NDK NEMA RATED 12 (3R), OR APPROVED EQUAL. ALL WIRING SHALL BE IN COMPLIANCE WITH TABLE 373-6(b) OF THE NATIONAL ELECTRICAL CODE.
 - OWNER'S NAME AND ADDRESS: MR. MARVIN M. SHILLER
WALLINGFORD DEVELOPMENT CORPORATION
C/O M.M. SHILLER ASSOCIATES
767 FIFTH AVENUE, 27TH FLOOR
NEW YORK, NEW YORK 10153
- CONTACT INDIVIDUAL: MARVIN M. SHILLER

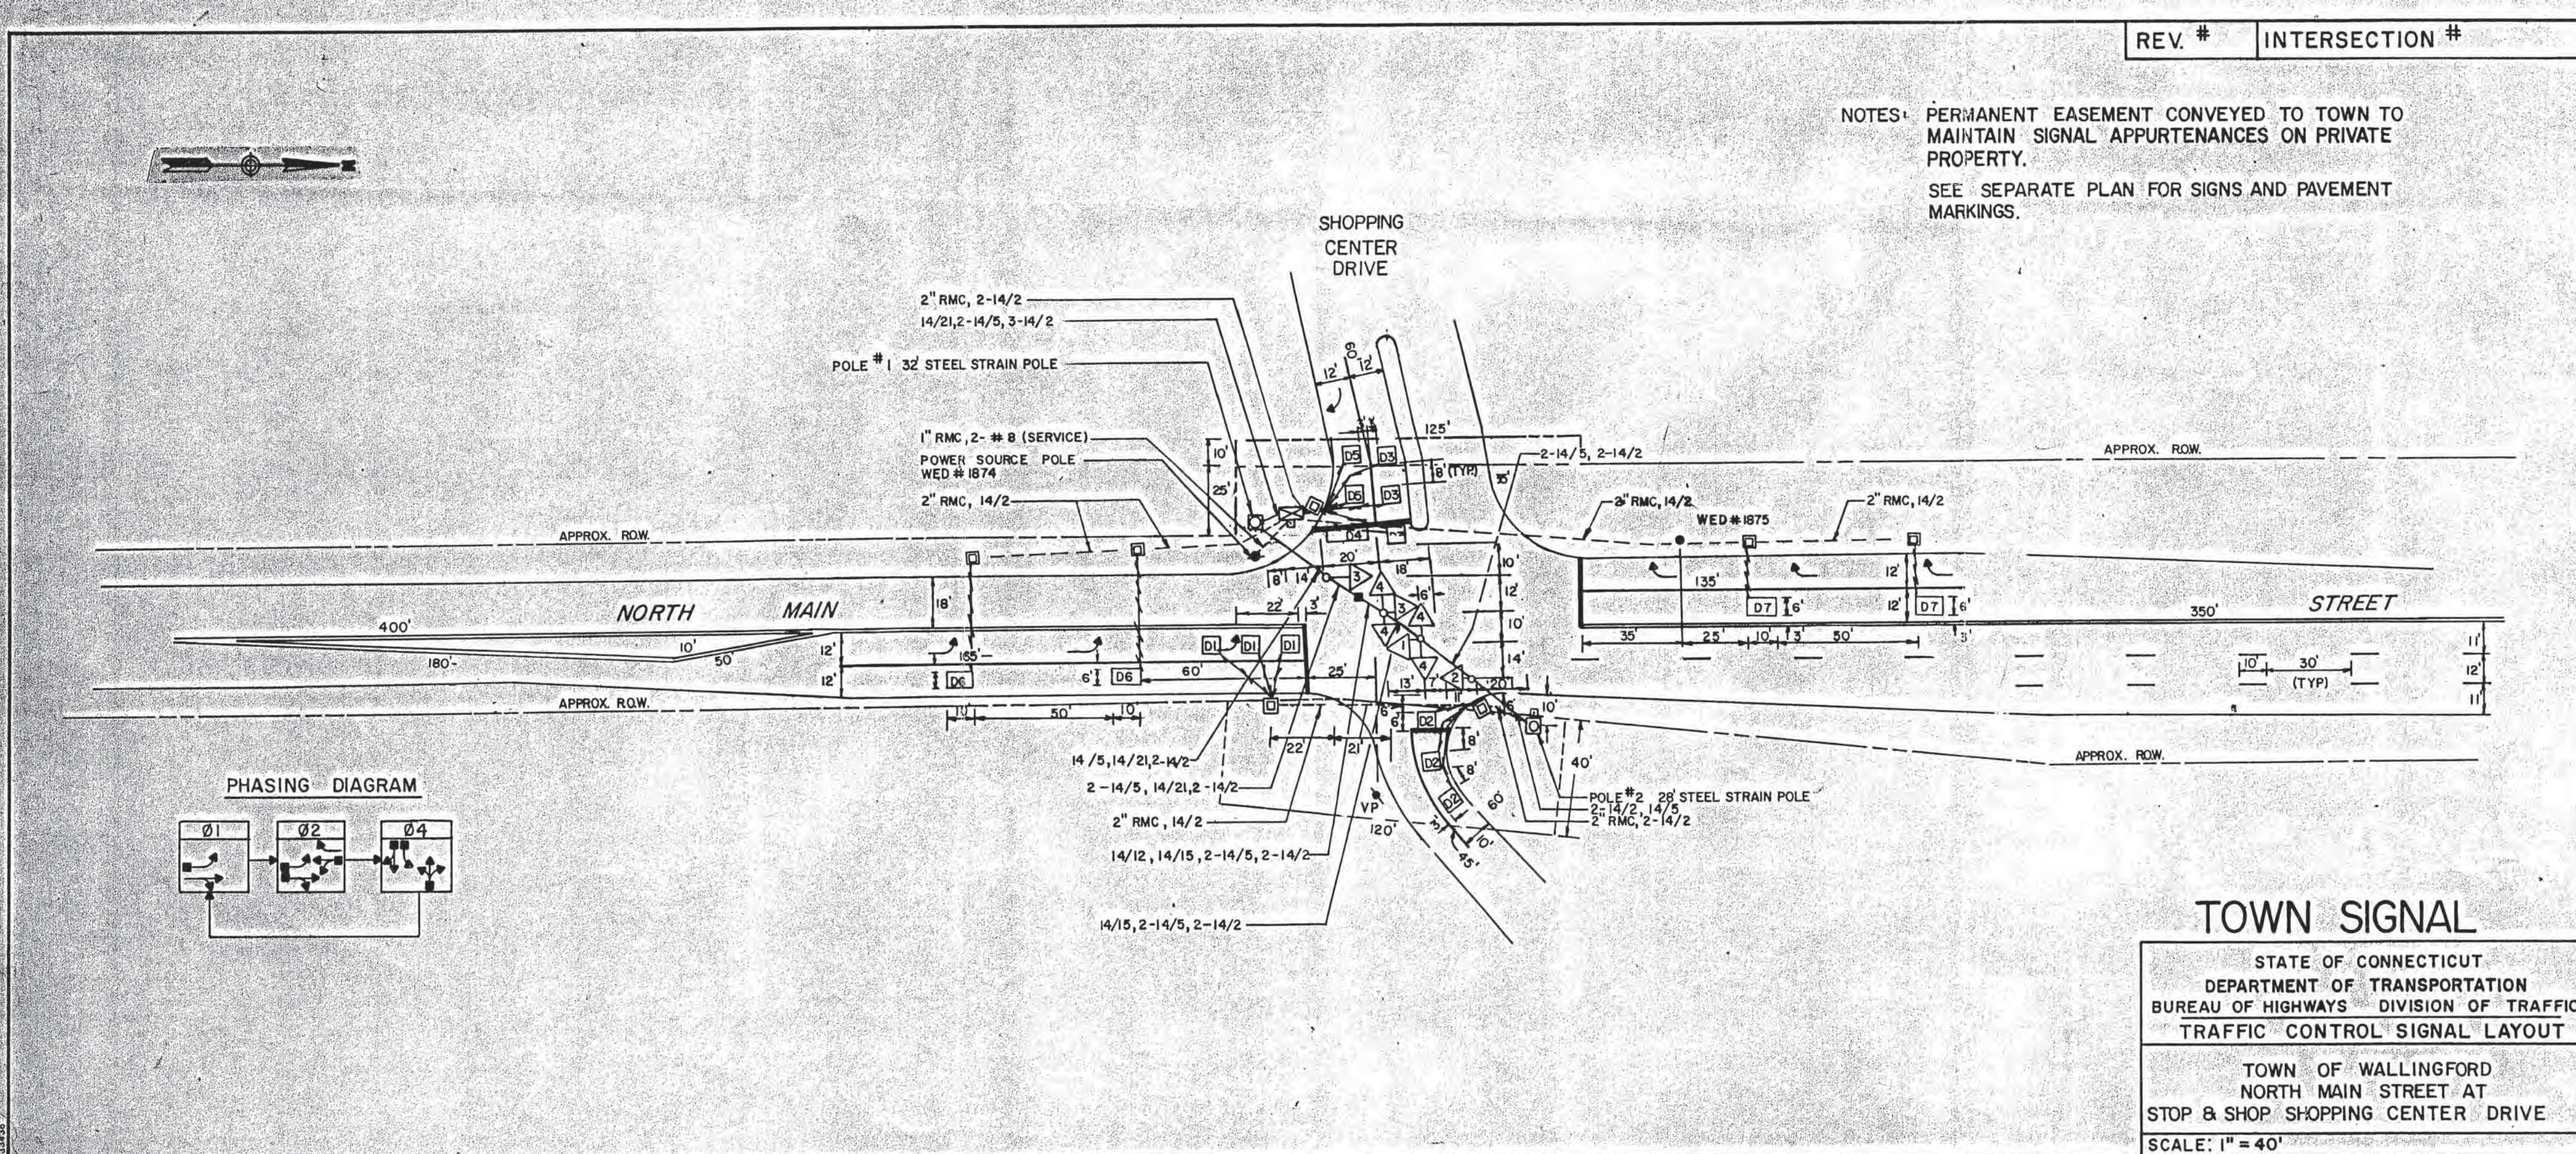

TOWN SIGNAL

STATE OF CONNECTICUT
DEPARTMENT OF TRANSPORTATION
BUREAU OF HIGHWAYS
DIVISION OF TRAFFIC

WALLINGFORD
N. MAIN ST./RTE. 68/RTE. 5
TRAFFIC CONTROL SIGNAL PLAN 677

REV. # INTERSECTION #

11-212

F.H.W.A. REGION NO.	STATE	TOWN	FED. AID PROJ. NO.	PROJ. NO.	YEAR	ROUTE NO.	SHEET NO.	TOTAL SHEETS
1	CONN.	WALLINGFORD	STPZ-2552(105)	148-165	1996	-	2	5

FACE #	NTOR	MOVEMENT DIAGRAM								PHASE 4	PHASE 5	PHASE 6	PHASE 7	PHASE 8					
		PHASE 1		PHASE 2		PHASE 3		PHASE 4							PHASE 5		PHASE 6		PHASE 7
		GRN	CL	CL	GRN	CL	CL	GRN	CL	CL	GRN	CL	CL	GRN	CL	CL	GRN	CL	CL
1					G	Y	R												
2					G	Y	R												
3					R	R	R												
4					R	R	R												
	MIN				15	3	1												
	MAX				50	5	2												
	MIN GRN				15														
	WALK																		
	PED CLR																		
	VEH EXT				5														
	MAX 1				30														
	MAX 2																		
	YELLOW				3														
	RED																		
	ADD INT																		
	MAX INT																		
	TBR																		
	TTR																		
	MIN GAP																		
	MODE	OFF			MIN RECALL			OFF			NON LOCK								
	INI START																		

ENERGY BY -- TOWN
SERVICE BY -- ED 6347

OFFICE RECORD

JOB# SM# N/A
REVISION
NEW SIGNAL

INTERSECTION

NORMAL	kW	hr/mo	kWh/mo
FLASH	kW	hr/mo	kWh/mo

METER SERVICE

SIGNAL FACES

TOWN SIGNAL

LEGEND

- R RED
- Y YELLOW
- G GREEN
- WALK/FL/DW
- FL FLASHING
- PROPOSED WOOD SPAN POLE
- EXISTING WOOD SPAN POLE
- PROPOSED STEEL SPAN POLE
- EXISTING STEEL SPAN POLE
- PROPOSED UTILITY POLE
- EXISTING UTILITY POLE
- PEDESTAL MOUNTING
- PEDESTAL PUSH BUTTON AND SIGN
- TRAFFIC SIGNAL FACE
- PEDESTRIAN SIGNAL FACE
- LOOP DETECTOR
- EXISTING PEDESTAL MOUNTING
- SYSTEM DETECTOR

CONTROLLER

EXIST. CONTROLLER

HANDHOLE

EXIST. HANDHOLE

(RMC) RIGID

METAL CONDUIT

STRAIN INSULATOR

MAGNETOMETER PROBES

CABLE CLOSURE

DET. LEADS IN SAW CUTS

AUXILIARY TERMINATION CABINET

RADIO ANTENNA

AUXILIARY EQUIPMENT CABINET

STATE OF CONNECTICUT
DEPARTMENT OF TRANSPORTATION
BUREAU OF HIGHWAYS
DIV. OF TRAFFIC ENGINEERING

TRAFFIC CONTROL SIGNAL

TOWN OF WALLINGFORD
BARNES ROAD AT BARNES INDUSTRIAL ROAD

REV. #

REV.	DATE	DESCRIPTION
1	8/9/96	FIELD SURVEY
2		DRAWER
3		CHECKED BY
4		SUBMITTED BY
5		APPROVED BY
6		DATE

DETECTORS


IDENT	SIZE	TURNS	MODE	FUNCTION	TIME (EST)	DAYS
D1	8'x6'	3	PRESENCE	MAX 1	ALL THE TIMES	DAILY
D4	6'x6'	3	PRESENCE			
D4A	12'x6'	3	8" DELAY			
D4B	10'x6'	3	8" DELAY			
D4C	9'x6'	3	PRESENCE			

COORDINATION

CYCLE	OFFSET SEC	YIELD PT SEC	PERMIS PERIOD	FORCE OFF %


TECHNICAL NOTES

STANDARD OVERLAP SKIP FEATURES APPLY

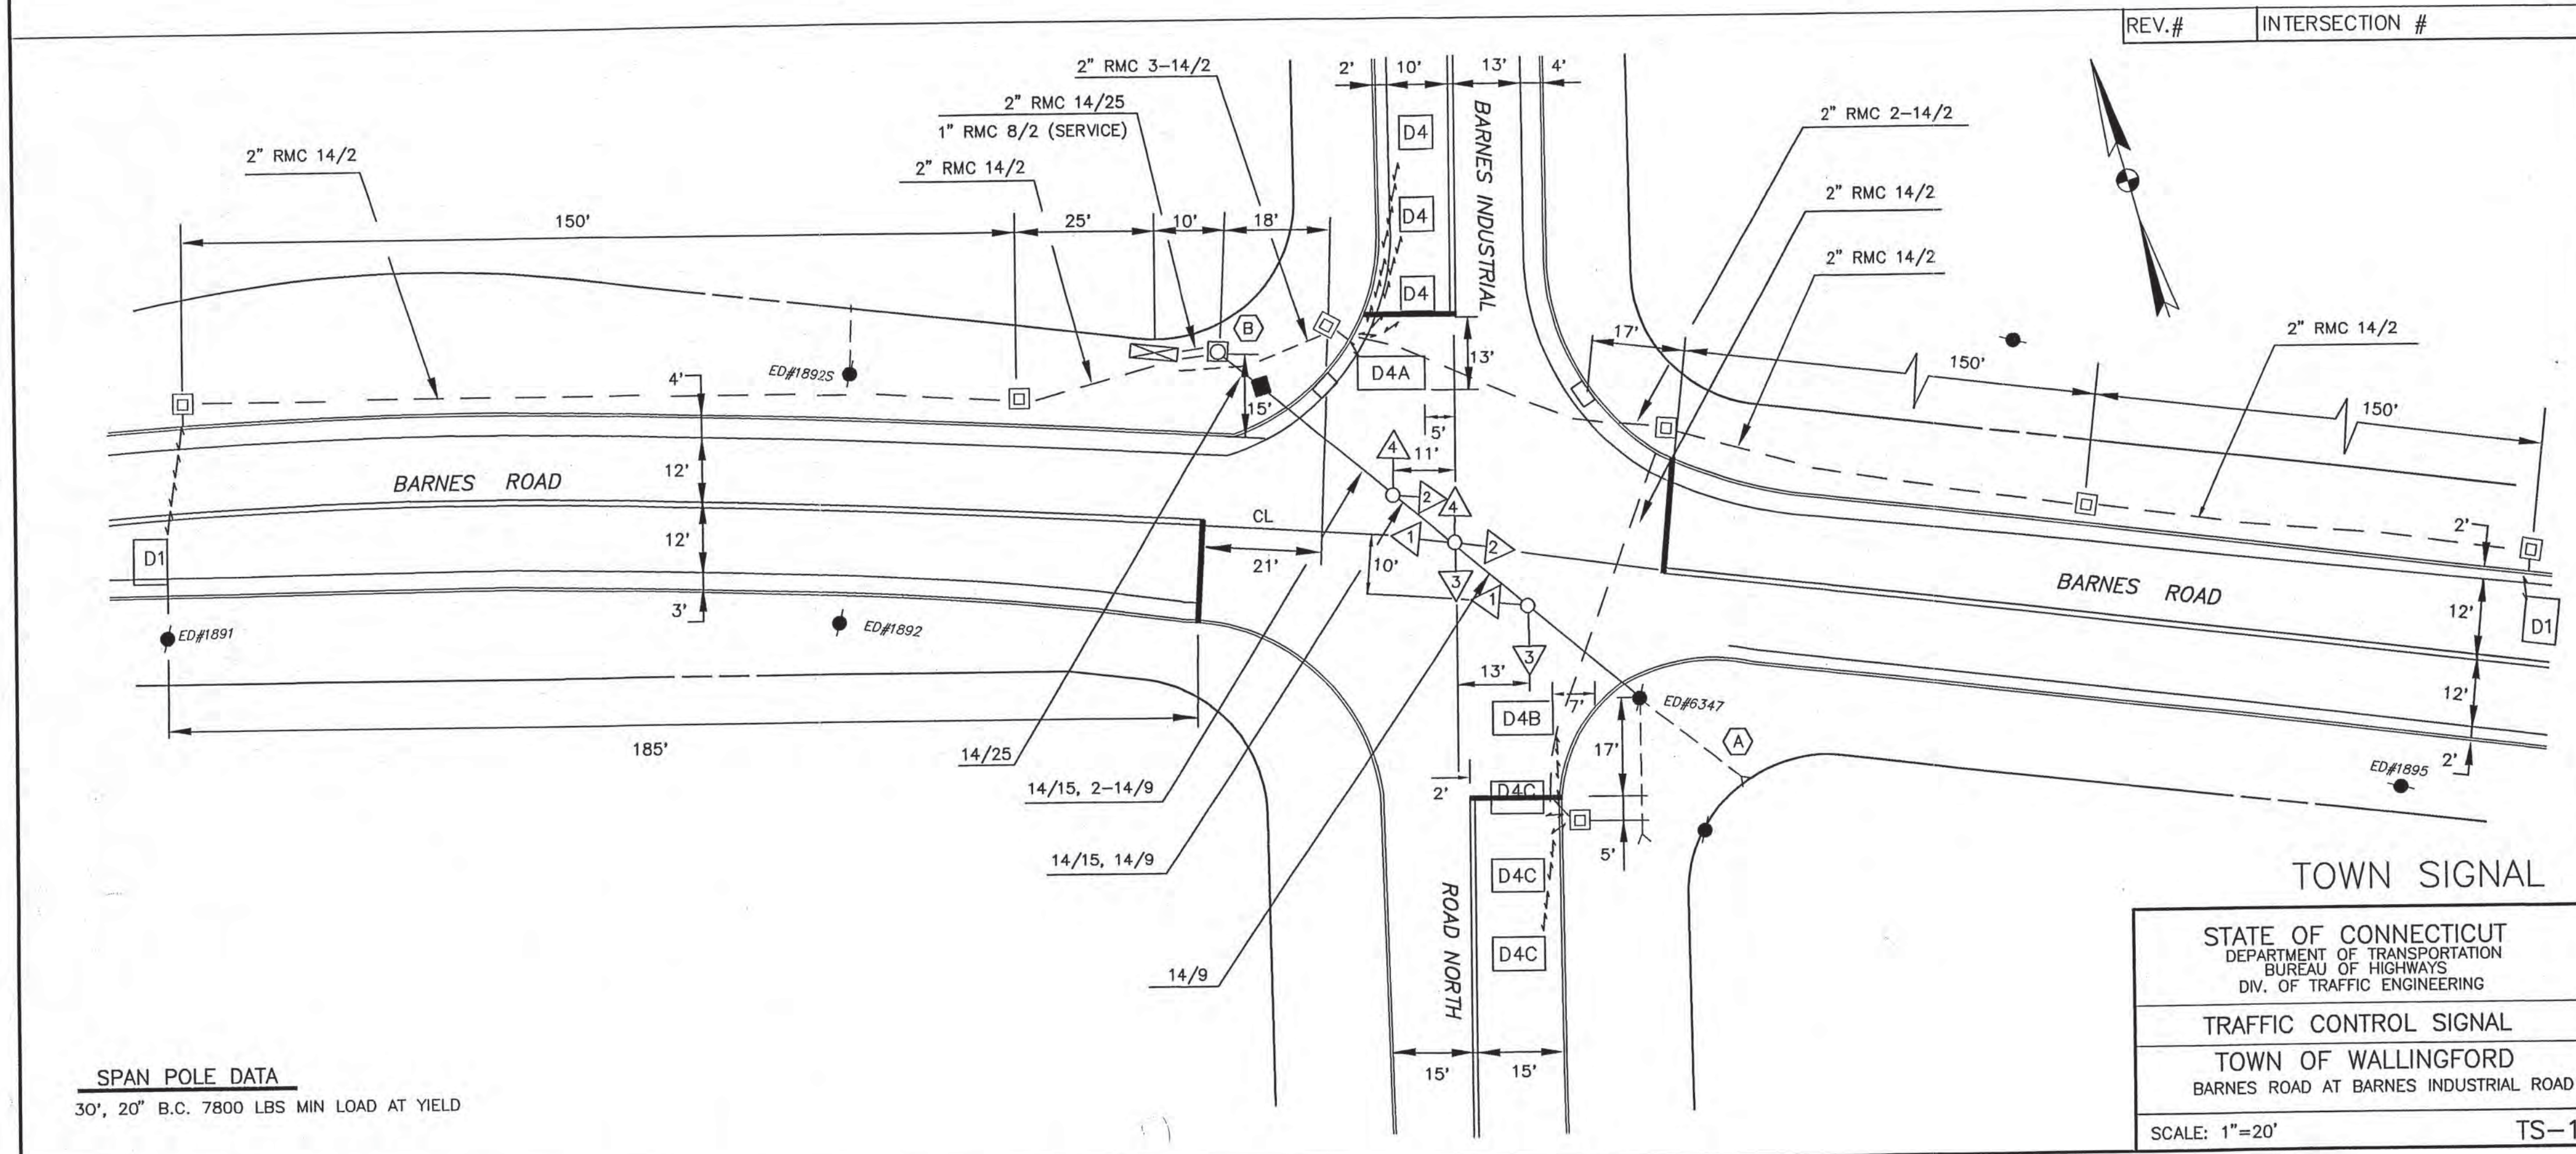

CONSTRUCTION NOTES

- ALL SIGNAL EQUIPMENT ARE NEW.
- ALL HANDHOLES TO BE INSTALLED 2' OFF EDGE OF ROAD.
- INSTALL LOOP DETECTORS 3' OFF EDGE OF ROAD AND 8' APART UNLESS OTHERWISE SPECIFIED.
- REMOVE ALL PAVEMENT MARKINGS/SIGNS THAT CONFLICT WITH THIS PLAN.
- INSTALL TYPE IV FOUNDATION WITH TYPE B CONTROLLER CABINET. CABINET DOOR TO OPEN ROAD SIDE.
- THE CONTRACTOR SHALL CONTACT "CALL BEFORE YOU DIG" 48 HOURS PRIOR TO ANY EXCAVATION TO BE PERFORMED (CALL B.U.D. 1-800 922-4455).
- THE SPAN WIRE SHOULD BE A MINIMUM OF 40" ABOVE COMMUNICATION CABLES AND A MINIMUM OF 12" BELOW THE SECONDARY WIRES.
- CONTACT MR. JAMES RAINEY AT WALLINGFORD ELECTRIC DIVISION (265-0308) FOR ELECTRIC SERVICE AND ANCHOR FOR ED #6347.
- INSTALL A 60 AMP DISCONNECT ON STEEL SPAN POLE.
- ANCHOR WOOD POLE
- INSTALL A 60 AMP DISCONNECT ON STEEL SPAN POLE. DISCONNECT TO BE MOUNTED 11' FROM BASE OF STEEL SPAN POLE.

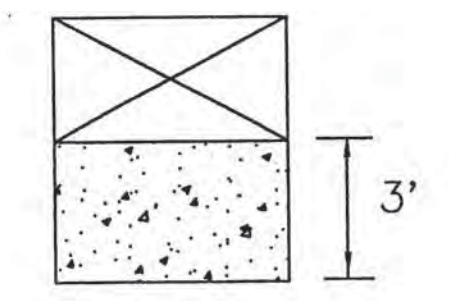

INSTALL TYPE I EPOXY RESIN PAVEMENT MARKINGS ON BARNES ROAD AND BARNES INDUSTRIAL ROAD NORTH AS INDICATED:



- 12" STOP BARS (140')
- 4" DYCL (400')
- 4" WHITE EDGE LINE (400')

STATE OF CONNECTICUT
DEPARTMENT OF TRANSPORTATION
BUREAU OF HIGHWAYS
DIV. OF TRAFFIC ENGINEERING

TRAFFIC CONTROL SIGNAL

SCALE: 1"=20'

TS-1

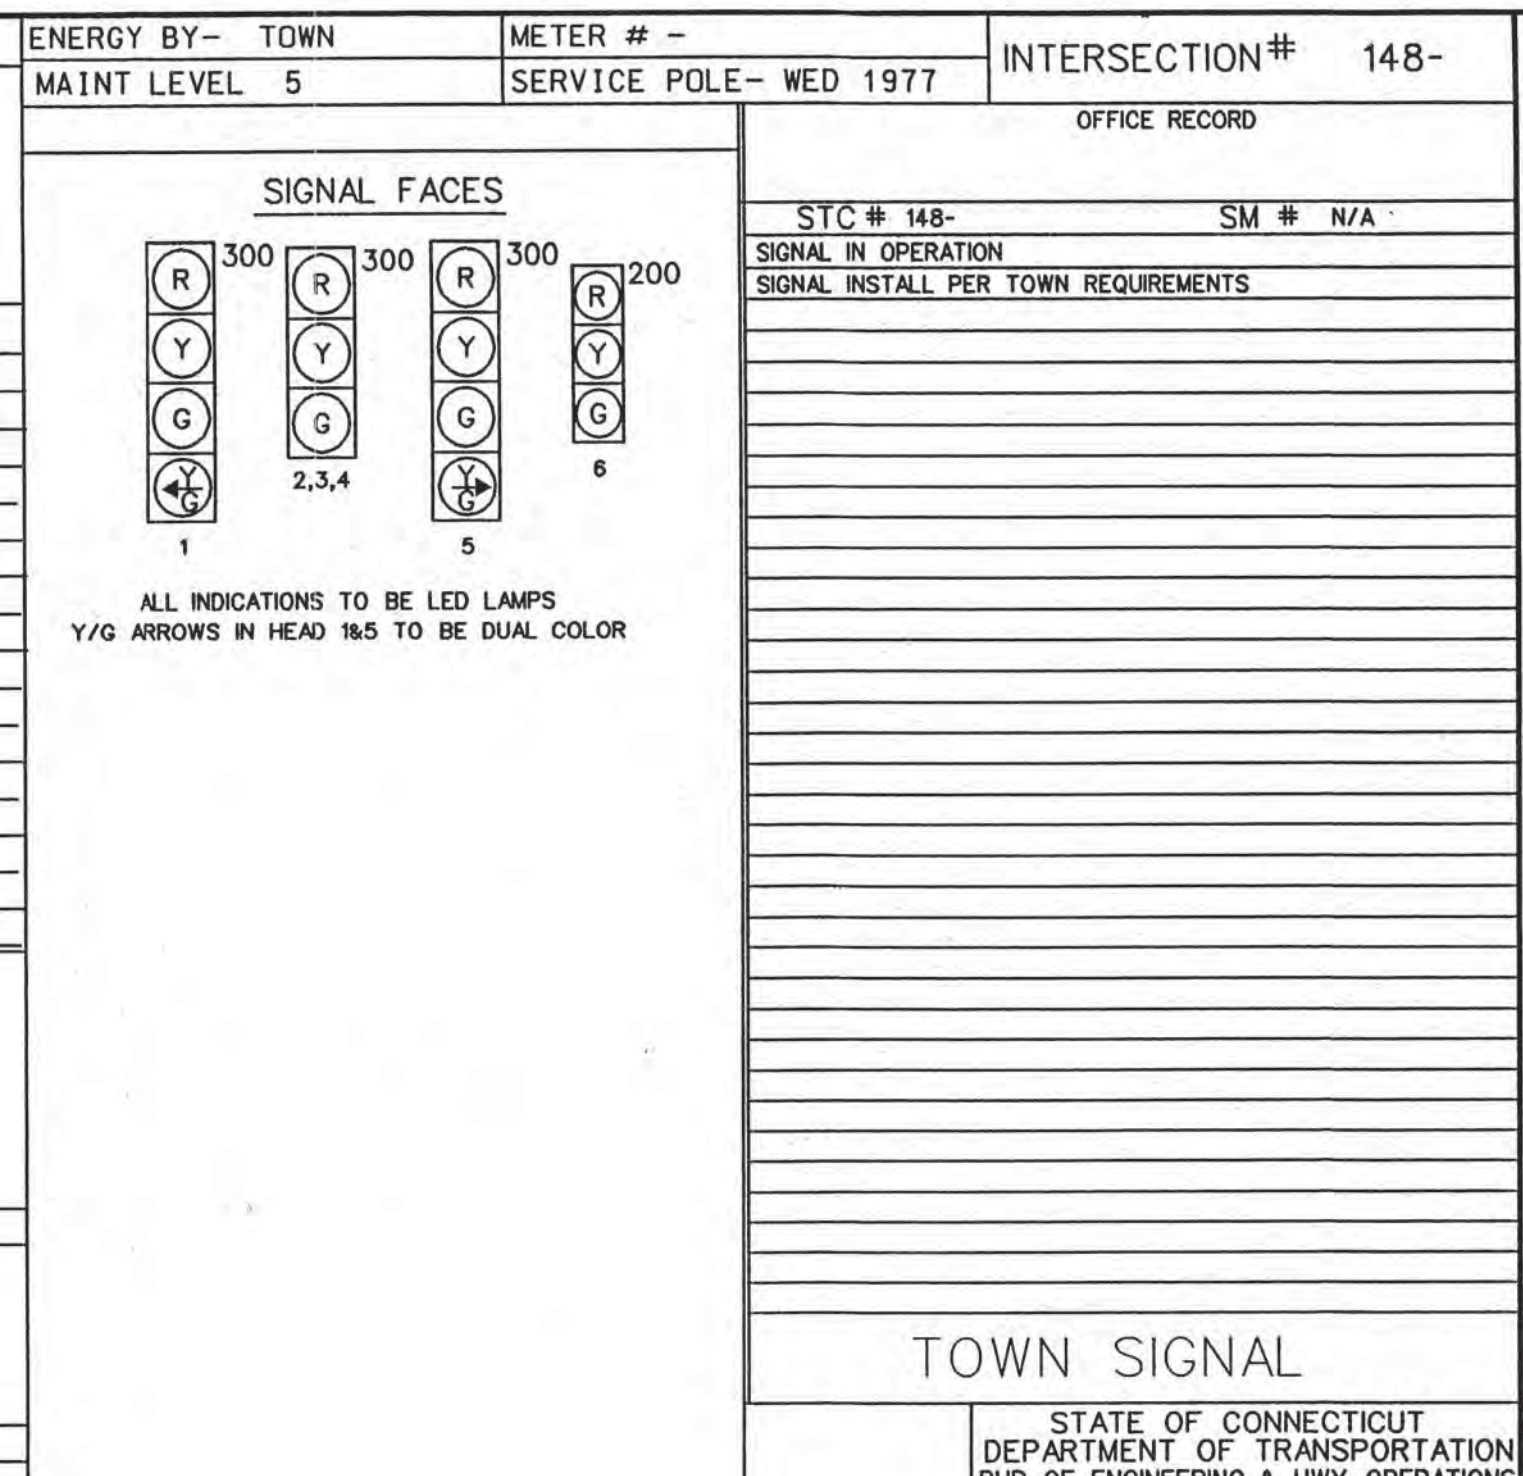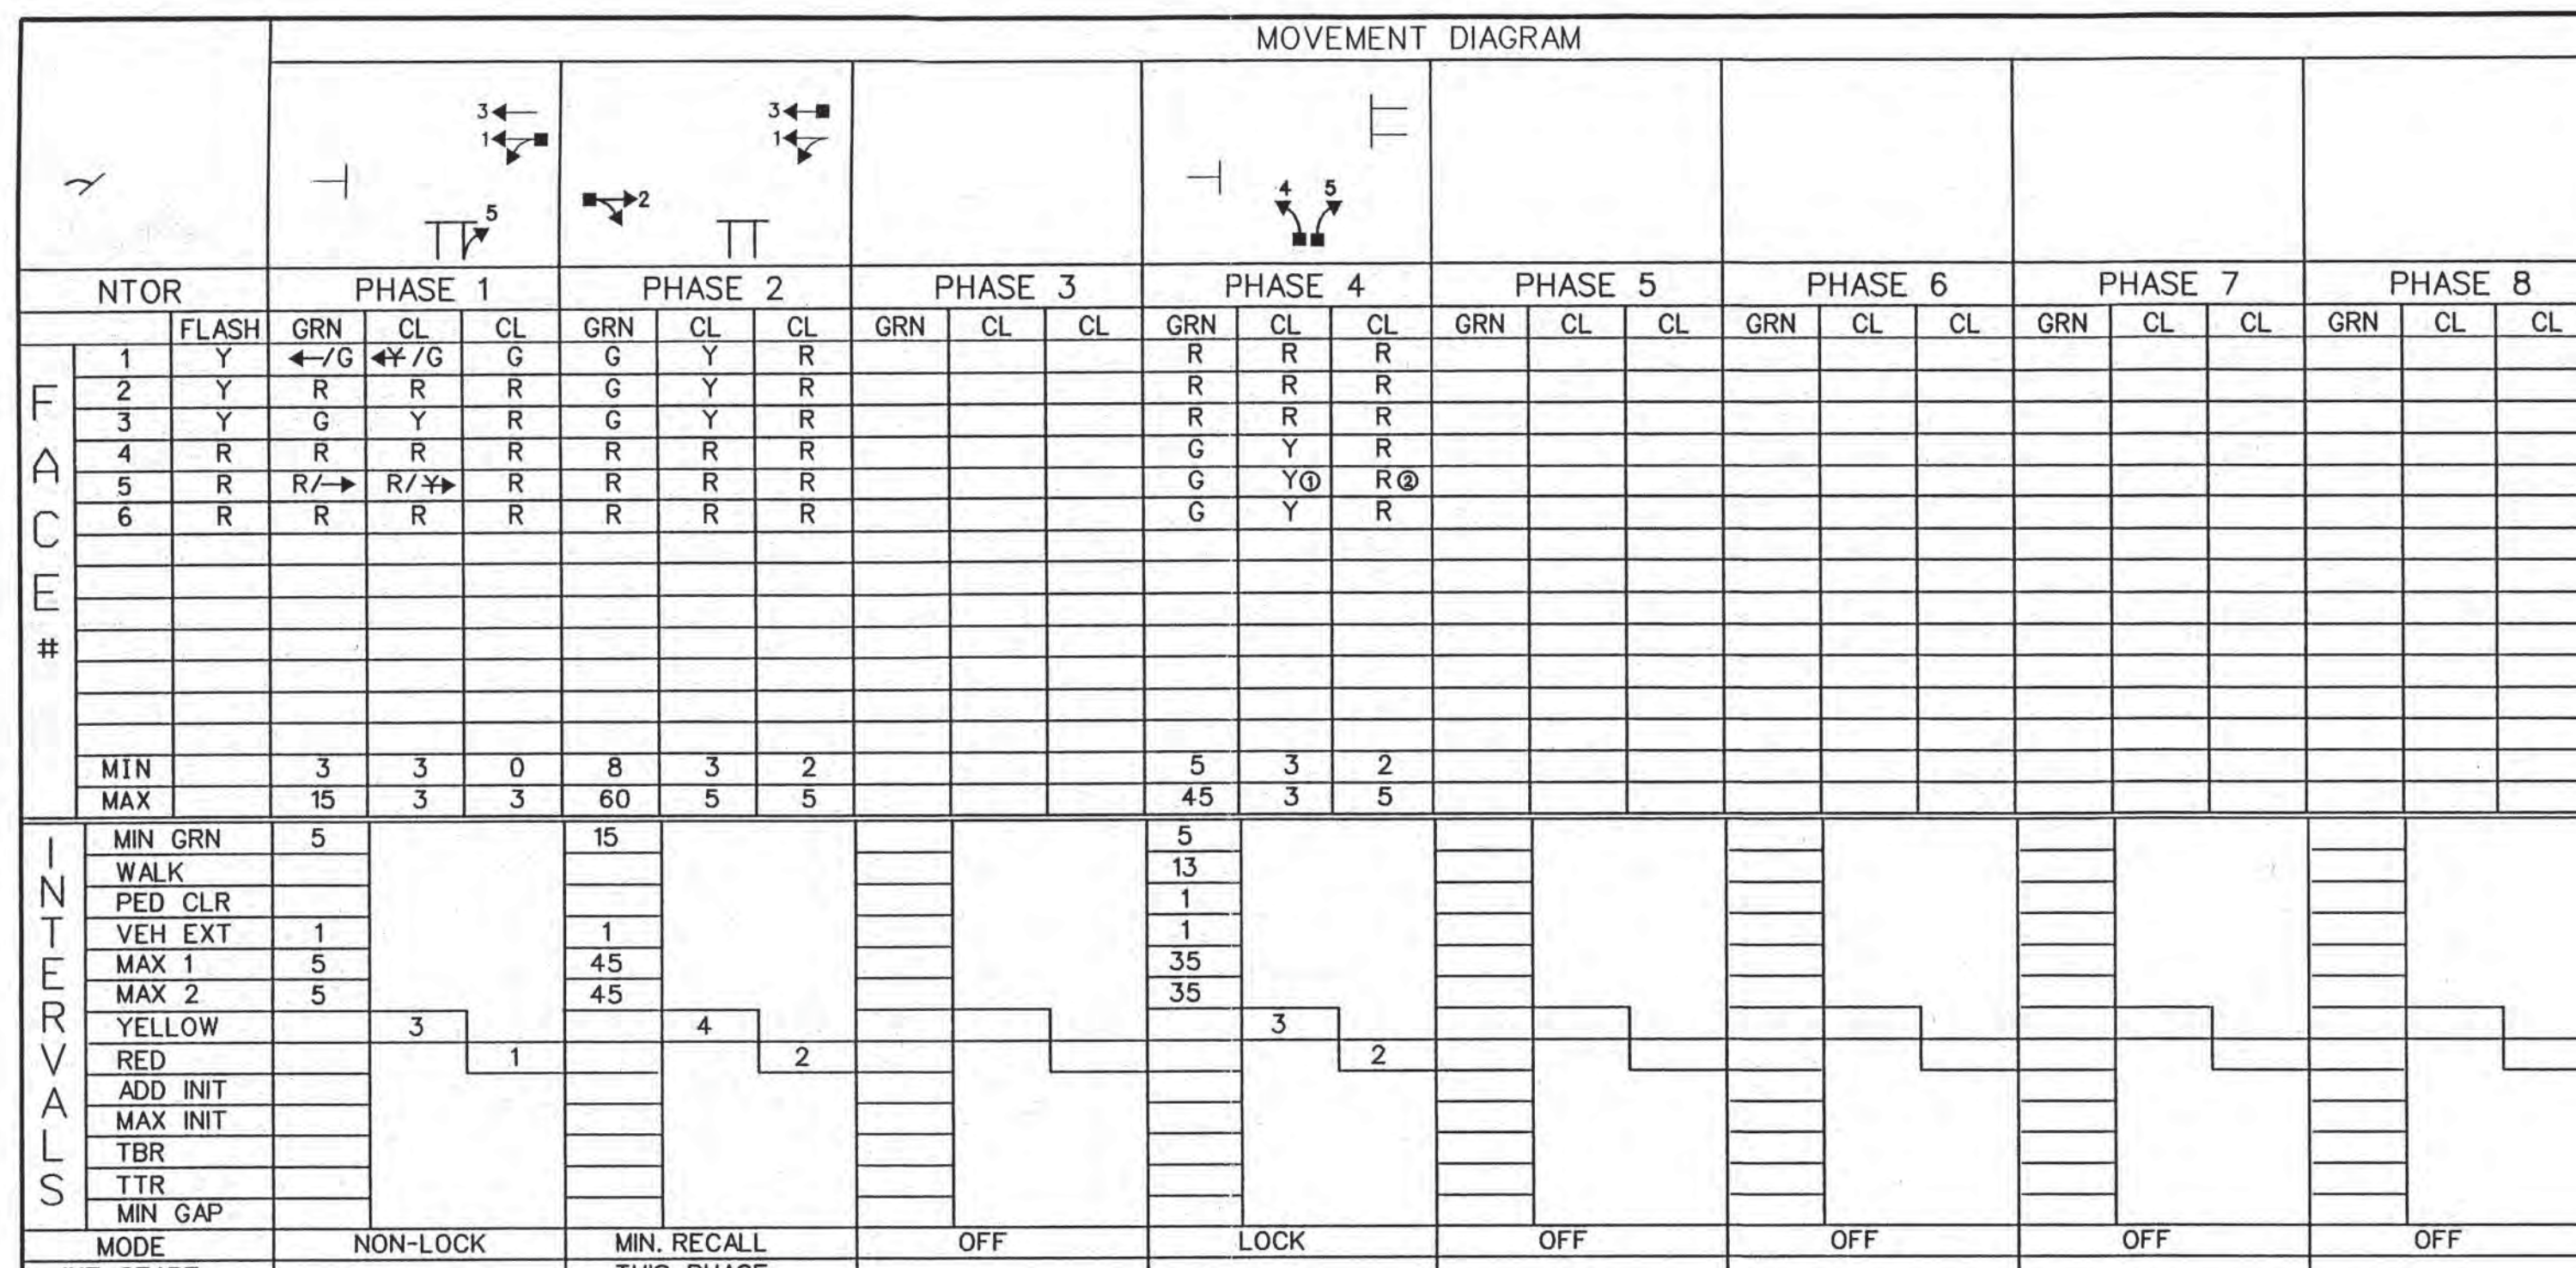

INTERVALS

MIN GRN	WALK	PED CLR	VEH EXT	MAX 1	MAX 2	YELLOW	RED	ADD INIT	MAX INIT	TBR	TTR	MIN GAP
5				5	5	3	1					
15			1	45	45	4	2					
			1	35	35	3	2					
			1	35	35							

MODE

MODE	NON-LOCK	MIN. RECALL THIS PHASE	OFF	LOCK	OFF	OFF	OFF	OFF	OFF
INT START									

DETECTORS


IDENT	SIZE (WXL)	TURNS	MODE	FUNCTION	TIME	DAYS	COORDINATION TYPE-	PERMIS	SYSTEM LOC
D1	1800 X 1800	3	PRESENCE	FLASH	EMERGENCY ONLY				MASTER
SD1	1800 X 1800	3	PRESENCE	MAX 1	ALL TIMES				TOWN
SD2	1800 X 1800	3	PULSE	MAX 2	FUTURE				ENGINEERS
SD3	1800 X 1800	3	PULSE						OFFICE
D4	3600 X 1800	-3	PRESENCE						
D4A	2400 X 1800	3	PRESENCE						
D4B	3600 X 1800	3	PRESENCE						
D4C	2400 X 1800	3	PRESENCE						
SD4	1800 X 1800	3	PRESENCE						
SD5	1800 X 1800	3	PRESENCE						
SD6	1800 X 1800	3	PULSE						
SD7	1800 X 1800	3	PULSE						
SD8	1800 X 1800	3	PULSE						

TECHNICAL NOTES

STANDARD OVERLAP SKIP FEATURES APPLY
 PHASE 1 SHALL ALWAYS BE FOLLOWED BY PHASE 2.
 PHASE 4 SHALL ONLY FOLLOW PHASE 2.
 ⓐ TO BE Y/→ IF PHASE 1 IS NEXT
 ⓑ TO BE R/→ IF PHASE 1 IS NEXT
 PHASE 2 ON, OMIT PHASE 1

SIGN LEGEND

(A) ERECT 31-0290
 (B) ERECT 31-1526

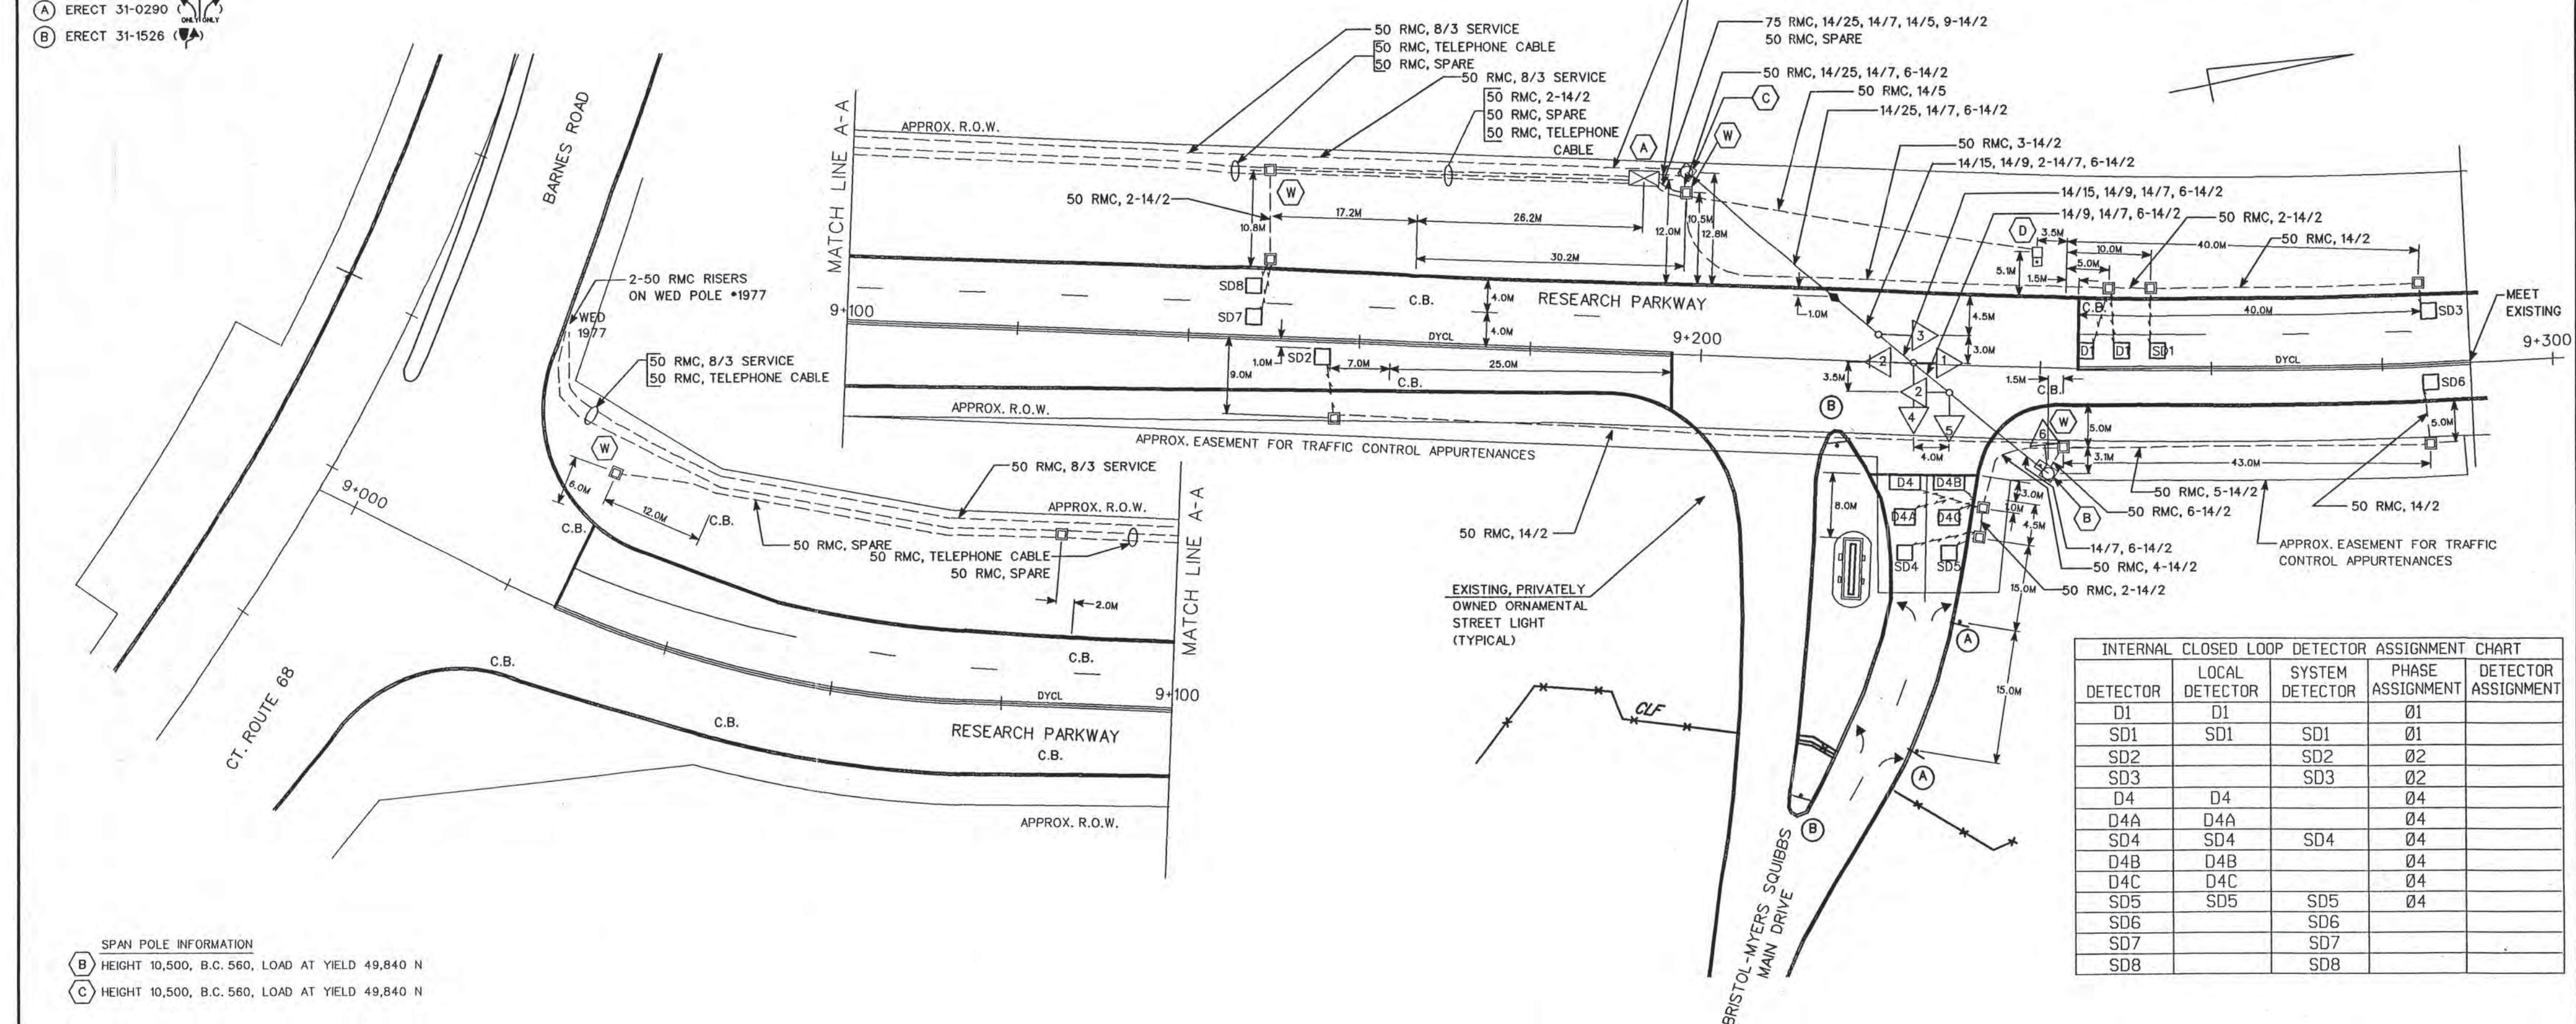

NO.	DATE	INIT.	DESCRIPTION

CONSTRUCTION NOTES

1. ALL WORK SHALL BE COMPLETED IN ACCORDANCE WITH THE TOWN OF WALLINGFORD AND THE STATE OF CONNECTICUT DEPARTMENT OF TRANSPORTATION.
 2. ALL TRAFFIC SIGNAL EQUIPMENT IS NEW.
 3. STAKE ALL R.O.W. PRIOR TO EXCAVATION.
 4. REPLACE DOUBLE YELLOW CENTERLINE AND LANE LINES ON RESEARCH PARKWAY FROM THE NORTH SIDE OF BARNES ROAD (ROUTE 68) NORTHERLY APPROXIMATELY 265 METERS TO STATION 9+290 AND ON THE BRISTOL MYERS SQUIBB SITE DRIVEWAY FROM RESEARCH PARKWAY EASTERLY APPROXIMATELY 40 METERS.
 5. LOOP DETECTORS ARE TO BE INSTALLED 1.0 METERS OFF THE CURB OR EDGE OF ROAD AND 2.4 METERS APART UNLESS OTHERWISE SPECIFIED.
 6. INSTALL HANDHOLES APPROXIMATELY 0.3M BEHIND CURB OR EDGE OF ROAD UNLESS OTHERWISE SPECIFIED.
 7. CABINET DOOR TO OPEN FIELD SIDE.
 8. IN ACCORDANCE WITH ALL APPLICABLE NEC CODES, THE CONTRACTOR SHALL FURNISH AND INSTALL A 60-AMP WEATHERPROOF DISCONNECT SWITCH MOUNTED ON THE STEEL SPAN POLE AT A HEIGHT OF 3 METERS ABOVE FINISHED GRADE. THE DISCONNECT SHALL BE A CUTLER-HAMMER SAFETY SWITCH, HEAVY DUTY SINGLE THROW, 222 NDK-NEMA RATED 12(3R) DEVICE.
 9. ALL PAVEMENT MARKINGS TO BE INSTALLED BY CONTRACTOR AS PER PLAN AND IN ACCORDANCE WITH TOWN AND MUTCD STANDARDS. MAINTENANCE OF PAVEMENT MARKINGS WILL BE DONE BY THE TOWN OF WALLINGFORD.
- (W) INSTALL 760 X 760 HANDHOLE. ALL OTHERS TYPE II.
 (A) INSTALL 8 PHASE FULL ACTUATED MASTER/LOCAL CONTROLLER (PEEK TRANSYT SERIES 3000) WITH EXTERNAL ELECTRIC METER AND TELEPHONE COMMUNICATION MEDIUM IN CONTROLLER CABINET ON TYPE IV TRAFFIC CONTROL FOUNDATION. DOOR TO OPEN FIELD SIDE. INSTALL CONCRETE PAD ADJACENT TO CONTROLLER DOOR.
 (B) 10,500mm SPAN POLE WITH PEDESTRIAN SIGNAL, PEDESTRIAN PUSH BUTTON AND SIGN.
 (C) 10,500mm SPAN POLE WITH SERVICE DISCONNECT SWITCH. FOUNDATION FOR POLE (C) MUST BE EXTENDED 0.65m (TOTAL DEPTH EQUALS 3650) AND THE TOP SET AT ELEVATION 108.35 m.
 (D) 1,000mm ALUMINUM PEDESTAL WITH PEDESTRIAN PUSH BUTTON AND SIGN.

UTILITY CONTACTS

- | | |
|---|--|
| <p>Ms. Suzanne P. Paddock
 Supervisor - O.N.E
 Southern New England Telephone
 1441 North Colony Road
 Meriden, CT. 06450
 (203) 238-5620</p> <p>Mr. Art Dutra
 Wallingford Electric
 100 John Street
 Wallingford, CT. 06492
 (203) 294-2271</p> <p>Mr. Dean P. Muratori
 Construction Manager
 AT&T Cable Services
 222 New Park Drive
 Berlin, CT. 06037
 (860) 505-6248</p> | <p>Mr. John P. Thompson, P.E.
 Town Engineer, Town of Wallingford
 29 Town Farm Road
 Wallingford, CT. 06492
 (203) 294-2035</p> <p>Mr. Leo Luciano
 Yankee Gas Services
 47 Eagle Street
 Waterbury, CT. 06708
 (203) 596-3104</p> <p>Mr. Vincent Mascia
 Town Of Wallingford Water & Sewer Dept.,
 377 South Cherry Street
 P.O. Box 725
 Wallingford, CT. 06492
 (203) 949-2672</p> |
|---|--|

CONNECTICUT DEPARTMENT OF TRANSPORTATION

PROJECT TITLE: TRAFFIC CONTROL SIGNAL
 RESEARCH PKWY @ BRISTOL MYERS SQUIBB DRIVE

TOWN: WALLINGFORD
 DRAWING TITLE: TRAFFIC SIGNAL PLAN SHEET

PROJECT NO. 1
 DRAWING NO. 1
 SHEET NO. 7

V-250
(697)

RECEIVED

JUL 24 2000
STATE TRAFFIC COMMISSION

CONSTRUCTION NOTES

- ① ALL FLASHING BEACON EQUIPMENT IS NEW. ALL WORK TO BE DONE IN CONFORMANCE WITH 814A AND AS AMENDED. ALL NEW TRAFFIC CONTROL EQUIPMENT AND SIGNS SHALL BE FIELD LOCATED AND APPROVED BY THE TOWN PRIOR TO CONSTRUCTION.
- ② SPAN ATTACHMENT TO UTILITY POLES WED #310 AND WED #311 TO BE BELOW SECONDARIES.
- ⑥ INSTALL TRAFFIC CONTROL CABINET TYPE A ON 4'-4" ALUMINUM PEDESTAL. CABINET DOOR TO OPEN STREET SIDE.
- ⑦ INSTALL 35' CLASS III UTILITY POLE WITH ANCHOR.
- ⑧ INSTALL 4-150 WATT SPOT LIGHT ASSEMBLY AT THE BOTTOM OF THE SIGNAL HOUSING. A MANUAL SWITCH SHALL BE PROVIDED AT THE CABINET WHICH IS ACCESSIBLE ONLY TO AUTHORIZED PERSONNEL. THE FLASHER AND SPOT LIGHT SHALL BE WIRED ON SEPARATE SWITCHES.
- ③ CONTRACTOR SHALL CONTACT "CALL BEFORE YOU DIG" (1-800-922-4455) PRIOR TO ANY EXCAVATION.
- ④ SPAN WIRE SHALL BE 3/8" DIA. EXTRA STRENGTH 15,400 LBS MAXIMUM BREAKING STRENGTH.
- ⑤ ELECTRICAL SERVICES TO THE CONTROLLER SHALL BE COORDINATED WITH THE WALLINGFORD ELECTRIC DIVISION. CONTACT: MR. ART DUTRA, WALLINGFORD ELECTRIC DIVISION 1-(203) 265-0308 TO COORDINATE. THE CONTRACTOR SHALL PAY ALL COST AND FEES FOR OBTAINING ELECTRICAL SERVICES.

TOWN OF WALLINGFORD CONTACT
 LT. ALAN ZAKRZEWSKI
 WALLINGFORD POLICE
 TRAFFIC MAINTENANCE DIVISION
 1-203-294-2815

MOVEMENT DIAGRAM

NONE		MOVEMENT DIAGRAM																								ENERGY BY- DEVELOPER		METER # -		INTERSECTION# N/A	
																										MAINT 24hr <input type="checkbox"/> Norm <input checked="" type="checkbox"/>		SERVICE POLE-WED #310		OFFICE RECORD	
																										METERED SERVICE					
																										SIGNAL FACES					
																										FACE 2 TO BE LED					
																										TOWN SIGNAL					
																										LEGEND					
																										STATE OF CONNECTICUT					
																										DEPARTMENT OF TRANSPORTATION					
																										BUR. OF ENGINEERING & HWY OPERATIONS					
																										DIVISION OF TRAFFIC ENGINEERING					
																										FLASHING BEACON					
																										TOWN OF WALLINGFORD					
																										COOK HILL ROAD AND					
																										DRIVE TO OAKDALE THEATER					
																										REV #		TRAFFIC ELECTRICAL			
																										ENGINEER		DATE			
																										DRAFTER		LANGAN ENGINEERING AND ENVIRONMENTAL SERVICES, INC.			
																										CHECKED BY					
																										SUBMITTED BY					
																										APPROVED BY					
																										DATE					

REV. # INTERSECTION # N/A

NOTES:
ALL PAVEMENT MARKINGS ARE EXISTING.

14/5, 14/3

COOK HILL ROAD

DRIVE TO OAKDALE THEATER

WED #310

WED #311

APPROX. R.O.W.

2" RMC, 8/3 (SERVICE)

2" RMC, 14/5, 14/3

50'


TOWN SIGNAL

STATE OF CONNECTICUT
DEPARTMENT OF TRANSPORTATION
BUR. OF ENGINEERING & HWY OPERATIONS
DIVISION OF TRAFFIC ENGINEERING

FLASHING BEACON LAYOUT

TOWN OF WALLINGFORD
COOK HILL ROAD AND
DRIVE TO OAKDALE THEATER

SCALE : 1"=40'

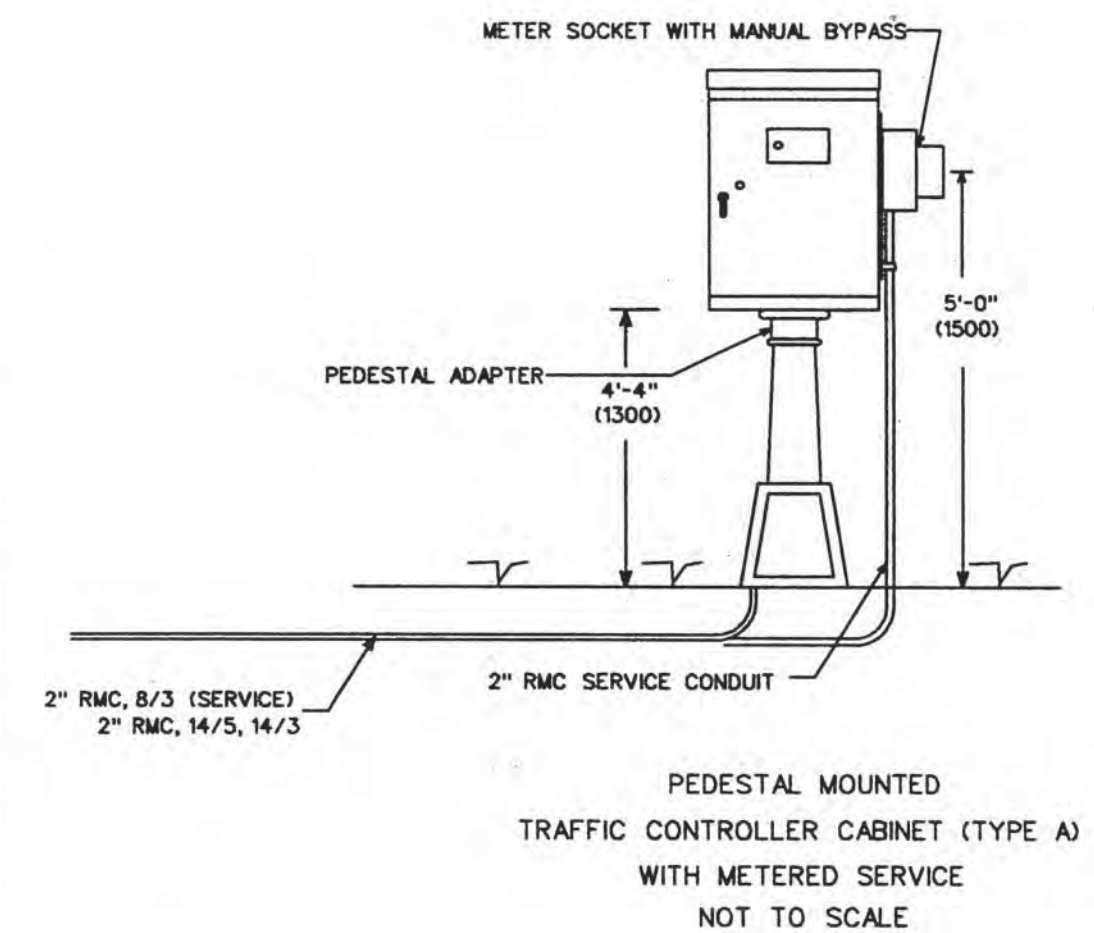


STATE OF CONNECTICUT
DEPARTMENT OF TRANSPORTATION
BUREAU OF ENGINEERING & HIGHWAY OPERATIONS
DIVISION OF TRAFFIC ENGINEERING

FLASHING BEACON

F.H.W.A. REGION NO.	STATE	TOWN	FED. AID PROJ. NO.	PROJ. NO.	YEAR	ROUTE NO.	SHEET NO.
1	CONN.	WALLINGFORD	N/A	N/A	97	N/A	

REV. # INTERSECTION #

73-T - SANTA CHERRY + JOAN ST.
START 2:25 P.M.

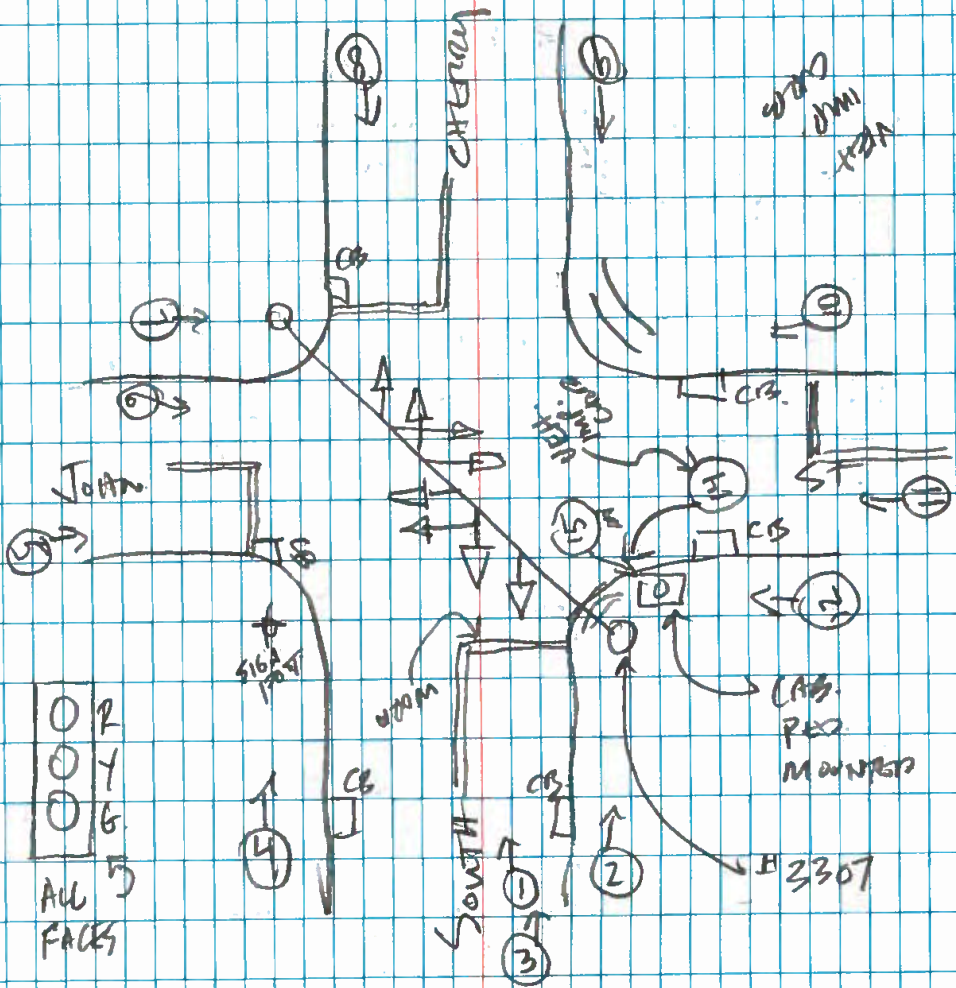


FINISH = 2:40 P.M.

75-T - OVERHEAD LITS @ CHURCH ST.

START - 2:50 P.M.

FACE #	NTOR	MOVEMENT DIAGRAM																								F O L D E R H A T I N G	I N T E R S E C T I O N #
		Normal Operation		Fire Pre-emption		PHASE 1		PHASE 2		PHASE 3		PHASE 4		PHASE 5		PHASE 6		PHASE 7		PHASE 8							
		GRN	CL	CL	GRN	CL	CL	GRN	CL	CL	GRN	CL	CL	GRN	CL	CL	GRN	CL	CL	GRN	CL	CL	GRN	CL	CL		
		FLY	Y	R	R	Y	R																				
		FLY	Y	R	R	Y	R																				

75-T CONT'D

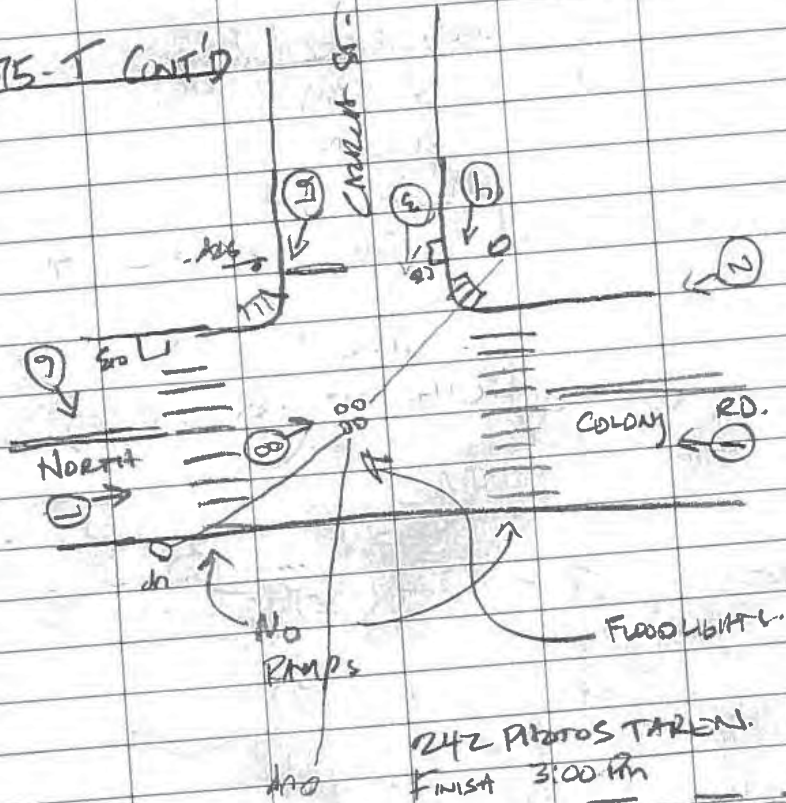

242 PHOTOS TAKEN.
FINISH 3:00 PM

APPENDIX B - FIELD INSPECTION SHEETS

4T

Field Inspection

SIGNAL EQUIPMENT EVALUATION FORM

CITY/TOWN _____

JOB# _____

DATE 7/1/12

LOCATION S. Colony Rd @ Walgreens

045

CONTROLLER CABINET INVENTORY									
Component	Local Controller	Master Controller	CM / MMU	Detector Amplifier	Time Clock	Preemption	Load Switches	Flasher	Cabinet
Quantity	1	N/A	1	5	N/A	1	4/12	1	1
Make	Peek		EDI	North Star Seaside		3M	PDC	PDC	Peek
Model #	3000E		NSM-12	10711-E 535T		752 Opticon	SSS-87WP	SSS-87WP	SS23
Serial #	N/A		232551			N/A	N/A	N/A	N/A
Comments:									

VEHICLE SIGNAL INVENTORY		
	Size	
	8"	12"
Red	3	4
Yellow	3	4
Green	3	4
R-Arrow		
Y-Arrow		1
G-Arrow		1
Comments:		

PEDESTRIAN SIGNAL INVENTORY												
	QUANTITY								PUSHBUTTON ASSEMBLY			
	Size				Illumination Method				Quantity	Working?	ADA Compliant?	
	9"	12"	16"	Countdown	Incandescent	LED	Fiber Optic	Poor Cond.?				
1 Section - Word									Button	2		10
1 Section - Symbol									Legend	2		
2 Section - Word									Audible	0		
2 Section - Symbol												
Comments: <u>R, Y, G 8" signal used as ped signals</u>												

04T

omit &1 if &2 is on
8 & Sequ.

SIGNAL SUPPORT QUANTITIES


		Post		Mast Arm		Span Wire	
		8'	10'	Truss	Monlever	Free	Tether
Post	Good					✓	
	Fair			X	X	X	X
	Poor			X	X	X	X

Comments:

φ Set	1	2	3	4	5	6	7	8	9
Min	3	15		5					
Ext.				2.0					
Max I	3	32		12					
Max II	3	32		12					
Yel	3.20	4.10		3.0					
Red	0.11	2.0		1.0					
Walk		15							
Ped Cl		1							
Lock				NL					
Recall	Max	Max							

Sketch of intersection signal phasing and signal layout:


- OUTLET FAN/THERMOSTAT LAMP *NO Bulbs*
- MAST ARM SPAN WIRE ORNAMENTAL
- VEH SIG 8" 12" Sect: 3 4 Bi 5 DH
- Inc FO LED OP Failure
- Fixed Freeswing Tether
- Color *Yellow/black* Backplate Visor
- PED SIG 9" 12" 16"
- Inc FO LED Failure
- Word Symbol Red/Yellow/green
- Pushbutton Audible Failure
- DETECTION Loop Video Magnetic
- Microwave Infrared Failure
- ADVANCE SIGNING None Static Illuminated
- NUMBER OF PHASES 2 3 4 5 6 7 8
- LEFT-TURN Perm. Prot. Lead Lag Simult
- PED PHASE None Exclusive Concurrent
- CYCLE LENGTH Max _____ Min _____
- CABINET PHOTOS

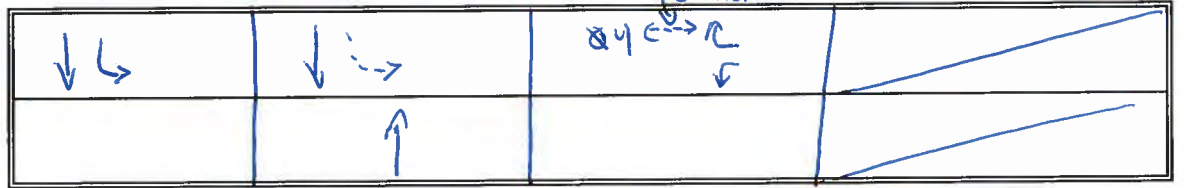

Det. Chn	φ
1-6 to	1-6
17	4
18	4
25	4
26	4

CPA I 02
WRM All
Int Max All
Ped Reg All

OLA = &1 & &2
No Coordination

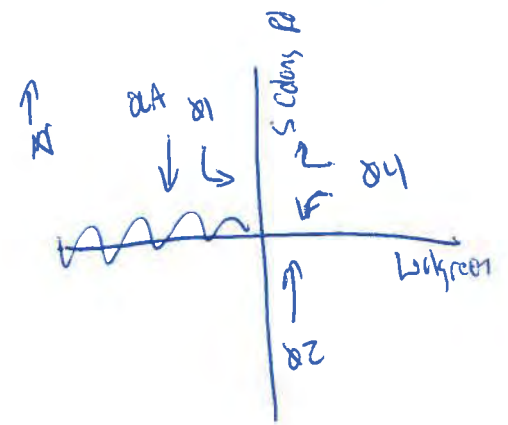

- Enable Run
- Railroad Preempt
- Input Lock
- Go to Higher Run
- NEMA Priority
- Override UCF

Maximum Intervals:

User Priority:

Duration Service:

Preempt Delay:

Reservice Time:

Inhibit Double Clearing OVL's

Min. Green:

Min. Yellow:

Min. Red:

Min. Ped. Clearance:

Min. Overlap Yellow:

- Go to Exit Phase
- Go to Next Demand
- Resume Sequence
- To Coordination:

*Valid
Well 1-3
Fixed 1-3
Exit 1*

FUNC\PH	1	2	3	4	5	6	7	8
Phases	<input type="checkbox"/>	<input checked="" type="checkbox"/>	<input type="checkbox"/>	<input type="checkbox"/>	<input type="checkbox"/>	<input type="checkbox"/>	<input type="checkbox"/>	<input type="checkbox"/>
Calls	<input type="checkbox"/>	<input type="checkbox"/>	<input type="checkbox"/>	<input type="checkbox"/>	<input type="checkbox"/>	<input type="checkbox"/>	<input type="checkbox"/>	<input type="checkbox"/>

RUN	INTVL #	TIME	FLASH PLAN	SIG OUTS	1 A	2 B	3 C	4 D	5 E	6 F	7 G	8 H	9 I	10 J	11 K	12 L	13 M	14 N	15 O	16 P
1	1	15			G															
TYPE				VEH																
TENTHS				PED																
EXIT				VEH O/L	G															
				PED O/L																
PC->YEL				OUTS																

RUN	INTVL #	TIME	FLASH PLAN	SIG OUTS	1 A	2 B	3 C	4 D	5 E	6 F	7 G	8 H	9 I	10 J	11 K	12 L	13 M	14 N	15 O	16 P
1	2	4			Y															
TYPE				VEH																
TENTHS				PED																
EXIT				VEH O/L	Y															
				PED O/L																
PC->YEL				OUTS																

RUN	INTVL #	TIME	FLASH PLAN	SIG OUTS	1 A	2 B	3 C	4 D	5 E	6 F	7 G	8 H	9 I	10 J	11 K	12 L	13 M	14 N	15 O	16 P
1	3	2																		
TYPE				VEH																
TENTHS				PED																
EXIT				VEH O/L																
				PED O/L																
PC->YEL				OUTS																

RUN	INTVL #	TIME	FLASH PLAN	SIG OUTS	1 A	2 B	3 C	4 D	5 E	6 F	7 G	8 H	9 I	10 J	11 K	12 L	13 M	14 N	15 O	16 P
TYPE				VEH																
TENTHS				PED																
EXIT				VEH O/L																
				PED O/L																
PC->YEL				OUTS																

Project: _____

City: _____

Location: _____

Date: 2/3/12

By: MSTW

Sheet: 047

DEPARTMENT OF TRANSPORTATION

PROJECT - _____ LOCATION # - 4-5 D.O.T. INSPECTOR - _____ DATE OF NEW SERVICE - _____
 TOWN - WALTON LOCATION - South Colony CONTRACTOR'S REP. - JFB CHANGE OVER DATE - _____
+ WALTONS
Dr.

LOOP DETECTOR TEST - (PERFORMED BY CONTRACTOR) SEE STANDARD SHEET TR-1000_01

TEST	INSULATION RESISTANCE (MEGGER)	LOOP CIRCUIT RESISTANCE	POWER INTERRUPTION
DATE			

PRELIMINARY VISUAL INSPECTION - (PERFORMED BY INSPECTOR)

DATE: 2/3/12

FOUNDATIONS	TR-1002_01
CTRL FND 4" ABOVE GROUND	Y
CONCRETE PAD (3'X4')	Y
CAST IN PLACE, BRUSH FINISHED	Y
CONDUITS BONDED TO GROUND ROD	Y
DUCT SEAL IN CONDUITS	Y

PEDESTALS	TR-1102_01
LOCATION	OK
PLUMB	OK
BONDED TO GROUND ROD	UNK.
CRUSHED STONE IN FOUNDATION CENTER	UNK.

PUSH BUTTONS	TR-1107_01
ADA TYPE BUTTON, (2" DIA.), PIEZO	OK
42" MOUNTING HEIGHT	OK
ACCESSIBLE FROM SIDEWALK/RAMP	OK

HANDHOLES	TR-1010_01
FLUSH WITH GRADE	Y
SET ON CRUSHED STONE BASE	YD
COVER & CONDUITS BONDED	YD
DUCT SEAL IN CONDUITS	YD

TRAFFIC SIGNALS	TR-1105_01
SPAN LAYOUT	OK
PLUMB APPEARANCE	OK ②
FACES: TYPE & LOCATION	OK ②
VISORS / LOUVERS / BACK PLATES	OK ③
MISSING HARDWARE: BOTTOM CAPS, ETC.	OK
HEIGHT 16'-17' TO BOTTOM	OK
SIGHT DISTANCE (VISIBILITY)	OK
UTILITY CLEARANCES	OK

ADA REQUIREMENTS	
CROSSWALKS	OK
SIDEWALK (CLEAR PATH, MIN 36")	OK
RAMPS W/ DETECTABLE WARNING STRIP	Y

SPAN POLES / MAST ARMS	TR-1103_01
LOCATION	OK
BASE GROUTED	OK
PROPER RAKE. PLUMB UNDER LOAD	OK
HEIGHT / ARM LENGTH	OK
H.H. CVR. POLE CAP, BOLT CVR	OK
BONDED TO GROUND ROD	UNK
I.D. TAG	OK
1 SPAN CLAMP PER ATTACHMENT	OK

PEDESTRIAN SIGNALS	TR-1102_01
CORRECT TYPE / SIZE	OK
FACING PED. TRAFFIC	OK
PROPER ADVISORY SIGNS	OK

SIGNS	
SPAN & POST MOUNT	OK
LANE USE ARROWS	OK
NTOR SIGNS	N/A
STOP, STOP AHEAD, INT WARNING	N/A
SIGNAL AHEAD	N/A
FLASHING "STOP AHEAD"	N/A

NOTES: ① FOR THOSE OBSERVED

② DOGHOUSE SIGNAL DAMAGED

PAVEMENT MARKINGS	
LANE ARROWS	N/A
PROPER LANE & SHOULDER WIDTH	OK
CENTER LINES	OK
STOP BAR PLACEMENT	OK
ELEPHANT TRACKS	N/A



5T

Field Inspection

SIGNAL EQUIPMENT EVALUATION FORM

(OST)
~~OST~~

CITY/TOWN _____ JOB# _____ DATE _____ LOCATION S Colony Rd @ Ward St

CONTROLLER CABINET INVENTORY									
Component	Local Controller	Master Controller	CM / MMU	Detector Amplifier	Time Clock	Preemption	Load Switches	Flasher	Cabinet
Quantity	1	1	1	9	N/A	1	6	1	1
Make	Peet	Peet	Transt	Sarasota		3M	GSP/ PDC/TSC	PDC	Peet
Model #	3000	M3000	ICELRA	(7) 535T (6) 515TGPZ		TEC Opticom	(1) 200K (4) 555-874P	55F-874P	5524
Serial #	N/A	N/A	N/A			N/A	(1) CMC 200 N/A	N/A	N/A
Comments:	5074 15.0 01/10		Out of service		Not sure flash local switch is working no lights				

VEHICLE SIGNAL INVENTORY		
	Size	
	8"	12"
Red	8	2
Yellow	8	2
Green	8	2
R-Arrow		
Y-Arrow		
G-Arrow		
Comments: 1 x/6 bi-modal		

PEDESTRIAN SIGNAL INVENTORY													
	QUANTITY									PUSHBUTTON ASSEMBLY			
	Size			Illumination Method							Quantity	Working?	ADA Compliant?
	9"	12"	16"	Countdown	Incandescent	LED	Fiber Optic	Poor Cond.?					
1 Section - Word			6		6					Button	4	4	4
1 Section - Symbol			2		6	2				Legend	4		
2 Section - Word										Audible	0		
2 Section - Symbol													
Comments:													


SIGNAL SUPPORT QUANTITIES							
		Post		Mast Arm		Span Wire	
		8'	10'	Truss	Monlever	Free	Tether
Post	Good					✓	
	Fair			X	X	X	X
	Poor			X	X	X	X
Comments:							

8 & 5 Sep

φ Set	1	2	3	4	5	6	7	8	9
Min		9	5	15	0	0	5	5	
Ext.		30	20	20	00	00			
Max I		24	9	34	0	0	30	30	
Max II		31	9	27	0	0	30	30	
Yel		4.0	4.0	4.0	0.1	0.0	4.0	3.0	
Red		20	10	10	0.0	0.0	20	1.0	
Walk		14			7				
Ped Cl		1			7				
Lock			PL		NL				
Recall		Min							

Sketch of intersection signal phasing and signal layout:

- OUTLET FAN/THERMOSTAT LAMP
- MAST ARM SPAN WIRE ORNAMENTAL
- VEH SIG 8" 12" Sect: 3 4 Bi 5 DH
 - Inc FO LED OP Failure
 - Fixed Freeswing Tether
 - Color Yellow/Black Backplate Visor
- PED SIG 9" 12" 16"
 - Inc FO LED Failure
 - Word Symbol Red/Yellow
 - Pushbutton Audible Failure
- DETECTION Loop Video Magnetic
 - Microwave Infrared Failure
- ADVANCE SIGNING None Static Illuminated
- NUMBER OF PHASES 2 3 4 5 6 7 8
- LEFT-TURN Perm. Prot. Lead Lag Simult
- PED PHASE None Exclusive Concurrent
- CYCLE LENGTH Max _____ Min _____
- CABINET PHOTOS

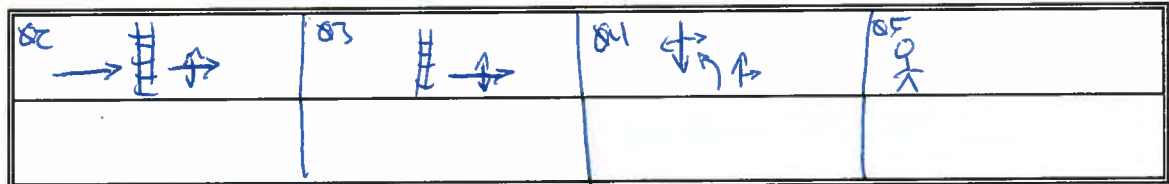


Det. ch	φ
1-6 to	1-8
17	2
18	2
21	2
25	2, 3
26	2
27	2
28	2
29	4

no left turn / no right turn.

- CNA I 02
- WPM An
- Ink Max All
- Ped Recy All

O/L Coord Enable = N
OLA = 2, 3

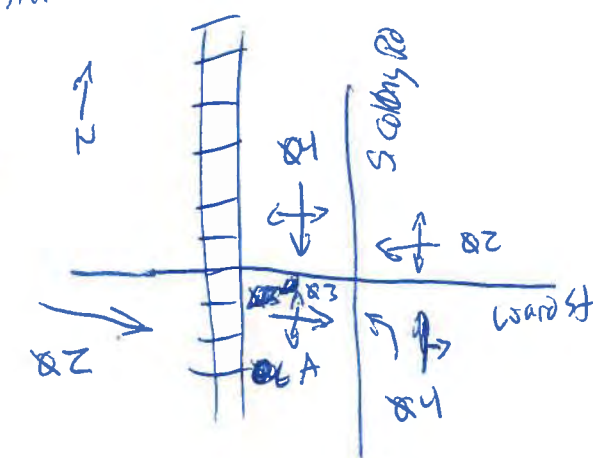

Pre-empt 1 (1082)

- Enable Run
- Railroad Preempt
- Input Lock
- Go to Higher Run
- NEMA Priority
- Override UCF

Maximum Intervals:

User Priority:

Duration Service:

Preempt Delay:

Reservice Time:

Inhibit Double Clearing OVL's

Min. Green:

Min. Yellow:

Min. Red:

Min. Ped. Clearance:

Min. Overlap Yellow:

- Go to Exit Phase
- Go to Next Demand
- Resume Sequence
- To Coordination

FUNC\PH 1 2 3 4 5 6 7 8

Phases

Calls

1 2 3 4 5 6
 Vchd XXXX
 Puch XXXX
 Fxw XXXX
 Exit X

RUN	INTVL #	TIME	FLASH PLAN	SIG OUTS	1 A	2 B	3 C	4 D	5 E	6 F	7 G	8 H	9 I	10 J	11 K	12 L	13 M	14 N	15 O	16 P
1	1	22					G													
TYPE				VEH																
TENTHS				PED																
EXIT				VEH O/L	G															
				PED O/L																
PC->YEL				OUTS	XI															

RUN	INTVL #	TIME	FLASH PLAN	SIG OUTS	1 A	2 B	3 C	4 D	5 E	6 F	7 G	8 H	9 I	10 J	11 K	12 L	13 M	14 N	15 O	16 P
2	2	4					Y													
TYPE				VEH																
TENTHS				PED																
EXIT				VEH O/L	Y															
				PED O/L																
PC->YEL				OUTS	XI															

RUN	INTVL #	TIME	FLASH PLAN	SIG OUTS	1 A	2 B	3 C	4 D	5 E	6 F	7 G	8 H	9 I	10 J	11 K	12 L	13 M	14 N	15 O	16 P
3	3	2																		
TYPE				VEH																
TENTHS				PED																
EXIT				VEH O/L																
				PED O/L																
PC->YEL				OUTS	XI															

RUN	INTVL #	TIME	FLASH PLAN	SIG OUTS	1 A	2 B	3 C	4 D	5 E	6 F	7 G	8 H	9 I	10 J	11 K	12 L	13 M	14 N	15 O	16 P
4	4	20						G												
TYPE				VEH																
TENTHS				PED																
EXIT				VEH O/L																
				PED O/L																
PC->YEL				OUTS	XI															

Project: _____
 City: _____
 Location: _____
 Sheet: OST
 By: MW
 Date: 2/1/12

Pre-empt 1 (2052)

- Enable Run
- Railroad Preempt
- Input Lock
- Go to Higher Run
- NEMA Priority
- Override UCF

Maximum Intervals:

User Priority:

Duration Service:

Preempt Delay:

Reservice Time:

Inhibit Double Clearing OVL's

Min. Green:

Min. Yellow:

Min. Red:

Min. Ped. Clearance:

Min. Overlap Yellow:

- Go to Exit Phase
- Go to Next Demand
- Resume Sequence
- To Coordination

FUNC\PH	1	2	3	4	5	6	7	8
Phases	<input type="checkbox"/>	<input type="checkbox"/>	<input type="checkbox"/>	<input type="checkbox"/>	<input type="checkbox"/>	<input type="checkbox"/>	<input type="checkbox"/>	<input type="checkbox"/>
Calls	<input type="checkbox"/>	<input type="checkbox"/>	<input type="checkbox"/>	<input type="checkbox"/>	<input type="checkbox"/>	<input type="checkbox"/>	<input type="checkbox"/>	<input type="checkbox"/>

RUN	1																		
INTVL #	TIME	FLASH PLAN	SIG OUTS	1 A	2 B	3 C	4 D	5 E	6 F	7 G	8 H	9 I	10 J	11 K	12 L	13 M	14 N	15 O	16 P
TYPE			VEH				Y												
TENTHS			PED																
EXIT			VEH O/L																
			PED O/L																
PC->YEL			OUTS	IX															

RUN	1																		
INTVL #	TIME	FLASH PLAN	SIG OUTS	1 A	2 B	3 C	4 D	5 E	6 F	7 G	8 H	9 I	10 J	11 K	12 L	13 M	14 N	15 O	16 P
TYPE			VEH																
TENTHS			PED																
EXIT			VEH O/L																
			PED O/L																
PC->YEL			OUTS	IX															

RUN																			
INTVL #	TIME	FLASH PLAN	SIG OUTS	1 A	2 B	3 C	4 D	5 E	6 F	7 G	8 H	9 I	10 J	11 K	12 L	13 M	14 N	15 O	16 P
TYPE			VEH																
TENTHS			PED																
EXIT			VEH O/L																
			PED O/L																
PC->YEL			OUTS																

RUN																			
INTVL #	TIME	FLASH PLAN	SIG OUTS	1 A	2 B	3 C	4 D	5 E	6 F	7 G	8 H	9 I	10 J	11 K	12 L	13 M	14 N	15 O	16 P
TYPE			VEH																
TENTHS			PED																
EXIT			VEH O/L																
			PED O/L																
PC->YEL			OUTS																

Project: OST

City: MWR

Location: _____

Date: 2/3/12

By: MWR

Sheet: OST

Pre-empt 2

- Enable Run
- Railroad Preempt
- Input Lock
- Go to Higher Run
- NEMA Priority
- Override UCF

Maximum Intervals:

User Priority:

Duration Service:

Preempt Delay:

Reservice Time:

Inhibit Double Clearing OVL's

Min. Green:

Min. Yellow:

Min. Red:

Min. Ped. Clearance:

Min. Overlap Yellow:

- Go to Exit Phase
- Go to Next Demand
- Resume Sequence
- To Coordination

Valid
Dwell
Fixed
Exit

1	X	X	X
2	X	X	X
3	X	X	X
4	X	X	X
5	X	X	X
6	X	X	X
7	X	X	X
8	X	X	X

FUNC\PH 1 2 3 4 5 6 7 8

Phases

Calls

RUN	TIME	FLASH PLAN	SIG OUTS	1 A	2 B	3 C	4 D	5 E	6 F	7 G	8 H	9 I	10 J	11 K	12 L	13 M	14 N	15 O	16 P
1	15						G												
TYPE			VEH																
TENTHS			PED																
EXIT			VEH O/L																
			PED O/L																
PC->YEL			OUTS																

RUN	TIME	FLASH PLAN	SIG OUTS	1 A	2 B	3 C	4 D	5 E	6 F	7 G	8 H	9 I	10 J	11 K	12 L	13 M	14 N	15 O	16 P
2	4						Y												
TYPE			VEH																
TENTHS			PED																
EXIT			VEH O/L																
			PED O/L																
PC->YEL			OUTS																

RUN	TIME	FLASH PLAN	SIG OUTS	1 A	2 B	3 C	4 D	5 E	6 F	7 G	8 H	9 I	10 J	11 K	12 L	13 M	14 N	15 O	16 P
3	2																		
TYPE			VEH																
TENTHS			PED																
EXIT			VEH O/L																
			PED O/L																
PC->YEL			OUTS																

RUN	TIME	FLASH PLAN	SIG OUTS	1 A	2 B	3 C	4 D	5 E	6 F	7 G	8 H	9 I	10 J	11 K	12 L	13 M	14 N	15 O	16 P
TYPE			VEH																
TENTHS			PED																
EXIT			VEH O/L																
			PED O/L																
PC->YEL			OUTS																

Project: _____

City: _____

Location: _____

Sheet: 051

By: MMW

Date: 2/19/2018

Pre-empt 3

- Enable Run
- Railroad Preempt
- Input Lock
- Go to Higher Run
- NEMA Priority
- Override UCF

Maximum Intervals:
 User Priority:
 Duration Service:
 Preempt Delay:
 Reservice Time:

Inhibit Double Clearing OVL's
 Min. Green:
 Min. Yellow:
 Min. Red:
 Min. Ped. Clearance:
 Min. Overlap Yellow:

- Go to Exit Phase
- Go to Next Demand
- Resume Sequence
- To Coordination

Vehicle
 Dwell 1-3
 Fixed 1-3
 Exit 1

FUNCTION PH 1 2 3 4 5 6 7 8
 Phases
 Calls

RUN	TIME	FLASH PLAN	SIG OUTS	1 A	2 B	3 C	4 D	5 E	6 F	7 G	8 H	9 I	10 J	11 K	12 L	13 M	14 N	15 O	16 P
3	15				G														
TYPE			VEH																
TENTHS			PED																
EXIT			VEH O/L	G															
			PED O/L																
PC->YEL			OUTS																

RUN	TIME	FLASH PLAN	SIG OUTS	1 A	2 B	3 C	4 D	5 E	6 F	7 G	8 H	9 I	10 J	11 K	12 L	13 M	14 N	15 O	16 P
3	4				Y														
TYPE			VEH																
TENTHS			PED																
EXIT			VEH O/L																
			PED O/L																
PC->YEL			OUTS																

RUN	TIME	FLASH PLAN	SIG OUTS	1 A	2 B	3 C	4 D	5 E	6 F	7 G	8 H	9 I	10 J	11 K	12 L	13 M	14 N	15 O	16 P
3	2																		
TYPE			VEH																
TENTHS			PED																
EXIT			VEH O/L																
			PED O/L																
PC->YEL			OUTS																

RUN	TIME	FLASH PLAN	SIG OUTS	1 A	2 B	3 C	4 D	5 E	6 F	7 G	8 H	9 I	10 J	11 K	12 L	13 M	14 N	15 O	16 P
TYPE			VEH																
TENTHS			PED																
EXIT			VEH O/L																
			PED O/L																
PC->YEL			OUTS																

Project: _____
 City: _____
 Location: _____
 Sheet: 051
 By: MWW
 Date: 7/3/12



DEPARTMENT OF TRANSPORTATION

PROJECT - _____ LOCATION # - 5-T D.O.T. INSPECTOR - _____ DATE OF NEW SERVICE - _____
 TOWN - Wallingford LOCATION - South Colony at Ward St. CONTRACTOR'S REP. - JLB CHANGE OVER DATE - _____

LOOP DETECTOR TEST - (PERFORMED BY CONTRACTOR) SEE STANDARD SHEET TR-1000_01

TEST	INSULATION RESISTANCE (MEGGER)	LOOP CIRCUIT RESISTANCE	POWER INTERRUPTION
DATE			

PRELIMINARY VISUAL INSPECTION - (PERFORMED BY INSPECTOR)

DATE: 2/3/12

FOUNDATIONS	TR-1002-01
CTRL FND 4" ABOVE GROUND	Y
CONCRETE PAD (3'X4')	Y
CAST IN PLACE, BRUSH FINISHED	Y
CONDUITS BONDED TO GROUND ROD	Y
DUCT SEAL IN CONDUITS	Y

PEDESTALS	TR-1102-01
LOCATION	OK
PLUMB	OK
BONDED TO GROUND ROD	UNK
CRUSHED STONE IN FOUNDATION CENTER	UNK

PUSH BUTTONS	TR-1107-01
ADA TYPE BUTTON, (2" DIA.), PIEZO	Y
42" MOUNTING HEIGHT	Y
ACCESSIBLE FROM SIDEWALK/RAMP	Y

HANDHOLES	TR-1010-01
FLUSH WITH GRADE	Y
SET ON CRUSHED STONE BASE	Y ①
COVER & CONDUITS BONDED	N ①
DUCT SEAL IN CONDUITS	N ①

TRAFFIC SIGNALS	TR-1105-01
SPAN LAYOUT	OK
PLUMB APPEARANCE	OK
FACES: TYPE & LOCATION	OK
VISORS / LOUVERS / BACK PLATES	OK
MISSING HARDWARE: BOTTOM CAPS, ETC.	OK
HEIGHT 16'-17' TO BOTTOM	OK
SIGHT DISTANCE (VISIBILITY)	OK
UTILITY CLEARANCES	OK

ADA REQUIREMENTS	TR-1107-01
CROSSWALKS	Y ③
SIDEWALK (CLEAR PATH, MIN 36")	Y
RAMPS W/ DETECTABLE WARNING STRIP	N ④

SPAN POLES / MAST ARMS	TR-1103-01
LOCATION	OK
BASE GROUTED	OK
PROPER RAKE. PLUMB UNDER LOAD	OK
HEIGHT / ARM LENGTH	OK
H.H. CVR. POLE CAP, BOLT CVR	OK
BONDED TO GROUND ROD	UNK
I.D. TAG	UNK
1 SPAN CLAMP PER ATTACHMENT	OK

PEDESTRIAN SIGNALS	TR-1102-01
CORRECT TYPE / SIZE	②
FACING PED. TRAFFIC	OK
PROPER ADVISORY SIGNS	②

SIGNS	TR-1107-01
SPAN & POST MOUNT	OK
LANE USE ARROWS	OK
NTOR SIGNS	
STOP, STOP AHEAD, INT WARNING	N/A
SIGNAL AHEAD	N/A
FLASHING "STOP AHEAD"	N/A
<u>INT. ILLUM SIGNS</u>	OK

NOTES: ① FOR THOSE OBSERVED
 ② VARIOUS TYPES USE SOME NEWER STYLE
 ③ IN POOR CONDITION
 ④ AT ONE LOC. NEW RAMP (S/E COR.)
 ⑤ COULD BE MOVED BACK @ NB APPROACH.

PAVEMENT MARKINGS	TR-1107-01
LANE ARROWS	OK ③
PROPER LANE & SHOULDER WIDTH	OK
CENTER LINES	OK
STOP BAR PLACEMENT	OK ⑤
ELEPHANT TRACKS	N/A



6T

Field Inspection

SIGNAL EQUIPMENT EVALUATION FORM

CITY/TOWN _____ JOB# _____ DATE _____ LOCATION _____

CONTROLLER CABINET INVENTORY									
Component	Local Controller	Master Controller	CM / MMU	Detector Amplifier	Time Clock	Preemption	Load Switches	Flasher	Cabinet
Quantity	1	N/A	1	6	N/A	2	10	1	1
Make	Peek 3000 E		Peek	Sarsoda		3M	PDC	PDC	Peek
Model #	↓		1ZELRA	2ZZ GP6		752 Opticon	Model 200	Model 204	9443
Serial #	N/A		0900			N/A	N/A	N/A	102828 102828
Comments: Mike had note a hour @ some point cleared out since. 2nd Preemption Card Pulled out.									

VEHICLE SIGNAL INVENTORY		
	Size	
	8"	12"
Red		10
Yellow		10
Green		10
R-Arrow		
Y-Arrow		
G-Arrow		
Comments:		

Bi mod G/Y arrow 5

PEDESTRIAN SIGNAL INVENTORY													
	QUANTITY									PUSHBUTTON ASSEMBLY			
	Size				Illumination Method						Quantity	Working?	ADA Compliant?
	9"	12"	16"	Countdown	Incandescent	LED	Fiber Optic	Poor Cond.?					
1 Section - Word										Button	6		Y
1 Section - Symbol			12	0		12				Legend	6		
2 Section - Word										Audible	1		
2 Section - Symbol													
Comments:													

SIGNAL SUPPORT INVENTORY							
		Post		Mast Arm		Span Wire	
		8'	10'	Truss	Monlever	Free	Tether
Mast Arm							
Post	8'						
	Poor						
Comments:							

φ Set	1	2	3	4	5	6	7	8	9
Min									
Ext.									
Max I									
Max II									
Yel									
Red									
Walk									
Ped Cl									
Lock									
Recall									

Sketch of intersection and signal layout:

- OUTLET FAN LAMP
 MAST ARM SPAN WIRE ORNAMENTAL
 VEH SIG 8" 12" Sect. 3 4 Bi 5
 Inc FO LED OP Failure
 Fixed Freeswing Tether
 Color Yellow Backplate Visor
 PED SIG 9" 12" 16"
 Inc FO LED Failure
 Word Symbol Red/Yellow
 Pushbutton Audible Failure
 DETECT Loop Magnetic Video
 Microwave Infrared Failure

Cycle	Split	Cycle	01	02	03	04	05	06
Source <u>Close loop</u>	1	1	12	33	5	16	20	18
Split offset "	1	2	13	29	5	16	24	13
Free "	1	3	13	28	5	15	26	13
Flash "	1	4	11	33	5	16	22	13

ADVANCE SIGNING N Static Illuminated
 NUMBER OF PHASES 2 3 4 5 6

LEFT TURN Perm Prot Lead Lag Simult
 PED PHASE N Exclusive Concurrent

CYCLE LENGTH Max 120 Min 60

Dynamic "No Left Turn"
"No Right Turn"

T.O.D.
MON-FRI 01:00 - 06:30 Free
 06:30 - 09:00 1/1/1
 09:00 - 15:00 3/1/1
 15:00 - 18:30 2/1/1
 18:30 - 24:00 Free


Sat & Sun
 Free

Preempt exits to phase 2

Project: _____
City: Wallingford, CT
Location: N./S. Colony @ Quimpic & Hill & Colton St
SIGNAL TIMING SHEET

Sheet: 6T
By: MWW
Date: 1/18/2017

INTERSECTION DIAGRAM

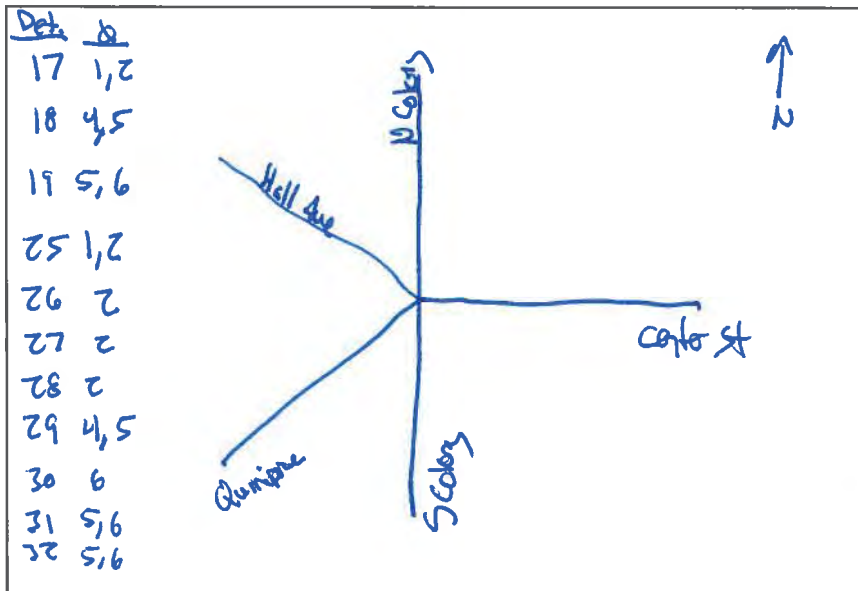

Coordinated opp in Phase

Pretimed
Semi-Actuated
Fully-Actuated

NOTES: Omit Phase 1 if #2 on

8 phase Sequantrol
inhibit max yes to all
Ped Recycle yes to all
wRM yes to all

OVERLAPS

	A	B	C/E	D
Phases	1,3,4,5	1,2	4,5	5,6

PHASE TIMES

Phase	1	2	3	4	5	6	7	8
Lock / NLock	NL	GNAR	NL	NL		NL		
Recall (Max, Min, None)		Min						
Walk		9	7					
Don't Walk		1	10					
Min Green	5	15	0	4	12	4		
Extension	20	30	0.0	20	30	20		
Recall Green								
Max I Green	5	28	0	6	25	5		
Max II Green	15	40	0	15	25	5		
Max III Green								
Yellow	3.0	3.0	0.1	3.0	3.0	3.0		
All Red	0.1	2.0	0.0	0.1	4.0	4.0		
Total Split I								
Total Split II								


PRE-EMPTION

Phases				
--------	--	--	--	--

TIME OF DAY SETTINGS

Cycle	MAX I
Time Period:	AM Peak 0:30-9:00
Cycle Length:	100 Min 60
Offset:	20
Cycle	MAX II
Time Period:	PM Peak 15:00-18:30
Cycle Length:	120 Min 60
Offset:	25
Cycle	MAX III
Time Period:	Mid-day 9:00-15:00
Cycle Length:	100 Min 60
Offset:	25

SIGNAL PHASING DIAGRAM

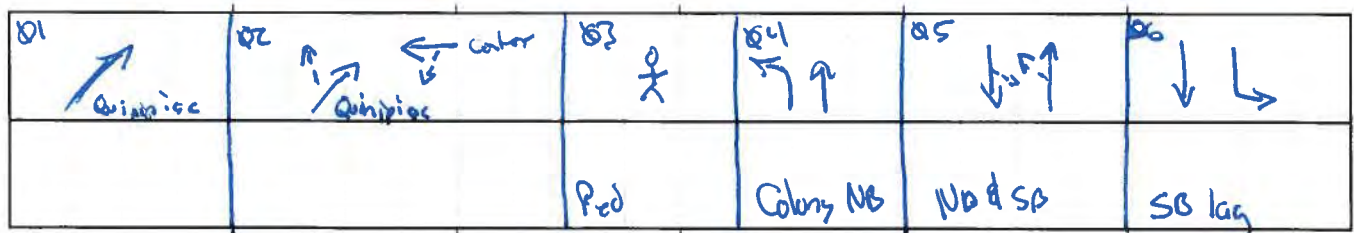

DEPARTMENT OF TRANSPORTATION

PROJECT - _____ LOCATION # - 6-T D.O.T. INSPECTOR - _____ DATE OF NEW SERVICE - _____
 TOWN - _____ LOCATION - ROUTE 150 & US ROUTE 5 AT QUINNIPING ST. CONTRACTOR'S REP. - JLB CHANGE OVER DATE - _____

LOOP DETECTOR TEST - (PERFORMED BY CONTRACTOR) SEE STANDARD SHEET TR-1000_01

TEST	INSULATION RESISTANCE (MEGGER)	LOOP CIRCUIT RESISTANCE	POWER INTERRUPTION
DATE			

PRELIMINARY VISUAL INSPECTION - (PERFORMED BY INSPECTOR)

DATE: 1/18/12

FOUNDATIONS	TR-1002-01
CTRL FND 4" ABOVE GROUND	Y
CONCRETE PAD (3'X4')	Y
CAST IN PLACE, BRUSH FINISHED	Y
CONDUITS BONDED TO GROUND ROD	Y
DUCT SEAL IN CONDUITS	Y

PEDESTALS	TR-1102-01
LOCATION	OK
PLUMB	OK
BONDED TO GROUND ROD	UNK.
CRUSHED STONE IN FOUNDATION CENTER	UNK.

PUSH BUTTONS	TR-1107-01
ADA TYPE BUTTON, (2" DIA.), PIEZO	OK
42" MOUNTING HEIGHT	OK
ACCESIBLE FROM SIDEWALK/RAMP	OK

HANDHOLES	TR-1010-01
FLUSH WITH GRADE	①
SET ON CRUSHED STONE BASE	Y
COVER & CONDUITS BONDED	N
DUCT SEAL IN CONDUITS	N
WIRE NUTS	Y

TRAFFIC SIGNALS	TR-1105-01
SPAN LAYOUT	OK
PLUMB APPEARANCE	OK
FACES: TYPE & LOCATION	OK
VISORS / LOUVERS / BACK PLATES	OK
MISSING HARDWARE: BOTTOM CAPS, ETC.	OK
HEIGHT 16'-17' TO BOTTOM	OK
SIGHT DISTANCE (VISIBILITY)	OK
UTILITY CLEARANCES	OK

ADA REQUIREMENTS	
CROSSWALKS	OK
SIDEWALK (CLEAR PATH, MIN 36")	OK
RAMPS W/ DETECTABLE WARNING STRIP	NO

SPAN POLES / MAST ARMS	TR-1103-01
LOCATION	OK
BASE GROUTED	OK ②
PROPER RAKE. PLUMB UNDER LOAD	OK
HEIGHT / ARM LENGTH	OK
H.H. CVR. POLE CAP, BOLT CVR	③
BONDED TO GROUND ROD	N
I.D. TAG	Y
1 SPAN CLAMP PER ATTACHMENT	Y

PEDESTRIAN SIGNALS	M/lt.	TR-1102-01
CORRECT TYPE / SIZE		OK
FACING PED. TRAFFIC		OK
PROPER ADVISORY SIGNS		OK

SIGNS	
SPAN & POST MOUNT	OK ④
LANE USE ARROWS	OK
NTOR SIGNS	OK
STOP, STOP AHEAD, INT WARNING	NA
SIGNAL AHEAD	NA
FLASHING "STOP AHEAD"	NA

NOTES: ① SEVERAL ARE NOT FINISH
 ② POLE AT N.E. COR. RTE 150 & US RTE NEEDS WORK @ BASE
 ③ SOME MISSING OR RUSTED SIGN
 ④ LANE USE SIGN OBSERVED @ US RTE 5 SB
 ⑤ POOR COND. ON HALL AVE.

PAVEMENT MARKINGS	
LANE ARROWS	OK
PROPER LANE & SHOULDER WIDTH	OK
CENTER LINES	OK
STOP BAR PLACEMENT	OK
ELEPHANT TRACKS	N/A
R/R KING	⑤



25T

Field Inspection

SIGNAL EQUIPMENT EVALUATION FORM

25T

CITY/TOWN _____ JOB# _____ DATE 2/3/12 LOCATION _____

CONTROLLER CABINET INVENTORY									
Component	Local Controller	Master Controller	CM / MMU	Detector Amplifier	Time Clock	Preemption	Load Switches	Flasher	Cabinet
Quantity	1	N/A	1	1	N/A	N/A	3/8	1	1
Make	Peek		Transyt	Suzuki			PDC	PDC	Peek
Model #	3000		Model 1200	322 GP6			SSS-87WP	SSF-87WP	7786
Serial #	5907		171	N/A			N/A	N/A	112210
Comments:									

VEHICLE SIGNAL INVENTORY		
	Size	
	8"	12"
Red		6
Yellow		6
Green		6
R-Arrow		
Y-Arrow		
G-Arrow		
Comments:		

PEDESTRIAN SIGNAL INVENTORY													
	QUANTITY								PUSHBUTTON ASSEMBLY				
	Size			Illumination Method						Quantity	Working?	ADA Compliant?	
	9"	12"	16"	Countdown	Incandescent	LED	Fiber Optic	Poor Cond.?					
1 Section - Word										Button	2		2
1 Section - Symbol			2		2					Legend	2		
2 Section - Word										Audible	1	✓	
2 Section - Symbol													
Comments:													


SIGNAL SUPPORT QUANTITIES							
		Post		Mast Arm		Span Wire	
		8'	10'	Truss	Monlever	Free	Tether
Post	Good					✓	
	Fair						
	Poor						
Comments:							

80 Segs.

φ Set	1	2	3	4	5	6	7	8	9
Min		15		8					
Ext.		2.0		3.0					
Max I		30	25	20					
Max II		30	25	20					
Yel		3.0		3.0					
Red		1.0	0.1	1.0					
Walk			9						
Ped Cl			12						
Lock				UL					
Recall		Min							


Sketch of intersection signal phasing and signal layout:

- OUTLET FAN/THERMOSTAT LAMP
- MAST ARM SPAN WIRE ORNAMENTAL
- VEH SIG 8" 12" Sect: 3 4 Bi 5 DH
 - Inc FO LED OP Failure
 - Fixed Freeswing Tether
 - Color _____ Backplate Visor
- PED SIG 9" 12" 16"
 - Inc FO LED Failure
 - Word Symbol Red/Yellow
 - Pushbutton Audible Failure
- DETECTION Loop Video Magnetic
 - Microwave Infrared Failure
- ADVANCE SIGNING None Static Illuminated
- NUMBER OF PHASES 2 3 4 5 6 7 8
- LEFT-TURN Perm. Prot. Lead Lag Simult
- PED PHASE None Exclusive Concurrent
- CYCLE LENGTH Max _____ Min _____
- CABINET PHOTOS

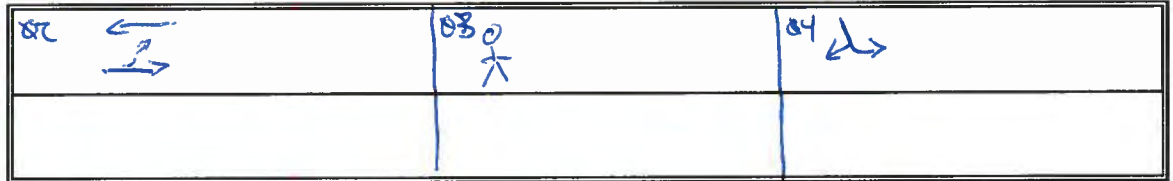

Det chn 8
 1-6 to 1-8
 9 4
 10 4
 25 4
 29 5
 30 5
 21 6
 22 6

CNA I 02
 WPM All

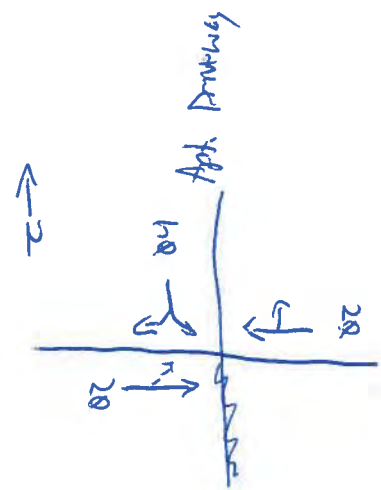

DEPARTMENT OF TRANSPORTATION

PROJECT - _____ LOCATION # - RAE 150 @ SILVER D.O.T. INSPECTOR - _____ DATE OF NEW SERVICE - _____
 TOWN - _____ LOCATION - 25-T AND 1715 CONTRACTOR'S REP. - JLB CHANGE OVER DATE - _____

LOOP DETECTOR TEST - (PERFORMED BY CONTRACTOR) SEE STANDARD SHEET TR-1000_01

TEST	INSULATION RESISTANCE (MEGGER)	LOOP CIRCUIT RESISTANCE	POWER INTERRUPTION
DATE			

PRELIMINARY VISUAL INSPECTION - (PERFORMED BY INSPECTOR)

DATE: 2/3/12

FOUNDATIONS	TR-1002-01
CTRL FND 4" ABOVE GROUND	Y
CONCRETE PAD (3'X4')	Y
CAST IN PLACE, BRUSH FINISHED	Y
CONDUITS BONDED TO GROUND ROD	
DUCT SEAL IN CONDUITS	

PEDESTALS	TR-1102-01
LOCATION	OK N/A
PLUMB	OK
BONDED TO GROUND ROD	UNK.
CRUSHED STONE IN FOUNDATION CENTER	UNK.

PUSH BUTTONS	TR-1107-01
ADA TYPE BUTTON, (2" DIA.), PIEZO	Y
42" MOUNTING HEIGHT	OK
ACCESSIBLE FROM SIDEWALK/RAMP	N

HANDHOLES	TR-1010-01
FLUSH WITH GRADE	N
SET ON CRUSHED STONE BASE	UNK.
COVER & CONDUITS BONDED	N
DUCT SEAL IN CONDUITS	N

TRAFFIC SIGNALS	TR-1105-01
SPAN LAYOUT	OK
PLUMB APPEARANCE	OK
FACES: TYPE & LOCATION	OK
VISORS / LOUVERS / BACK PLATES	OK
MISSING HARDWARE: BOTTOM CAPS, ETC.	N/A
HEIGHT 16'-17' TO BOTTOM	OK
SIGHT DISTANCE (VISIBILITY)	OK
UTILITY CLEARANCES	OK

ADA REQUIREMENTS	
CROSSWALKS	(1)
SIDEWALK (CLEAR PATH, MIN 36")	(1)
RAMPS W/ DETECTABLE WARNING STRIP	N

SPAN POLES / MAST ARMS	TR-1103-01
LOCATION	N/A
BASE GROUTED	
PROPER RAKE. PLUMB UNDER LOAD	
HEIGHT / ARM LENGTH	
H.H. CVR. POLE CAP, BOLT CVR	
BONDED TO GROUND ROD	
I.D. TAG	
1 SPAN CLAMP PER ATTACHMENT	

PEDESTRIAN SIGNALS	TR-1102-01
CORRECT TYPE / SIZE	Y
FACING PED. TRAFFIC	Y
PROPER ADVISORY SIGNS	N/A

SIGNS	
SPAN & POST MOUNT	OK
LANE USE ARROWS	N/A
NTOR SIGNS	OK
STOP, STOP AHEAD, INT WARNING	N/A
SIGNAL AHEAD	N/A
FLASHING "STOP AHEAD"	N/A

PAVEMENT MARKINGS	
LANE ARROWS	N/A
PROPER LANE & SHOULDER WIDTH	OK
CENTER LINES	OK
STOP BAR PLACEMENT	OK
ELEPHANT TRACKS	N/A

NOTES:

(1) No Ramps / SW @ crosswalk loc. (DARKWOOD)
 * IN POLE LOCATION (P.O.S.)



26T

Field Inspection

SIGNAL EQUIPMENT EVALUATION FORM

(SIT)

CITY/TOWN _____ JOB# _____ DATE 2/3/12 LOCATION Center @ S.E. La St

CONTROLLER CABINET INVENTORY									
Component	Local Controller	Master Controller	CM / MMU	Detector Amplifier	Time Clock	Preemption	Load Switches	Flasher	Cabinet
Quantity	1	N/A	1	6	N/A	N/A	9/12	1	1
Make	Peels		Transyt	Scragots			PDC	PDC	Scotton
Model #	3000		12ELR	515T6PC			SSS-87WP	SBF-87WP	PEELS 44 typ v
Serial #	N/A		N/A	N/A			N/A	N/A	N/A
Comments:	Couldn't access cabinet key 1 required re cut door for key 2								

VEHICLE SIGNAL INVENTORY		
	Size	
	8"	12"
Red	4	4
Yellow	8	
Green	8	
R-Arrow		
Y-Arrow		
G-Arrow		
Comments:	3 Y/G Arrow Bi-modal	

PEDESTRIAN SIGNAL INVENTORY													
	QUANTITY									PUSHBUTTON ASSEMBLY			
	Size			Illumination Method							Quantity	Working?	ADA Compliant?
	9"	12"	16"	Countdown	Incandescent	LED	Fiber Optic	Poor Cond.?					
1 Section - Word										Button	4	✓	2/3 2/3
1 Section - Symbol			8			8				Legend	4		
2 Section - Word										Audible	1	✓	
2 Section - Symbol													
Comments:													


omit if 02 is on
8 & Sepu. 1234
5678

SIGNAL SUPPORT QUANTITIES							
		Post		Mast Arm		Span Wire	
		8'	10'	Truss	Monlever	Free	Tether
Post	Good	4				✓	
	Fair						
	Poor						
Comments:							

φ Set	1	2	3	4	5	6	7	8	9
Min	3	25	3	8	4	0	3	8	
Ext.	20	0.0	20	4.0	0.0	0.0	2.0	4.0	
Max I	10	30	10	25	23	0	10	25	
Max II	10	30	10	25	23	0	10	25	
Yel	30	30	3.0	3.0	0.1	0.0	3.0	3.0	
Red	1.0	2.0	1.0	2.0	0.0	0.0	1.0	2.0	
Walk		19			9				
Ped Cl		1			12				
Lock									
Recall									

Sketch of intersection signal phasing and signal layout:

- OUTLET FAN/THERMOSTAT LAMP
- MAST ARM SPAN WIRE ORNAMENTAL
- VEH SIG 8" 12" Sect: 3 4 Bi 5 DH
- Inc FO LED OP Failure
- Fixed Freeswing Tether
- Color Yellow Backplate Visor
- PED SIG 9" 12" 16"
- Inc FO LED Failure
- Word Symbol Red/Yellow
- Pushbutton Audible Failure

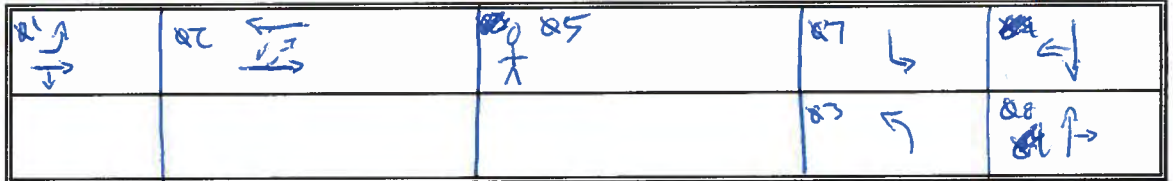


Det chg
1-2 to 1-8

WRN 02
Ink Max All
Ped Reg All
operating free

Dual Entry 04 & 08
O/L Card enabled = Y

- DETECTION Loop Video Magnetic
- Microwave Infrared Failure
- ADVANCE SIGNING None Static Illuminated
- NUMBER OF PHASES 2 3 4 5 6 7 8
- LEFT-TURN Perm. Prot. Lead Lag Simult
- PED PHASE None Exclusive Concurrent
- CYCLE LENGTH Max _____ Min _____
- CABINET PHOTOS

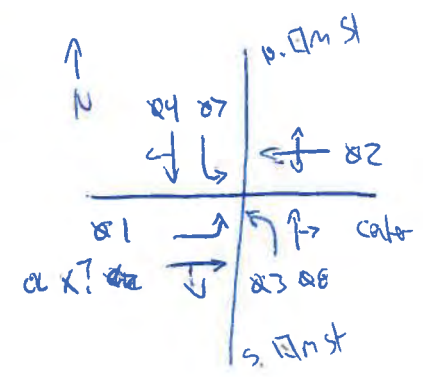

DEPARTMENT OF TRANSPORTATION

PROJECT - _____ LOCATION # 24E 150 @ N/S FLIN STS. D.O.T. INSPECTOR - _____ DATE OF NEW SERVICE - _____
 TOWN Wallingford LOCATION - 24-T CONTRACTOR'S REP. - JLB CHANGE OVER DATE - _____

LOOP DETECTOR TEST - (PERFORMED BY CONTRACTOR) SEE STANDARD SHEET TR-1000_01

TEST	INSULATION RESISTANCE (MEGGER)	LOOP CIRCUIT RESISTANCE	POWER INTERRUPTION
DATE			

PRELIMINARY VISUAL INSPECTION - (PERFORMED BY INSPECTOR)

DATE: 2/3/12

FOUNDATIONS	TR-1002_01
CTRL FND 4" ABOVE GROUND	Y
CONCRETE PAD (3'X4')	Y
CAST IN PLACE, BRUSH FINISHED	Y
CONDUITS BONDED TO GROUND ROD	Y
DUCT SEAL IN CONDUITS	N

PEDESTALS	TR-1102-01
LOCATION	OK
PLUMB	OK
BONDED TO GROUND ROD	UNK.
CRUSHED STONE IN FOUNDATION CENTER	UNK.

PUSH BUTTONS	TR-1107_01
ADA TYPE BUTTON, (2" DIA.), PIEZO	(1)
42" MOUNTING HEIGHT	OK
ACCESSIBLE FROM SIDEWALK/RAMP	Y

HANDHOLES	TR-1010_01
FLUSH WITH GRADE	Y
SET ON CRUSHED STONE BASE	UNK.
COVER & CONDUITS BONDED	UNK.
DUCT SEAL IN CONDUITS	UNK.

TRAFFIC SIGNALS	TR-1105_01
SPAN LAYOUT	OK
PLUMB APPEARANCE	OK
FACES: TYPE & LOCATION	OK
VISORS / LOUVERS / BACK PLATES	OK
MISSING HARDWARE: BOTTOM CAPS, ETC..	N.
HEIGHT 16'-17' TO BOTTOM	OK
SIGHT DISTANCE (VISIBILITY)	OK
UTILITY CLEARANCES	OK

ADA REQUIREMENTS	
CROSSWALKS	(2)
SIDEWALK (CLEAR PATH, MIN 36")	Y
RAMPS W/ DETECTABLE WARNING STRIP	N

SPAN POLES / MAST ARMS	TR-1103_01
LOCATION	N/A
BASE GROUTED	↓
PROPER RAKE. PLUMB UNDER LOAD	↓
HEIGHT / ARM LENGTH	↓
H.H. CVR. POLE CAP, BOLT CVR	↓
BONDED TO GROUND ROD	↓
I.D. TAG	↓
1 SPAN CLAMP PER ATTACHMENT	↓

PEDESTRIAN SIGNALS	TR-1102_01
CORRECT TYPE / SIZE	N/A OK
FACING PED. TRAFFIC	OK
PROPER ADVISORY SIGNS	(3)

SIGNS	
SPAN & POST MOUNT	OK
LANE USE ARROWS	OK
NTOR SIGNS	OK
STOP, STOP AHEAD, INT WARNING	N/A
SIGNAL AHEAD	N/A
FLASHING "STOP AHEAD"	N/A

NOTES:

(1) NOT ALL
(2) WORK
(3) OLD - PUSH BUT. FOR WORK TYPE.

PAVEMENT MARKINGS	
LANE ARROWS	OK
PROPER LANE & SHOULDER WIDTH	OK
CENTER LINES	OK
STOP BAR PLACEMENT	OK
ELEPHANT TRACKS	N/A



27T

Field Inspection

SIGNAL EQUIPMENT EVALUATION FORM

CITY/TOWN Wallington, CT JOB# _____ DATE _____ LOCATION Center st @ N./S. Main St.

277

CONTROLLER CABINET INVENTORY									
Component	Local Controller	Master Controller	CM / MMU	Detector Amplifier	Time Clock	Preemption	Load Switches	Flasher	Cabinet
Quantity	1	1	1	4	N/A	N/A	8/12	1	1
Make	Peek	Peek	Peek	Sarasota			6 PDC 2 Cube TSC	PDC	Southern
Model #	3000 5074 V4.5 H29	M3000 5581 V2.5 C8/26	Double Diamond	516T GPZ			6 SSS-67WP 2 Cube 200	SSF-67WP	N/A
Serial #	N/A	N/A	N/A	N/A			N/A	N/A	N/A
Comments: <u>Difficult to get door open & turn key</u>									

VEHICLE SIGNAL INVENTORY		
	Size	
	8"	12"
Red	8	
Yellow	8	
Green	8	
R-Arrow		
Y-Arrow		
G-Arrow		
Comments: <u>4 7/8 Arrow 2nd model</u>		

PEDESTRIAN SIGNAL INVENTORY													
	QUANTITY								PUSHBUTTON ASSEMBLY				
	Size			Illumination Method						Quantity	Working?	ADA Compliant?	
	9"	12"	16"	Countdown	Incandescent	LED	Fiber Optic	Poor Cond.?					
1 Section - Word										Button	4	✓	✓
1 Section - Symbol			8			8				Legend	4		
2 Section - Word										Audible	1	✓	
2 Section - Symbol													
Comments:													

12 3478 omit 05 wle 02 is on
 56 omit 01 when 06 is on

SIGNAL SUPPORT QUANTITIES							
		Post		Mast Arm		Span Wire	
		8'	10'	Truss	Monlever	Free	Tether
Post	Good					✓	
	Fair						
	Poor						
Comments:							

φ Set	1	2	3	4	5	6	7	8	9
Min	3	15		6	3	15	8		
Ext.	2	0		02	2	4	4		
Max I	10	25	25	10	10	25	30		
Max II	10	40	25	8	10	40	35		
Yel	3	3		3	3	3	3		
Red	1	2	2	1	1	2	2		
Walk		15	9			15			
Ped Cl		1	12			1			
Lock	NL			NL	NL				
Recall		Min Max				Min Max			

Sketch of intersection signal phasing and signal layout:

OUTLET FAN/THERMOSTAT LAMP *bulb based out*

MAST ARM SPAN WIRE ORNAMENTAL

VEH SIG 8" 12" Sect: 3 4 Bi 5 DH
 Inc FO LED OP Failure
 Fixed Freeswing Tether
 Color Yellow Backplate Visor

PED SIG 9" 12" 16"
 Inc FO LED Failure
 Word Symbol Red/Yellow
 Pushbutton Audible Failure

DETECTION Loop Video Magnetic
 Microwave Infrared Failure

ADVANCE SIGNING None Static Illuminated


NUMBER OF PHASES 2 3 4 5 6 7 8

LEFT-TURN Perm. Prot. Lead Lag Simult

PED PHASE None Exclusive Concurrent


CYCLE LENGTH Max _____ Min _____

CABINET PHOTOS

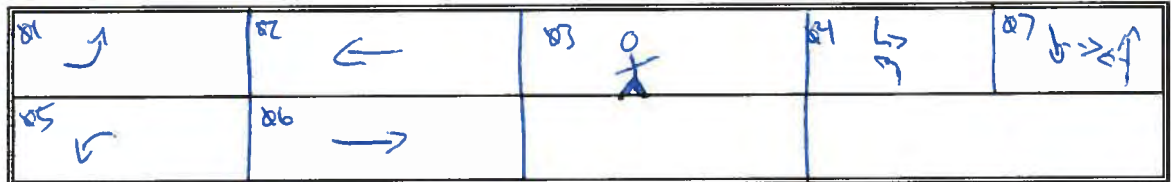

Det. chn 02
1-8 to 1-0
 Sys
 1 17
 2 16

CMAI 02 & 06
 WRM All
 Inh Max 02 06

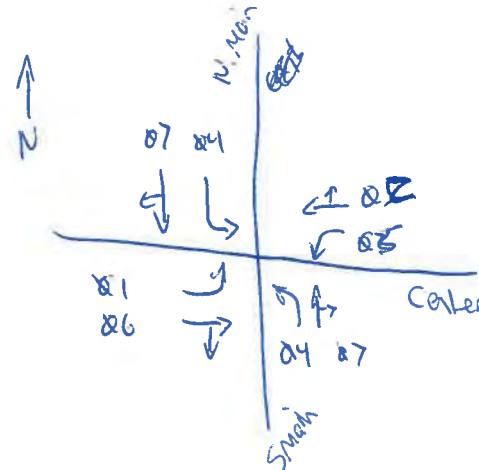



Project: _____
 City: _____
 Location: _____

Sheet: 27T
 By: MWW
 Date: 2/3/12

Operating Modes [X]

Source:	Cycle	Split	Offset	Free	Flash	City Zero Midnight Cycles:					
						1	2	3	4	5	6
TOD	<input type="checkbox"/>	<input type="checkbox"/>	<input type="checkbox"/>	<input type="checkbox"/>	<input type="checkbox"/>						
Closed Loop	<input checked="" type="checkbox"/>	<input checked="" type="checkbox"/>	<input checked="" type="checkbox"/>	<input checked="" type="checkbox"/>	<input checked="" type="checkbox"/>						
Interconnect	<input type="checkbox"/>	<input type="checkbox"/>	<input type="checkbox"/>	<input type="checkbox"/>	<input type="checkbox"/>						

<input type="checkbox"/> Auto Permissives	<input type="checkbox"/> Offset Entry In %	Out of Step to Free:	<input type="checkbox"/>
<input type="checkbox"/> End of Main Street	<input type="checkbox"/> Perm-Pa Entry In %	Ped Permissive:	<input type="text" value="0"/>
<input type="checkbox"/> Enhanced Permissives	<input type="checkbox"/> Invert Free Input	Interconnect TOD Revert:	<input type="text" value="0"/>
<input type="checkbox"/> Fixed Force-Off	<input type="checkbox"/> Split Matrix	Percent Yield:	<input type="text" value="5"/>
<input type="checkbox"/> Yellow Offset	<input type="checkbox"/> 4 Splits/Cycle	Percent EGB:	<input type="text" value="0"/>
<input checked="" type="checkbox"/> Central Override	<input type="checkbox"/> No Early Coord Ped	Percent RGB:	<input type="text" value="0"/>
<input type="checkbox"/> No PCL Offset Adjust		Conditions to Free:	
SYNC Source: Type of Perm: Offset Seeking:		No. of Cycles w/No Sync	<input type="text" value="0"/>
<input checked="" type="checkbox"/> TOD/CL/INTER	<input checked="" type="checkbox"/> Yield	No. of Sec. w/No offset	<input type="text" value="0"/>
<input type="checkbox"/> City Zero	<input type="checkbox"/> Single	No. of Sec. w/Multi Offsets	<input type="text" value="0"/>
<input type="checkbox"/> Absolute	<input type="checkbox"/> Multiple		
	<input type="checkbox"/> Add		
	<input type="checkbox"/> Dwell		
	<input checked="" type="checkbox"/> Short Route		

Phase Allocation		1	2	3	4	5	6	7	8
Cyc/Splt	Phase								
	All 24 splits	0	0	0	0	0	0	0	0

Coord to 2#6

DEPARTMENT OF TRANSPORTATION

PROJECT - _____ LOCATION # - 27-T D.O.T. INSPECTOR - _____ DATE OF NEW SERVICE - _____
 TOWN - Waukegan LOCATION - Main St. Mt CONTRACTOR'S REP. - JLB CHANGE OVER DATE - _____
Route 150

LOOP DETECTOR TEST - (PERFORMED BY CONTRACTOR) SEE STANDARD SHEET TR-1000_01

TEST	INSULATION RESISTANCE (MEGGER)	LOOP CIRCUIT RESISTANCE	POWER INTERUPTION
DATE			

PRELIMINARY VISUAL INSPECTION - (PERFORMED BY INSPECTOR)

DATE: 2/3/12

FOUNDATIONS	TR-1002_01
CTRL FND 4" ABOVE GROUND	Y
CONCRETE PAD (3'X4')	Y
CAST IN PLACE, BRUSH FINISHED	Y
CONDUITS BONDED TO GROUND ROD	Y
DUCT SEAL IN CONDUITS	N

PEDESTALS	TR-1102_01
LOCATION	OK
PLUMB	OK
BONDED TO GROUND ROD	UNK
CRUSHED STONE IN FOUNDATION CENTER	UNK

PUSH BUTTONS	TR-1107_01
ADA TYPE BUTTON, (2" DIA.), PIEZO	N
42" MOUNTING HEIGHT	OK
ACCESIBLE FROM SIDEWALK/RAMP	OK

HANDHOLES	TR-1010_01
FLUSH WITH GRADE	Y/D
SET ON CRUSHED STONE BASE	Y/D
COVER & CONDUITS BONDED	N
DUCT SEAL IN CONDUITS	N

TRAFFIC SIGNALS	TR-1105_01
SPAN LAYOUT	
PLUMB APPEARANCE	
FACES: TYPE & LOCATION	
VISORS / LOUVERS / BACK PLATES	
MISSING HARDWARE: BOTTOM CAPS, ETC.	
HEIGHT 16'-17' TO BOTTOM	
SIGHT DISTANCE (VISIBILITY)	
UTILITY CLEARANCES	

ADA REQUIREMENTS	
CROSSWALKS	OK
SIDEWALK (CLEAR PATH, MIN 36")	OK
RAMPS W/ DETECTABLE WARNING STRIP	N

SPAN POLES / MAST ARMS	TR-1103_01
LOCATION	OK
BASE GROUTED	OK
PROPER RAKE. PLUMB UNDER LOAD	OK
HEIGHT / ARM LENGTH	OK
H.H. CVR. POLE CAP, BOLT CVR	N
BONDED TO GROUND ROD	UNK
I.D. TAG	UNK
1 SPAN CLAMP PER ATTACHMENT	OK

PEDESTRIAN SIGNALS	TR-1102_01
CORRECT TYPE / SIZE	OK ③
FACING PED. TRAFFIC	OK
PROPER ADVISORY SIGNS	OK ③

SIGNS	
SPAN & POST MOUNT	OK
LANE USE ARROWS	OK
NTOR SIGNS	OK
STOP, STOP AHEAD, INT WARNING	N/A
SIGNAL AHEAD	N/A
FLASHING "STOP AHEAD"	N/A

PAVEMENT MARKINGS	
LANE ARROWS	OK
PROPER LANE & SHOULDER WIDTH	OK
CENTER LINES	OK
STOP BAR PLACEMENT	OK
ELEPHANT TRACKS	N/A

NOTES: ① SOME ARE RAISED +/- 1"

② FOR THOSE OBSERVED
③ EQUIPMENT IS MISMATCHED



28T

Field Inspection

SIGNAL EQUIPMENT EVALUATION FORM

CITY/TOWN Wallington, CT JOB# _____ DATE 2/3/12 LOCATION Center St @ N. Orchard St

ZBT

CONTROLLER CABINET INVENTORY									
Component	Local Controller	Master Controller	CM / MMU	Detector Amplifier	Time Clock	Preemption	Load Switches	Flasher	Cabinet
Quantity	1	N/A	1	3	N/A	N/A	4/12	1	1
Make	Peek		Transyt	Soracota			PDC	PDC	Southern
Model #	3000		12 ELR	515T GPZ			SS-87WP	SSF-87WP	N/A
Serial #	8232		3300	N/A			N/A	N/A	N/A
Comments: <u>old Transyt 1680EL sitting in cabinet</u>									

VEHICLE SIGNAL INVENTORY		
	Size	
	8"	12"
Red	8	
Yellow	8	
Green	8	
R-Arrow		
Y-Arrow		
G-Arrow		
Comments: <u>All LED</u>		

PEDESTRIAN SIGNAL INVENTORY												
	QUANTITY								PUSHBUTTON ASSEMBLY			
	Size			Illumination Method						Quantity	Working?	ADA Compliant?
	9"	12"	16"	Countdown	Incandescent	LED	Fiber Optic	Poor Cond.?				
1 Section - Word									Button	5		
1 Section - Symbol			8			8			Legend	5		
2 Section - Word									Audible	1		
2 Section - Symbol												
Comments:												

SIGNAL SUPPORT QUANTITIES

		Post		Mast Arm		Span Wire	
		8'	10'	Truss	Monlever	Free	Tether
Post	Good					✓	
	Fair			X	X	X	X
	Poor			X	X	X	X
Comments:							

ea Segw.

φ Set	1	2	3	4	5	6	7	8	9
Min	1	30		0	0	1	1	1	
Ext.				40	40				
Max I	30	35	30	15	15	30	30	30	
Max II	30	30	30	30	30	30	30	30	
Yel		3.0		3.0	3.0				
Red		2.0	0.1	2.0	2.0				
Walk			7						
Ped Cl			12						
Lock									
Recall		Min							

Sketch of intersection signal phasing and signal layout:

- OUTLET FAN/THERMOSTAT LAMP *bulbs burned out*
- MAST ARM SPAN WIRE ORNAMENTAL

- VEH SIG 8" 12" Sect: 3 4 Bi 5 DH
- Inc FO LED OP Failure
- Fixed Freeswing Tether
- Color Yellow/Black Backplate Visor

- PED SIG 9" 12" 16"
- Inc FO LED Failure
- Word Symbol Red/Yellow
- Pushbutton Audible Failure

- DETECTION Loop Video Magnetic
- Microwave Infrared Failure

- ADVANCE SIGNING None Static Illuminated


- NUMBER OF PHASES 2 3 4 5 6 7 8

- LEFT-TURN Perm. Prot. Lead Lag Simult

- PED PHASE None Exclusive Concurrent

CYCLE LENGTH Max _____ Min _____


- CABINET PHOTOS

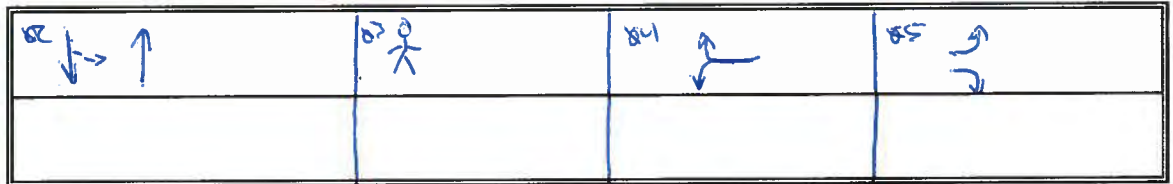

Det chn
1-8 1-8

WRM All
Ink Max All
Ped Recy All

*Free operation 24/7
No Coordination
No Pre-emption*

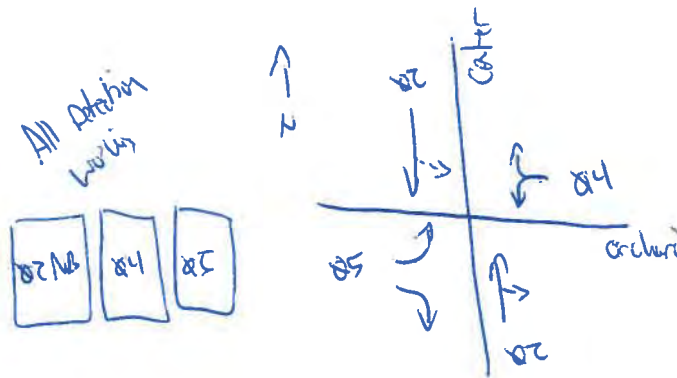

DEPARTMENT OF TRANSPORTATION

PROJECT - _____ LOCATION # - 28-T D.O.T. INSPECTOR - _____ DATE OF NEW SERVICE - _____
 TOWN - Warrington LOCATION - RTE 150 & N/S OLCHAMND ST. CONTRACTOR'S REP. - JLB CHANGE OVER DATE - _____

LOOP DETECTOR TEST - (PERFORMED BY CONTRACTOR) SEE STANDARD SHEET TR-1000_01

TEST	INSULATION RESISTANCE (MEGGER)	LOOP CIRCUIT RESISTANCE	POWER INTERRUPTION
DATE			

PRELIMINARY VISUAL INSPECTION - (PERFORMED BY INSPECTOR)

DATE: 2/3/12

FOUNDATIONS	TR-1002_01
CTRL FND 4" ABOVE GROUND	Y
CONCRETE PAD (3'X4')	Y
CAST IN PLACE, BRUSH FINISHED	Y
CONDUITS BONDED TO GROUND ROD	Y
DUCT SEAL IN CONDUITS	ND

PEDESTALS	TR-1102_01
LOCATION	OK
PLUMB	OK
BONDED TO GROUND ROD	UNK
CRUSHED STONE IN FOUNDATION CENTER	UNK

PUSH BUTTONS	TR-1107_01
ADA TYPE BUTTON, (2" DIA.), PIEZO	OK
42" MOUNTING HEIGHT	OK
ACCESSIBLE FROM SIDEWALK/RAMP	OK

HANDHOLES	TR-1010_01
FLUSH WITH GRADE	X
SET ON CRUSHED STONE BASE	N
COVER & CONDUITS BONDED	N
DUCT SEAL IN CONDUITS	N

TRAFFIC SIGNALS	TR-1105_01
SPAN LAYOUT	OK
PLUMB APPEARANCE	OK
FACES: TYPE & LOCATION	OK
VISORS / LOUVERS / BACK PLATES	OK
MISSING HARDWARE: BOTTOM CAPS, ETC.	OK
HEIGHT 16'-17' TO BOTTOM	OK
SIGHT DISTANCE (VISIBILITY)	OK
UTILITY CLEARANCES	OK

ADA REQUIREMENTS	
CROSSWALKS	OK
SIDEWALK (CLEAR PATH, MIN 36")	OK
RAMPS W/ DETECTABLE WARNING STRIP	No

SPAN POLES / MAST ARMS	TR-1103_01
LOCATION	OK
BASE GROUTED	OK
PROPER RAKE. PLUMB UNDER LOAD	OK
HEIGHT / ARM LENGTH	OK
H.H. CVR. POLE CAP, BOLT CVR	N
BONDED TO GROUND ROD	UNK
I.D. TAG	UNK
1 SPAN CLAMP PER ATTACHMENT	OK

PEDESTRIAN SIGNALS	TR-1102_01
CORRECT TYPE / SIZE	OK
FACING PED. TRAFFIC	OK
PROPER ADVISORY SIGNS	N

SIGNS	
SPAN & POST MOUNT	OK
LANE USE ARROWS	
NTOR SIGNS	
STOP, STOP AHEAD, INT WARNING	
SIGNAL AHEAD	
FLASHING "STOP AHEAD"	

PAVEMENT MARKINGS	
LANE ARROWS	
PROPER LANE & SHOULDER WIDTH	
CENTER LINES	
STOP BAR PLACEMENT	
ELEPHANT TRACKS	

NOTES: ① - ONE SPAN SIGN IS OUT OF PLUMB



29T

Field Inspection

SIGNAL EQUIPMENT EVALUATION FORM

CITY/TOWN _____ JOB# _____ DATE _____ LOCATION _____

CONTROLLER CABINET INVENTORY									
Component	Local Controller	Master Controller	CM / MMU	Detector Amplifier	Time Clock	Preemption	Load Switches	Flasher	Cabinet
Quantity	1	N/A	1	6	N/A	1	5	1	1
Make	Peck		Peck	Sarsola		3M	PDC	PDC	Peck
Model #	3000		1ZELRA	222 GPL6		752 Opticon	Model 200	Model 201	9444
Serial #	101818		201010056	N/A		N/A	N/A	N/A	102283
Comments: <i>Opticon cab pulled out.</i>									

VEHICLE SIGNAL INVENTORY		
	Size	
	8"	12"
Red		
Yellow		
Green		
R-Arrow		
Y-Arrow		
G-Arrow		
Comments:		

PEDESTRIAN SIGNAL INVENTORY													
	QUANTITY									PUSHBUTTON ASSEMBLY			
	Size				Illumination Method						Quantity	Working?	ADA Compliant?
	9"	12"	16"	Countdown	Incandescent	LED	Fiber Optic	Poor Cond.?					
1 Section - Word										Button			
1 Section - Symbol										Legend			
2 Section - Word										Audible			
2 Section - Symbol													
Comments:													

SIGNAL SUPPORT INVENTORY							
		Post		Mast Arm		Span Wire	
		8'	10'	Truss	Monlever	Free	Tether
Mast Arm			3			✓	NA
Post	8'						
	Poor						
Comments:							

φ Set	1	2	3	4	5	6	7	8	9
Min									
Ext.									
Max I									
Max II									
Yel									
Red									
Walk									
Ped Cl									
Lock									
Recall									

Sketch of intersection and signal layout:

- OUTLET FAN LAMP
 MAST ARM SPAN WIRE ORNAMENTAL
 VEH SIG 8" 12" Sect. 3 4 Bi 5
 Inc FO LED OP Failure
 Fixed Freeswing Tether
 Color Yellow Backplate Visor
 PED SIG 9" 12" 16"
 Inc FO LED Failure
 Word Symbol Red/Yellow
 Pushbutton Audible Failure
 DETECT Loop Magnetic Video
 Microwave Infrared Failure

Source
 Cycle closed loop
 Split " "
 o/s " "
 Free " "
 Flat " "
 Yield
 Shoot Way

Cycle #	02	03	04	05
1	30	5	36	29
2	30	5	36	29
3	30	5	36	29
4	30	5	36	29

ADVANCE SIGNING N Static Illuminated
 NUMBER OF PHASES 2 3 4 5 6

ID 6

LEFT TURN Perm Prot Lead Lag Simult
 PED PHASE N Exclusive Concurrent

CYCLE LENGTH Max _____ Min _____

TOP
 Mon-Fri.
 0100 - 0630 Free
 0630 - 0900 1/1/1
 0900 - 1500 3/1/1
 1500 - 1830 2/1/1
 1830 - 2400 Free


SAT.
 0100 - 0900 Free
 0900 - 1500 4/1/1
 1500 - 2400 Free
 SUN
 0100 - 2400 Free

Project: _____
City: _____
Location: Hall Ave @ N. Cherry St

Sheet: 29T
By: MHW
Date: 1/18/2012

SIGNAL TIMING SHEET

INTERSECTION DIAGRAM

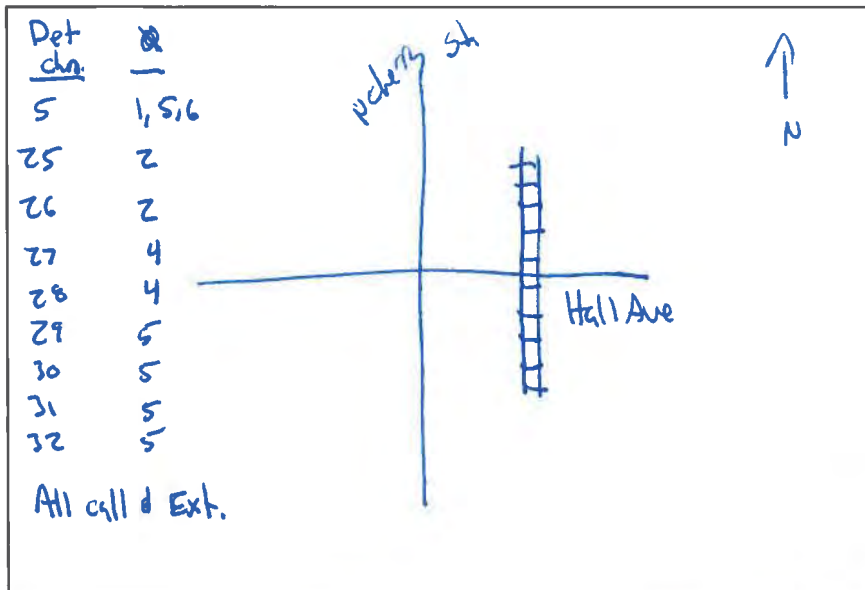

Coordinated
 Pretimed
 Semi-Actuated
 Fully-Actuated

NOTES:

8 phase Segmt.
time in controller good

OVERLAPS

	A	B	C	D
Phases	2,3,4,5			

PHASE TIMES

Phase	1	2	3	4	5	6	7	8
Lock / NLock			NL	NL	NL			
Recall (Max, Min, None)		CALL Min.						
Walk		9	7					
Don't Walk		1	10					
Min Green		8	6	8	6			
Extension		2.0	0.0	2.0	2.0			
Recall Green								
Max I Green		30	0	12	24			
Max II Green		30	0	10	25			
Max III Green								
Yellow		30	0.1	30	30			
All Red		2.0	0.0	1.0	2.0			
Total Split I								
Total Split II								


PRE-EMPTION

Phases				
--------	--	--	--	--

TIME OF DAY SETTINGS

Cycle MAX I	
Time Period:	AM
Cycle Length:	50 min 30
Offset:	32
Cycle 2 MAX II	
Time Period:	PM
Cycle Length:	60 min 30
Offset:	21
Cycle 3 MAX III	
Time Period:	MIDDY
Cycle Length:	50 min 30
Offset:	17

Coord Cycle 1 & 3 Coord Cycle 4
SIGNAL PHASING DIAGRAM

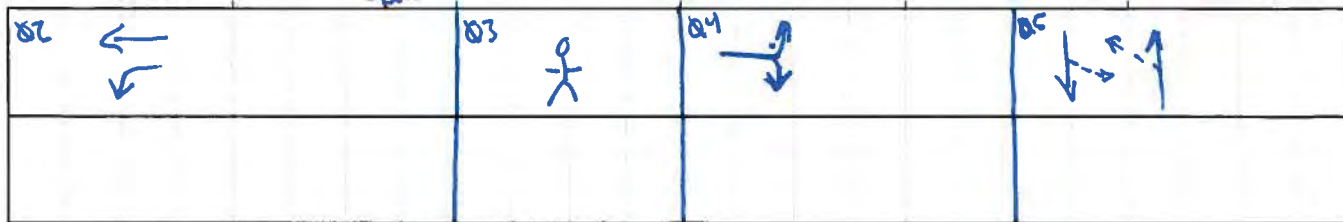

DEPARTMENT OF TRANSPORTATION

PROJECT - _____ LOCATION # - 29-T D.O.T. INSPECTOR - _____ DATE OF NEW SERVICE - _____
 TOWN - WAINWRIGHT LOCATION - RT 150 @ NORTH CHERRY STS. CONTRACTOR'S REP. - JLB CHANGE OVER DATE - _____

LOOP DETECTOR TEST - (PERFORMED BY CONTRACTOR) SEE STANDARD SHEET TR-1000_01

TEST	INSULATION RESISTANCE (MEGGER)	LOOP CIRCUIT RESISTANCE	POWER INTERRUPTION
DATE			

PRELIMINARY VISUAL INSPECTION - (PERFORMED BY INSPECTOR)

DATE: 1/13/12

FOUNDATIONS	TR-1002_01
CTRL FND 4" ABOVE GROUND	Y
CONCRETE PAD (3'X4')	Y
CAST IN PLACE, BRUSH FINISHED	Y
CONDUITS BONDED TO GROUND ROD	Y
DUCT SEAL IN CONDUITS	Y

PEDESTALS	TR-1102_01
LOCATION	OK
PLUMB	OK
BONDED TO GROUND ROD	UNK.
CRUSHED STONE IN FOUNDATION CENTER	UNK.

PUSH BUTTONS	TR-1107_01
ADA TYPE BUTTON, (2" DIA.), PIEZO	OK
42" MOUNTING HEIGHT	OK
ACCESIBLE FROM SIDEWALK/RAMP	OK

HANDHOLES	TR-1010_01
FLUSH WITH GRADE	Y
SET ON CRUSHED STONE BASE	①
COVER & CONDUITS BONDED	N
DUCT SEAL IN CONDUITS	N

TRAFFIC SIGNALS	TR-1105_01
SPAN LAYOUT	OK
PLUMB APPEARANCE	OK.
FACES: TYPE & LOCATION	OK
VISORS / LOUVERS / BACK PLATES	OK.
MISSING HARDWARE: BOTTOM CAPS, ETC..	OK
HEIGHT 16'-17' TO BOTTOM	OK
SIGHT DISTANCE (VISIBILITY)	OK.
UTILITY CLEARANCES	OK(4)

ADA REQUIREMENTS	
CROSSWALKS	Y(5)
SIDEWALK (CLEAR PATH, MIN 36")	Y
RAMPS W/ DETECTABLE WARNING STRIP	②

SPAN POLES / MAST ARMS	TR-1103_01
LOCATION	OK
BASE GROUTED	OK
PROPER RAKE. PLUMB UNDER LOAD	OK
HEIGHT / ARM LENGTH	OK
H.H. CVR. POLE CAP, BOLT CVR	OK
BONDED TO GROUND ROD	UNK.
I.D. TAG	UNK.
1 SPAN CLAMP PER ATTACHMENT	OK

PEDESTRIAN SIGNALS	N/A	TR-1102_01
CORRECT TYPE / SIZE		OK
FACING PED. TRAFFIC		OK
PROPER ADVISORY SIGNS		OK

SIGNS	
SPAN & POST MOUNT	OK(3)
LANE USE ARROWS	OK
NTOR SIGNS	N/A.
STOP, STOP AHEAD, INT WARNING	N/A
SIGNAL AHEAD	N/A.
FLASHING "STOP AHEAD"	N/A

PAVEMENT MARKINGS	
LANE ARROWS	OK(5)
PROPER LANE & SHOULDER WIDTH	OK
CENTER LINES	OK
STOP BAR PLACEMENT	OK
ELEPHANT TRACKS	N/A

NOTES: ① SOME YES - SOME UNK

② - N/W & S/W COR. - YES OTHERS NO.
 ③ - NRT - ON S/E COR. LEANING
 ④ - APPEARS UTILITY POLE #2208 BEING REPLACED - REASON FOR POLE TO POLE TO WENTWORTH WIRING PHOTO 0096

⑤ WORK



30T

Field Inspection

SIGNAL EQUIPMENT EVALUATION FORM

CITY/TOWN _____

JOB# _____

DATE 4/19/12 LOCATION Hall Ave @ Washington St

30T

CONTROLLER CABINET INVENTORY									
Component	Local Controller	Master Controller	CM / MMU	Detector Amplifier	Time Clock	Preemption	Load Switches	Flasher	Cabinet
Quantity	1	N/A	1	6	N/A	1	5/12	1	1
Make	Peck		Peck	Sarasota		SM	PDC	PDC	Peck
Model #	3000 E		Double Diamond	ZZZ GP6		Opticon 752	SSS-87WP	SSF-87WP	9445
Serial #	N/A		N/A	N/A		N/A	N/A	N/A	102282
Comments: <u>Coordination settings not programmed. Signal operates in Free mode Signal Comm Cable is in Cabinet</u>									

VEHICLE SIGNAL INVENTORY		
	Size	
	8"	12"
Red		9
Yellow		9
Green		9
R-Arrow		
Y-Arrow		
G-Arrow		
Comments:		

Y/G Arrow 1 (12")

PEDESTRIAN SIGNAL INVENTORY													
	QUANTITY									PUSHBUTTON ASSEMBLY			
	Size			Illumination Method							Quantity	Working?	ADA Compliant?
	9"	12"	16"	Countdown	Incandescent	LED	Fiber Optic	Poor Cond.?					
1 Section - Word										Button	4	4	4
1 Section - Symbol			8	0	8					Legend	4		
2 Section - Word										Audible	1		
2 Section - Symbol													
Comments:													

Actuated uncoordinated Signal
8 & Sequ.

SIGNAL SUPPORT INVENTORY							
		Post		Mast Arm		Span Wire	
		8'	10'	Truss	Monlever	Free	Tether
Mast Arm			3			✓	
Post	8'						
	Poor						
Comments:							

φ Set	1	2	3	4	5	6	7	8	9
Min	8	10	1	8					
Ext.	4.0	4.0	0.1	4.0					
Max I	10	20	30	20					
Max II	30	30	30	30					
Yel	4.0	4.0	3.0	4.0					
Red	2.0	2.0	0.0	2.0					
Walk			7						
Ped Cl			10						
Lock									
Recall		Max							

Sketch of intersection and signal layout:

Coord operation mode = TOD

- OUTLET FAN LAMP
- MAST ARM SPAN WIRE ORNAMENTAL
- VEH SIG 8" 12" Sect. 3 4 Bi 5
- Inc FO LED OP Failure
- Fixed Freeswing Tether
- Color Yellow Backplate Visor
- PED SIG 9" 12" 16"
- Inc FO LED Failure
- Word Symbol Red/Yellow
- Pushbutton Audible Failure
- DETECT Loop Magnetic Video
- Microwave Infrared Failure

Det	ds	φ
1	1	1
2	2	2
3	3	3
4	4	4
9	9	12
10	10	12
11	11	2
12	12	2
13	13	4
M	M	4
15	15	4
16	16	4
25	25	12
52	52	12
26	26	12
27	27	2
28	28	2
29	29	4
30	30	4
31	31	4
32	32	4



- ADVANCE SIGNING N Static Illuminated
- NUMBER OF PHASES 2 3 4 5 6

- LEFT TURN Perm Prot Lead Lag Simult
- PED PHASE N Exclusive Concurrent

CYCLE LENGTH Max _____ Min _____

WRW	X	X	X	X
Int Max	X	X	X	X
Ped Reg	X	X	X	X

OLA = 1, 2
OLB = 2

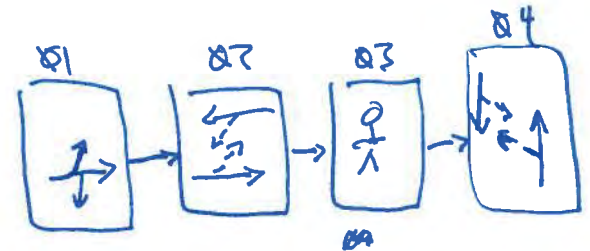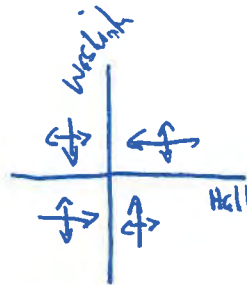

* Const call on Sys Det on
Hall Ave.
Washington

* Constant call on Stop bar Ped
on Hall Ave WB
D3

DEPARTMENT OF TRANSPORTATION

PROJECT - _____ LOCATION # - 30-T D.O.T. INSPECTOR - _____ DATE OF NEW SERVICE - _____
 TOWN - WASHINGTON LOCATION - WASHINGTON ST CONTRACTOR'S REP. - JLB CHANGE OVER DATE - _____
RT 150 (AVL MK)

LOOP DETECTOR TEST - (PERFORMED BY CONTRACTOR) SEE STANDARD SHEET TR-1000_01

TEST	INSULATION RESISTANCE (MEGGER)	LOOP CIRCUIT RESISTANCE	POWER INTERRUPTION
DATE			

PRELIMINARY VISUAL INSPECTION - (PERFORMED BY INSPECTOR)

DATE: 1/19/12

FOUNDATIONS TR-1002_01

CTRL FND 4" ABOVE GROUND	Y
CONCRETE PAD (3'X4')	Y
CAST IN PLACE, BRUSH FINISHED	Y
CONDUITS BONDED TO GROUND ROD	Y
DUCT SEAL IN CONDUITS	Y

HANDHOLES TR-1010_01

FLUSH WITH GRADE	Y ^①
SET ON CRUSHED STONE BASE	Y ^②
COVER & CONDUITS BONDED	Y ^②
DUCT SEAL IN CONDUITS	Y ^②

SPAN POLES / MAST ARMS TR-1103_01

LOCATION	OK
BASE GROUTED	OK
PROPER RAKE. PLUMB UNDER LOAD	OK
HEIGHT / ARM LENGTH	OK
H.H. CVR. POLE CAP, BOLT CVR	OK
BONDED TO GROUND ROD	UNK.
I.D. TAG	UNK.
1 SPAN CLAMP PER ATTACHMENT	OK

PEDESTALS TR-1102_01

LOCATION	OK
PLUMB	OK
BONDED TO GROUND ROD	UNK.
CRUSHED STONE IN FOUNDATION CENTER	UNK.

TRAFFIC SIGNALS TR-1105_01

SPAN LAYOUT	OK
PLUMB APPEARANCE	OK
FACES: TYPE & LOCATION	OK
VISORS / LOUVERS / BACK PLATES	OK
MISSING HARDWARE: BOTTOM CAPS, ETC.	OK
HEIGHT 16'-17' TO BOTTOM	OK
SIGHT DISTANCE (VISIBILITY)	OK
UTILITY CLEARANCES	OK

PEDESTRIAN SIGNALS TR-1102_01

CORRECT TYPE / SIZE	OK
FACING PED. TRAFFIC	OK
PROPER ADVISORY SIGNS	OK

PUSH BUTTONS TR-1107_01

ADA TYPE BUTTON, (2" DIA.), PIEZO	OK
42" MOUNTING HEIGHT	OK
ACCESSIBLE FROM SIDEWALK/RAMP	OK

ADA REQUIREMENTS

CROSSWALKS	OK ^③
SIDEWALK (CLEAR PATH, MIN 36")	OK
RAMPS W/ DETECTABLE WARNING STRIP	Y ^③

SIGNS

SPAN & POST MOUNT	OK
LANE USE ARROWS	N/A
NTOR SIGNS	N/A
STOP, STOP AHEAD, INT WARNING	N/A
SIGNAL AHEAD	N/A
FLASHING "STOP AHEAD"	N/A

PAVEMENT MARKINGS

LANE ARROWS	N/A
PROPER LANE & SHOULDER WIDTH	OK
CENTER LINES	OK
STOP BAR PLACEMENT	OK
ELEPHANT TRACKS	N/A
CROSSWALKS	Y ^④

NOTES: ① NOT PER PLANS

② FAR THOSE OBSERVED.
③ NEW RAMPS
④ BAD COND.



32T

Field Inspection

SIGNAL EQUIPMENT EVALUATION FORM

CITY/TOWN _____

JOB# _____

DATE _____

LOCATION Hall Ave (Route 100) @ Masonic Ave / Fire Station

32T

CONTROLLER CABINET INVENTORY

Component	Local Controller	Master Controller	CM / MMU	Detector Amplifier	Time Clock	Preemption	Load Switches	Flasher	Cabinet
Quantity	1	N/A	1	3	N/A		5	1	1
Make	Transyt		Transyt	Garasoto		Direct wire to Fire station	PDC	PDC	N/A
Model #	1090 EL		Model 1200	515T GP2			SS-87WP	SSF-87WP	N/A
Serial #	N/A		N/A	N/A					N/A
Comments: 1 unknown									

VEHICLE SIGNAL INVENTORY

	Size	
	8"	12"
Red	(1)	(2) 7
Yellow	(4)	(2) 7
Green	(1)	7
R-Arrow		
Y-Arrow		
G-Arrow		
Comments: (Fire Station) intersection		

PEDESTRIAN SIGNAL INVENTORY

	QUANTITY									PUSHBUTTON ASSEMBLY		
	Size				Illumination Method					Quantity	Working?	ADA Compliant?
	9"	12"	16"	Countdown	Incandescent	LED	Fiber Optic	Poor Cond.?				
1 Section - Word										Button		
1 Section - Symbol										Legend		
2 Section - Word										Audible		
2 Section - Symbol												
Comments: No Ped heads or pushbuttons												

SIGNAL SUPPORT INVENTORY							
		Post		Mast Arm		Span Wire	
		8'	10'	Truss	Monlever	Free	Tether
Mast Arm						✓	
Post	8'						
	Poor						
Comments:							

φ Set	1	2	3	4	5	6	7	8	9
Min	10	25		10					
Ext.	3.0	4.0		3.0					
Max I	15	35		25					
Max II	30	25		25					
Yel	3.0	3.0		3.0					
Red	1.0	2.0		1.0					
Walk				8	9				
Ped Cl				10					
Lock									
Recall		Min Max							


Sketch of intersection and signal layout:

- OUTLET FAN LAMP
 MAST ARM SPAN WIRE ORNAMENTAL
 VEH SIG 8" 12" Sect. 3 4 Bi 5
 Inc FO LED OP Failure
 Fixed Freeswing Tether
 Color Green & Yellow Backplate Visor
 PED SIG 9" 12" 16"
None Inc FO LED Failure
 Word Symbol Red/Yellow
 Pushbutton Audible Failure
 DETECT Loop Magnetic Video
 Microwave Infrared Failure

ADVANCE SIGNING N Static Illuminated
 NUMBER OF PHASES 2 3 4 5 6

LEFT TURN Perm Prot Lead Lag Simult
 PED PHASE N Exclusive Concurrent

CYCLE LENGTH Max _____ Min _____

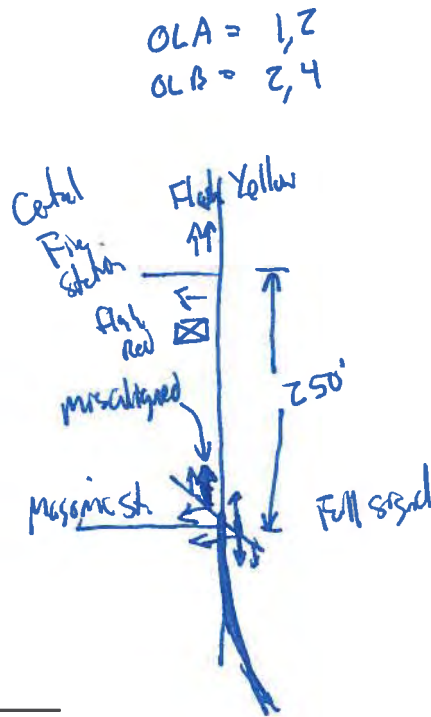

Amp 1 NB Works
 Amp 2 SB Nonresp.
 Amp 3 EB Works with Delay (7 Sec)

DEPARTMENT OF TRANSPORTATION

PROJECT - _____ LOCATION # - 32-T D.O.T. INSPECTOR - _____ DATE OF NEW SERVICE - _____
 TOWN - Wallingford LOCATION - HILL AVE & MASONIC DRIVE CONTRACTOR'S REP. - JLS CHANGE OVER DATE - _____

LOOP DETECTOR TEST - (PERFORMED BY CONTRACTOR) SEE STANDARD SHEET TR-1000.01

TEST	INSULATION RESISTANCE (MEGGER)	LOOP CIRCUIT RESISTANCE	POWER INTERRUPTION
DATE			

PRELIMINARY VISUAL INSPECTION - (PERFORMED BY INSPECTOR)

DATE: 1/20/12

FOUNDATIONS	TR-1002.01
CTRL FND 4" ABOVE GROUND	Y
CONCRETE PAD (3'X4')	N
CAST IN PLACE, BRUSH FINISHED	Y
CONDUITS BONDED TO GROUND ROD	Y
DUCT SEAL IN CONDUITS	Y

PEDESTALS	TR-1102.01
LOCATION	N/A
PLUMB	↓
BONDED TO GROUND ROD	↓
CRUSHED STONE IN FOUNDATION CENTER	↓

PUSH BUTTONS	TR-1107.01
ADA TYPE BUTTON, (2" DIA.), PIEZO	N/A
42" MOUNTING HEIGHT	
ACCESSIBLE FROM SIDEWALK/RAMP	

HANDHOLES	TR-1010.01
FLUSH WITH GRADE	Y
SET ON CRUSHED STONE BASE	Y
COVER & CONDUITS BONDED	N
DUCT SEAL IN CONDUITS	N

TRAFFIC SIGNALS	TR-1105.01
SPAN LAYOUT	OK
PLUMB APPEARANCE	OK
FACES: TYPE & LOCATION	OK
VISORS / LOUVERS / BACK PLATES	OK
MISSING HARDWARE: BOTTOM CAPS, ETC.	OK
HEIGHT 16'-17' TO BOTTOM	OK
SIGHT DISTANCE (VISIBILITY)	OK
UTILITY CLEARANCES	OK

ADA REQUIREMENTS	TR-1107.01
CROSSWALKS	N/A
SIDEWALK (CLEAR PATH, MIN 36")	↓
RAMPS W/ DETECTABLE WARNING STRIP	↓

SPAN POLES / MAST ARMS ^②	TR-1103.01
LOCATION	N/A
BASE GROUTED	N/A
PROPER RAKE. PLUMB UNDER LOAD	↓
HEIGHT / ARM LENGTH	↓
H.H. CVR. POLE CAP, BOLT CVR	↓
BONDED TO GROUND ROD	↓
I.D. TAG	↓
1 SPAN CLAMP PER ATTACHMENT	↓

PEDESTRIAN SIGNALS	TR-1102.01
CORRECT TYPE / SIZE	N/A
FACING PED. TRAFFIC	↓
PROPER ADVISORY SIGNS	↓

SIGNS	TR-1107.01
SPAN & POST MOUNT	N/A
LANE USE ARROWS	N/A
NTOR SIGNS	N/A
STOP, STOP AHEAD, INT WARNING	N/A
SIGNAL AHEAD	N/A
FLASHING "STOP AHEAD"	N/A

NOTES: ^① FOR THOSE OBSERVERS
^② WOOD UTIL. POLES.

PAVEMENT MARKINGS	TR-1107.01
LANE ARROWS	N/A
PROPER LANE & SHOULDER WIDTH	↓
CENTER LINES	↓
STOP BAR PLACEMENT	↓
ELEPHANT TRACKS	↓



54T

Field Inspection

SIGNAL EQUIPMENT EVALUATION FORM

CITY/TOWN _____ JOB# _____ DATE _____ LOCATION S. Turnpike @ Cook Hill Rd

54T

CONTROLLER CABINET INVENTORY									
Component	Local Controller	Master Controller	CM / MMU	Detector Amplifier	Time Clock	Preemption	Load Switches	Flasher	Cabinet
Quantity	1	N/A	1 Peek	11	N/A	1	4/12	1	1
Make	Peek		↓	Sarsco		3M	PDC	PDC	Peek
Model #	3000		Double Diamond	535T		Opticon 562	SSS-87WP	SSF-87WP	5187
Serial #	170138		1090707	N/A		N/A	N/A	N/A	964380-1
Comments:									

VEHICLE SIGNAL INVENTORY		
	Size	
	8"	12"
Red	1	7
Yellow	1	7
Green	1	7
R-Arrow		
Y-Arrow		
G-Arrow		1
Comments:		

PEDESTRIAN SIGNAL INVENTORY												
	QUANTITY								PUSHBUTTON ASSEMBLY			
	Size			Illumination Method					Quantity	Working?	ADA Compliant?	
	9"	12"	16"	Countdown	Incandescent	LED	Fiber Optic	Poor Cond.?				
1 Section - Word									Button	2	2	2?
1 Section - Symbol									Legend	2		
2 Section - Word									Audible			
2 Section - Symbol												
Comments:												

DIA DI PZA DZG DMA DM DYC DAB SDI SDZ SD3

Orbit or when 2 is an 8 to Segv.

~~Card 55 TOP~~ Free operation

SIGNAL SUPPORT INVENTORY							
		Post		Mast Arm		Span Wire	
		8'	10'	Truss	Monlever	Free	Tether
Mast Arm						✓	
Post	8'						
	Poor						
Comments: 1 4' pole for ped button							


φ Set	1	2	3	4	5	6	7	8	9
Min	5	15		7					
Ext.	2.0	4.0		3.0					
Max I	12	25		18					
Max II	15	35		25					
Yel	3.0	3.0		3.0					
Red	1.0	2.0		2.0					
Walk				12					
Ped Cl				1					
Lock	NL		E	NL					
Recall		Min							

Sketch of intersection and signal layout:

WEM	x	x	x	x	x	x	x	x
Inh Max	x	x	x	x	x	x	x	x
Ped Recg	x	x	x	x	x	x	x	x

Preempt Run 1 Chase Hill Road

OLA = 1, 2

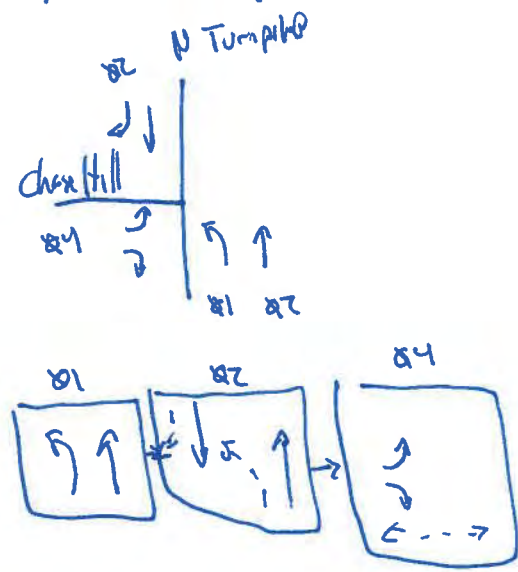

- OUTLET FAN LAMP
- MAST ARM SPAN WIRE ORNAMENTAL
- VEH SIG 8" 12" Sect 3 4 Bi 5
- Inc FO LED OP Failure
- Fixed Freeswing Tether
- Color Yellow Backplate Visor
- PED SIG 9" 12" 16"
- Inc FO LED Failure
- Word Symbol Red/Yellow
- Pushbutton Audible Failure
- DETECT Loop Magnetic Video
- Microwave Infrared Failure

Pet	0
chn.	1
17	4
18	4
19	4
20	1
21	1
22	1
23	1
24	1
25	2
26	2
27	2
28	4
29	4
30	1
31	1
32	1

RH/G

ADVANCE SIGNING N Static Illuminated

NUMBER OF PHASES 2 3 4 5 6

LEFT TURN Perm Prot Lead Lag Simult

PED PHASE N Exclusive Concurrent

CYCLE LENGTH Max _____ Min _____

3 Sys Pet.

DEPARTMENT OF TRANSPORTATION

PROJECT - _____ LOCATION # - 54-T D.O.T. INSPECTOR - _____ DATE OF NEW SERVICE - _____
 TOWN - WALINGFORD LOCATION - SOUTH TURNPIKE RD AT COOK MILL RD. CONTRACTOR'S REP. - JLB CHANGE OVER DATE - _____

LOOP DETECTOR TEST - (PERFORMED BY CONTRACTOR) SEE STANDARD SHEET TR-1000_01

TEST	INSULATION RESISTANCE (MEGGER)	LOOP CIRCUIT RESISTANCE	POWER INTERRUPTION
DATE			

PRELIMINARY VISUAL INSPECTION - (PERFORMED BY INSPECTOR)

DATE: 1/20/12

FOUNDATIONS	TR-1002_01
CTRL FND 4" ABOVE GROUND	Y
CONCRETE PAD (3'X4')	Y
CAST IN PLACE, BRUSH FINISHED	Y
CONDUITS BONDED TO GROUND ROD	Y
DUCT SEAL IN CONDUITS	Y

PEDESTALS	TR-1102_01
LOCATION	OK (4)
PLUMB	OK
BONDED TO GROUND ROD	UNK
CRUSHED STONE IN FOUNDATION CENTER	UNK

PUSH BUTTONS	TR-1107_01
ADA TYPE BUTTON, (2" DIA.), PIEZO	OK
42" MOUNTING HEIGHT	OK
ACCESSIBLE FROM SIDEWALK/RAMP	N

HANDHOLES	TR-1010_01
FLUSH WITH GRADE	Y (1)
SET ON CRUSHED STONE BASE	Y (2)
COVER & CONDUITS BONDED	Y (3)
DUCT SEAL IN CONDUITS	Y (2)

TRAFFIC SIGNALS	TR-1105_01
SPAN LAYOUT	OK
PLUMB APPEARANCE	OK
FACES: TYPE & LOCATION	OK
VISORS / LOUVERS / BACK PLATES	OK
MISSING HARDWARE: BOTTOM CAPS, ETC.	OK
HEIGHT 16'-17' TO BOTTOM	OK
SIGHT DISTANCE (VISIBILITY)	OK
UTILITY CLEARANCES	OK

ADA REQUIREMENTS	TR-1107_01
CROSSWALKS	N/A
SIDEWALK (CLEAR PATH, MIN 36")	↓
RAMPS W/ DETECTABLE WARNING STRIP	↓

SPAN POLES / MAST ARMS	TR-1103_01
LOCATION	OK
BASE GROUTED	OK
PROPER RAKE. PLUMB UNDER LOAD	OK
HEIGHT / ARM LENGTH	OK
H.H. CVR. POLE CAP, BOLT CVR	OK
BONDED TO GROUND ROD	UNK
I.D. TAG	UNK
1 SPAN CLAMP PER ATTACHMENT	OK

PEDESTRIAN SIGNALS	TR-1102_01
CORRECT TYPE / SIZE	N/A
FACING PED. TRAFFIC	N/A
PROPER ADVISORY SIGNS	N/A

SIGNS	TR-1107_01
SPAN & POST MOUNT	OK (5)
LANE USE ARROWS	OK
NTOR SIGNS	N/A
STOP, STOP AHEAD, INT WARNING	N/A
SIGNAL AHEAD	N/A
FLASHING "STOP AHEAD"	N/A

NOTES: (1) SEVERAL H.H. NOT FOUND IN FIELD
 (2) FOR THOSE OBSERVED
 (3) NOT COVERS
 (4) NOT ADA ACCESSIBLE

(5) LANE USE SIGN MISSING @ SB COOK MILL.

PAVEMENT MARKINGS	TR-1107_01
LANE ARROWS	OK
PROPER LANE & SHOULDER WIDTH	OK
CENTER LINES	OK
STOP BAR PLACEMENT	OK
ELEPHANT TRACKS	N/A



55T

Field Inspection

SIGNAL EQUIPMENT EVALUATION FORM

CITY/TOWN _____

JOB# _____

DATE _____

 LOCATION S Turnpike Rd @ Chestnut Rd
SST

CONTROLLER CABINET INVENTORY									
Component	Local Controller	Master Controller	CM / MMU	Detector Amplifier	Time Clock	Preemption	Load Switches	Flasher	Cabinet
Quantity	1	N/A	1	2	N/A	1	5/12	1	1
Make	Peek		Peek	Sarsotz		3M	PDC	PDC	Southern Massachusetts
Model #	3000		IZELRA	1-515T GP2 1-535T		Opticom SGZ	SSS-87WP	SSF-87WP	N/A
Serial #	N/A		N/A			N/A	N/A	N/A	N/A
Comments:						with self rack			

VEHICLE SIGNAL INVENTORY		
	Size	
	8"	12"
Red	4	2
Yellow	4	2
Green	4	2
R-Arrow		0
Y-Arrow		1
G-Arrow		1
Comments:		

PEDESTRIAN SIGNAL INVENTORY													
	QUANTITY									PUSHBUTTON ASSEMBLY			
	Size			Countdown	Incandescent	LED	Fiber Optic	Poor Cond.?		Quantity	Working?	ADA Compliant?	
	9"	12"	16"										
1 Section - Word										Button			
1 Section - Symbol										Legend			
2 Section - Word										Audible			
2 Section - Symbol													
Comments: <u>No Red signals or buttons</u>													

omit 01 if 02 is on
8a Sequ.

SIGNAL SUPPORT INVENTORY						
	Post		Mast Arm		Span Wire	
	8'	10'	Truss	Monlever	Free	Tether
Mast Arm						
Post	8'					
	Poor					
Comments:						

φ Set	1	2	3	4	5	6	7	8	9
Min	5	15	7		6				
Ext.	20				3.0				
Max I	8	18	7		24				
Max II	10	21	7		24				
Yel	3.0	0.1	3.0		3.0				
Red	0.1	0.0	20		1.0				
Walk		9							
Ped Cl		1							
Lock	PL		UL						
Recall		Max	Min						

Sketch of intersection and signal layout:

CNAF		X						
WEM	X	X	X	X	X	X	X	X
Inh Max	X	X	X	X	X	X	X	X
Ped Req	X	X	X	X	X	X	X	X
Coord Phase		X						

- OUTLET FAN LAMP 2 neither are working
- MAST ARM SPAN WIRE ORNAMENTAL
- VEH SIG 8" 12" Sect. 3 4 Bi 5
 - Inc FO LED OP Failure
 - Fixed Freeswing Tether
 - Color Yellow Backplate Visor
- PED SIG 9" 12" 16"
 - Inc FO LED Failure
 - Word Symbol Red/Yellow
 - Pushbutton Audible Failure
- DETECT Loop Magnetic Video
 - Microwave Infrared Failure
- ADVANCE SIGNING N Static Illuminated
- NUMBER OF PHASES 2 3 4 5 6
- LEFT TURN Perm Prot Lead Lag Simult
- PED PHASE N Exclusive Concurrent

Det	chn	φ
25	1	
26	5	

OLA = 1, 2, 3
OLB = 2, 3

when flashing stop ahead

Cycle	split	offset	01	02	03	05	07
1	1	10	16	25	19	40	70
2	1	11	18	26	19	37	75

TOP Plan (7 days)
0700 - 1500 1/1/1
1500 - 1800 2/1/1
1800 - 0100 1/1/1



CYCLE LENGTH Max _____ Min _____

desire to get reflowing

2010 for road c sign 01 & 02

DEPARTMENT OF TRANSPORTATION

PROJECT - _____ LOCATION # - 55-T D.O.T. INSPECTOR - _____ DATE OF NEW SERVICE - _____
 TOWN - WARRINGFORD LOCATION - SOUTH GREEN PINE RD & CHESHIRE RD CONTRACTOR'S REP. - JUB CHANGE OVER DATE - _____

LOOP DETECTOR TEST - (PERFORMED BY CONTRACTOR) SEE STANDARD SHEET TR-1000_01

TEST	INSULATION RESISTANCE (MEGGER)	LOOP CIRCUIT RESISTANCE	POWER INTERUPTION
DATE			

PRELIMINARY VISUAL INSPECTION - (PERFORMED BY INSPECTOR)

DATE: 1/20/12

FOUNDATIONS	TR-1002_01
CTRL FND 4" ABOVE GROUND	Y
CONCRETE PAD (3'X4')	Y
CAST IN PLACE, BRUSH FINISHED	Y
CONDUITS BONDED TO GROUND ROD	Y
DUCT SEAL IN CONDUITS	Y

PEDESTALS	TR-1102_01
LOCATION	N/A
PLUMB	↓
BONDED TO GROUND ROD	↓
CRUSHED STONE IN FOUNDATION CENTER	↓

PUSH BUTTONS	TR-1107_01
ADA TYPE BUTTON, (2" DIA.), PIEZO	N/A
42" MOUNTING HEIGHT	↓
ACCESIBLE FROM SIDEWALK/RAMP	↓

HANDHOLES	TR-1010_01
FLUSH WITH GRADE	Y
SET ON CRUSHED STONE BASE	UNK.
COVER & CONDUITS BONDED	UNK.
DUCT SEAL IN CONDUITS	UNK.

TRAFFIC SIGNALS	TR-1105_01
SPAN LAYOUT	OK
PLUMB APPEARANCE	OK
FACES: TYPE & LOCATION	OK
VISORS / LOUVERS / BACK PLATES	OK
MISSING HARDWARE: BOTTOM CAPS, ETC.	OK
HEIGHT 16'-17' TO BOTTOM	OK
SIGHT DISTANCE (VISIBILITY)	OK
UTILITY CLEARANCES	OK

ADA REQUIREMENTS	TR-1107_01
CROSSWALKS	N/A
SIDEWALK (CLEAR PATH, MIN 36")	↓
RAMPS W/ DETECTABLE WARNING STRIP	↓

SPAN POLES / MAST ARMS	TR-1103_01
LOCATION	OK
BASE GROUTED	OK
PROPER RAKE. PLUMB UNDER LOAD	OK
HEIGHT / ARM LENGTH	OK
H.H. CVR. POLE CAP, BOLT CVR	OK
BONDED TO GROUND ROD	UNK.
I.D. TAG	Y
1 SPAN CLAMP PER ATTACHMENT	Y

PEDESTRIAN SIGNALS	TR-1102_01
CORRECT TYPE / SIZE	N/A
FACING PED. TRAFFIC	↓
PROPER ADVISORY SIGNS	↓

SIGNS	TR-1107_01
SPAN & POST MOUNT	OK
LANE USE ARROWS	OK
NTOR SIGNS	N/A
STOP, STOP AHEAD, INT WARNING	OK
SIGNAL AHEAD	OK
FLASHING "STOP AHEAD"	OK

PAVEMENT MARKINGS	TR-1107_01
LANE ARROWS	N/A
PROPER LANE & SHOULDER WIDTH	OK
CENTER LINES	OK
STOP BAR PLACEMENT	OK
ELEPHANT TRACKS	N/A

NOTES:



56T

Field Inspection

SIGNAL EQUIPMENT EVALUATION FORM

SGT

CITY/TOWN _____ JOB# _____ DATE _____ LOCATION _____

CONTROLLER CABINET INVENTORY									
Component	Local Controller	Master Controller	CM / MMU	Detector Amplifier	Time Clock	Preemption	Load Switches	Flasher	Cabinet
Quantity	1	N/A	1	12	N/A	1	6/12	1	1
Make	Peek		Transit	Sarsate		3M	PDC	PDC	Peek
Model #	3000		12 EL	535T		Opticon 562	SSS-87WP	SSF-87WP	5410
Serial #	N/A		N/A	N/A		N/A	N/A	N/A	N/A
Comments:									

VEHICLE SIGNAL INVENTORY		
	Size	
	8"	12"
Red		10
Yellow		10
Green		10
R-Arrow		
Y-Arrow		1
G-Arrow		4
Comments:		

Handwritten signature

PEDESTRIAN SIGNAL INVENTORY													
	QUANTITY									PUSHBUTTON ASSEMBLY			
	Size			Illumination Method						Quantity	Working?	ADA Compliant?	
	9"	12"	16"	Countdown	Incandescent	LED	Fiber Optic	Poor Cond.?					
1 Section - Word										Button			
1 Section - Symbol										Legend			
2 Section - Word										Audible			
2 Section - Symbol													
Comments:													

Handwritten mark

top 20 19 18 17 25 22
 bottom 8 32 30 31 22 21
 Detectors

12 3478
 56

SIGNAL SUPPORT INVENTORY							
		Post		Mast Arm		Span Wire	
		8'	10'	Truss	Monlever	Free	Tether
Mast Arm						✓	
Post	8'						
	Poor						
Comments:							

φ Set	1	2	3	4	5	6	7	8	9
Min	5	10	6		5	10	5		
Ext.	2.0	0.0	3.0		2.0	0.0	1.0		
Max I	11	23	12		11	23	8		
Max II	13	24	15		13	24	7		
Yel	3.0	3.0	3.0		3.0	3.0	3.0		
Red	2.0	2.0	2.0		2.0	2.0	2.0		
Walk		9				9			
Ped Cl		1				1			
Lock					NL		NL		
Recall		Max				Max			

Sketch of intersection and signal layout:

- OUTLET FAN LAMP *burnt out*
- MAST ARM SPAN WIRE ORNAMENTAL
- VEH SIG 8" 12" Sect. 3 4 Bi 5
- Inc FO LED OP Failure
- Fixed Freeswing Tether
- Color *Yellow* Backplate Visor
- PED SIG 9" 12" 16"
- None* Inc FO LED Failure
- Word Symbol Red/Yellow
- Pushbutton Audible Failure
- DETECT Loop Magnetic Video
- Microwave Infrared Failure

Coord by TOP

CNAI X X X X X X X X X
 WRM X X X X X X X X X
 Inh Max X X X X X X X X X
 Ped Recy X X X X X X X X X
 Walk Rest X X X X X X X X X
 Coord Phase X X X X X X X X X
 OLA = 1,2
 OLB = 2,3
 OLC = 1,5


Det	Ch	Q
17	2	2
18	2	2
19	6	6
20	6	6
21	3	3
22	3	3
23	7	7
24	7	7
25	5	5
26	1	1
27	1	1
28	1	1
29	1	1
30	5	5
31	7	7
32	7	7

Cycle	split	offset	Max	Min	01	02	03	05	06	07
1	1	0	70	75	23	37	23	23	37	17
2	1	0	30	30	24	35	26	24	35	15

ADVANCE SIGNING N Static Illuminated
 NUMBER OF PHASES 2 3 4 5 6

LEFT TURN Perm Prot Lead Lag Simult
 PED PHASE N Exclusive Concurrent

CYCLE LENGTH Max _____ Min _____

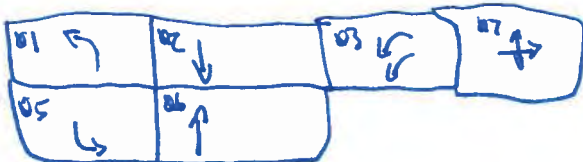

T.O.D.
 Plan 1 (7 days)
 0:00 - 15:00 1/1/1
 15:00 - 18:00 2/1/1
 18:00 - 0:00 1/1/1



DEPARTMENT OF TRANSPORTATION

PROJECT - _____ LOCATION # - 56-T D.O.T. INSPECTOR - _____ DATE OF NEW SERVICE - _____
 TOWN - Wilmington LOCATION - Quinnipiac St. to Route 15 + Masonic Ave CONTRACTOR'S REP. - JLB CHANGE OVER DATE - _____

LOOP DETECTOR TEST - (PERFORMED BY CONTRACTOR) SEE STANDARD SHEET TR-1000_01

TEST	INSULATION RESISTANCE (MEGGER)	LOOP CIRCUIT RESISTANCE	POWER INTERRUPTION
DATE			

PRELIMINARY VISUAL INSPECTION - (PERFORMED BY INSPECTOR)

DATE: _____

FOUNDATIONS	TR-1002-01
CTRL FND 4" ABOVE GROUND	Y
CONCRETE PAD (3'X4')	Y
CAST IN PLACE, BRUSH FINISHED	Y
CONDUITS BONDED TO GROUND ROD	Y
DUCT SEAL IN CONDUITS	Y

PEDESTALS	TR-1102-01
LOCATION	OK
PLUMB	N
BONDED TO GROUND ROD	UNK.
CRUSHED STONE IN FOUNDATION CENTER	UNK.

PUSH BUTTONS	TR-1107-01
ADA TYPE BUTTON, (2" DIA.), PIEZO	N/A
42" MOUNTING HEIGHT	↓
ACCESSIBLE FROM SIDEWALK/RAMP	↓

HANDHOLES	TR-1010-01
FLUSH WITH GRADE	Y
SET ON CRUSHED STONE BASE	N ①
COVER & CONDUITS BONDED	②
DUCT SEAL IN CONDUITS	Y ③

TRAFFIC SIGNALS	TR-1105-01
SPAN LAYOUT	OK
PLUMB APPEARANCE	OK
FACES: TYPE & LOCATION	OK
VISORS / LOUVERS / BACK PLATES	OK
MISSING HARDWARE: BOTTOM CAPS, ETC.	OK
HEIGHT 16'-17' TO BOTTOM	OK
SIGHT DISTANCE (VISIBILITY)	OK
UTILITY CLEARANCES	OK

ADA REQUIREMENTS	
CROSSWALKS	N/A
SIDEWALK (CLEAR PATH, MIN 36")	↓
RAMPS W/ DETECTABLE WARNING STRIP	↓

SPAN POLES / MAST ARMS	TR-1103-01
LOCATION	OK
BASE GROUTED	OK
PROPER RAKE. PLUMB UNDER LOAD	OK
HEIGHT / ARM LENGTH	OK
H.H. CVR. POLE CAP, BOLT CVR	OK
BONDED TO GROUND ROD	UNK.
I.D. TAG	OK
1 SPAN CLAMP PER ATTACHMENT	OK

PEDESTRIAN SIGNALS	TR-1102-01
CORRECT TYPE / SIZE	N/A
FACING PED. TRAFFIC	↓
PROPER ADVISORY SIGNS	↓

SIGNS	
SPAN & POST MOUNT	OK ④
LANE USE ARROWS	OK
NTOR SIGNS	N/A
STOP, STOP AHEAD, INT WARNING	N/A ②
SIGNAL AHEAD	N/A
FLASHING "STOP AHEAD"	N/A

- NOTES: ① WATER PRESENT @ ONE LOC.
 ② CONDUITS BONDED - COVERS NOT
 ③ FOR THOSE OBSERVED
 ④ 1 SIGN DOWN OTHERS DAMAGED OR LEARNING
 ⑤ WORN ON QUINNIPAC ST.

PAVEMENT MARKINGS	
LANE ARROWS	OK
PROPER LANE & SHOULDER WIDTH	OK
CENTER LINES	OK
STOP BAR PLACEMENT	OK
ELEPHANT TRACKS	N/A
STOP BARS	⑤



57T

Field Inspection

12345

SIGNAL EQUIPMENT EVALUATION FORM

571

CITY/TOWN Wallingford, CT JOB# _____ DATE 1/2/12 LOCATION River Rd @ Quinnipiac St

CONTROLLER CABINET INVENTORY

Component	Local Controller	Master Controller	CM / MMU	Detector Amplifier	Time Clock	Preemption	Load Switches	Flasher	Cabinet
Quantity	1	N/A	1	6	N/A	1	5/12	1	1
Make	Peel		Transyt	Sarasota		3M	PDC	TSC	Peel
Model #	3000		12ELRA	535T		Opticom 512	SSS-87WP	Cube 204	5411
Serial #	9120		4180	N/A		N/A	N/A	N/A	970953
Comments: <u>Fault on detector DZB (22)</u>									

VEHICLE SIGNAL INVENTORY		
	Size	
	8"	12"
Red	1	9
Yellow	1	9
Green	1	9
R-Arrow		
Y-Arrow		3
G-Arrow		3
Comments: <u>EB heads mounted horizontal</u>		

PEDESTRIAN SIGNAL INVENTORY												
	QUANTITY								PUSHBUTTON ASSEMBLY			
	Size			Illumination Method					Quantity	Working?	ADA Compliant?	
	9"	12"	16"	Countdown	Incandescent	LED	Fiber Optic	Poor Cond.?				
1 Section - Word									Button	2	2	2
1 Section - Symbol									Legend			
2 Section - Word									Audible			
2 Section - Symbol												
Comments: <u>None</u>												

Coord Status = Free, input override

Omit 21 if 22 is on 8 & Sequ.


SIGNAL SUPPORT QUANTITIES							
		Post		Mast Arm		Span Wire	
		8'	10'	Truss	Monlever	Free	Tether
Post	Good					X	
	Fair			X	X	X	X
	Poor			X	X	X	X
Comments:							

φ Set	1	2	3	4	5	6	7	8	9
Min	3	9	9		9				
Ext.	1.0	2.0	2.0		2.0				
Max I	10	25	15		15				
Max II	5	22	14		15				
Yel	3.0	4.0	4.0		4.0				
Red	0.1	1.0	1.0		1.0				
Walk		9	11		11				
Ped Cl		1	1		1				
Lock	NL								
Recall		Max							

Sketch of intersection signal phasing and signal layout:

- OUTLET FAN/THERMOSTAT LAMP
- MAST ARM SPAN WIRE ORNAMENTAL
- VEH SIG 8" 12" Sect: 3 4 Bi 5 DH
- Inc FO LED OP Failure
- Fixed Freeswing Tether
- Color Yellow Backplate Visor
- PED SIG 9" 12" 16"
- Inc FO LED Failure
- None Word Symbol Red/Yellow
- Pushbutton Audible Failure
- DETECTION Loop Video Magnetic
- Microwave Infrared Failure
- ADVANCE SIGNING None Static Illuminated
- NUMBER OF PHASES 2 3 4 5 6 7 8
- LEFT-TURN Perm. Prot. Lead Lag Simult
- PED PHASE None Exclusive Concurrent
- CYCLE LENGTH Max _____ Min _____
- CABINET PHOTOS

Det chn. &
 1-8 1-8
 25 1
 26 2
 27 2
 22 2
 28 2
 29 3
 20 3
 31 3
 32 3

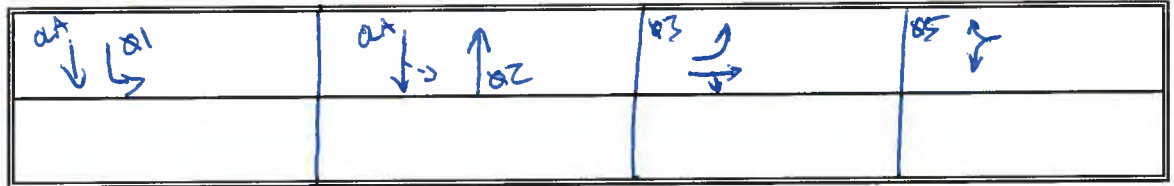

- CNAI X
- WRM X X X X X X X X
- Ink Max X →
- Ped Recy X →
- Coord phase X

OL card is programmed.



DEPARTMENT OF TRANSPORTATION

PROJECT - _____ LOCATION # - 57-T D.O.T. INSPECTOR - _____ DATE OF NEW SERVICE - _____
 TOWN - WALTON FUND LOCATION - QUINNPINE ST CONTRACTOR'S REP. - JLB CHANGE OVER DATE - _____
MT RTE 15 OFF RAMP to RIVER RD.

LOOP DETECTOR TEST - (PERFORMED BY CONTRACTOR) SEE STANDARD SHEET TR-1000.01

TEST	INSULATION RESISTANCE (MEGGER)	LOOP CIRCUIT RESISTANCE	POWER INTERRUPTION
DATE			

PRELIMINARY VISUAL INSPECTION - (PERFORMED BY INSPECTOR)

DATE: 2/2/12

FOUNDATIONS	TR-1002.01
CTRL FND 4" ABOVE GROUND	Y
CONCRETE PAD (3'X4')	Y
CAST IN PLACE, BRUSH FINISHED	Y
CONDUITS BONDED TO GROUND ROD	Y
DUCT SEAL IN CONDUITS	Y

PEDESTALS	TR-1102.01
LOCATION	OK
PLUMB	OK
BONDED TO GROUND ROD	UNK.
CRUSHED STONE IN FOUNDATION CENTER	UNK.

PUSH BUTTONS	TR-1107.01
ADA TYPE BUTTON, (2" DIA.), PIEZO	Y
42" MOUNTING HEIGHT	Y
ACCESSIBLE FROM SIDEWALK/RAMP	Y

HANDHOLES	TR-1010.01
FLUSH WITH GRADE	Y ①
SET ON CRUSHED STONE BASE	Y
COVER & CONDUITS BONDED	N
DUCT SEAL IN CONDUITS	Y ②

TRAFFIC SIGNALS	TR-1105.01
SPAN LAYOUT	OK
PLUMB APPEARANCE	OK
FACES: TYPE & LOCATION	OK ③
VISORS / LOUVERS / BACK PLATES	OK ④
MISSING HARDWARE: BOTTOM CAPS, ETC.	OK
HEIGHT 16'-17' TO BOTTOM	OK
SIGHT DISTANCE (VISIBILITY)	OK ⑤
UTILITY CLEARANCES	OK

ADA REQUIREMENTS	
CROSSWALKS	N
SIDEWALK (CLEAR PATH, MIN 36")	Y
RAMPS W/ DETECTABLE WARNING STRIP	N

SPAN POLES / MAST ARMS	TR-1103.01
LOCATION	OK
BASE GROUTED	OK
PROPER RAKE. PLUMB UNDER LOAD	OK
HEIGHT / ARM LENGTH	OK
H.H. CVR. POLE CAP, BOLT CVR	OK
BONDED TO GROUND ROD	UNK
I.D. TAG	OK
1 SPAN CLAMP PER ATTACHMENT	OK

PEDESTRIAN SIGNALS	TR-1102.01
CORRECT TYPE / SIZE <u>R/Y/G</u>	OK
FACING PED. TRAFFIC	OK
PROPER ADVISORY SIGNS	OK

SIGNS	
SPAN & POST MOUNT	OK
LANE USE ARROWS	OK
NTOR SIGNS	OK
STOP, STOP AHEAD, INT WARNING	OK
SIGNAL AHEAD	OK
FLASHING "STOP AHEAD"	OK

- NOTES:
- ① SOME COUNTS NOT BE LOCATED.
 - ② FOR THOSE OBSERVED.
 - ③ SOME INDICATIONS PARTIALLY OUT.
 - ④ REFINISH PAINT ON MAST SIGNALS
 - ⑤ ADVANCE SIGN ON QUINNPINE.

PAVEMENT MARKINGS	
LANE ARROWS	OK
PROPER LANE & SHOULDER WIDTH	OK
CENTER LINES	OK
STOP BAR PLACEMENT	OK
ELEPHANT TRACKS	N/A



- Enable Run
- Railroad Preempt
- Input Lock
- Go to Higher Run
- NEMA Priority
- Override UCF

Maximum Intervals: **3**
 User Priority: **1**
 Duration Service: **5**
 Preempt Delay: **0**
 Reservice Time: **0**

Inhibit Double Clearing OVL's
 Min. Green: **5.0**
 Min. Yellow: **0.0**
 Min. Red: **0.0**
 Min. Ped. Clearance: **0**
 Min. Overlap Yellow: **0.0**

- Go to Exit Phase
- Go to Next Demand
- Resume Sequence
- To Coordination

Valid
 Pedel
 Exit
 1 2 3
 x x x
 x x x
 x x x

FUNCTION	1	2	3	4	5	6	7	8
Phases	<input type="checkbox"/>	<input checked="" type="checkbox"/>	<input type="checkbox"/>	<input type="checkbox"/>	<input type="checkbox"/>	<input type="checkbox"/>	<input type="checkbox"/>	<input type="checkbox"/>
Calls	<input type="checkbox"/>	<input type="checkbox"/>	<input type="checkbox"/>	<input type="checkbox"/>	<input type="checkbox"/>	<input type="checkbox"/>	<input type="checkbox"/>	<input type="checkbox"/>

RUN	1																		
INTVL #	15	FLASH PLAN	SIG OUTS	1 A	2 B	3 C	4 D	5 E	6 F	7 G	8 H	9 I	10 J	11 K	12 L	13 M	14 N	15 O	16 P
TYPE			VEH		G														
TENTHS			PED																
EXIT			VEH O/L	G															
			PED O/L																
PC->YEL			OUTS																

RUN	1																		
INTVL #	4	FLASH PLAN	SIG OUTS	1 A	2 B	3 C	4 D	5 E	6 F	7 G	8 H	9 I	10 J	11 K	12 L	13 M	14 N	15 O	16 P
TYPE			VEH																
TENTHS			PED																
EXIT			VEH O/L																
			PED O/L																
PC->YEL			OUTS																

RUN	1																		
INTVL #	15	FLASH PLAN	SIG OUTS	1 A	2 B	3 C	4 D	5 E	6 F	7 G	8 H	9 I	10 J	11 K	12 L	13 M	14 N	15 O	16 P
TYPE			VEH																
TENTHS			PED																
EXIT			VEH O/L																
			PED O/L																
PC->YEL			OUTS																

RUN																			
INTVL #		FLASH PLAN	SIG OUTS	1 A	2 B	3 C	4 D	5 E	6 F	7 G	8 H	9 I	10 J	11 K	12 L	13 M	14 N	15 O	16 P
TYPE			VEH																
TENTHS			PED																
EXIT			VEH O/L																
			PED O/L																
PC->YEL			OUTS																

Project: _____
 City: Wallingford, CT
 Location: River Rd @ Rompage St
 Date: 4/4/12
 By: MJM
 Sheet: 5/1

58T

Field Inspection

2345

SIGNAL EQUIPMENT EVALUATION FORM

58T

CITY/TOWN Wallingford, CT JOB# _____ DATE 4/12 LOCATION Quinnipiac St @ Ward⁵/Bull Ave / Lufbery Ave

CONTROLLER CABINET INVENTORY									
Component	Local Controller	Master Controller	CM / MMU	Detector Amplifier	Time Clock	Preemption	Load Switches	Flasher	Cabinet
Quantity	1	N/A	1	7	N/A	1	9/12	1	1
Make	Peek		Transyt	Sarcosoft		3M	PDC	PDC	Peek
Model #	3000		IZELRA	ZZZ GPG		opticom 75Z	SS-87WP	SS-87WP	9948
Serial #	134788		21101135	N/A		N/A	N/A	N/A	N/A 102288
Comments: <u>tough to open door</u> Controller Rev. = 5074 v4.5 <u>Card status: Card, local TOD-Master</u> <u>Flashing failure on detector # den. 15 (D6)</u>									

VEHICLE SIGNAL INVENTORY		
	Size	
	8"	12"
Red	2+4 (6)	4+2+5 (11)
Yellow	2+4 (6)	4+2+5 (11)
Green	2+4 (6)	4+2+5 (11)
R-Arrow		
Y-Arrow		
G-Arrow		(5)
Comments:		

PEDESTRIAN SIGNAL INVENTORY													
	QUANTITY									PUSHBUTTON ASSEMBLY			
	Size			Illumination Method						Quantity	Working?	ADA Compliant?	
	9"	12"	16"	Countdown	Incandescent	LED	Fiber Optic	Poor Cond.?					
1 Section - Word										Button	5	5	5
1 Section - Symbol			6		6					Legend			
2 Section - Word										Audible			
2 Section - Symbol													
Comments:													

SIGNAL SUPPORT QUANTITIES


		Post		Mast Arm		Span Wire	
		8'	10'	Truss	Monlever	Free	Tether
Post	Good					✓	
	Fair			X	X	X	X
	Poor			X	X	X	X
Comments:							

8 & Sequ.

φ Set	1	2	3	4	5	6	7	8	9
Min		15		5	5	9			
Ext.		3.0		2.0	2.0	3.0			
Max I		52		18	18	42			
Max II		39		11	15	39			
Yel		3.0	0.1	3.0	3.0	3.0			
Red		4.0	0.0	4.0	4.0	4.0			
Walk			7						
Ped Cl			12						
Lock			NL		NL				
Recall		Min							

Sketch of intersection signal phasing and signal layout:


- OUTLET FAN/THERMOSTAT LAMP
- MAST ARM SPAN WIRE ORNAMENTAL
- VEH SIG 8" 12" Sect: 3 4 Bi 5 DH
 - Inc FO LED OP Failure
 - Fixed Freeswing Tether
 - Color Yellow/black Backplate Visor
- PED SIG 9" 12" 16"
 - Inc FO LED Failure
 - Word Symbol Red/Yellow
 - Pushbutton Audible Failure
- DETECTION Loop Video Magnetic
 - Microwave Infrared Failure
- ADVANCE SIGNING None Static Illuminated
- NUMBER OF PHASES 2 3 4 5 6 7 8
- LEFT-TURN Perm. Prot. Lead Lag Simult
- PED PHASE None Exclusive Concurrent
- CYCLE LENGTH Max _____ Min _____
- CABINET PHOTOS

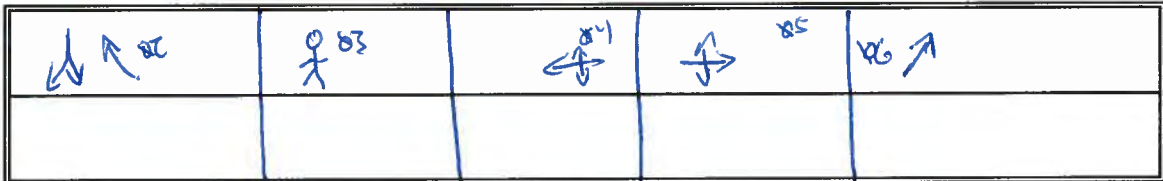

Datchn. 2
 1-8 1-8
 17 2
 18 2
 19 2
 20 1
 21 1
 22 1
 23 1
 24 1
 25 2
 26 2
 27 2
 28 2
 29 2
 30 2
 31 2
 32 2

CMA I 2Z
 WRM All
 Inh Max 2-6
 Walk Rest 2Z
 Coord phase 2Z

OLA = 2,4
 OL B = 2
 OL C = 2,5,6
 OL P = 2,6

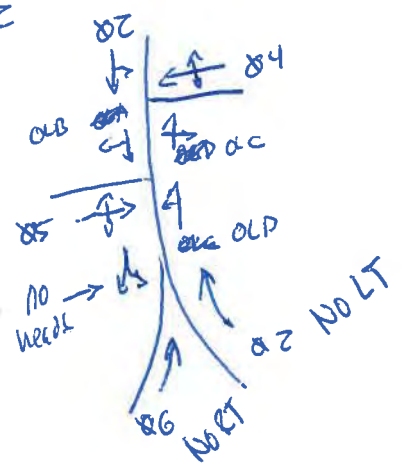

DEPARTMENT OF TRANSPORTATION

PROJECT - _____ LOCATION # - 5B-T D.O.T. INSPECTOR - _____ DATE OF NEW SERVICE - _____
 TOWN - WALWING FORD LOCATION - Quinnipiac St. CONTRACTOR'S REP. - JLB CHANGE OVER DATE - _____
(Bull/Lufberry/Ward Str.)

LOOP DETECTOR TEST - (PERFORMED BY CONTRACTOR) SEE STANDARD SHEET TR-1000_01

TEST	INSULATION RESISTANCE (MEGGER)	LOOP CIRCUIT RESISTANCE	POWER INTERRUPTION
DATE			

PRELIMINARY VISUAL INSPECTION - (PERFORMED BY INSPECTOR)

DATE: 2/2/12

FOUNDATIONS TR-1002_01

CTRL FND 4" ABOVE GROUND	Y
CONCRETE PAD (3'X4')	Y
CAST IN PLACE, BRUSH FINISHED	Y
CONDUITS BONDED TO GROUND ROD	Y
DUCT SEAL IN CONDUITS	Y

HANDHOLES TR-1010_01

FLUSH WITH GRADE	Y 0
SET ON CRUSHED STONE BASE	Y
COVER & CONDUITS BONDED	N 2
DUCT SEAL IN CONDUITS	Y 2

SPAN POLES / MAST ARMS TR-1103_01

LOCATION	OK
BASE GROUTED	OK
PROPER RAKE. PLUMB UNDER LOAD	OK
HEIGHT / ARM LENGTH	OK
H.H. CVR. POLE CAP, BOLT CVR	OK
BONDED TO GROUND ROD	UNK
I.D. TAG	UNK.
1 SPAN CLAMP PER ATTACHMENT	OK

PEDESTALS TR-1102_01

LOCATION	OK
PLUMB	OK 3
BONDED TO GROUND ROD	UNK
CRUSHED STONE IN FOUNDATION CENTER	UNK.

TRAFFIC SIGNALS TR-1105_01

SPAN LAYOUT	OK
PLUMB APPEARANCE	OK
FACES: TYPE & LOCATION	OK
VISORS / LOUVERS / BACK PLATES	OK
MISSING HARDWARE: BOTTOM CAPS, ETC.	OK
HEIGHT 16'-17' TO BOTTOM	OK
SIGHT DISTANCE (VISIBILITY)	OK
UTILITY CLEARANCES	OK

PEDESTRIAN SIGNALS TR-1102_01

CORRECT TYPE / SIZE	N/A	OK.
FACING PED. TRAFFIC		OK
PROPER ADVISORY SIGNS		OK

PUSH BUTTONS TR-1107_01

ADA TYPE BUTTON, (2" DIA.), PIEZO	Y
42" MOUNTING HEIGHT	Y
ACCESSIBLE FROM SIDEWALK/RAMP	Y

ADA REQUIREMENTS

CROSSWALKS	OK
SIDEWALK (CLEAR PATH, MIN 36")	OK
RAMPS W/ DETECTABLE WARNING STRIP	N

SIGNS

SPAN & POST MOUNT	OK
LANE USE ARROWS	OK
NTOR SIGNS	OK
STOP, STOP AHEAD, INT WARNING	N/A
SIGNAL AHEAD	N/A
FLASHING "STOP AHEAD"	N/A

PAVEMENT MARKINGS

LANE ARROWS	N/A
PROPER LANE & SHOULDER WIDTH	OK
CENTER LINES	OK
STOP BAR PLACEMENT	OK
ELEPHANT TRACKS	N/A

NOTES: ① Some could not be located

② For those observed

③ One damaged opp Bull NE



1 0
Veh
Dwell
Fixed
Exit
X X X
X
X X X
X

- Enable Run
- Railroad Preempt
- Input Lock
- Go to Higher Run
- NEMA Priority
- Override UCF

Maximum Intervals: **3**
 User Priority: **1**
 Duration Service: **15**
 Preempt Delay: **0**
 Reservice Time: **5**

Inhibit Double Clearing OVL's
 Min. Green: **5.0**
 Min. Yellow: **0.0**
 Min. Red: **0.0**
 Min. Ped. Clearance: **12**
 Min. Overlap Yellow: **0.0**

- Go to Exit Phase
- Go to Next Demand
- Resume Sequence
- To Coordination

FUNC\PH	1	2	3	4	5	6	7	8
Phases	<input type="checkbox"/>	<input checked="" type="checkbox"/>	<input type="checkbox"/>	<input type="checkbox"/>	<input type="checkbox"/>	<input type="checkbox"/>	<input type="checkbox"/>	<input type="checkbox"/>
Calls	<input type="checkbox"/>	<input type="checkbox"/>	<input type="checkbox"/>	<input checked="" type="checkbox"/>	<input checked="" type="checkbox"/>	<input type="checkbox"/>	<input type="checkbox"/>	<input type="checkbox"/>

RUN	2																		
INTVL #	15	FLASH PLAN	SIG OUTS	1 A	2 B	3 C	4 D	5 E	6 F	7 G	8 H	9 I	10 J	11 K	12 L	13 M	14 N	15 O	16 P
TYPE			VEH								G								
TENTHS			PED																
EXIT			VEH O/L		G	G	G												
			PED O/L																
PC->YEL			OUTS																

RUN	2																		
INTVL #	42	FLASH PLAN	SIG OUTS	1 A	2 B	3 C	4 D	5 E	6 F	7 G	8 H	9 I	10 J	11 K	12 L	13 M	14 N	15 O	16 P
TYPE			VEH								Y								
TENTHS			PED																
EXIT			VEH O/L																
			PED O/L																
PC->YEL			OUTS																

RUN	2																		
INTVL #	3	FLASH PLAN	SIG OUTS	1 A	2 B	3 C	4 D	5 E	6 F	7 G	8 H	9 I	10 J	11 K	12 L	13 M	14 N	15 O	16 P
TYPE			VEH																
TENTHS			PED																
EXIT			VEH O/L																
			PED O/L																
PC->YEL			OUTS																

RUN																			
INTVL #		FLASH PLAN	SIG OUTS	1 A	2 B	3 C	4 D	5 E	6 F	7 G	8 H	9 I	10 J	11 K	12 L	13 M	14 N	15 O	16 P
TYPE			VEH																
TENTHS			PED																
EXIT			VEH O/L																
			PED O/L																
PC->YEL			OUTS																

Project: **Wallingford, CT**
 City: **Wallingford, CT**
 Location: **Parade Ground / Lobby**
 Sheet: **58T**
 By: **AWD**
 Date: **7/2/12**

Valid
Dwell
Fixed
Exit

1	X	X	X
2	X	X	X
3	X	X	X

- Enable Run
- Railroad Preempt
- Input Lock
- Go to Higher Run
- NEMA Priority
- Override UCF

Maximum Intervals: **3**
 User Priority: **1**
 Duration Service: **15**
 Preempt Delay: **0**
 Reservice Time: **5**

Inhibit Double Clearing OVL's
 Min. Green: **5.0**
 Min. Yellow: **0.0**
 Min. Red: **0.0**
 Min. Ped. Clearance: **12**
 Min. Overlap Yellow: **0.0**

- Go to Exit Phase
- Go to Next Demand
- Resume Sequence
- To Coordination

FUNC\PH	1	2	3	4	5	6	7	8
Phases	<input type="checkbox"/>	<input checked="" type="checkbox"/>	<input type="checkbox"/>	<input type="checkbox"/>	<input type="checkbox"/>	<input type="checkbox"/>	<input type="checkbox"/>	<input type="checkbox"/>
Calls	<input type="checkbox"/>	<input type="checkbox"/>	<input type="checkbox"/>	<input checked="" type="checkbox"/>	<input checked="" type="checkbox"/>	<input type="checkbox"/>	<input type="checkbox"/>	<input type="checkbox"/>

RUN	1																		
INTVL #	15	FLASH PLAN	SIG OUTS	1 A	2 B	3 C	4 D	5 E	6 F	7 G	8 H	9 I	10 J	11 K	12 L	13 M	14 N	15 O	16 P
TYPE			VEH		G														
TENTHS			PED																
EXIT			VEH O/L	G															
			PED O/L																
PC->YEL			OUTS																

RUN	1																		
INTVL #	4	FLASH PLAN	SIG OUTS	1 A	2 B	3 C	4 D	5 E	6 F	7 G	8 H	9 I	10 J	11 K	12 L	13 M	14 N	15 O	16 P
TYPE			VEH		G														
TENTHS			PED																
EXIT			VEH O/L	G															
			PED O/L																
PC->YEL			OUTS																

RUN	1																		
INTVL #	2	FLASH PLAN	SIG OUTS	1 A	2 B	3 C	4 D	5 E	6 F	7 G	8 H	9 I	10 J	11 K	12 L	13 M	14 N	15 O	16 P
TYPE			VEH		G														
TENTHS			PED																
EXIT			VEH O/L	G															
			PED O/L																
PC->YEL			OUTS																

RUN																			
INTVL #		FLASH PLAN	SIG OUTS	1 A	2 B	3 C	4 D	5 E	6 F	7 G	8 H	9 I	10 J	11 K	12 L	13 M	14 N	15 O	16 P
TYPE			VEH																
TENTHS			PED																
EXIT			VEH O/L																
			PED O/L																
PC->YEL			OUTS																

Project: **Wallingford, CT**
 City: **Wallingford, CT**
 Location: **Deming Road / Soil / Lobby**
 Sheet: **56T**
 By: **MWB**
 Date: **2/2/12**

59T

Field Inspection

SIGNAL EQUIPMENT EVALUATION FORM

CITY/TOWN _____ JOB# _____ DATE _____ LOCATION _____

CONTROLLER CABINET INVENTORY									
Component	Local Controller	Master Controller	CM / MMU	Detector Amplifier	Time Clock	Preemption	Load Switches	Flasher	Cabinet
Quantity	1	● N/A	Transyst	4	N/A	1	4	1	1
Make	Peck		Transyst	3 - Sansate 1 Elgate		3M	PDC	PDC	Peck
Model #	3000		IZEL	222 Orde / 2		752 Opticom	Model 200	Model 201	9447
Serial #	5207		N/A	N/A		N/A	N/A	N/A	982241
Comments: Old 3000 series Controller sitting in cabinet Chn 16 Det broken Chn 13 Det broken Opticom ^{Pulled} out of slot.									

VEHICLE SIGNAL INVENTORY		
	Size	
	8"	12"
Red		8
Yellow		8
Green		8
R-Arrow		
Y-Arrow		
G-Arrow		
Comments:		

PEDESTRIAN SIGNAL INVENTORY													
	QUANTITY									PUSHBUTTON ASSEMBLY			
	Size					Illumination Method					Quantity	Working?	ADA Compliant?
	9"	12"	16"	Countdown	Incandescent	LED	Fiber Optic	Poor Cond.?					
1 Section - Word										Button	4	Y	Y
1 Section - Symbol			8	0		8				Legend	4		
2 Section - Word										Audible	1		
2 Section - Symbol													
Comments:													

SIGNAL SUPPORT INVENTORY						
		Post		Mast Arm		Span Wire
		8'	10'	Truss	Monlever	Free
Mast Arm						✓
Post	8'	2				
	Poor					
Comments:						

φ Set	1	2	3	4	5	6	7	8	9
Min									
Ext.									
Max I									
Max II									
Yel									
Red									
Walk									
Ped Cl									
Lock									
Recall									

Sketch of intersection and signal layout:

- OUTLET FAN LAMP
- MAST ARM SPAN WIRE ORNAMENTAL
- VEH SIG 8" 12" Sect. 3 4 Bi 5
- Inc FO LED OP Failure
- Fixed Freeswing Tether
- Color Yellow Backplate Visor
- PED SIG 9" 12" 16"
- Inc FO LED Failure
- Word Symbol Red/Yellow
- Pushbutton Audible Failure Tone
- DETECT Loop Magnetic Video
- Microwave Infrared Failure
- ADVANCE SIGNING N Static Illuminated
- NUMBER OF PHASES 2 3 4 5 6
- LEFT TURN Perm Prot Lead Lag Simult
- PED PHASE N Exclusive Concurrent

Detector on 9/10 1 1/2 to phase 2
13/4 15/6 to phase 4

Source
Cycle closed loop
Split " "
offset " "
Free " "
Flash " "

Day 1
0:00-6:30 Free
6:30-9:00 1/1/1
9:00-15:00 3/1/1
15:00-18:30 2/1/1
18:30-0:00 Free

Day 2
9:00-15:00 4/1/1
Free all other

Yield starting

CYCLE LENGTH Max 60 Min 40

DEPARTMENT OF TRANSPORTATION

PROJECT - _____ LOCATION # - 59-T D.O.T. INSPECTOR - _____ DATE OF NEW SERVICE - _____
 TOWN - WAINWRIGHT LOCATION - POUNCEVILLE CONTRACTOR'S REP. - JLB CHANGE OVER DATE - _____
WASHINGTON STS

LOOP DETECTOR TEST - (PERFORMED BY CONTRACTOR) SEE STANDARD SHEET TR-1000_01

TEST	INSULATION RESISTANCE (MEGGER)	LOOP CIRCUIT RESISTANCE	POWER INTERRUPTION
DATE			

PRELIMINARY VISUAL INSPECTION - (PERFORMED BY INSPECTOR)

DATE: 1/18/12

FOUNDATIONS	TR-1002_01
CTRL FND 4" ABOVE GROUND	Y
CONCRETE PAD (3'X4')	Y
CAST IN PLACE, BRUSH FINISHED	Y
CONDUITS BONDED TO GROUND ROD	Y
DUCT SEAL IN CONDUITS	Y

PEDESTALS	TR-1102_01
LOCATION	OK
PLUMB	Y
BONDED TO GROUND ROD	UNK.
CRUSHED STONE IN FOUNDATION CENTER	UNK.

PUSH BUTTONS	TR-1107_01
ADA TYPE BUTTON, (2" DIA.), PIEZO	OK
42" MOUNTING HEIGHT	OK
ACCESSIBLE FROM SIDEWALK/RAMP	Y

HANDHOLES ①	TR-1010_01
FLUSH WITH GRADE	Y
SET ON CRUSHED STONE BASE	Y
COVER & CONDUITS BONDED	Y
DUCT SEAL IN CONDUITS	N

TRAFFIC SIGNALS	TR-1105_01
SPAN LAYOUT	OK
PLUMB APPEARANCE	Y
FACES: TYPE & LOCATION	OK
VISORS / LOUVERS / BACK PLATES	OK
MISSING HARDWARE: BOTTOM CAPS, ETC.	OK.
HEIGHT 16'-17' TO BOTTOM	OK
SIGHT DISTANCE (VISIBILITY)	OK.
UTILITY CLEARANCES	OK

ADA REQUIREMENTS	
CROSSWALKS	OK
SIDEWALK (CLEAR PATH, MIN 36")	OK
RAMPS W/ DETECTABLE WARNING STRIP	N

SPAN POLES / MAST ARMS	TR-1103_01
LOCATION	OK
BASE GROUTED	Y
PROPER RAKE. PLUMB UNDER LOAD	OK
HEIGHT / ARM LENGTH	OK
H.H. CVR. POLE CAP, BOLT CVR	OK.
BONDED TO GROUND ROD	UNK.
I.D. TAG	②
1 SPAN CLAMP PER ATTACHMENT	OK

PEDESTRIAN SIGNALS M/H	TR-1102_01
CORRECT TYPE / SIZE	OK
FACING PED. TRAFFIC	OK
PROPER ADVISORY SIGNS	OK

SIGNS	
SPAN & POST MOUNT	OK
LANE USE ARROWS	N/A
NTOR SIGNS	OK.
STOP, STOP AHEAD, INT WARNING	N/A.
SIGNAL AHEAD	N/A.
FLASHING "STOP AHEAD"	N/A.


PAVEMENT MARKINGS	
LANE ARROWS	N/A
PROPER LANE & SHOULDER WIDTH	OK
CENTER LINES	OK
STOP BAR PLACEMENT	OK
ELEPHANT TRACKS	N/A

NOTES: ① ONLY ONE H.A. WAS OBSERVED @ S.E. COR (WIRE NUTS FND.)
 ② NOT OBSERVED



SIGNAL TIMING SHEET

INTERSECTION DIAGRAM

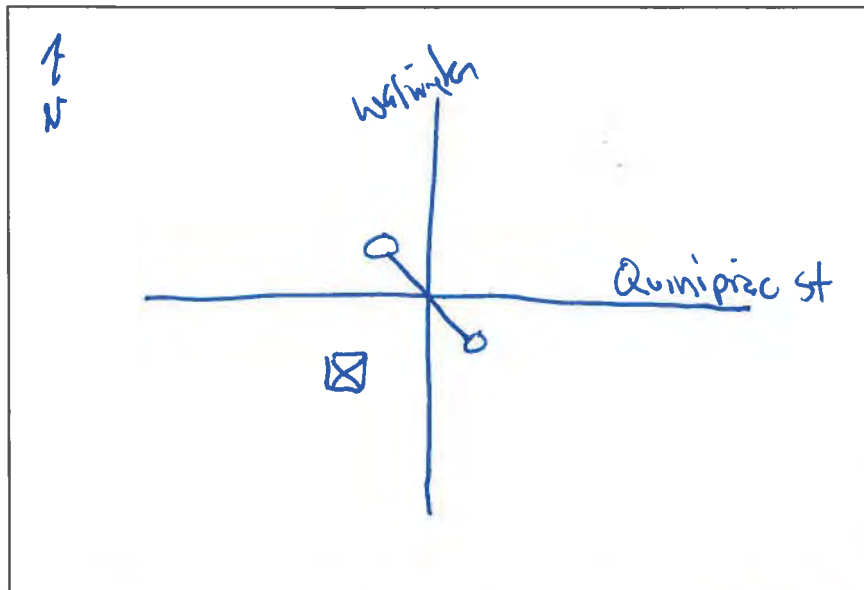

Coordination X

Pretimed

Semi-Actuated

Fully-Actuated X

baker loops
So opp. as
Pretimed

NOTES:

8 phase sequential
time clock good

OVERLAPS

	A	B	C	D
Phases	Z	Z		

PRE-EMPTION

Phases				
--------	--	--	--	--

TIME OF DAY SETTINGS

Cycle MAX I	
Time Period:	AM
Cycle Length:	50 min 40
Offset:	0
Cycle MAX II	
Time Period:	PM
Cycle Length:	60 min 40
Offset:	0
Cycle MAX III	
Time Period:	Midday
Cycle Length:	50 min 40
Offset:	0


PHASE TIMES

Phase	1	2	3	4	5	6	7	8
Lock / NLock		Min	NL	NL				
Recall (Max, Min, None)		CNAI		MAX				
Walk			7					
Don't Walk			10					
Min Green		15	0	8				
Extension		3.0	0	3.0				
Recall Green								
Max I Green		30		20				
Max II Green		35		20				
Max III Green								
Yellow		3.0	0.1	3.0				
All Red		2.0	0.0	2.0				
Total Split I		60	5	35				
Total Split II		60	5	35				

Split III Same

Coord

SIGNAL PHASING DIAGRAM

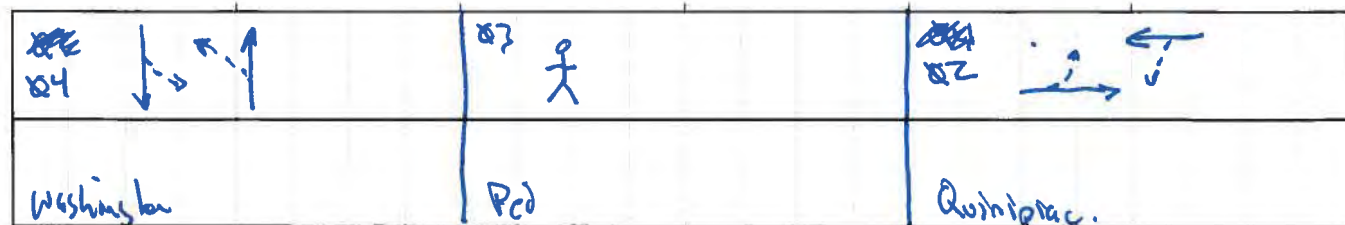

60T

Field Inspection

SIGNAL EQUIPMENT EVALUATION FORM

CITY/TOWN _____ JOB# _____ DATE _____ LOCATION _____

CONTROLLER CABINET INVENTORY									
Component	Local Controller	Master Controller	CM / MMU	Detector Amplifier	Time Clock	Preemption	Load Switches	Flasher	Cabinet
Quantity	1	0	1	4 + 2 spare	N/A	1	7	1	1
Make	Peek		Peek	Sarasota		3M	PDC	TSC	Peek
Model #	3000		12ELRA	222 GP6		752 opticon	Model 200	204	9446
Serial #	135054		0791	N/A		N/A	N/A	N/A	982241
Comments:	Opticon card not active (pulled out of 982 Card slot) Det. Card in chn 11/12 → 15/16								

VEHICLE SIGNAL INVENTORY		
	Size	
	8"	12"
Red		0
Yellow		8
Green		8
R-Arrow		
Y-Arrow		
G-Arrow		
Comments:		

PEDESTRIAN SIGNAL INVENTORY													
	QUANTITY									PUSHBUTTON ASSEMBLY			
	Size				Illumination Method						Quantity	Working?	ADA Compliant?
	9"	12"	16"	Countdown	Incandescent	LED	Fiber Optic	Poor Cond.?					
1 Section - Word										Button	4	Y	Y
1 Section - Symbol			8	0		8				Legend	4	Y	
2 Section - Word										Audible	1	Y	
2 Section - Symbol													
Comments:													

SIGNAL SUPPORT INVENTORY							
		Post		Mast Arm		Span Wire	
		8'	10'	Truss	Monlever	Free	Tether
Mast Arm							
Post	8'						
	Poor						
Comments:							

φ Set	1	2	3	4	5	6	7	8	9
Min									
Ext.									
Max I									
Max II									
Yel									
Red									
Walk									
Ped Cl									
Lock									
Recall									

Sketch of intersection and signal layout:

- OUTLET FAN LAMP
 MAST ARM SPAN WIRE ORNAMENTAL
 VEH SIG 8" 12" Sect. 3 4 Bi 5
 Inc FO LED OP Failure
 Fixed Freeswing Tether
 Color Yellow Backplate Visor
 PED SIG 9" 12" 16"
 Inc FO LED Failure
 Word Symbol Red/Yellow
 Pushbutton Audible Failure
 DETECT Loop Magnetic Video
 Microwave Infrared Failure

ADVANCE SIGNING N Static Illuminated
 NUMBER OF PHASES 2 3 4 5 6

LEFT TURN Perm Prot Lead Lag Simult
 PED PHASE N Exclusive Concurrent

CYCLE LENGTH Max _____ Min _____

	Cycle	1	2	3		
	Len	50	60	50	0:00 - 6:30	Free
	min len	40	30	30	6:30 - 9:00	1/1/1
	o/s	34	11	11	9:00 - 15:00	3/1/1
					15:00 - 18:30	2/1/1
					18:30 - 24:00	Free
#	C / o / s / Free					
1	7/6/25	1	CH	WARM	IM 1	IMC
2	7/6/25	2	FOH			

Cycle Source CL
 Split CL
 o/s CL
 Free CL
 Flash CL

End of Main Y
 Cycle 1 2 3 4 5
 44 5 22 29
 Split 1
 Cycle 2 45 5 20 30
 Split 1
 Cycle 3 44 5 20 31
 46 5 16 33

DEPARTMENT OF TRANSPORTATION

PROJECT - _____ LOCATION # - 60-T D.O.T. INSPECTOR - _____ DATE OF NEW SERVICE - _____
 TOWN - WALWINGFORD LOCATION - N.S. CITERRY @ QUINNIPAC ST CONTRACTOR'S REP. - JLB CHANGE OVER DATE - _____

LOOP DETECTOR TEST - (PERFORMED BY CONTRACTOR) SEE STANDARD SHEET TR-1000_01

TEST	INSULATION RESISTANCE (MEGGER)	LOOP CIRCUIT RESISTANCE	POWER INTERRUPTION
DATE			

PRELIMINARY VISUAL INSPECTION - (PERFORMED BY INSPECTOR)

DATE: 1/18/12

FOUNDATIONS	TR-1002_01
CTRL FND 4" ABOVE GROUND	Y
CONCRETE PAD (3'X4')	Y
CAST IN PLACE, BRUSH FINISHED	Y
CONDUITS BONDED TO GROUND ROD	Y
DUCT SEAL IN CONDUITS	Y

PEDESTALS	TR-1102_01
LOCATION	OK
PLUMB	OK
BONDED TO GROUND ROD	UNK.
CRUSHED STONE IN FOUNDATION CENTER	UNK.

PUSH BUTTONS	TR-1107_01
ADA TYPE BUTTON, (2" DIA.), PIEZO	
42" MOUNTING HEIGHT	OK
ACCESSIBLE FROM SIDEWALK/RAMP	OK

HANDHOLES	TR-1010_01
FLUSH WITH GRADE	Y
SET ON CRUSHED STONE BASE	①
COVER & CONDUITS BONDED	②
DUCT SEAL IN CONDUITS	③

TRAFFIC SIGNALS	TR-1105_01
SPAN LAYOUT	OK
PLUMB APPEARANCE	OK
FACES: TYPE & LOCATION	OK
VISORS / LOUVERS / BACK PLATES	OK
MISSING HARDWARE: BOTTOM CAPS, ETC.	OK
HEIGHT 16'-17' TO BOTTOM	OK
SIGHT DISTANCE (VISIBILITY)	③
UTILITY CLEARANCES	OK

ADA REQUIREMENTS	
CROSSWALKS	④
SIDEWALK (CLEAR PATH, MIN 36")	OK
RAMPS W/ DETECTABLE WARNING STRIP	N-⑤

SPAN POLES / MAST ARMS	TR-1103_01
LOCATION	OK
BASE GROUTED	Y
PROPER RAKE. PLUMB UNDER LOAD	Y
HEIGHT / ARM LENGTH	OK
H.H. CVR. POLE CAP, BOLT CVR	OK
BONDED TO GROUND ROD	UNK
I.D. TAG	②
1 SPAN CLAMP PER ATTACHMENT	Y

PEDESTRIAN SIGNALS	TR-1102_01
CORRECT TYPE / SIZE	OK
FACING PED. TRAFFIC	OK
PROPER ADVISORY SIGNS	OK

SIGNS	
SPAN & POST MOUNT	OK
LANE USE ARROWS	OK
NTOR SIGNS	OK
STOP, STOP AHEAD, INT WARNING	N/A
SIGNAL AHEAD	N/A
FLASHING "STOP AHEAD"	N/A

NOTES:

- ① H.H. COULD NOT BE OPENED @ THIS LOC.
- ② NOT OBSERVED
- ③ OK EXCEPT FOR SIL. HEND #2 (W.B. QUINNIPAC ST)

- ④ -BAR STYLE - IN POOR CONDITION
- ⑤ -SOME RAMPS APPEAR GREATER THAN 1" PER FT SLOPE
- ⑥ -MAST P.M. IN POOR COND.

PAVEMENT MARKINGS ⑥	
LANE ARROWS	N/A
PROPER LANE & SHOULDER WIDTH	OK
CENTER LINES	OK
STOP BAR PLACEMENT	OK
ELEPHANT TRACKS	N/A

